

**AZIMUTH LLC**  
 josef chalut  
 architect  
 327 ocean house road  
 Cape Elizabeth, Maine  
 Maine Licensed Architect  
 office 207 799 0404  
 cell 207 318 3234  
 e: azimuth@maine.rr.com




- List of Drawings
- A0.01 ~~Approved~~ Life Safety Plans
  - A1.01 First Floor Plan (north)
  - A1.02 First Floor Plan (south)
  - A1.03 Second Floor Plan
  - A1.04 3d Floor Plan
  - A1.05 1st Flr Reflected Ceiling Plan
  - A1.06 2nd Flr Reflected Ceiling Plan
  - A2.01 Interior Elevations
  - A2.02 Interior Elevations
  - A3.01 Stair #3, HVAC chase
  - A3.02 Stair #4
  - A4.01 Changing Rooms (Lockers)
  - A5.01 Wall Types
  - A6.01 Schedules
  - LS1.1 1st Floor Life Safety
  - LS1.2 2nd Floor Life Safety
- As Built Revision to Occupant Load  
 Date of these drawings: May 20, 2014

Diversified Communications  
 Proposed Tenant Improvements  
 121 Free Street,  
 Portland Maine, 04101

1st Floor Life Safety Plan  
 Means of Egress

LS1.1

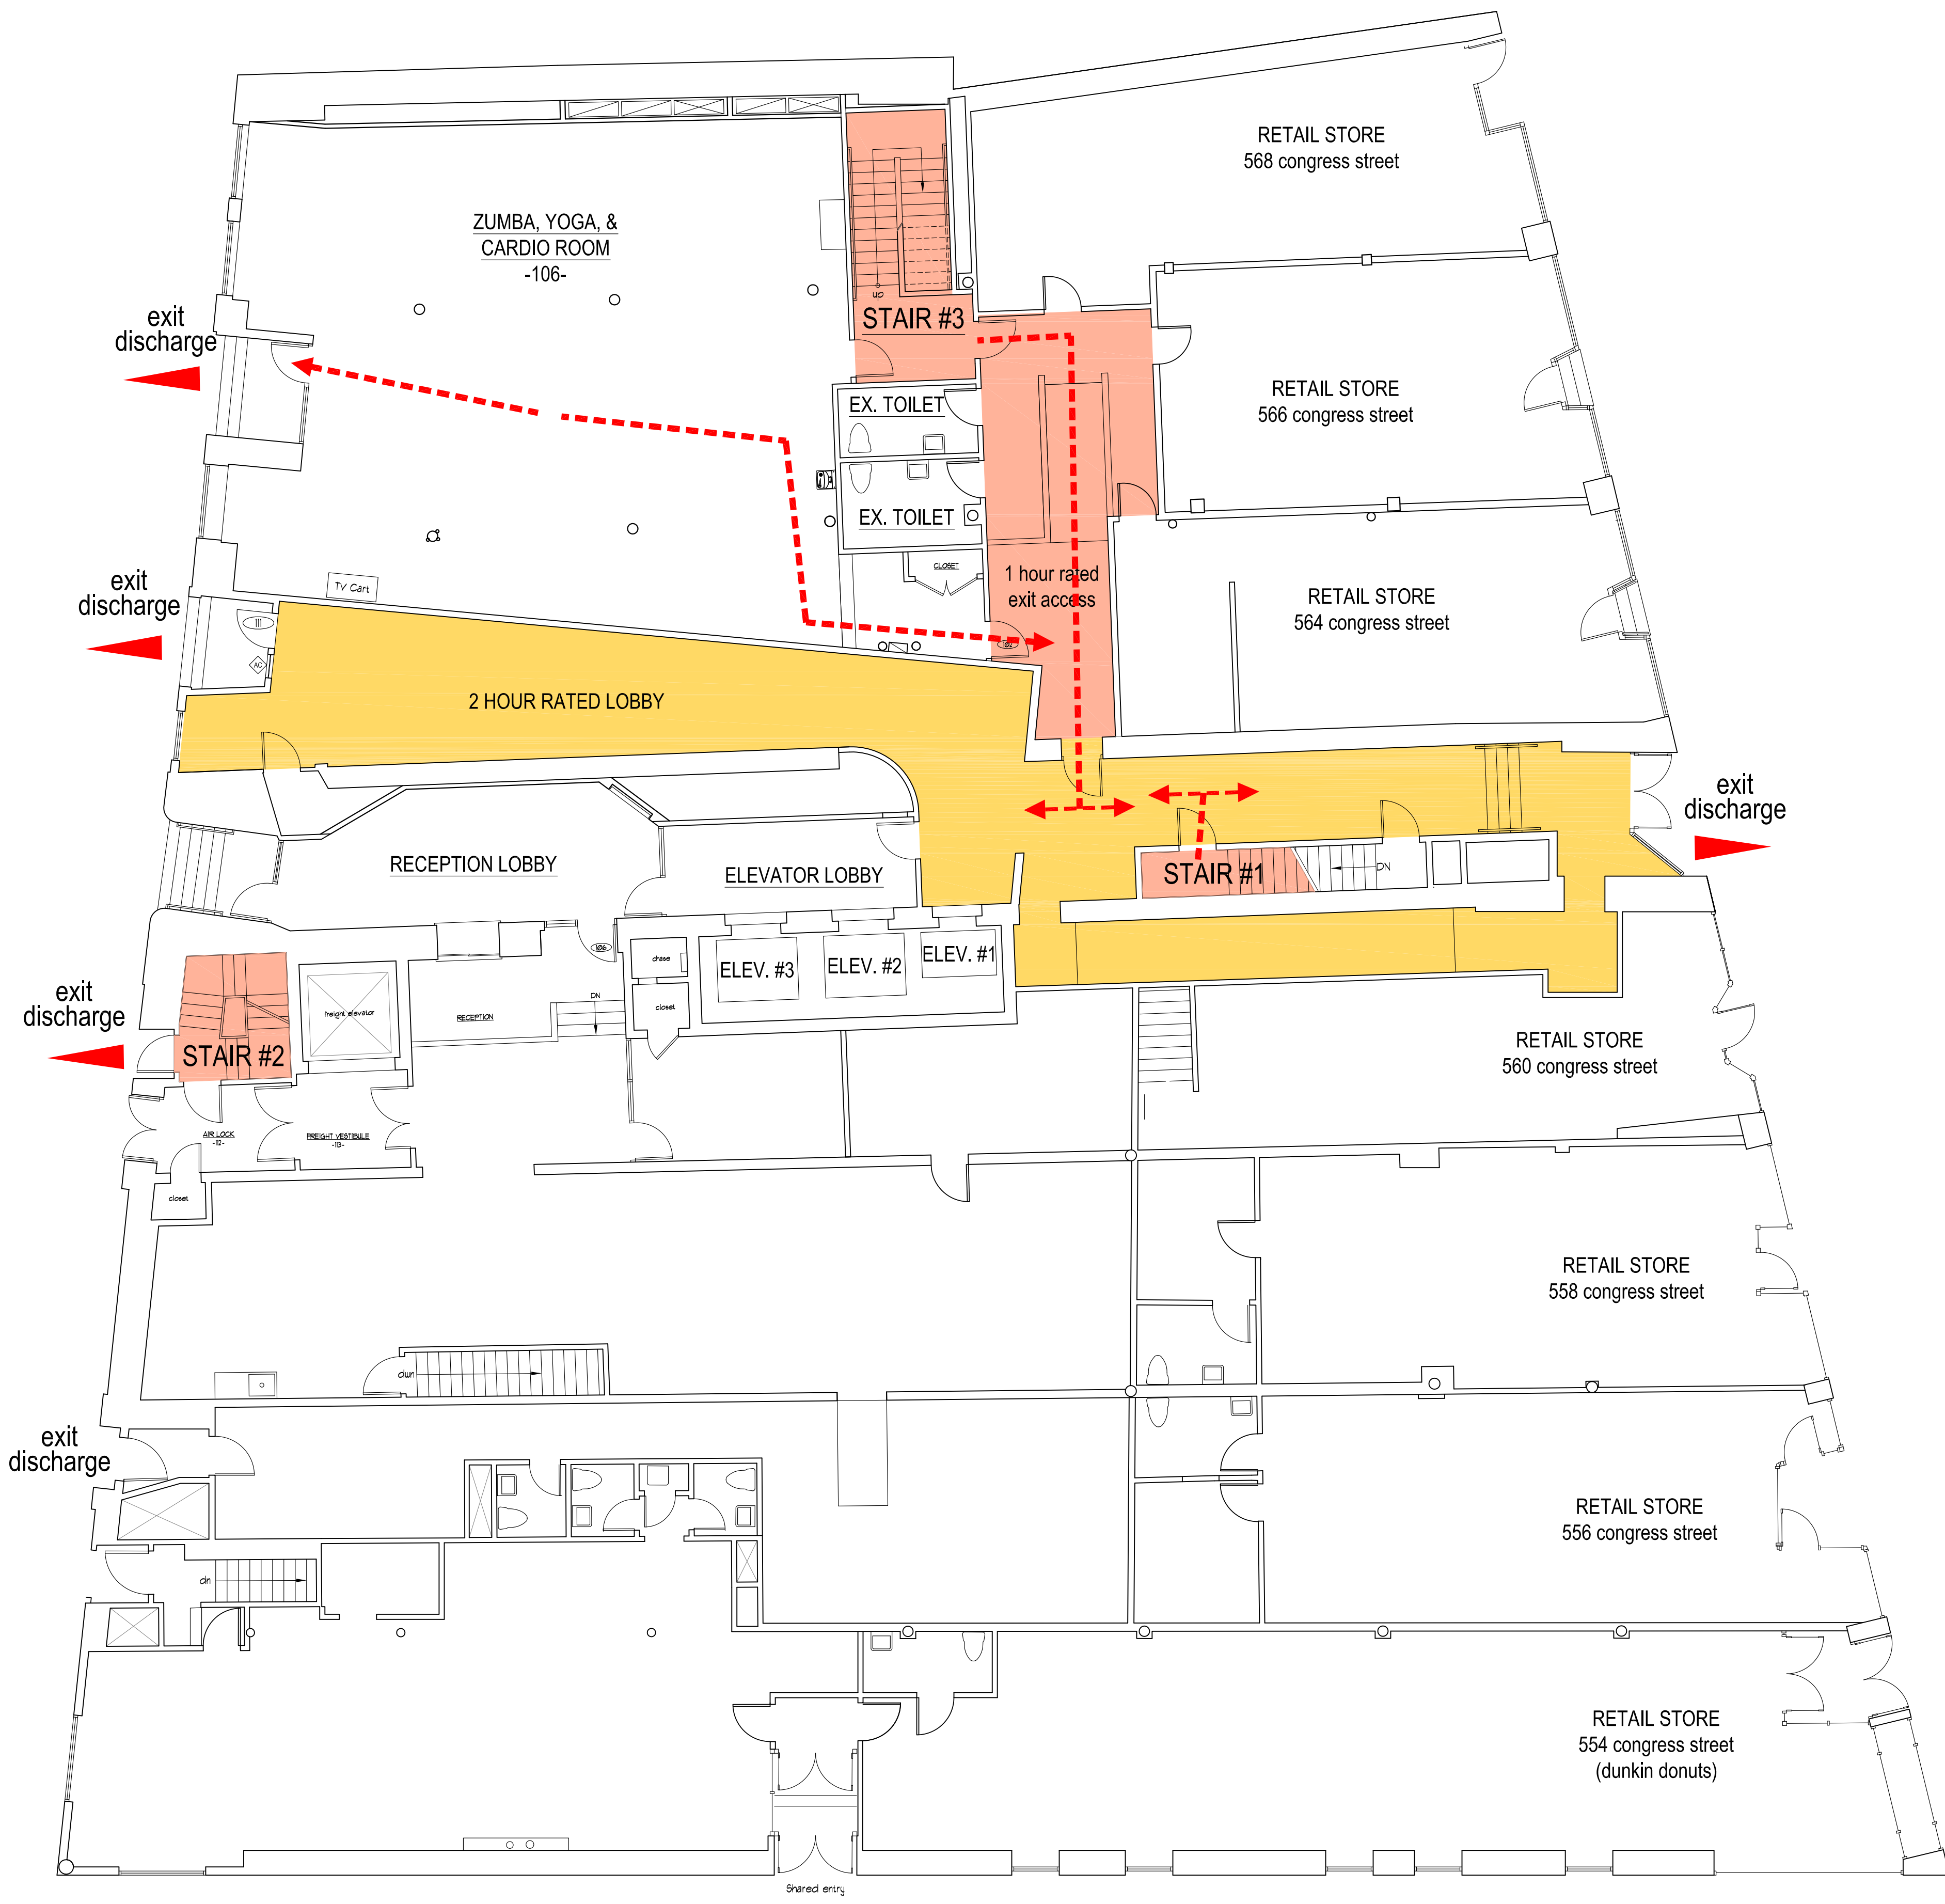

Second Floor LS Plan  
 1/8" = 1'-0"

