




Reviewed for Code Compliance
 Inspections Division
 Approved with Conditions

Date: 04/28/14

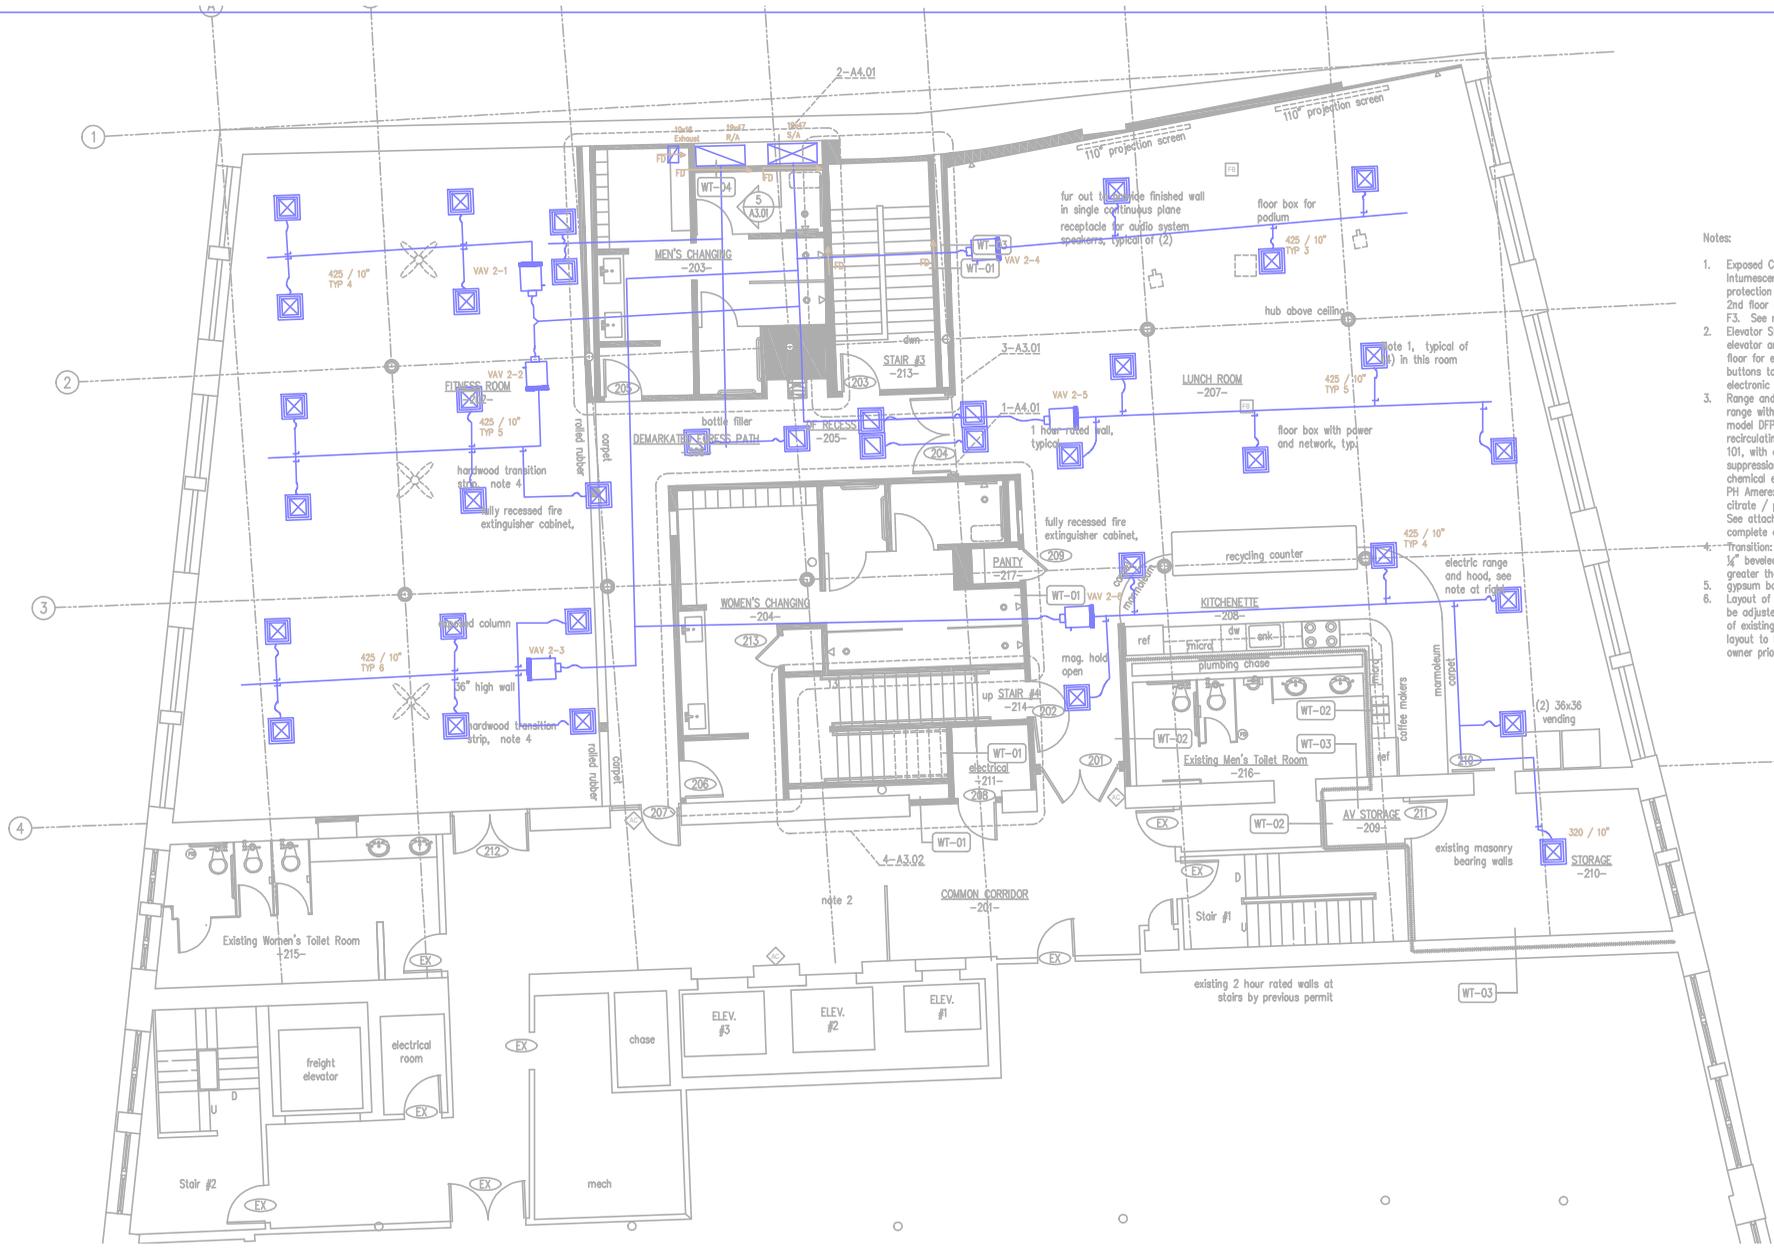

Notes:

- Exposed Columns: Provide Intumescent Coating for 1 hour protection of existing steel column at 2nd floor columns B2, B3, C3, D3, F2, F3. See notes at first floor plan.
- Elevator Stops: remove existing wall at elevator and provide stops at 2nd floor for elevators 2 and 3. Call buttons to be reconfigured for electronic card access
- Range and Hood: electric residential range with Denkor Fire Protection model DFP 1036-F, 36" wide front recirculating 500 CFM hood in NFPA 101, with activation of mechanical fire suppression system by fusible link, wet chemical extinguishing agent to be low PH Amerex 660 (pressurized potassium citrate / potassium acetate mix). See attached specification for complete description
- Transition: maximum 1/4" vertical plus 1/4" beveled 1 on 2. If transition is greater than 1/4" notify architect gypsum board soffit at 8-6
- Layout of partition walls may need to be adjusted to accommodate locations of existing walls and columns. Final layout to be reviewed by architect and owner prior to construction of walls

<p>Design • Build • Install • Service</p> <p>HVAC SERVICES, INC.</p> <p>73 BRADLEY DRIVE WESTBROOK, MAINE 04092 (207) 854-HVAC (4822)</p>	REVISIONS	THE MARQUIS LOFTS Portland, Maine
	NO. NOTES	PROJECT: DUCTWORK – ROOF PLAN & SCHEDULES
		SHEET TITLE: SCALE: 1/4"=1'-0" DRAWN BY: A22 CADD DRAFTING SERVICES, INC. CHECKED BY: "AS-BUILT" DATE:
		DATE: 03-02-2014 SHEET No. M-3