


1 **PARTIAL FIRST FLOOR PLAN - EXISTING STAIR 002 (at Free St.)**
 SKA20 SCALE: 1/8" = 1'-0"

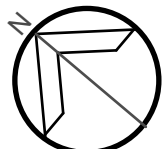

RR A
 Richard Renner|Architects
 Portland, ME 207.773.9699
 Sherborn, MA 508.651.2385
 Issued: **MAR. 24, 2015**
 Revised: **04-28-15**

MAINE COLLEGE OF ART
Lower Level Renovations
PHASE I

Existing Exit
Stair 002
 Drawn by: C.Y. Checked by:
 Scale: As Shown

MECA
LOWER LEVEL
 Renovations
SKA20
 revised