

Future location for building naming rights partner signage

Fixed fascia mounted letters similar to details at the Southwest Entrance. Final entrance naming partner still under consideration.

There is no Marquee planned for this entry.

Future location for building naming rights partner signage

Fixed fascia mounted letters as per details. Final naming will be 'Bath Savings Entrance'

There is no Marquee planned for this entry.

Northwest Entrance

Southwest Entrance

Southeast Entrance

Fixed post mounted letters as per following details. Final naming will be 'Clark Insurance Entrance'

Future Marquee signage as per details.

Future location for building naming ~~DELETED~~ signage to be located above Marquee.

Original fixed signage location to be replaced with new Cross Insurance Arena Sign



SITE RENDERING PLAN
Cumberland County Civic Center Renovation

Portland, Maine
 MAY 10, 2012

Exterior Signage Master Plan Rev. 02-27-14

Additional Proposed Changes Rev 02-05-15

0 15' 30' 60'



Original fixed signage location to be replaced with new Cross Insurance Arena Sign


Future location for building name ~~DELETED~~ signage to be located above Marquee.

Future Marquee signage as per details.



Southeast Entrance

Fixed post mounted letters below Marquee as per following details. Final naming will be 'Clark Insurance Entrance'

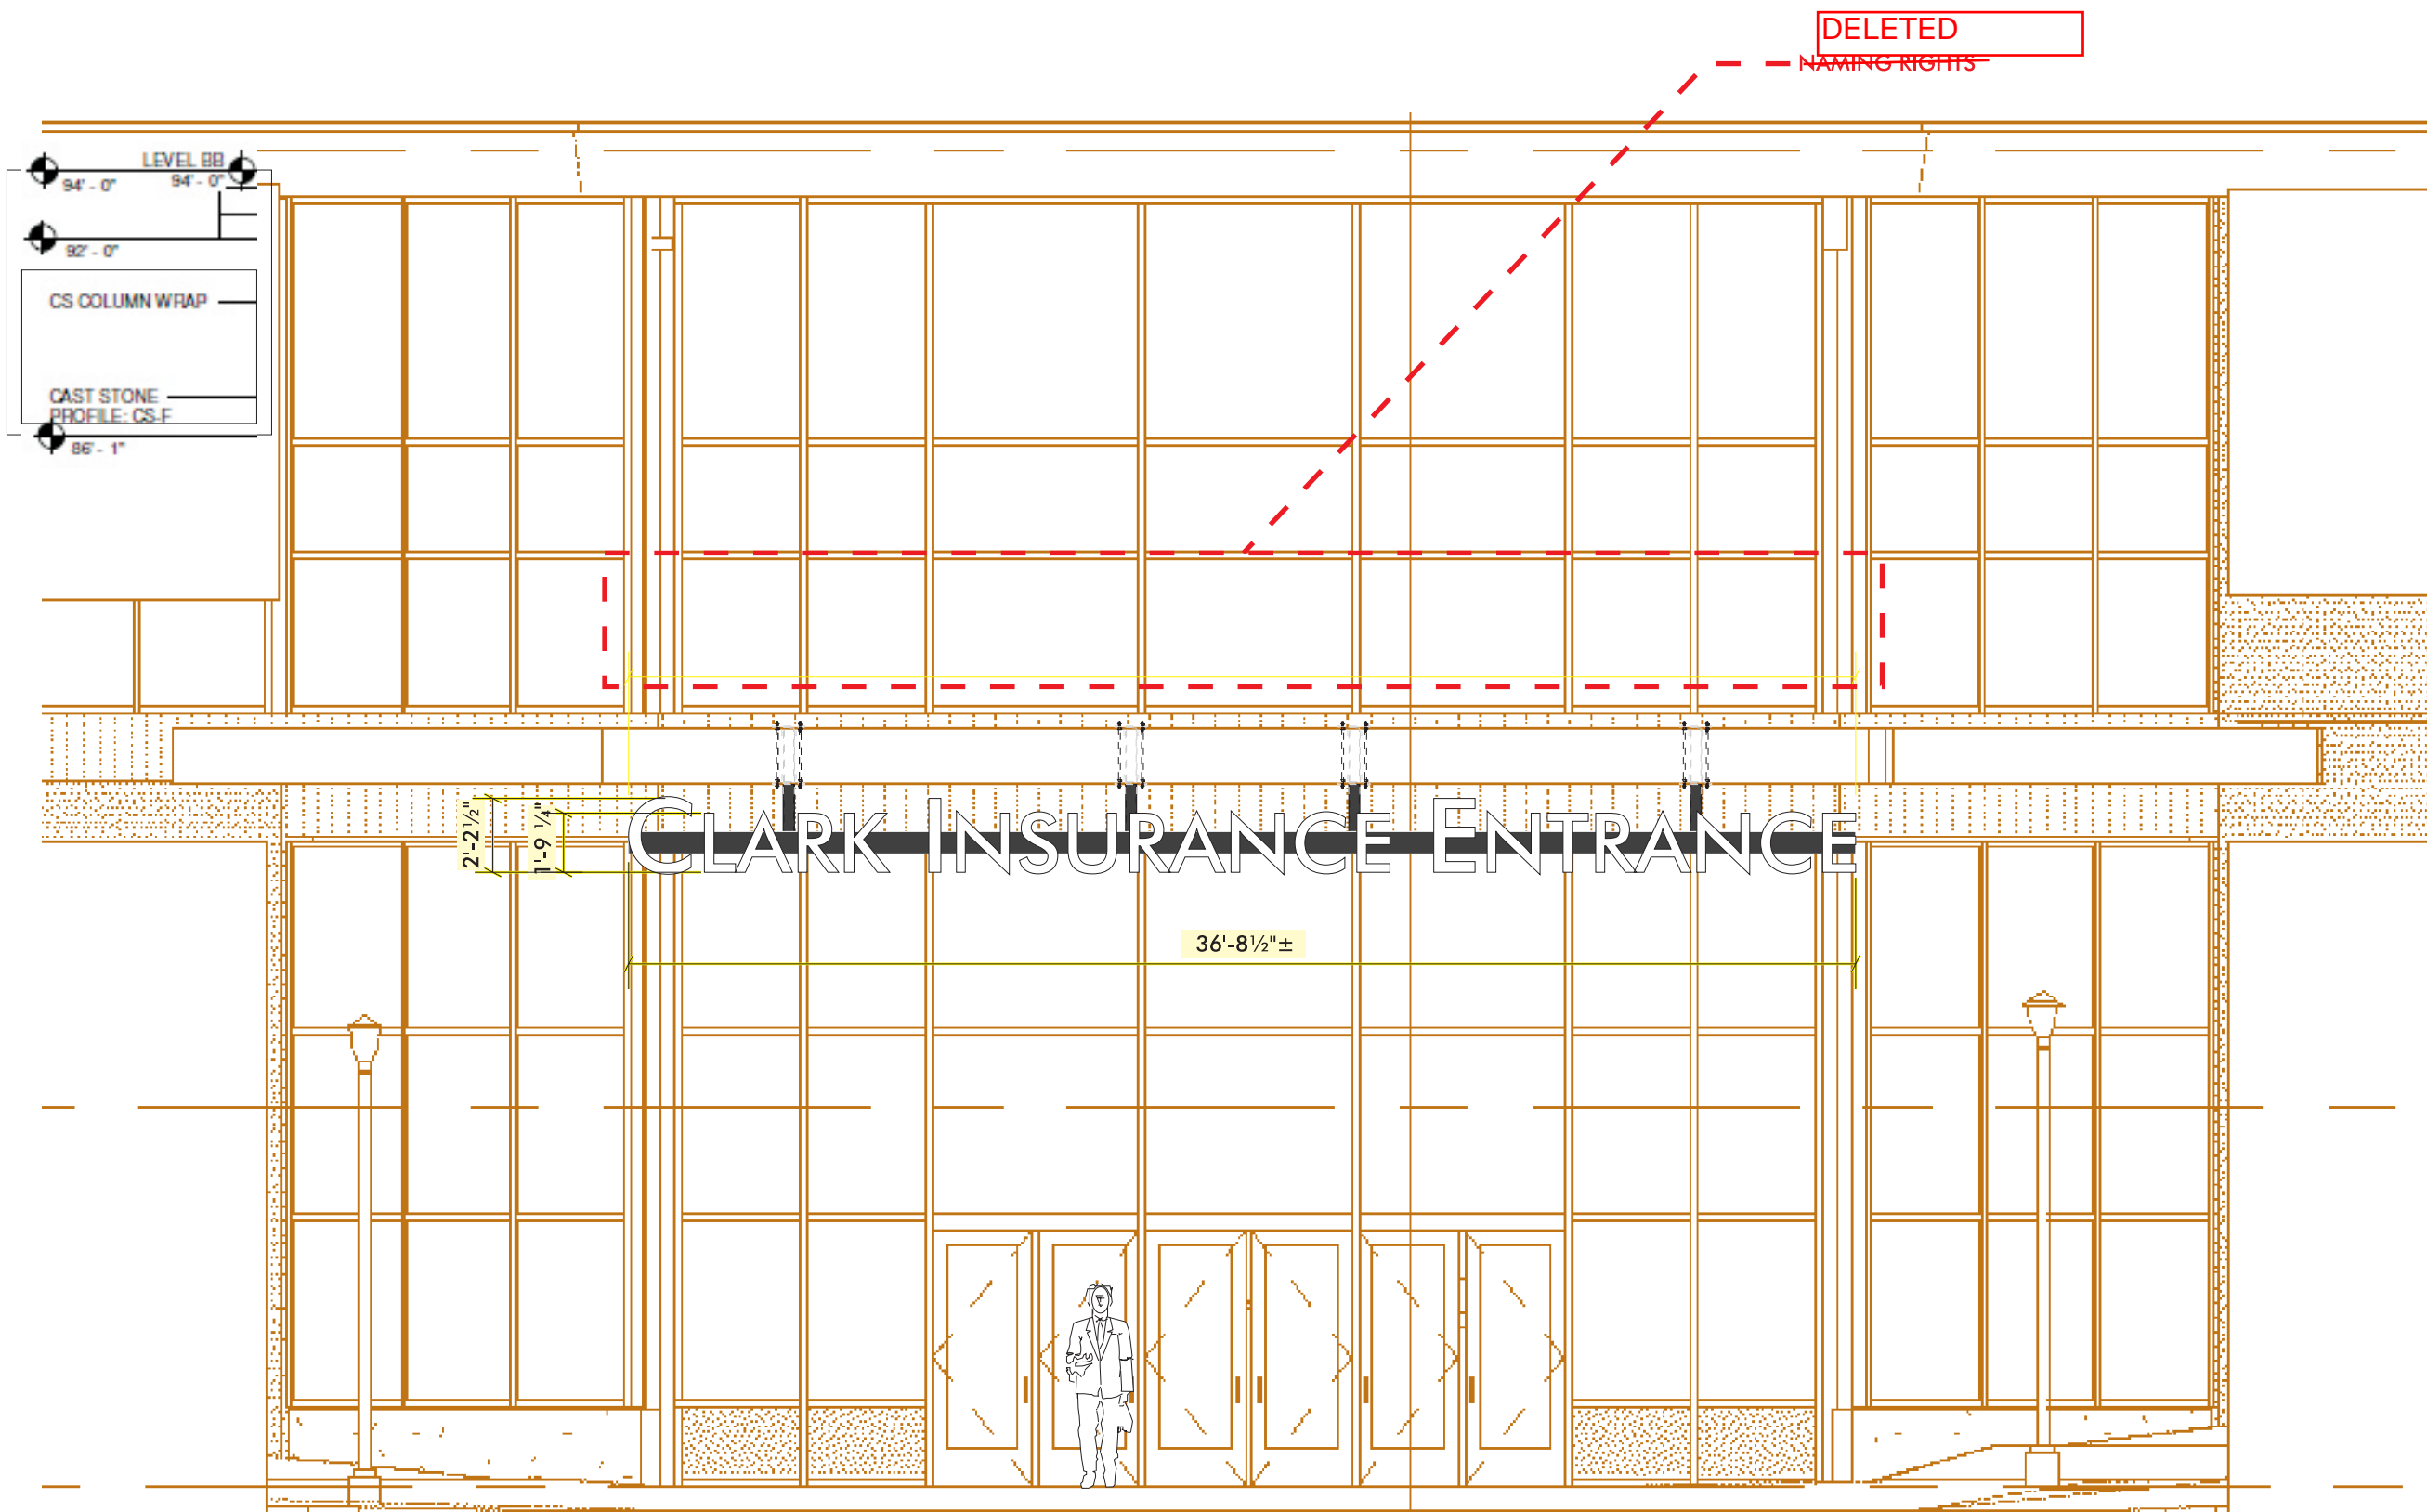

ENTRY ID 1 OF 3—CORNER ELEVATION—INT. ILLUM. ENTRY ID LETTERS SUSPENDED

SCALE: 3/16"=1'-0"

(1) SET REQUIRED



Neokraft
S I G N S

Neokraft Signs Inc.
686 Main Street
Lewiston, Maine 04240
Telephone: 207.782.9654
Facsimile: 207.782.0009
1.800.339.2258
<http://www.neokraft.com>

Custom Sign Fabrication

These plans are the exclusive property of Neokraft Signs, Inc. and are the result of the original work of its employees. They are submitted to Neokraft's client for the sole purpose of consideration of whether to purchase these plans or to purchase from Neokraft a sign manufactured according to these plans.

Distribution or exhibition of these plans to anyone other than employees of said client, or use of these plans to construct a sign similar to the one embodied herein, is expressly forbidden. In the event that such exhibition or construction occurs, Neokraft expects to be reimbursed \$1500 in compensation for time and effort entailed in creating these plans.

**Cumberland County
Civic Center
ML020258**

PERMIT

Location: 1 Civic Center Square
Portland, ME

Drawing Set: Master Sign Plan

Drawing No.: 1 of 9

Drawn by: DS Rep.: RM

Date: 02.26.2014

Revised: 02.27.2014

Lead No.: ML020258

Gen Ref.: 17890, 17799



Neokraft
S I G N S

Neokraft Signs Inc.
686 Main Street
Lewiston, Maine 04240
Telephone: 207.782.9654
Facsimile: 207.782.0009
1.800.339.2258
<http://www.neokraft.com>

Custom Sign Fabrication

These plans are the exclusive property of Neokraft Signs, Inc. and are the result of the original work of its employees. They are submitted to Neokraft's client for the sole purpose of consideration of whether to purchase these plans or to purchase from Neokraft a sign manufactured according to these plans.

Distribution or exhibition of these plans to anyone other than employees of said client, or use of these plans to construct a sign similar to the one embodied herein, is expressly forbidden. In the event that such exhibition or construction occurs, Neokraft expects to be reimbursed \$1500 in compensation for time and effort entailed in creating these plans.

**Cumberland County
Civic Center
ML020258**

PERMIT

Location: 1 Civic Center Square

Portland, ME

Drawing Set: Master Sign Plan

Drawing No.: 2 of 9


Drawn by: DS Rep.: RM

Date: 02.26.2014

Revised: 02.27.2014


Lead No.: ML020258

Gen Ref.: 17890, 17799

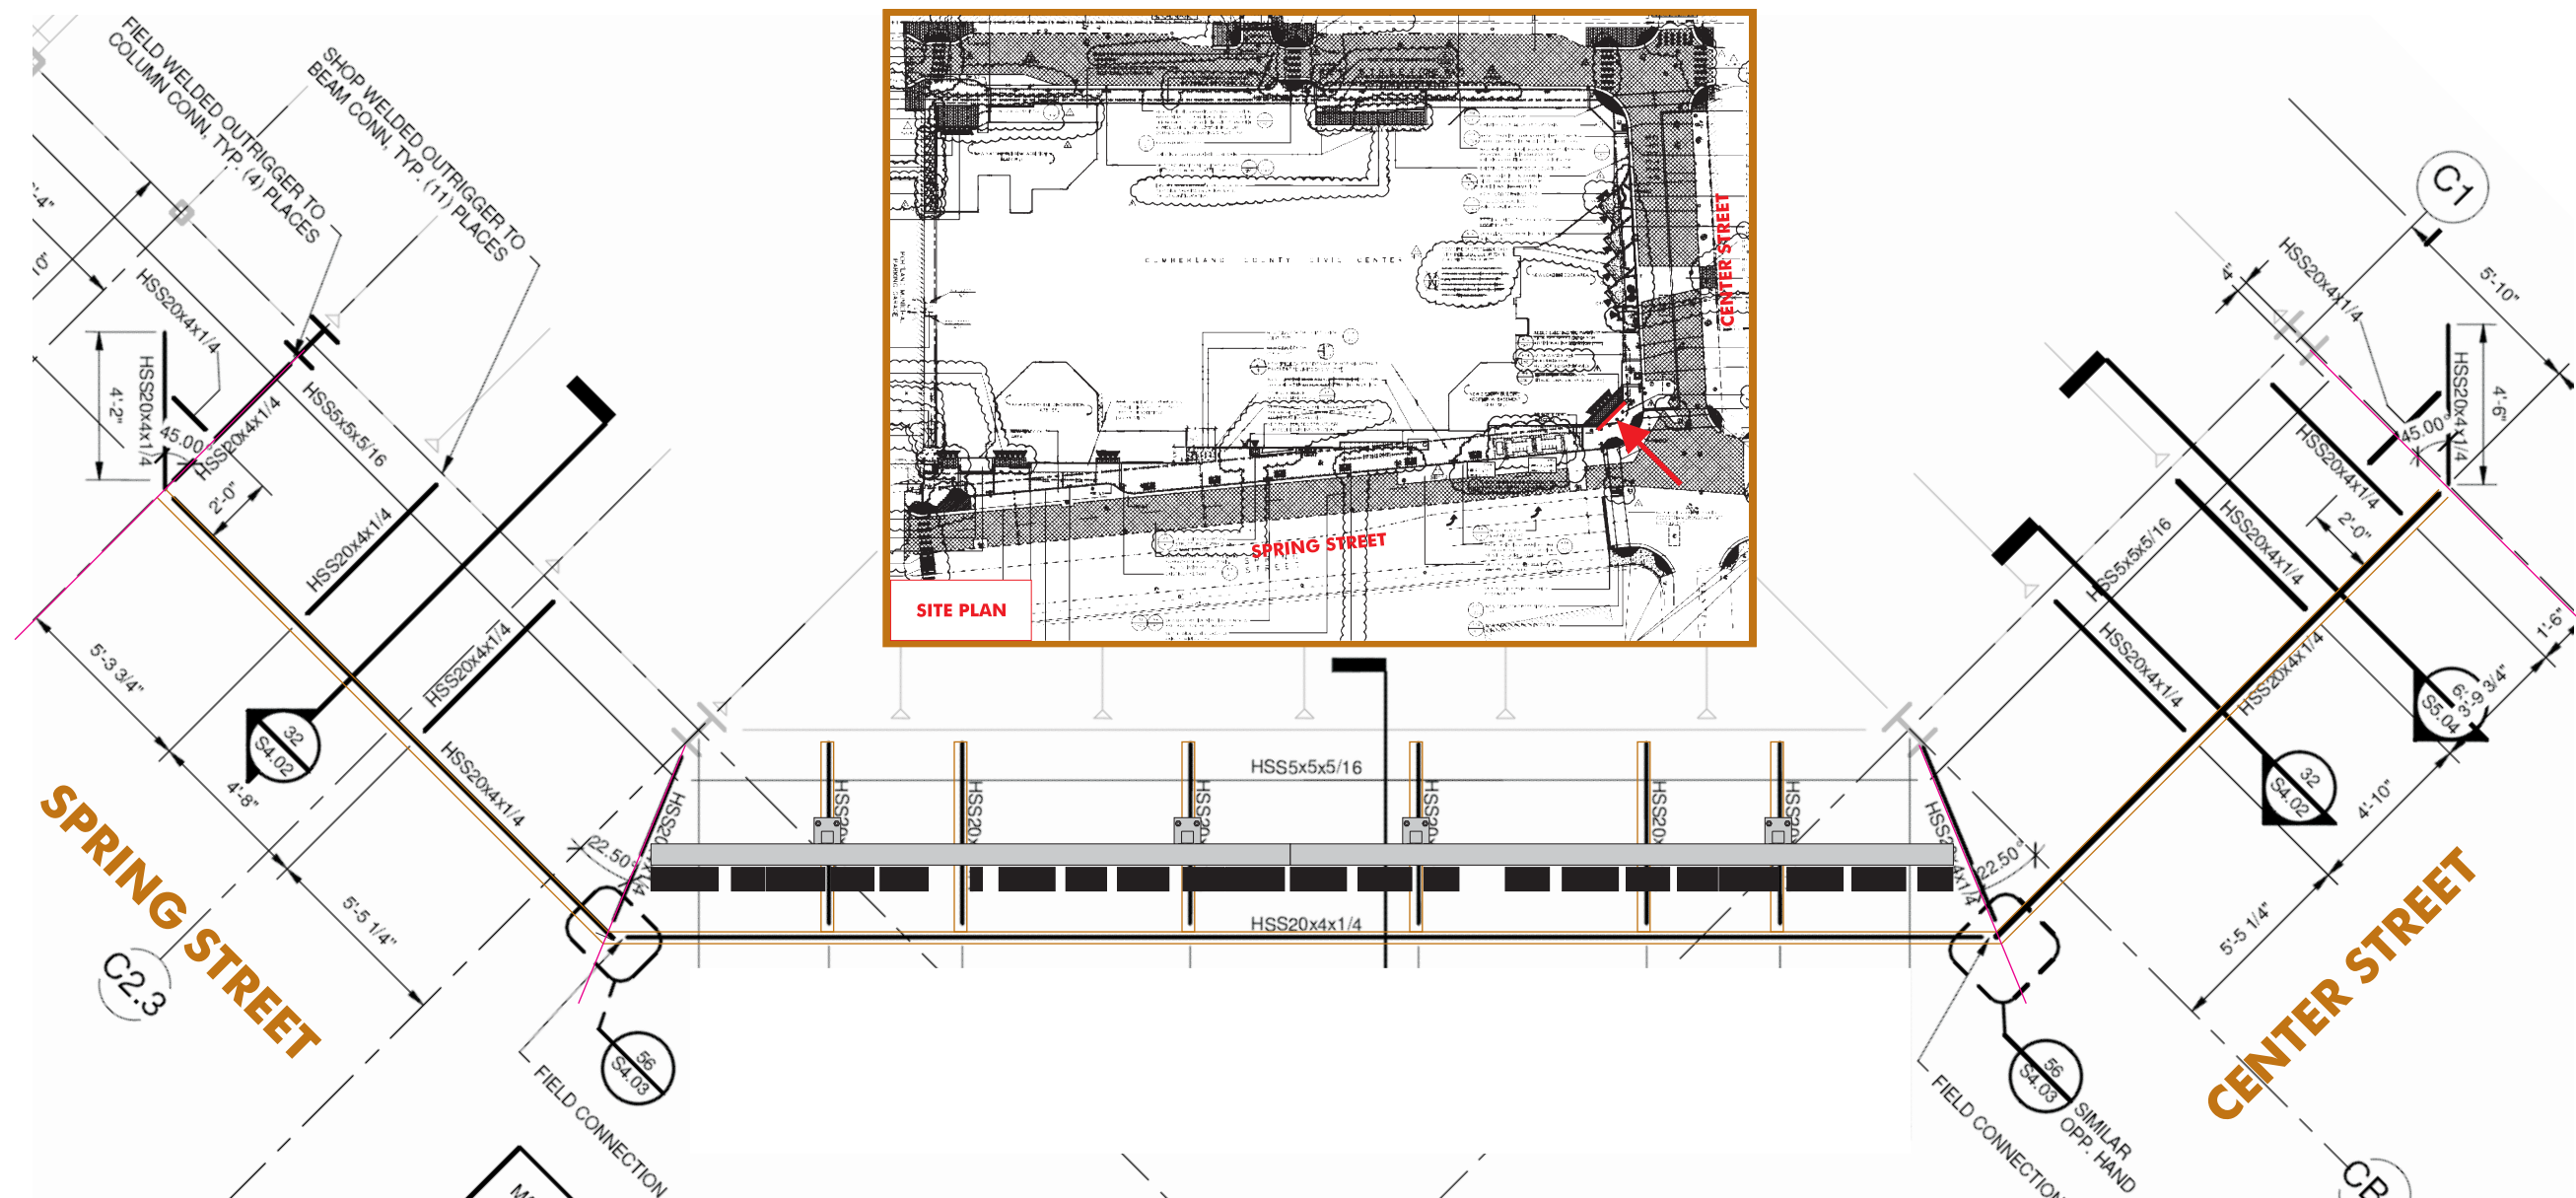


ENTRY ID 1 OF 3—REFLECTED 'CEILING' PLAN

SCALE: 3/16"=1'-0"

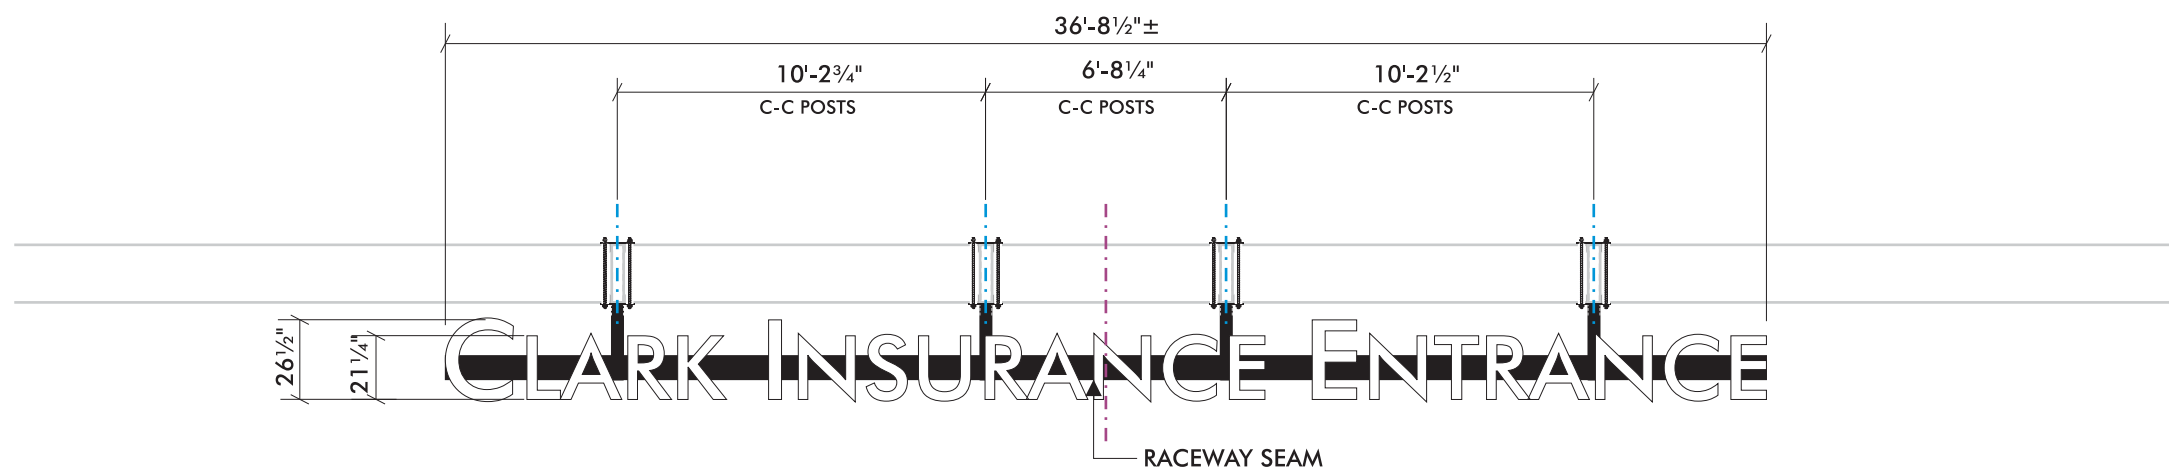

ENTRY ID 1 OF 3—COPY LAYOUT VIEW


SCALE: 3/16"=1'-0"

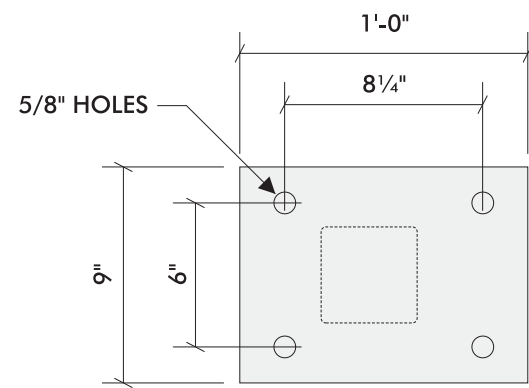


1/2" STEEL PLATES (8) TOTAL
(4) WITH WELDED POST

PLATE DETAIL

SCALE: 1 1/2" = 1'-0"

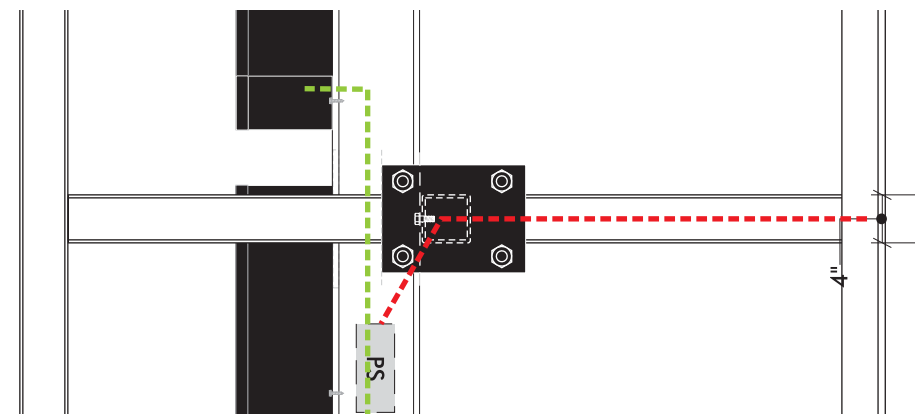


TOP VIEW

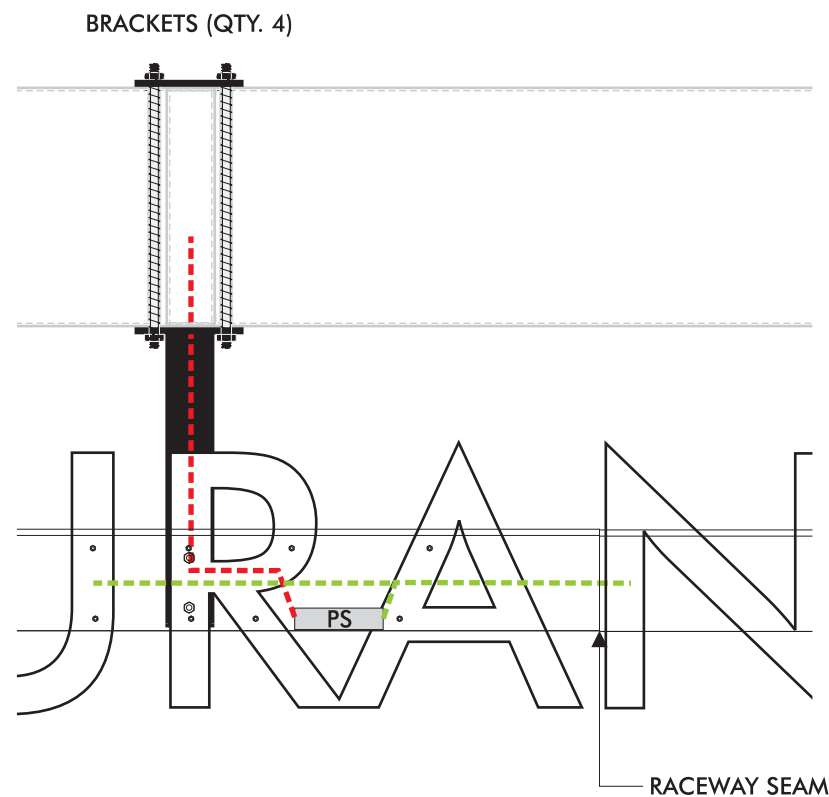

ENTRY ID 1 OF 3—DETAIL—BRACKETS/RACEWAY

SCALE: 3/4" = 1'-0"

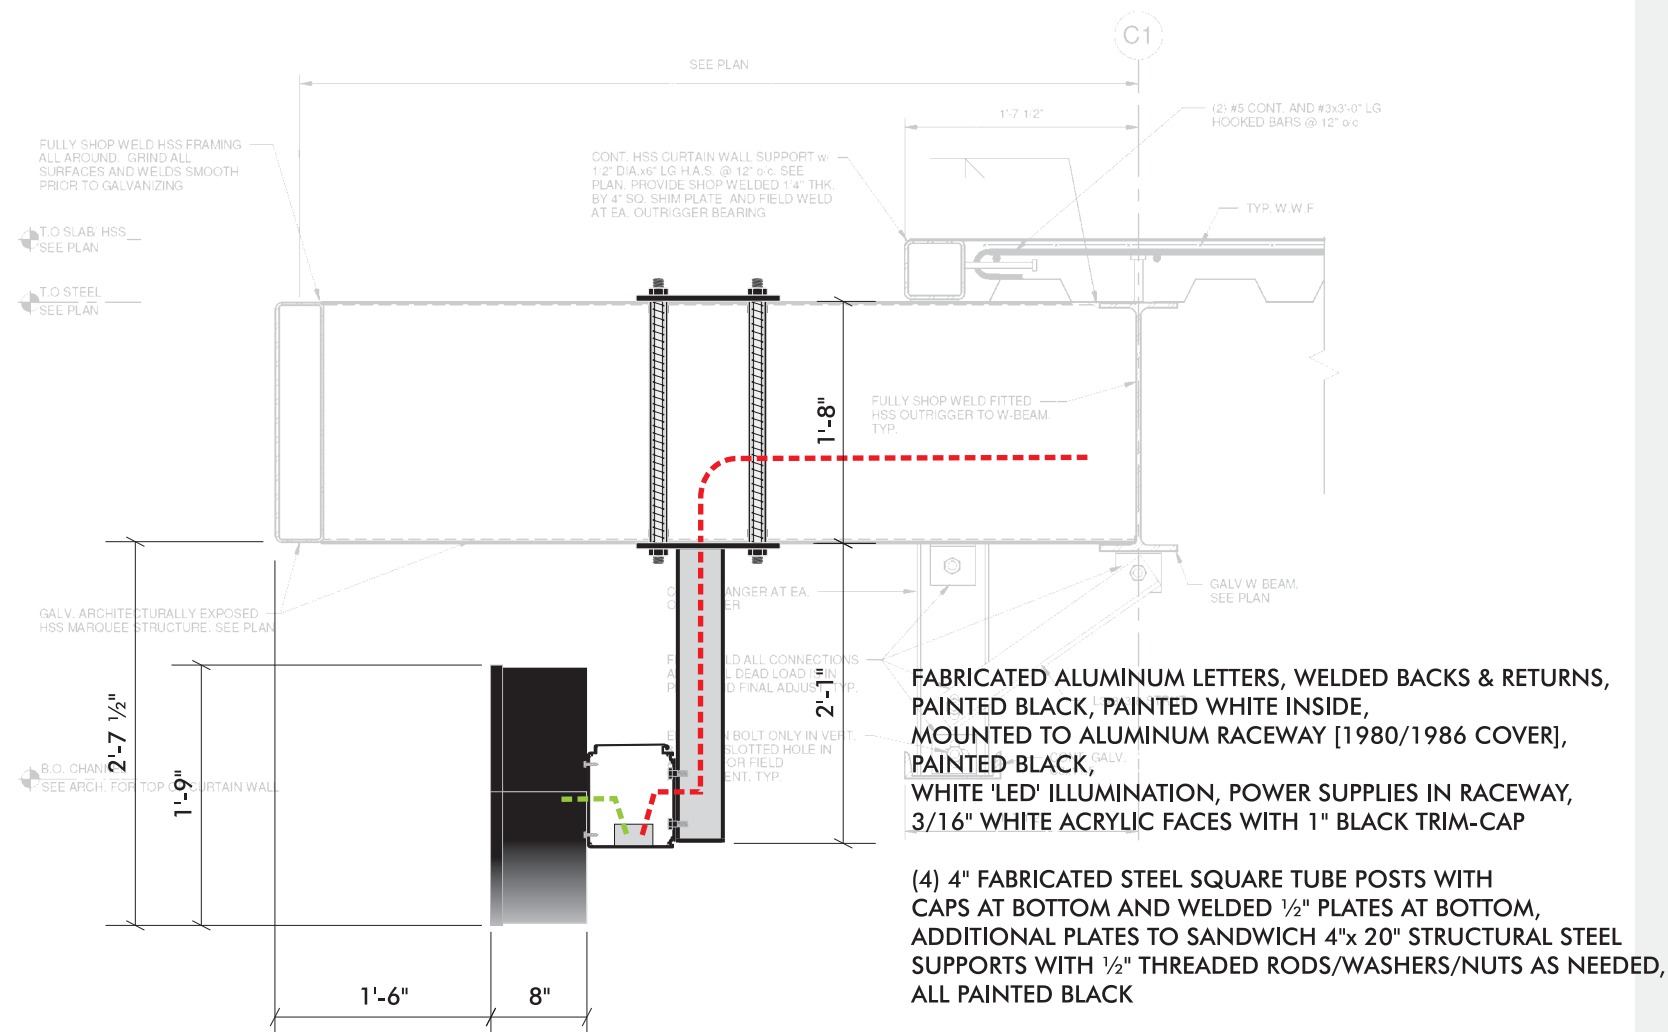

END VIEW

SCALE: 3/4" = 1'-0"



Neokraft
SIGN S

Neokraft Signs Inc.
686 Main Street
Lewiston, Maine 04240
Telephone: 207.782.9654
Facsimile: 207.782.0009
1.800.339.2258
<http://www.neokraft.com>

Custom Sign Fabrication

These plans are the exclusive property of Neokraft Signs, Inc. and are the result of the original work of its employees. They are submitted to Neokraft's client for the sole purpose of consideration of whether to purchase these plans or to purchase from Neokraft a sign manufactured according to these plans.

Distribution or exhibition of these plans to anyone other than employees of said client, or use of these plans to construct a sign similar to the one embodied herein, is expressly forbidden. In the event that such exhibition or construction occurs, Neokraft expects to be reimbursed \$1500 in compensation for time and effort entailed in creating these plans.

**Cumberland County
Civic Center
ML020258**

PERMIT

Location: 1 Civic Center Square
Portland, ME

Drawing Set: Master Sign Plan

Drawing No.: 3 of 9

Drawn by: DS Rep.: RM

Date: 02.26.2014

Revised: 02.27.2014


Lead No.: ML020258

Gen Ref.: 17890, 17799


ELECTRICAL TO SIGN BY OWNER (LOCATION TBD)

SINK COMBS DETHLEFS


Copyright by
Sink Combs
Dethlefs, P.C.
475 Lincoln Street
Suite 100
Darien, Conn 06820
303.358.0300
FAX 303.352.0222

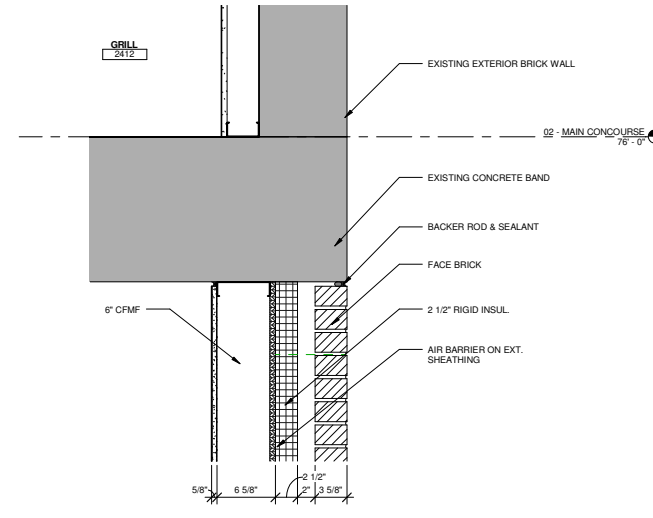


8 Detail 8 - WALL SECTION DETAIL
1 1/2" = 1'-0"

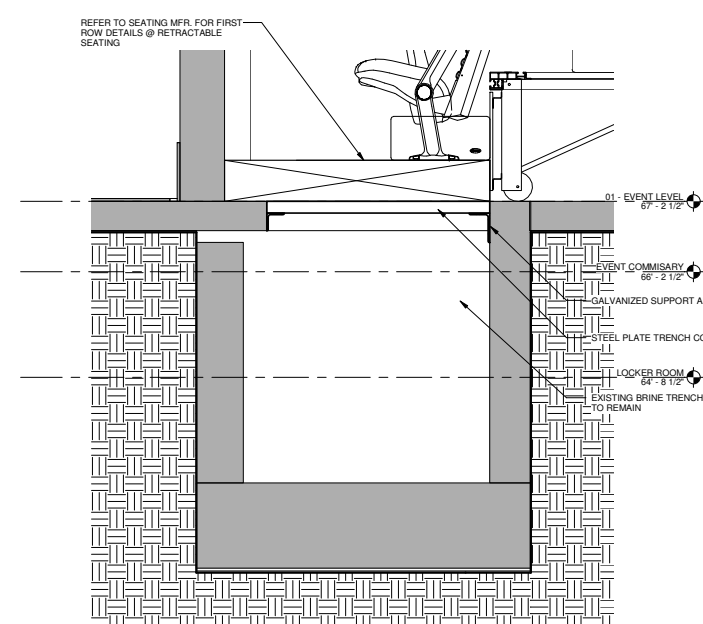


7 SECTION DETAIL - BRINE TRENCH COVER
1" = 1'-0"

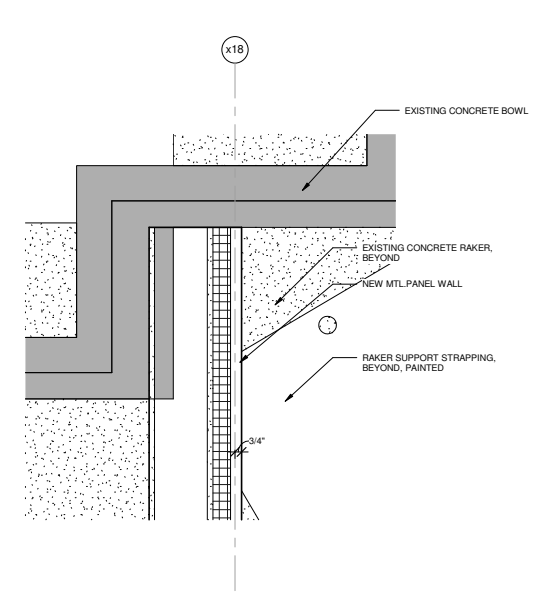


3 SECTION DETAIL - METAL PANEL WALL @ EXISTING CONCRETE BOWL
1 1/2" = 1'-0"

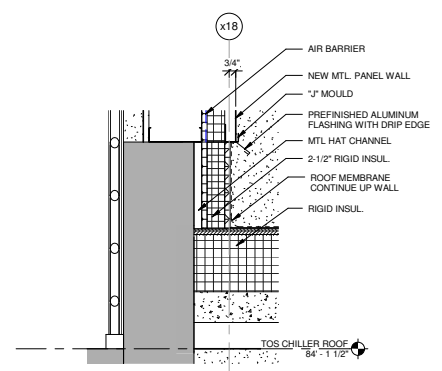

2 SECTION DETAIL - METAL PANEL WALL TO EXISTING CONCRETE SPANDEL BEAM
1 1/2" = 1'-0"

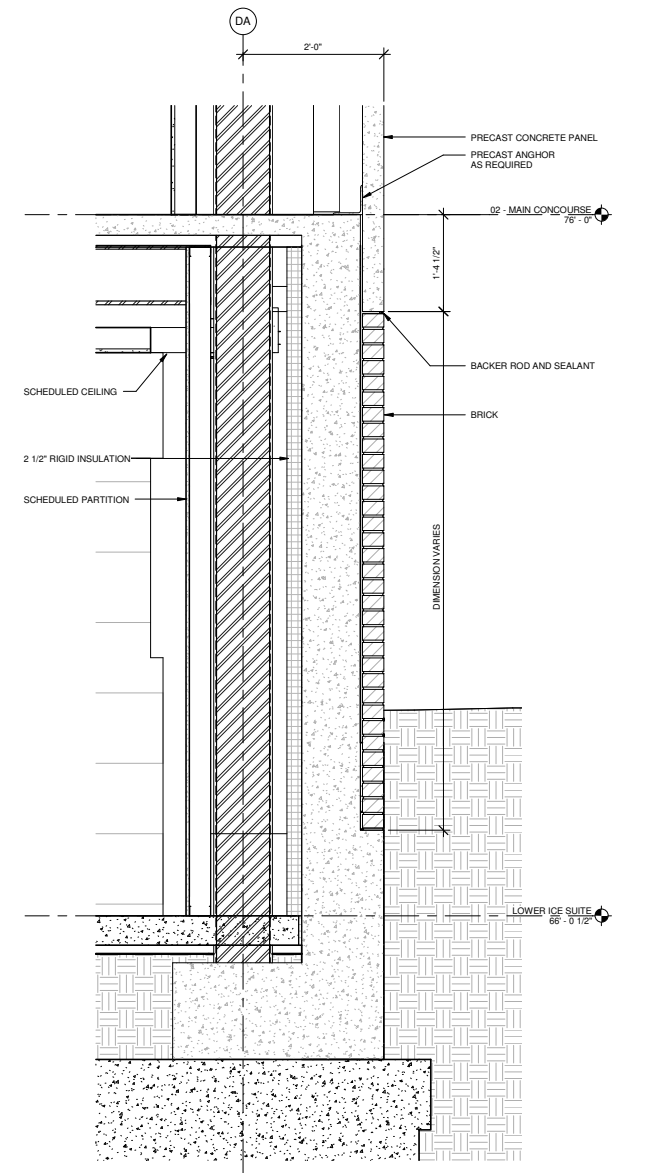

6 Detail 9 - WALL SECTION
1" = 1'-0"

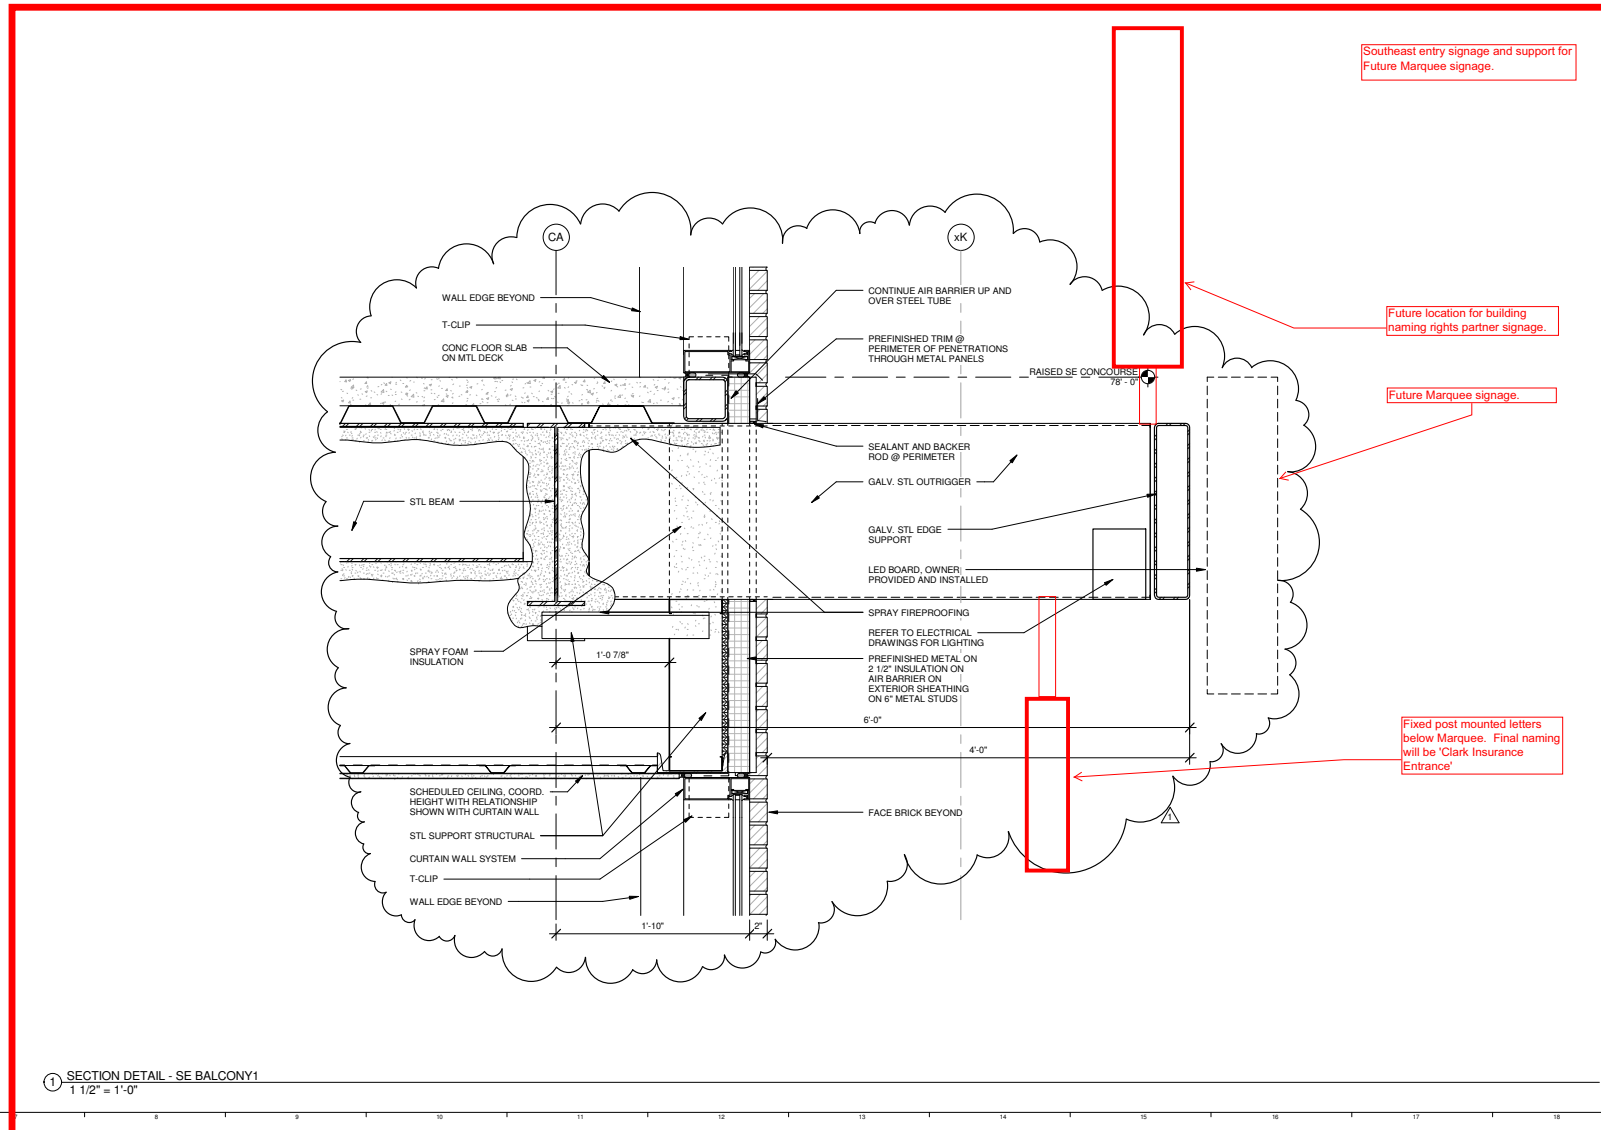

1 SECTION DETAIL - SE BALCONY1
1 1/2" = 1'-0"

Southeast entry signage and support for Future Marquee signage.

Future location for building naming rights partner signage.

Future Marquee signage.

Fixed post mounted letters below Marquee. Final naming will be 'Clark Insurance Entrance'

1	SI #047	02-27-2013
0	CONSTRUCTION DOCUMENTS	01-21-2013
REV.	DESCRIPTION	DATE
SI #047		
02-27-2013		
CURRENT ISSUE STATUS		

WBRC
ARCHITECTS • ENGINEERS
WWW.WBRC-ALC.COM
BANGOR, MAINE 207.647.4511
PORTLAND, MAINE 207.428.4511
SARASOTA, FLORIDA 941.556.0751

CUMBERLAND COUNTY CIVIC CENTER RENOVATION
PORTLAND, MAINE

SECTION DETAILS

PROJECT NO:	3757.00	DRAWING SCALE:	1"
SCALE:	As Indicated		
PROJECT MANAGER:	JRB	SHEET NO.:	A8.32
DRAWN BY:	RAD		
CHECKED BY:	MEJ		

7/11/2013 7:36:57 AM C:\P\Local\075700 - CCCO Architecture_bds\bdos.rvt


Future location for building naming rights partner signage. See detail on following pages.

There is no Marquee planned for this entry.

Fixed fascia mounted letters. See details on following pages. Final entrance naming partner still under consideration.

Northwest Entrance



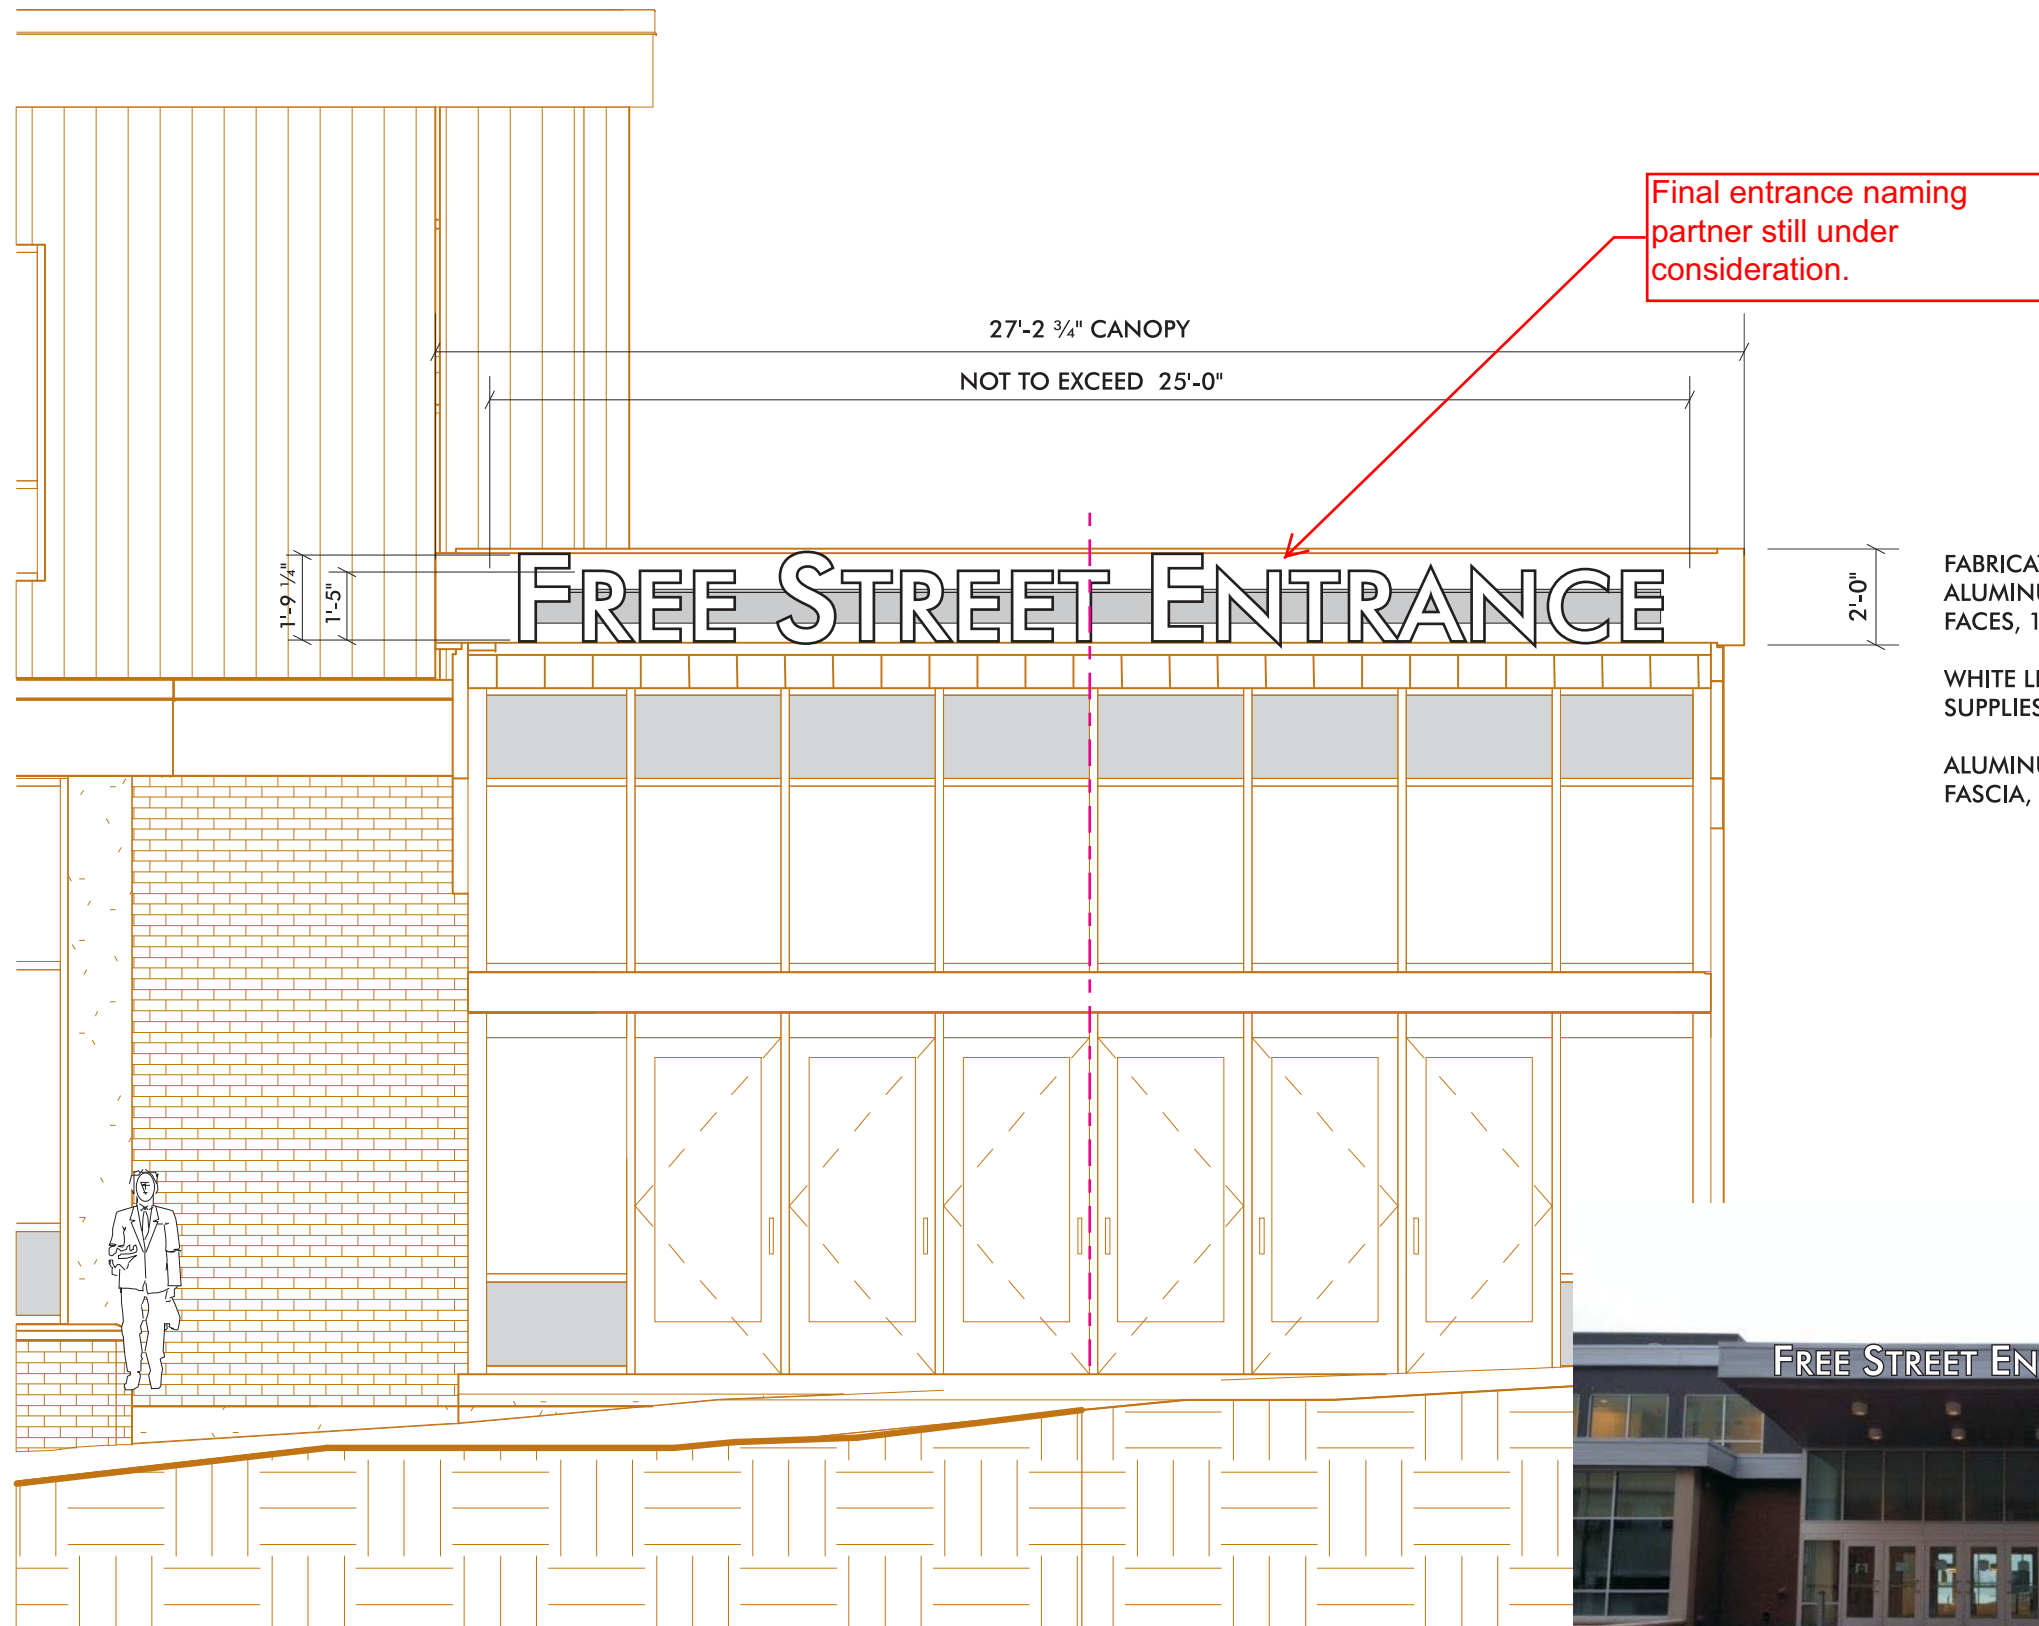


Final entrance naming partner still under consideration.

FABRICATED LETTERS: 5" DEEP BLACK ALUMINUM RETURNS, 3/16" WHITE ACRYLIC FACES, 1" BLACK TRIM-CAP

WHITE LED ILLUMINATION, POWER SUPPLIES IN RACEWAY

ALUMINUM RACEWAY PAINTED TO MATCH FASCIA, LETTERS MOUNTED ON RACEWAY

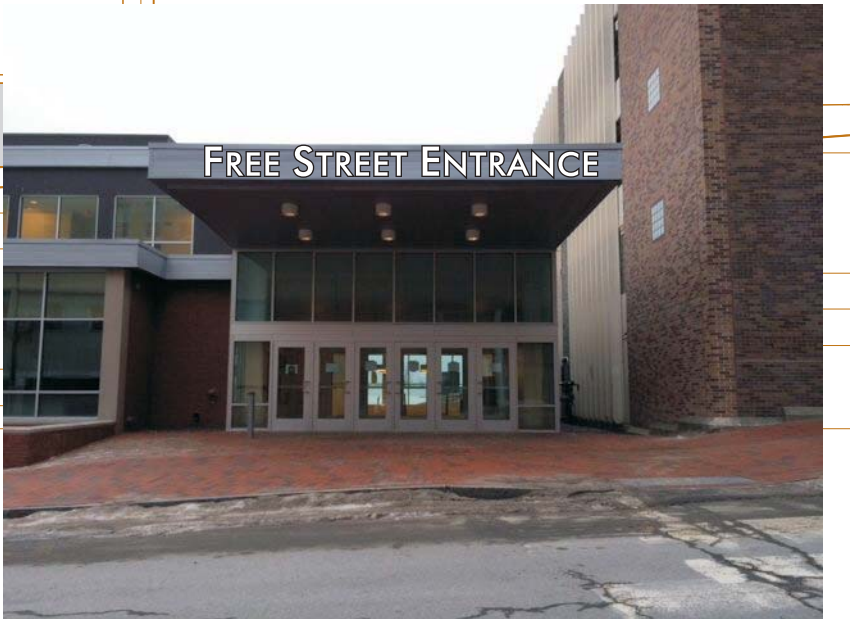

ENTRY ID 3 OF 3—FREE STREET ELEVATION—INT. ILLUM. ENTRY ID LETTERS ON CANOPY
 SCALE: 1/4" = 1'-0" (1) SET REQUIRED

PHOTO COMPOSITE
 NO SCALE



Neokraft
 SIGNS

Neokraft Signs Inc.
 686 Main Street
 Lewiston, Maine 04240
 Telephone: 207.782.9654
 Facsimile: 207.782.0009
 1.800.339.2258
<http://www.neokraft.com>


Custom Sign Fabrication

These plans are the exclusive property of Neokraft Signs, Inc. and are the result of the original work of its employees. They are submitted to Neokraft's client for the sole purpose of consideration of whether to purchase these plans or to purchase from Neokraft a sign manufactured according to these plans.

Distribution or exhibition of these plans to anyone other than employees of said client, or use of these plans to construct a sign similar to the one embodied herein, is expressly forbidden. In the event that such exhibition or construction occurs, Neokraft expects to be reimbursed \$1500 in compensation for time and effort entailed in creating these plans.


**Cumberland County
 Civic Center
 ML020258**

PERMIT	
Location:	1 Civic Center Square Portland, ME
Drawing Set: Master Sign Plan	
Drawing No.:	6 of 9
Drawn by:	DS Rep.: RM
Date:	02.26.2014
Revised:	02.27.2014
Lead No.:	ML020258
Gen Ref.:	17890, 17799

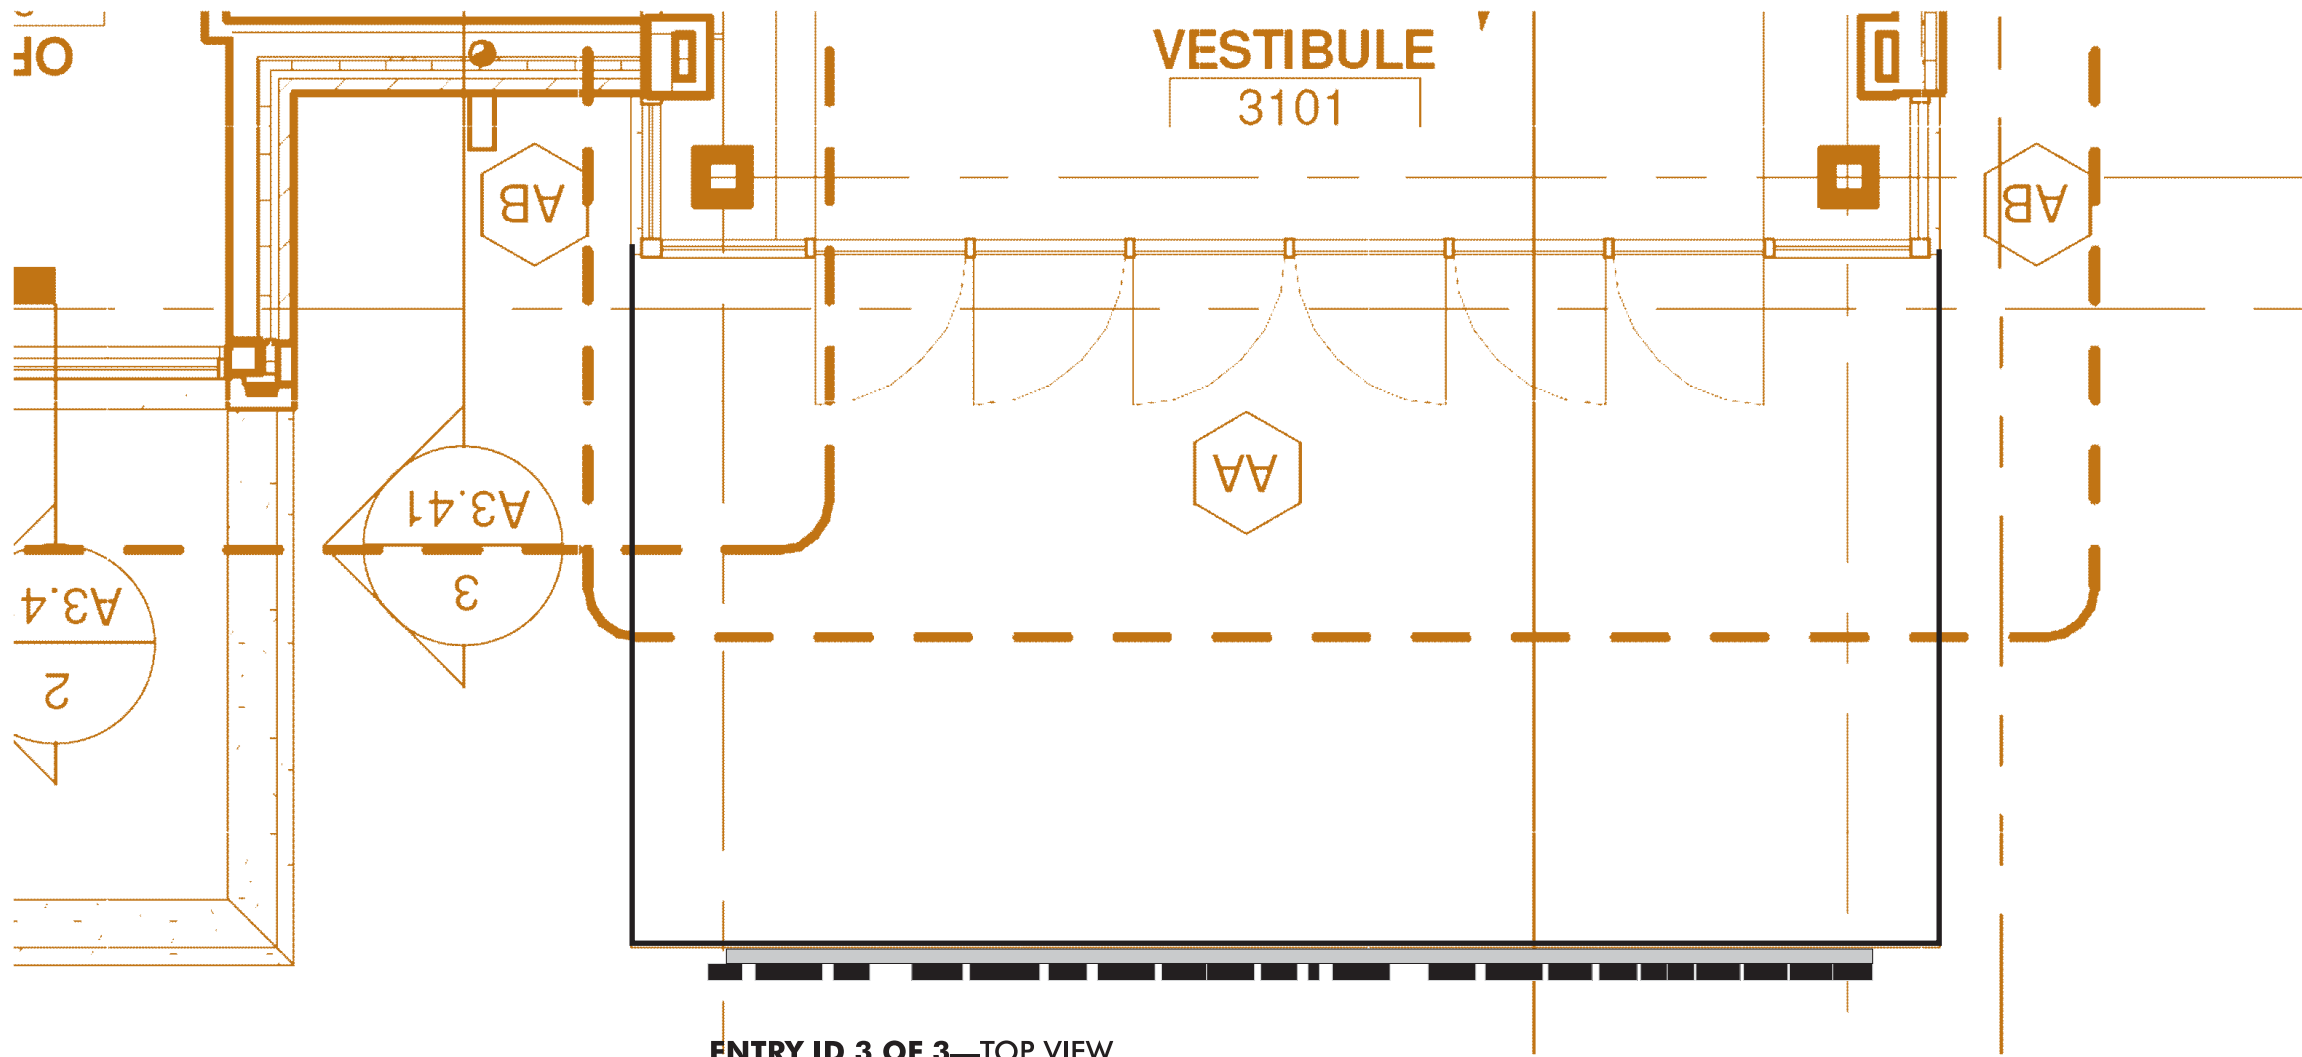


ENTRY ID 3 OF 3—TOP VIEW

SCALE: 1/4" = 1'-0"

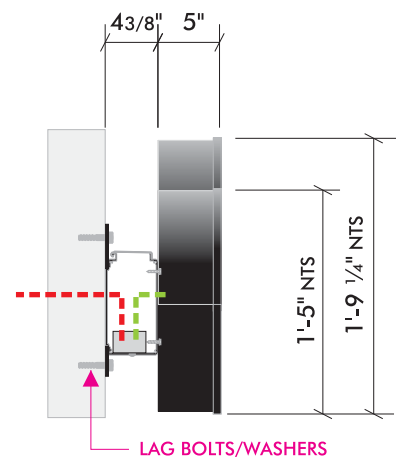

END VIEW

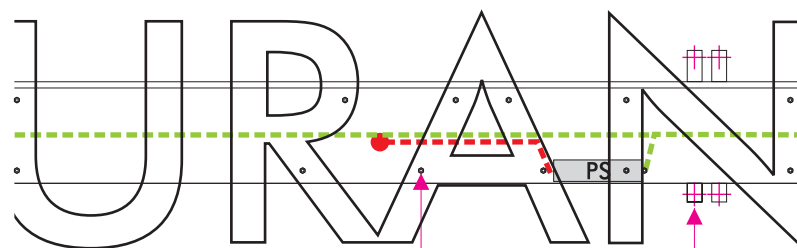

TEK-SCREWS THRU LETTER BACK INTO RACEWAY AS NEEDED


LAG BOLTS/WASHERS THRU RACEWAY CLIPS AND SIDING INTO CANOPY SHEATHING

FABRICATED ALUMINUM LETTERS: 5" DEEP BLACK ALUMINUM RETURNS, 3/16" WHITE ACRYLIC FACES
 1" BLACK TRIM-CAP, WHITE 'LED' ILLUMINATION,
 LETTERS MOUNTED ON RACEWAY [1981, 1982N, 1986N]
 POWER SUPPLIES IN RACEWAY, ALUMINUM RACEWAY PAINTED TO MATCH FACADE (TBD),

ELECTRICAL TO SIGN LOCATION BY OWNER (LOCATION TBD)

ENTRY ID 3 OF 3—DETAIL—FABRICATION/RACEWAY/ATTACHMENTS

SCALE: 3/4" = 1'-0"

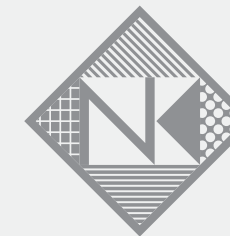

Neokraft
S I G N S

Neokraft Signs Inc.
 686 Main Street
 Lewiston, Maine 04240
 Telephone: 207.782.9654
 Facsimile: 207.782.0009
 1.800.339.2258
<http://www.neokraft.com>

Custom Sign Fabrication

These plans are the exclusive property of Neokraft Signs, Inc. and are the result of the original work of its employees. They are submitted to Neokraft's client for the sole purpose of consideration of whether to purchase these plans or to purchase from Neokraft a sign manufactured according to these plans.

Distribution or exhibition of these plans to anyone other than employees of said client, or use of these plans to construct a sign similar to the one embodied herein, is expressly forbidden. In the event that such exhibition or construction occurs, Neokraft expects to be reimbursed \$1500 in compensation for time and effort entailed in creating these plans.

**Cumberland County
 Civic Center
 ML020258**

PERMIT

Location: 1 Civic Center Square
 Portland, ME

Drawing Set: Master Sign Plan

Drawing No.: 7 of 9


Drawn by: DS Rep.: RM

Date: 02.26.2014

Revised: 02.27.2014


Lead No.: ML020258

Gen Ref.: 17890, 17799

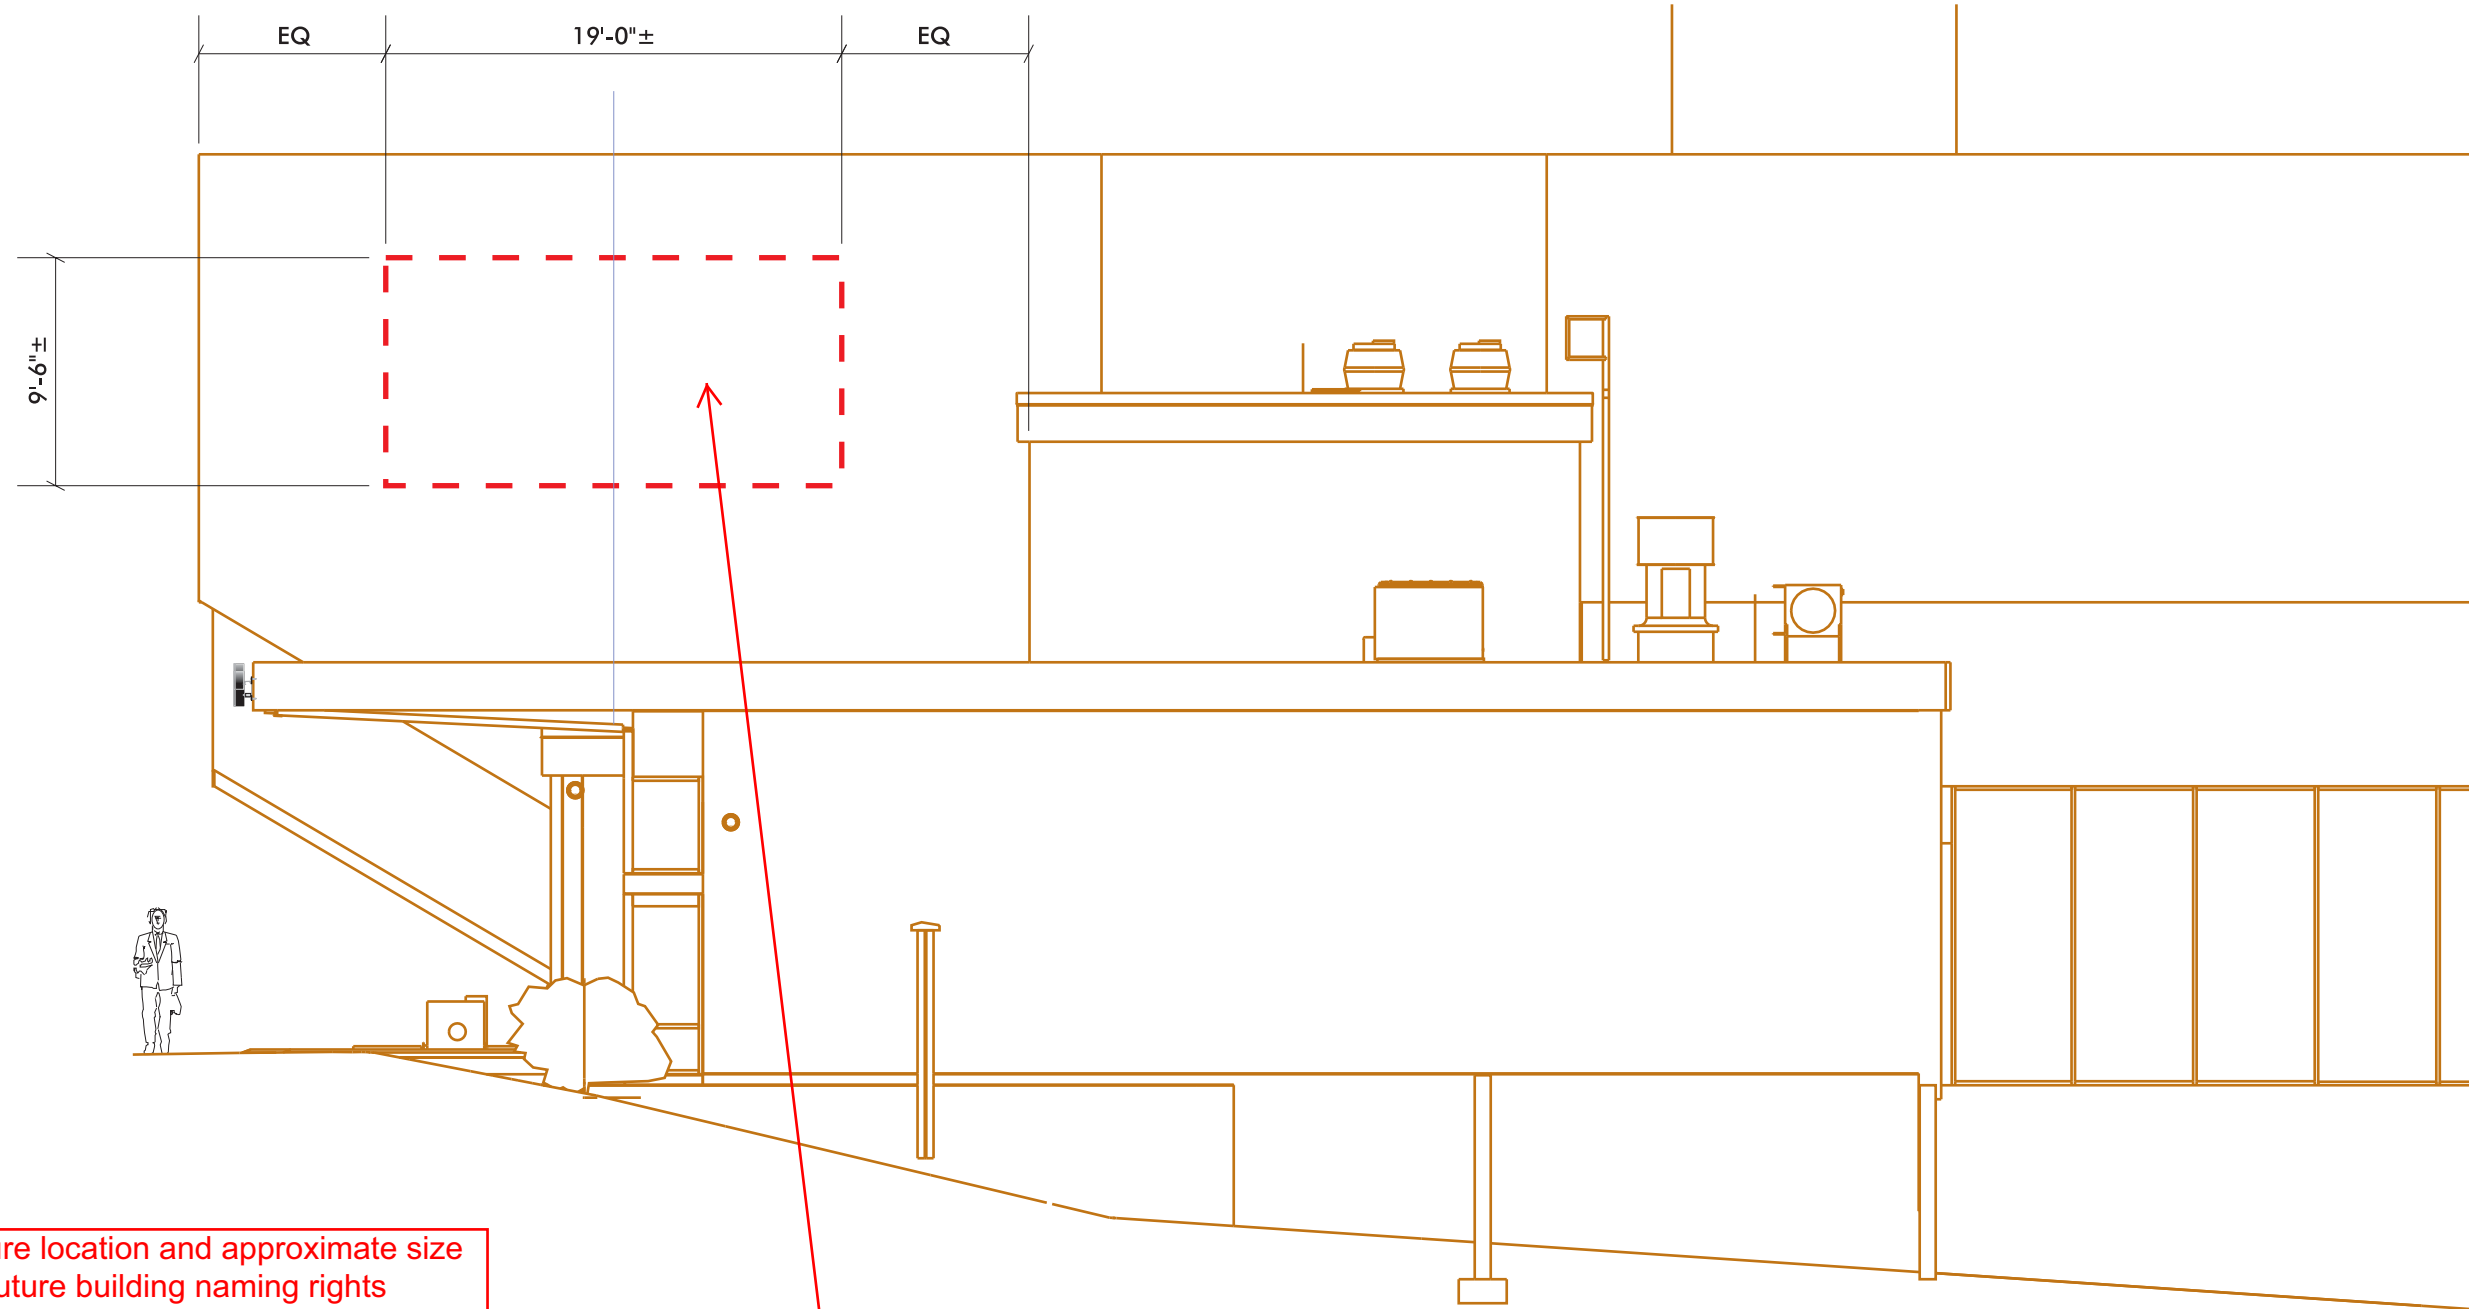

Future location and approximate size for future building naming rights partner signage. Final Building Naming Rights partner and layouts are yet to be determined.

WEST ELEVATION AT FREE STREET—NAMING RIGHTS WALL ID
 SCALE: 1/8"=1'-0" NAME RIGHTS ID (2) OF (3)

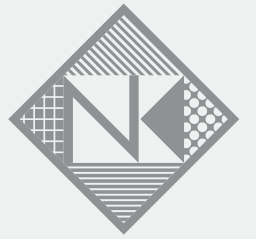

Neokraft
 S I G N S

Neokraft Signs Inc.
 686 Main Street
 Lewiston, Maine 04240
 Telephone: 207.782.9654
 Facsimile: 207.782.0009
 1.800.339.2258
<http://www.neokraft.com>

Custom Sign Fabrication

These plans are the exclusive property of Neokraft Signs, Inc. and are the result of the original work of its employees. They are submitted to Neokraft's client for the sole purpose of consideration of whether to purchase these plans or to purchase from Neokraft a sign manufactured according to these plans.

Distribution or exhibition of these plans to anyone other than employees of said client, or use of these plans to construct a sign similar to the one embodied herein, is expressly forbidden. In the event that such exhibition or construction occurs, Neokraft expects to be reimbursed \$1500 in compensation for time and effort entailed in creating these plans.

**Cumberland County
 Civic Center
 ML020258**

PERMIT

Location: 1 Civic Center Square
 Portland, ME

Drawing Set: Master Sign Plan

Drawing No.: 8 of 9

Drawn by: DS Rep.: RM

Date: 02.26.2014

Revised: 02.27.2014

Lead No.: ML020258

Gen Ref.: 17890, 17799

There is no Marquee planned for this entry.

Fixed fascia mounted letters. See details on following pages. Final entrance naming will be 'Bath Savings Entrance'

Future location for building naming rights partner signage. See detail on following pages.

Southwest Entrance





Neokraft
SIGN S

Neokraft Signs Inc.
686 Main Street
Lewiston, Maine 04240
Telephone: 207.782.9654
Facsimile: 207.782.0009
1.800.339.2258
<http://www.neokraft.com>

Custom Sign Fabrication

These plans are the exclusive property of Neokraft Signs, Inc. and are the result of the original work of its employees. They are submitted to Neokraft's client for the sole purpose of consideration of whether to purchase these plans or to purchase from Neokraft a sign manufactured according to these plans.

Distribution or exhibition of these plans to anyone other than employees of said client, or use of these plans to construct a sign similar to the one embodied herein, is expressly forbidden. In the event that such exhibition or construction occurs, Neokraft expects to be reimbursed \$1500 in compensation for time and effort entailed in creating these plans.

**Cumberland County
Civic Center**
ML020258

PERMIT

Location: 1 Civic Center Square
Portland, ME

Drawing Set: Master Sign Plan

Drawing No.: 4 of 9

Drawn by: DS Rep.: RM

Date: 02.26.2014

Revised: 02.27.2014

Lead No.: ML020258

Gen Ref.: 17890, 17799



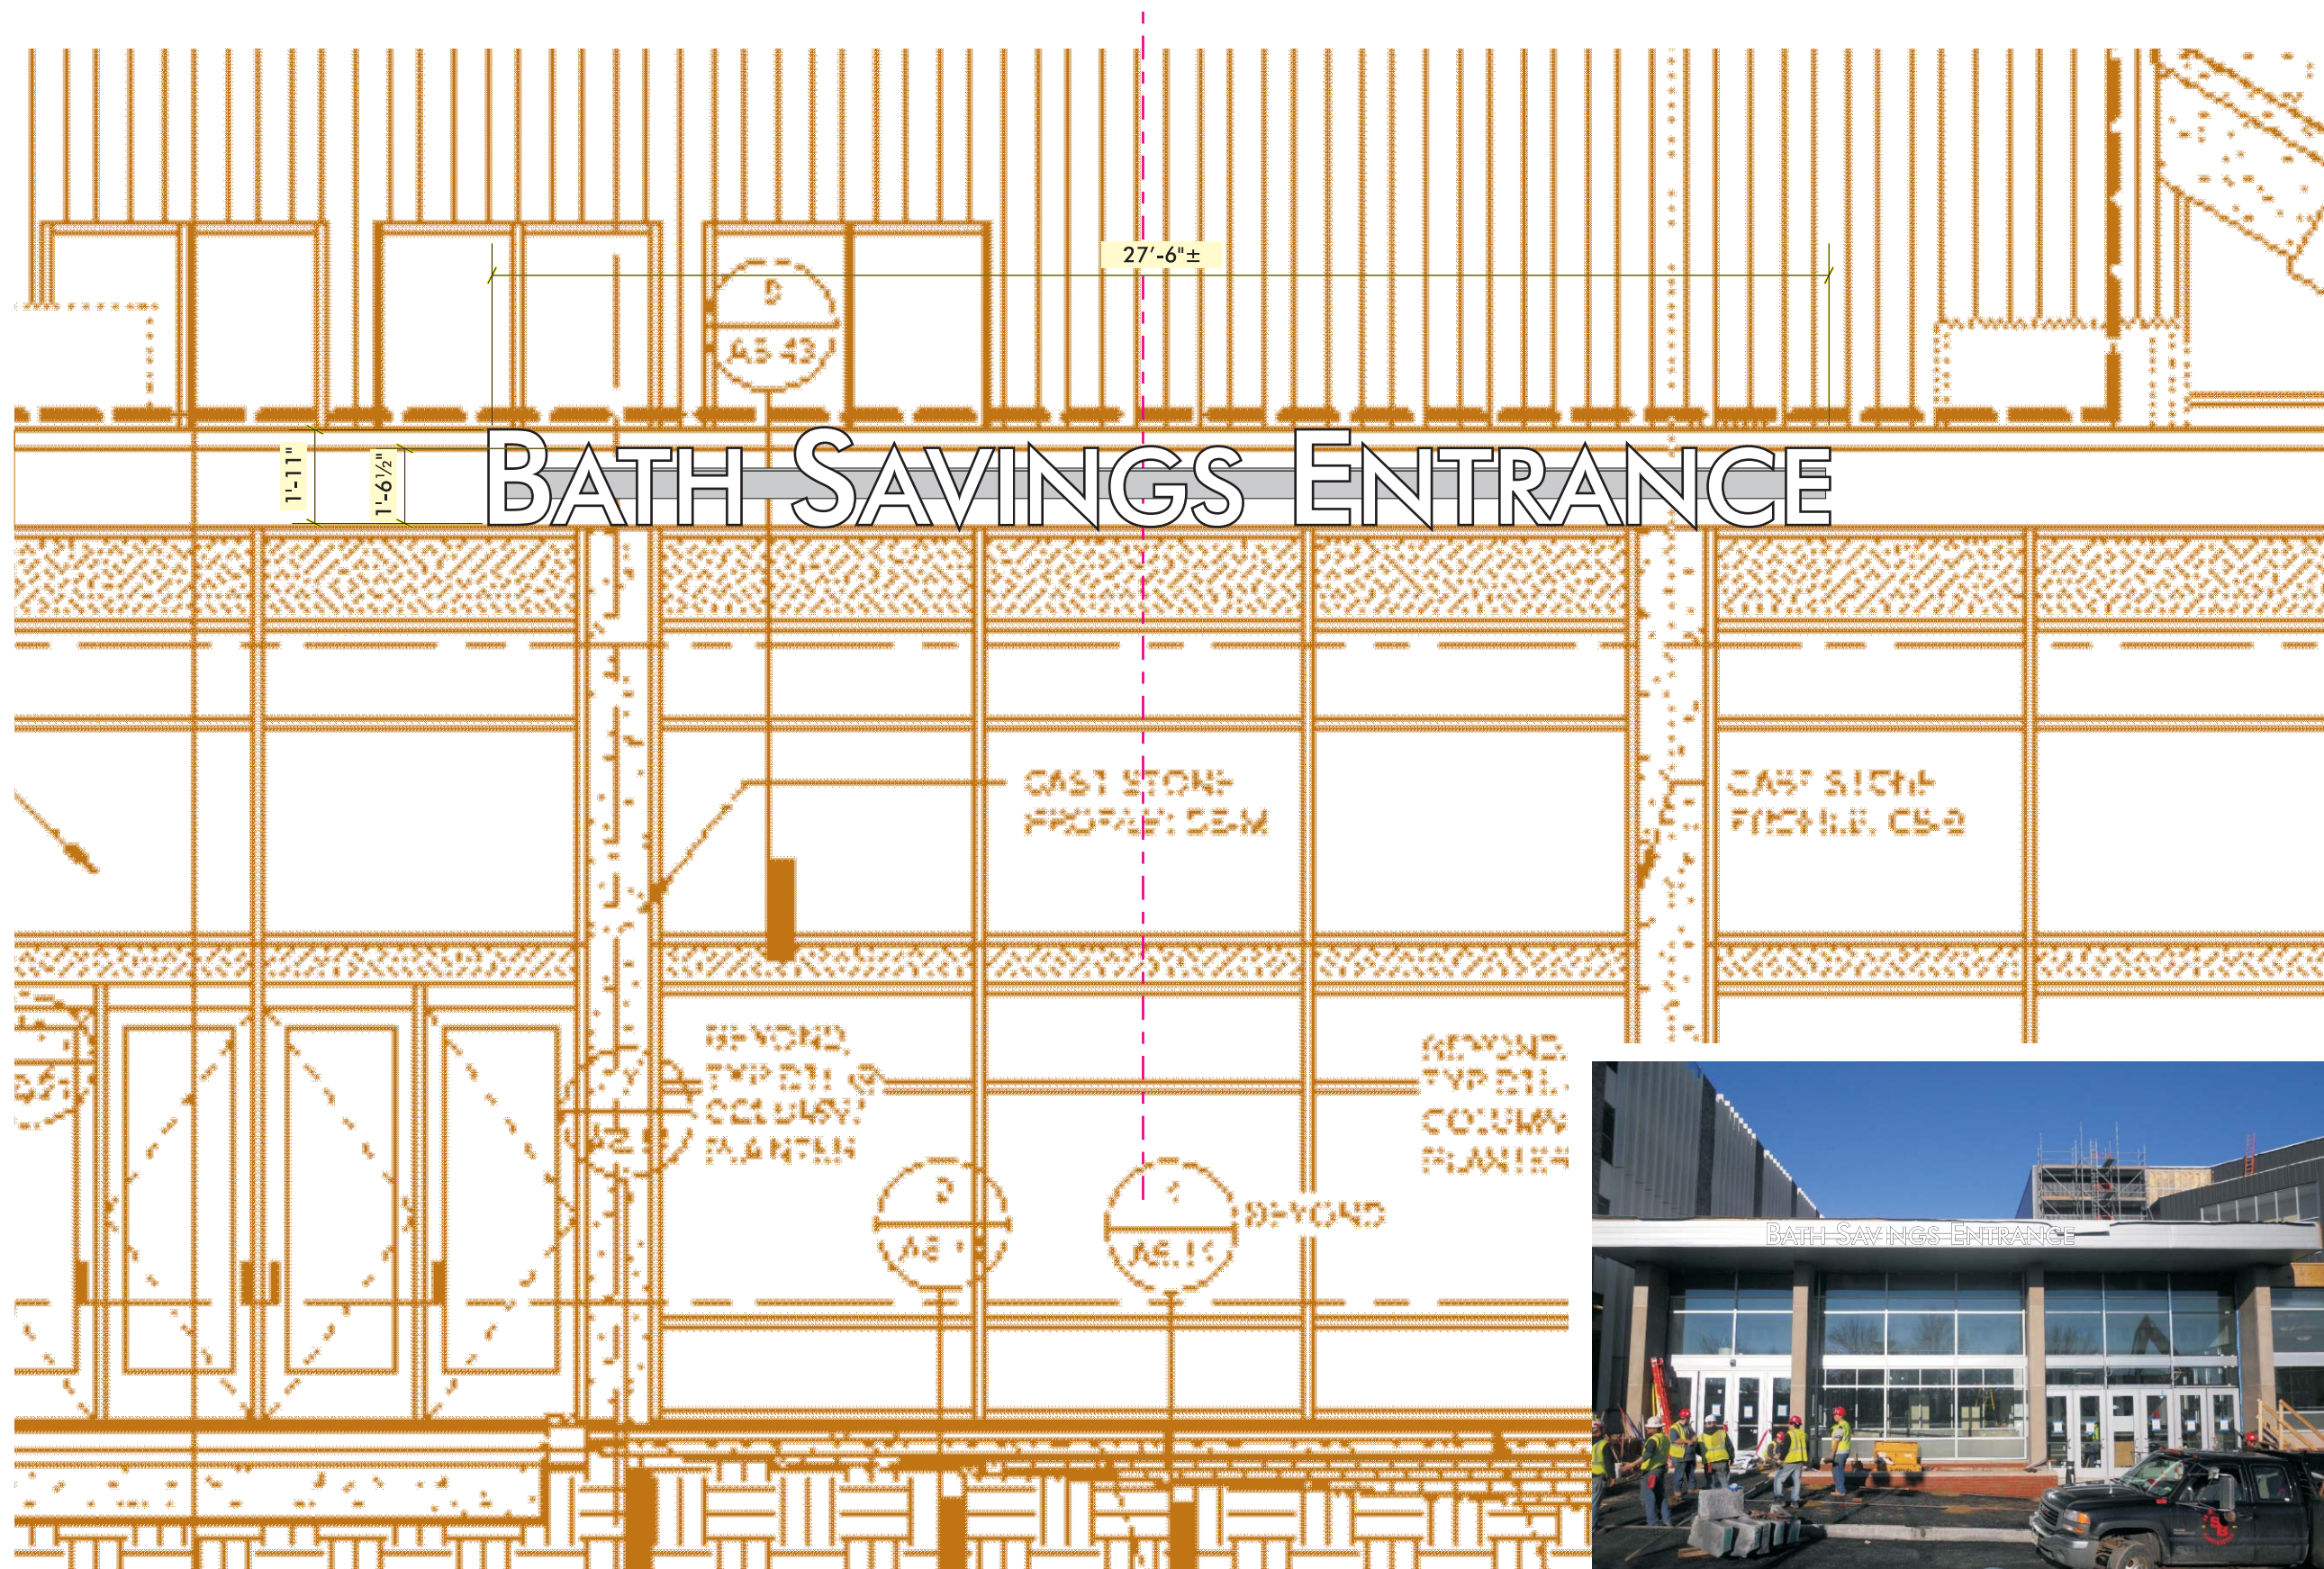


PHOTO COMPOSITE
NO SCALE

ENTRY ID 2 OF 3—SPRING STREET ELEVATION—INT. ILLUM. ENTRY ID LETTERS ON FASCIA

SCALE: 1/4" = 1'-0"



(1) SET REQUIRED

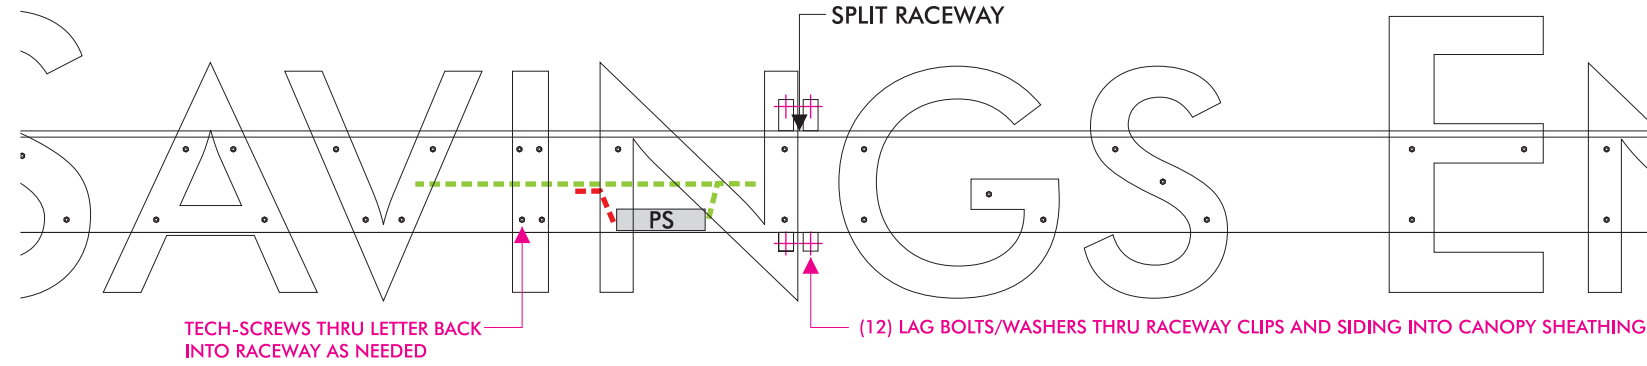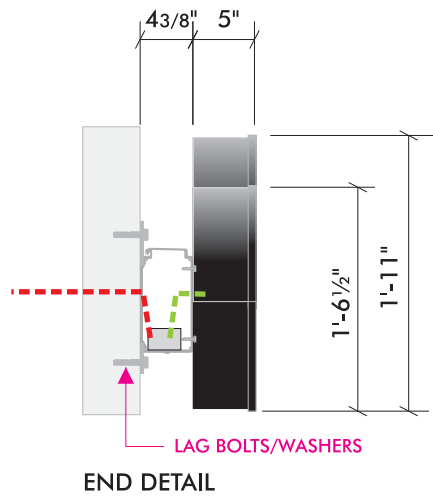

FABRICATED ALUMINUM LETTERS - 5" DEEP BLACK ALUMINUM RETURNS, 3/16" WHITE ACRYLIC FACES WITH 1" BLACK TRIM-CAP, WHITE 'LED' ILLUMINATION, LETTERS MOUNTED ON RACEWAY #1981, 1982N, 1986N, POWER SUPPLIES IN RACEWAY, ALUMINUM RACEWAY PAINTED TO MATCH FACADE (TBD),
ELECTRICAL TO SIGN BY OWNER (LOCATION TBD)

ENTRY ID 2 OF 3—DETAIL—FABRICATION/RACEWAY/ATTACHMENTS

SCALE: 3/4" = 1'-0"

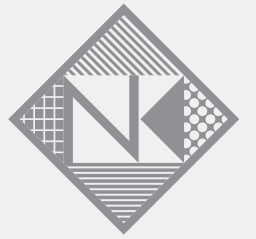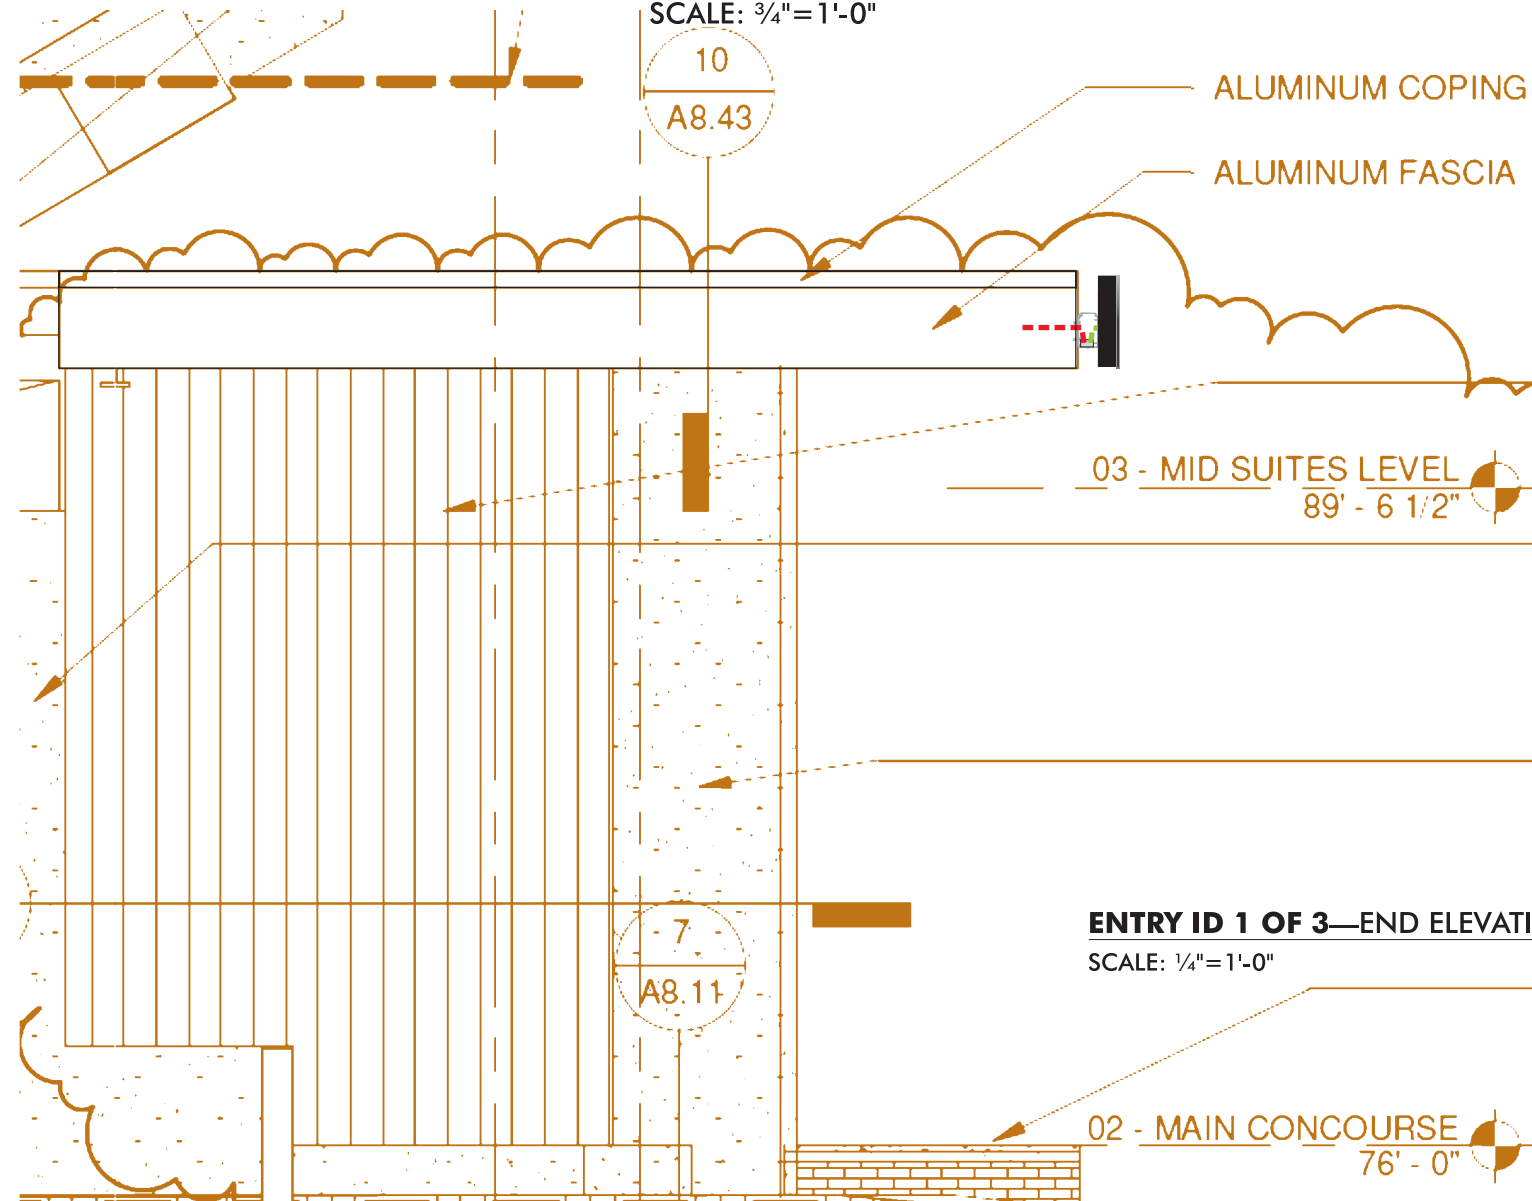

Neokraft
 SIGNS

Neokraft Signs Inc.
 686 Main Street
 Lewiston, Maine 04240
 Telephone: 207.782.9654
 Facsimile: 207.782.0009
 1.800.339.2258
<http://www.neokraft.com>


Custom Sign Fabrication

These plans are the exclusive property of Neokraft Signs, Inc. and are the result of the original work of its employees. They are submitted to Neokraft's client for the sole purpose of consideration of whether to purchase these plans or to purchase from Neokraft a sign manufactured according to these plans.

Distribution or exhibition of these plans to anyone other than employees of said client, or use of these plans to construct a sign similar to the one embodied herein, is expressly forbidden. In the event that such exhibition or construction occurs, Neokraft expects to be reimbursed \$1500 in compensation for time and effort entailed in creating these plans.

**Cumberland County
 Civic Center**
 ML020258

PERMIT	
Location:	1 Civic Center Square Portland, ME
Drawing Set: Master Sign Plan	
Drawing No.:	5 of 9
Drawn by:	DS Rep.: RM
Date:	02.26.2014
Revised:	02.27.2014
Lead No.:	ML020258
Gen Ref.:	17890, 17799

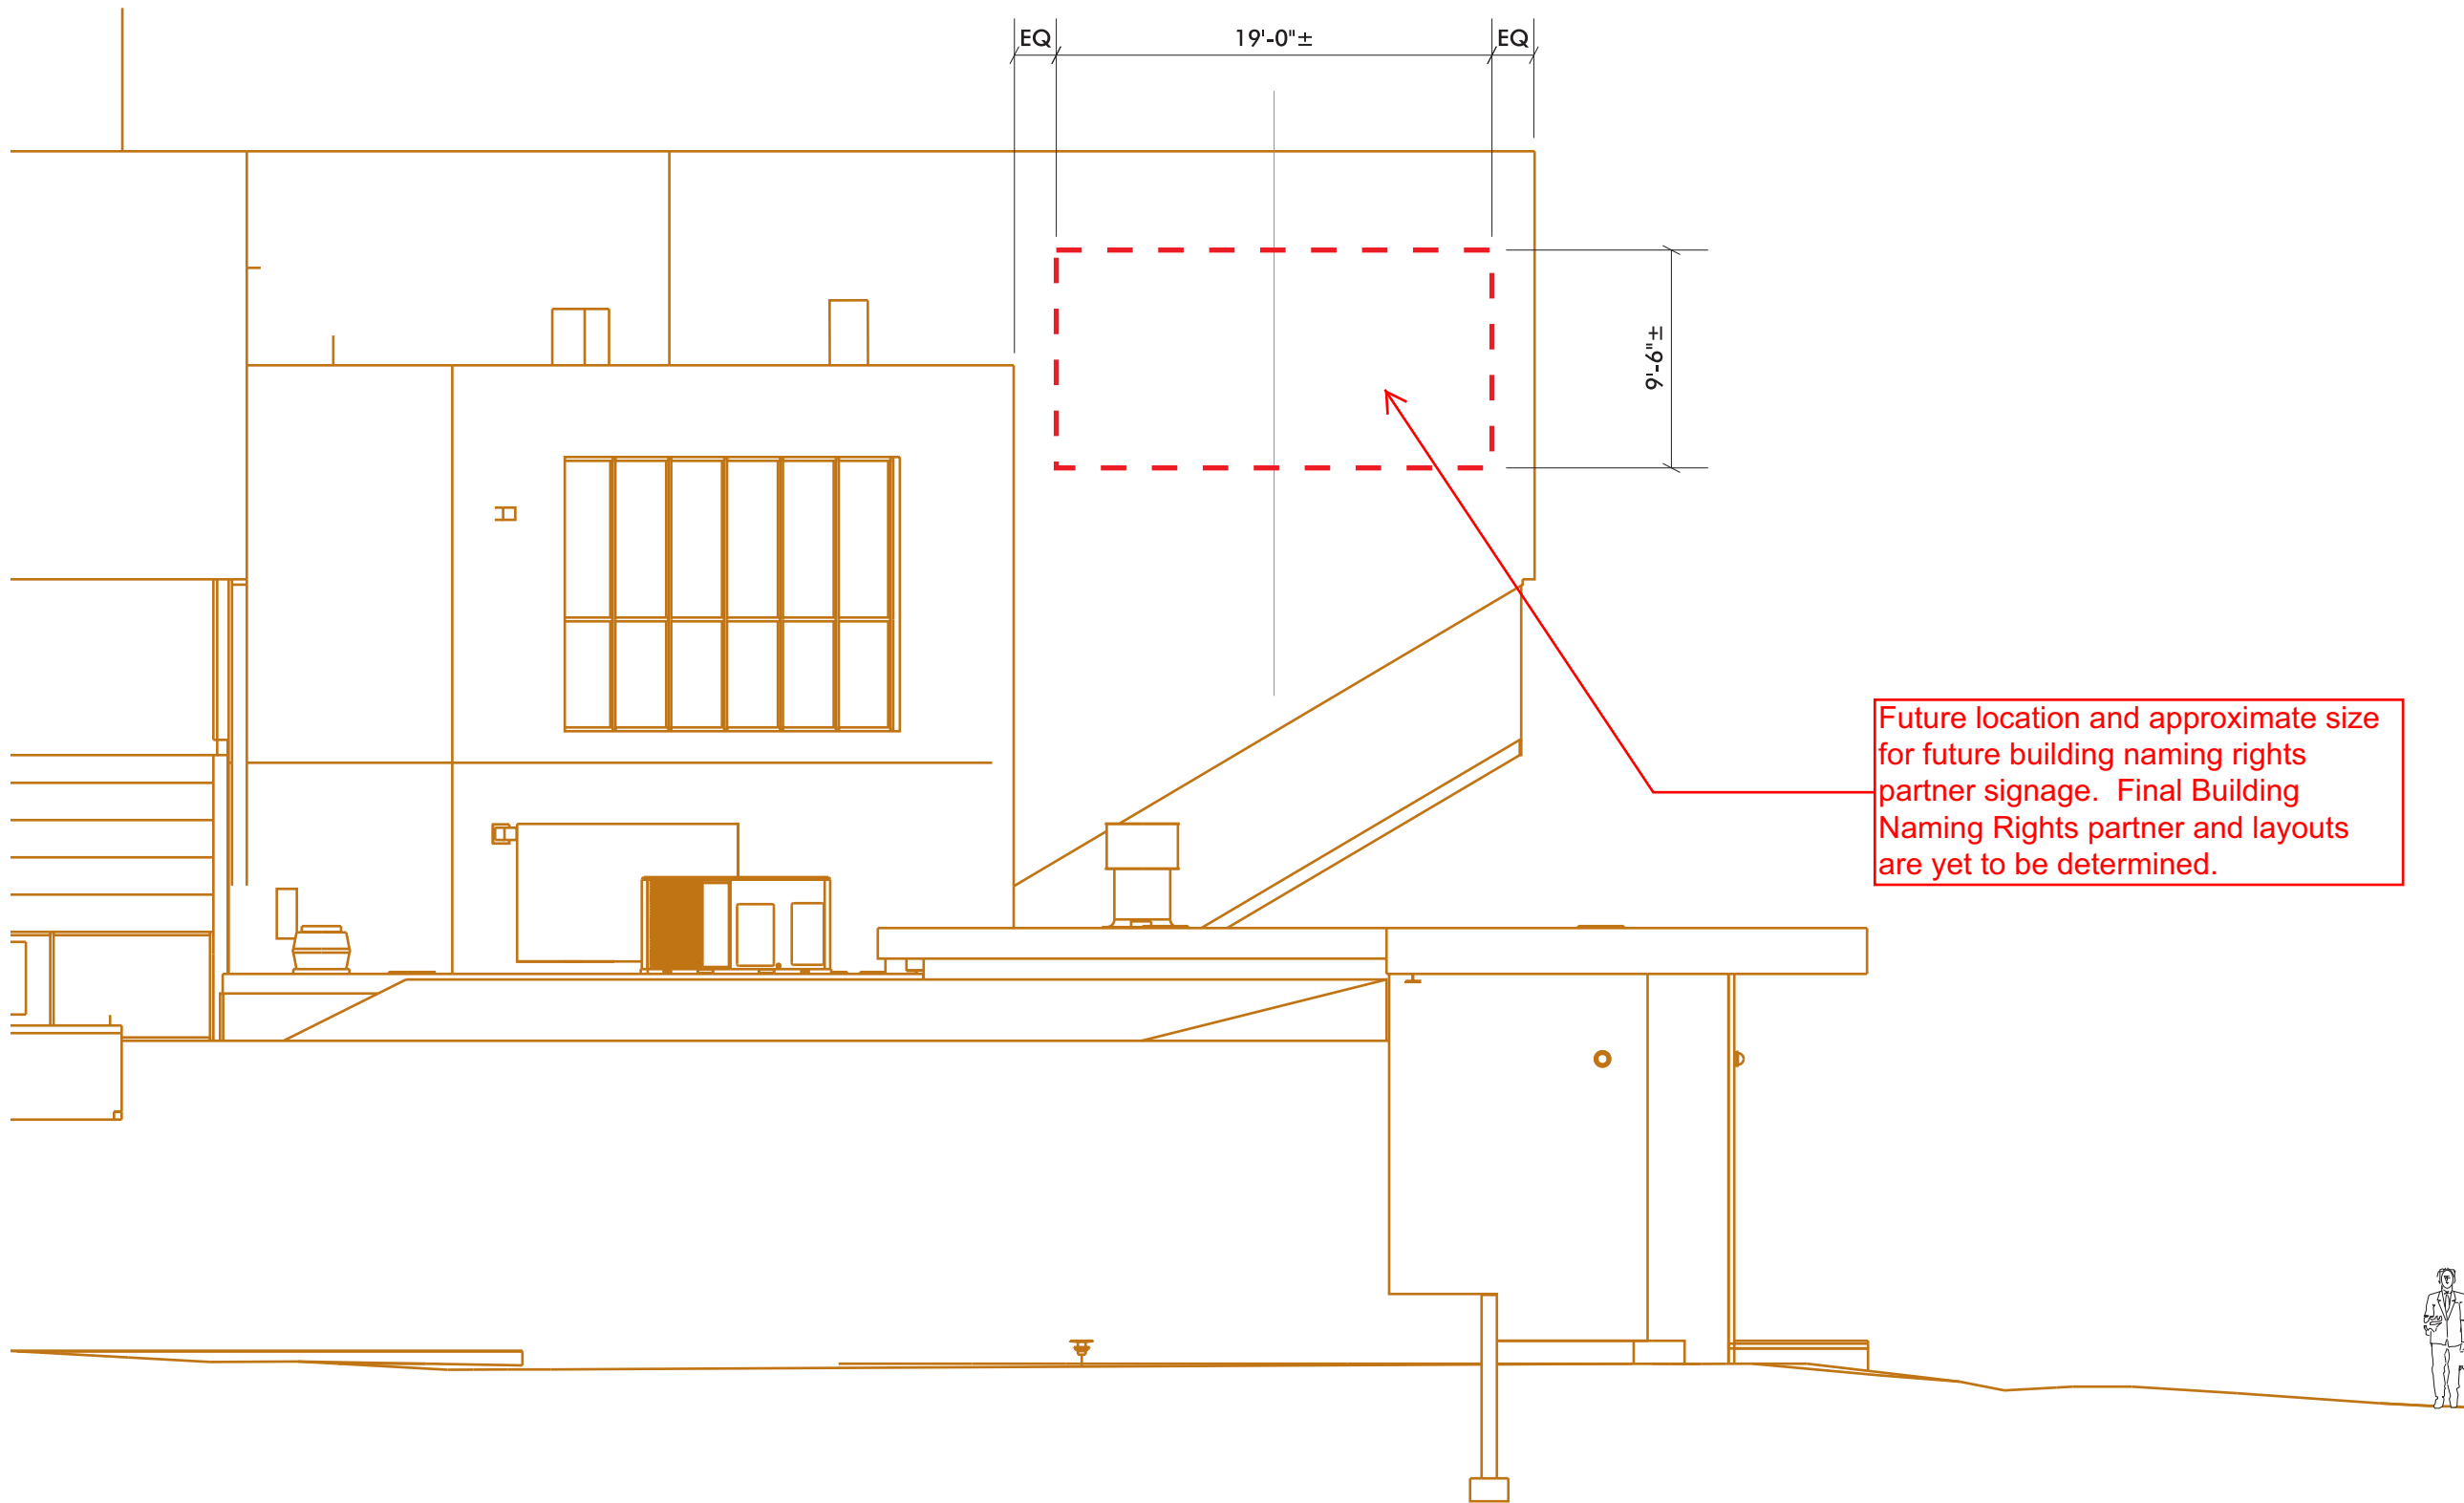

Future location and approximate size for future building naming rights partner signage. Final Building Naming Rights partner and layouts are yet to be determined.

WEST ELEVATION AT SPRING STREET—NAMING RIGHTS WALL ID
 SCALE: 1/8"=1'-0" NAME RIGHTS ID (3) OF (3)



Neokraft
 S I G N S

Neokraft Signs Inc.
 686 Main Street
 Lewiston, Maine 04240
 Telephone: 207.782.9654
 Facsimile: 207.782.0009
 1.800.339.2258
<http://www.neokraft.com>

Custom Sign Fabrication

These plans are the exclusive property of Neokraft Signs, Inc. and are the result of the original work of its employees. They are submitted to Neokraft's client for the sole purpose of consideration of whether to purchase these plans or to purchase from Neokraft a sign manufactured according to these plans.

Distribution or exhibition of these plans to anyone other than employees of said client, or use of these plans to construct a sign similar to the one embodied herein, is expressly forbidden. In the event that such exhibition or construction occurs, Neokraft expects to be reimbursed \$1500 in compensation for time and effort entailed in creating these plans.

**Cumberland County
 Civic Center**
 ML020258

PERMIT

Location: 1 Civic Center Square
 Portland, ME

Drawing Set: Master Sign Plan

Drawing No.: 9 of 9

Drawn by: DS Rep.: RM

Date: 02.26.2014

Revised: 02.27.2014

Lead No.: ML020258

Gen Ref.: 17890, 17799