

nop Drawing

20922

Job Name

J W Location

Date

Drawing No

Job Name: WCSH-TV

Location: CONGRESS ST., PTLP. ME

Date: 6-23-92 REV. 6-25-92

Drawing No: 2

STAIR SIDE WALL




Neokraft Signs Incorporated, 686 Main Street, Lewiston, Maine 04240
Manufacturers, Installers and Designers of Custom Electric, Neon, Plastic and Metal Signs
(207) 782-9654, FAX 782-0009

* ASBUILTS: 7/20/92

Remove 1/4" # 21000 BACKED UP
WITH TRANS. IVORY VINYL. THEN
THEN BACKED UP WITH LACRYL 152 LIGHT BROWN.
WHEN BACKING UP THE VERY WAY WITH IT.
PRINT WITH NAME THE PRINT ABOUT 5 POINTS
RECOMMEND TO 1 PART PRINT. DARK. 12 POINTS

EXIST'G. SIGN AT TOP OF STAIRTOWER
FAB'D. UNDER PREV. W/O # 11230 BT.

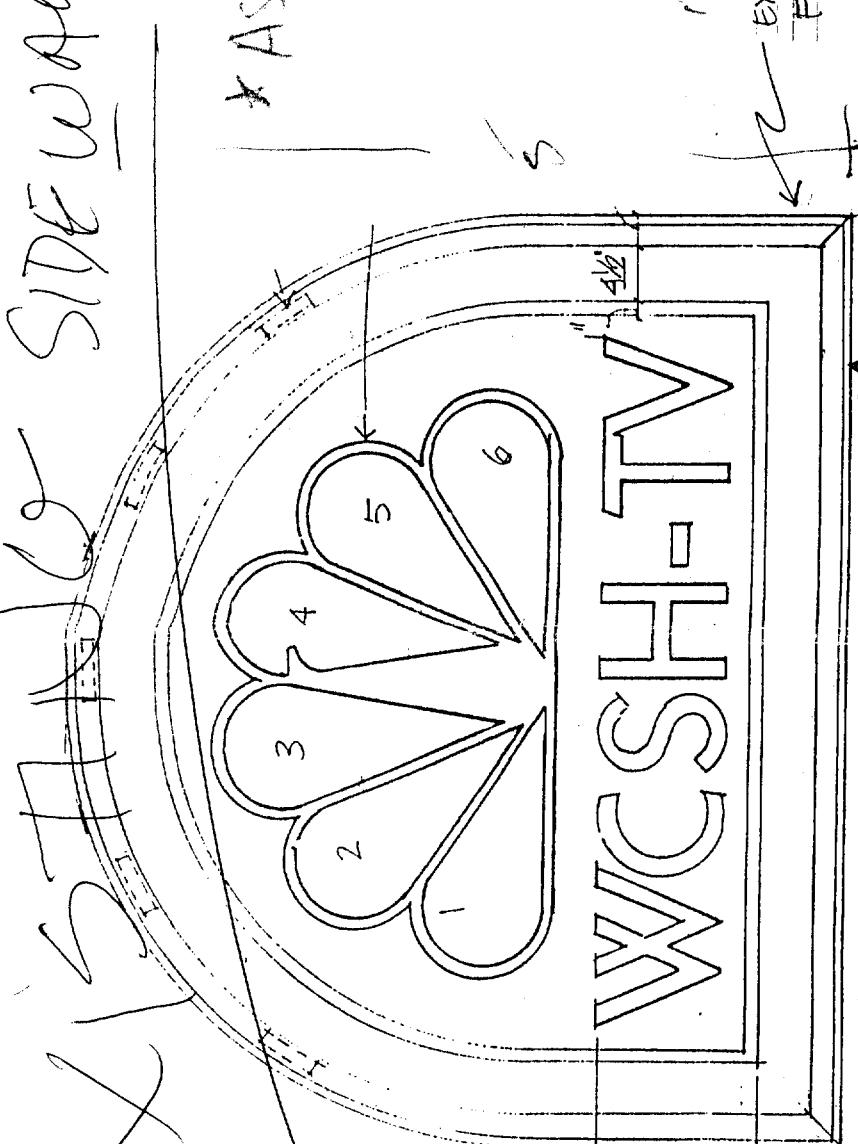


6 X 5.75 = 30 FT

FASCIA 6'-3 3/4" BKGD. V.O. BETW. BRICK

CAB. 6'-2 3/4" CRIT.

Face 3'-11 1/2" x 6'-2 1/4"

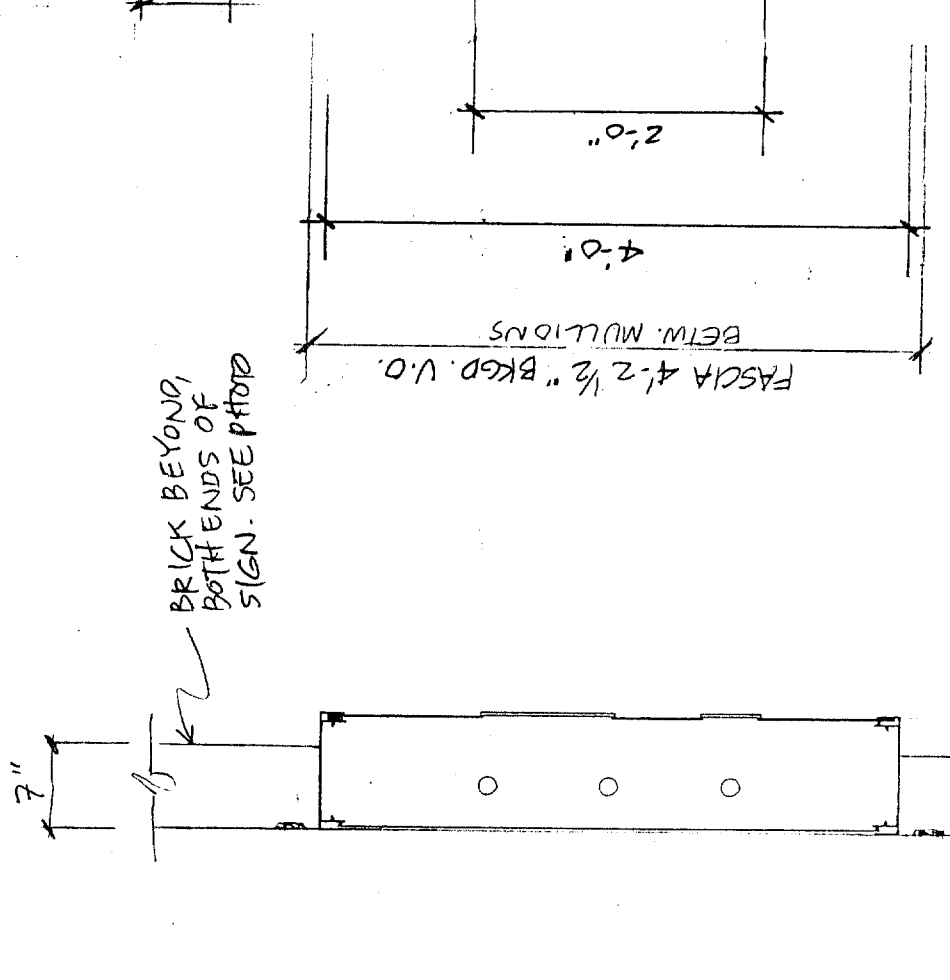

BRICK BEYOND,
BOTH ENDS OF
SIGN. SEE PHOTO

SECTION

3/4" = 1'-0"

4 x 6.19 = 24.76 FT

N/K TO CONNECT TO EXIST'G. ELEC.

Second surface Applied Ivory Vinyl Translucent
B/S with Light Brown

NEWSIGN ABC I D/H/O LAMPS, 600 MA BALLAST
CAB. & RET. DK. BRONZE 0.15"


FACE: 1/4" THK. ACRYLIC R&H BRONZE NO. 2370
B/S/P LIGHTLY ACRYLIC LT. BROWN
ROUTED (IN-LINED) EXCEPT AS REQ'D.
FOR MIN. STROKE -- SEE DWG. 2) COPY.

"6" : 1/4" THK. ACRYLIC R&H WHITE NO. 7328

"ALIVE!" W/ UNDERSCOPE : 1/4" THK. ACRYLIC
R&H ORANGE NO. 2119

COPY PER CAR ART. TO BE CUT BY OFFERSON,
(N/K TO SUPPLY ACRYLIC), COPY TO BE
APPLIED BY N/K.

S/F ILLUM. WALL SIGN W/ ROUTED, ACRYLIC COPY
3/4" = 1'-0"

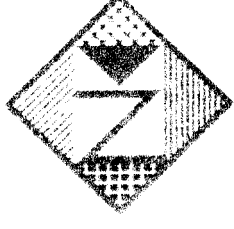

Neokraft
SIGN S

Neokraft Signs Inc.
686 Main Street
Lewiston, Maine 04240
Telephone: 207.782.9654
Facsimile: 207.782.0009
1.800.339.7258
<http://www.neokraft.com>
Custom Sign Fabrication

Except for designs supplied by the client, all ideas, plans or arrangements indicated on this drawing are copyrighted and owned by Neokraft Signs Inc. and shall not be reproduced, used by or disclosed to any person, firm, or corporation without written permission of Neokraft Signs Inc.

WCSH TV
02021

Location: 1 Congress Square
Portland, ME
Drawing No.: 1 of 1
Drawn by: PFAT
Date: 05.28.2004
Gen Ref:

9" DEEP SIGNCOMP 1 PART / 2 PART EXTRUDED ALUMINUM CABINET (#1923) WITH 1 5/8" DROP LIP RETAINERS (#1944), PAINT TO MATCH FACE
3/16" THICK TRANSLUCENT WHITE LEXAN FACE WITH FIRST SURFACE @SP TRANS DURANODIC BRONZE (230-69) VINYL BACKGROUND AND TRANSLUCENT WHITE KNOCKED OUT COPY
INSTALL IN WALL OPENING AS SHOWN

6'-2 3/4" CRITICAL



SINGLE FACE INTERNALLY ILLUMINATED WALL SIGN
SCALE: 3/4" = 1'-0"
(1) REQUIRED


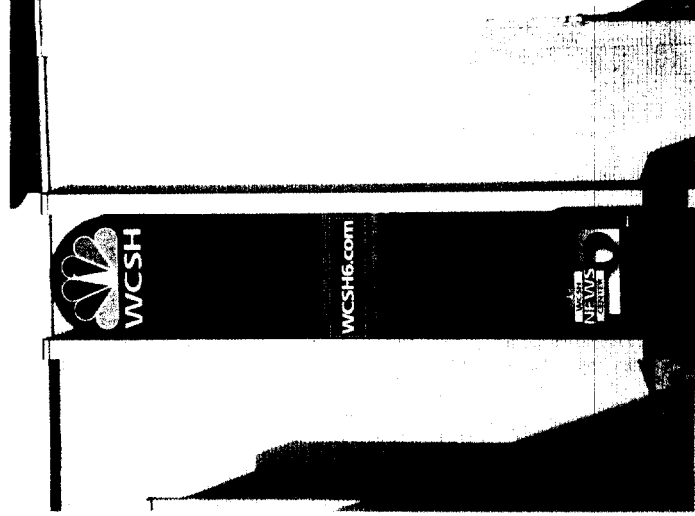


PHOTO COMPOSITE—PROPOSED
NOT TO SCALE

WALL AREA
 $40' \times 60' = 2400$ # STREET ELEVATION
 $40' \times 100' = 4000$ # PARKING LOT ELEVATION

NEWSSTAND

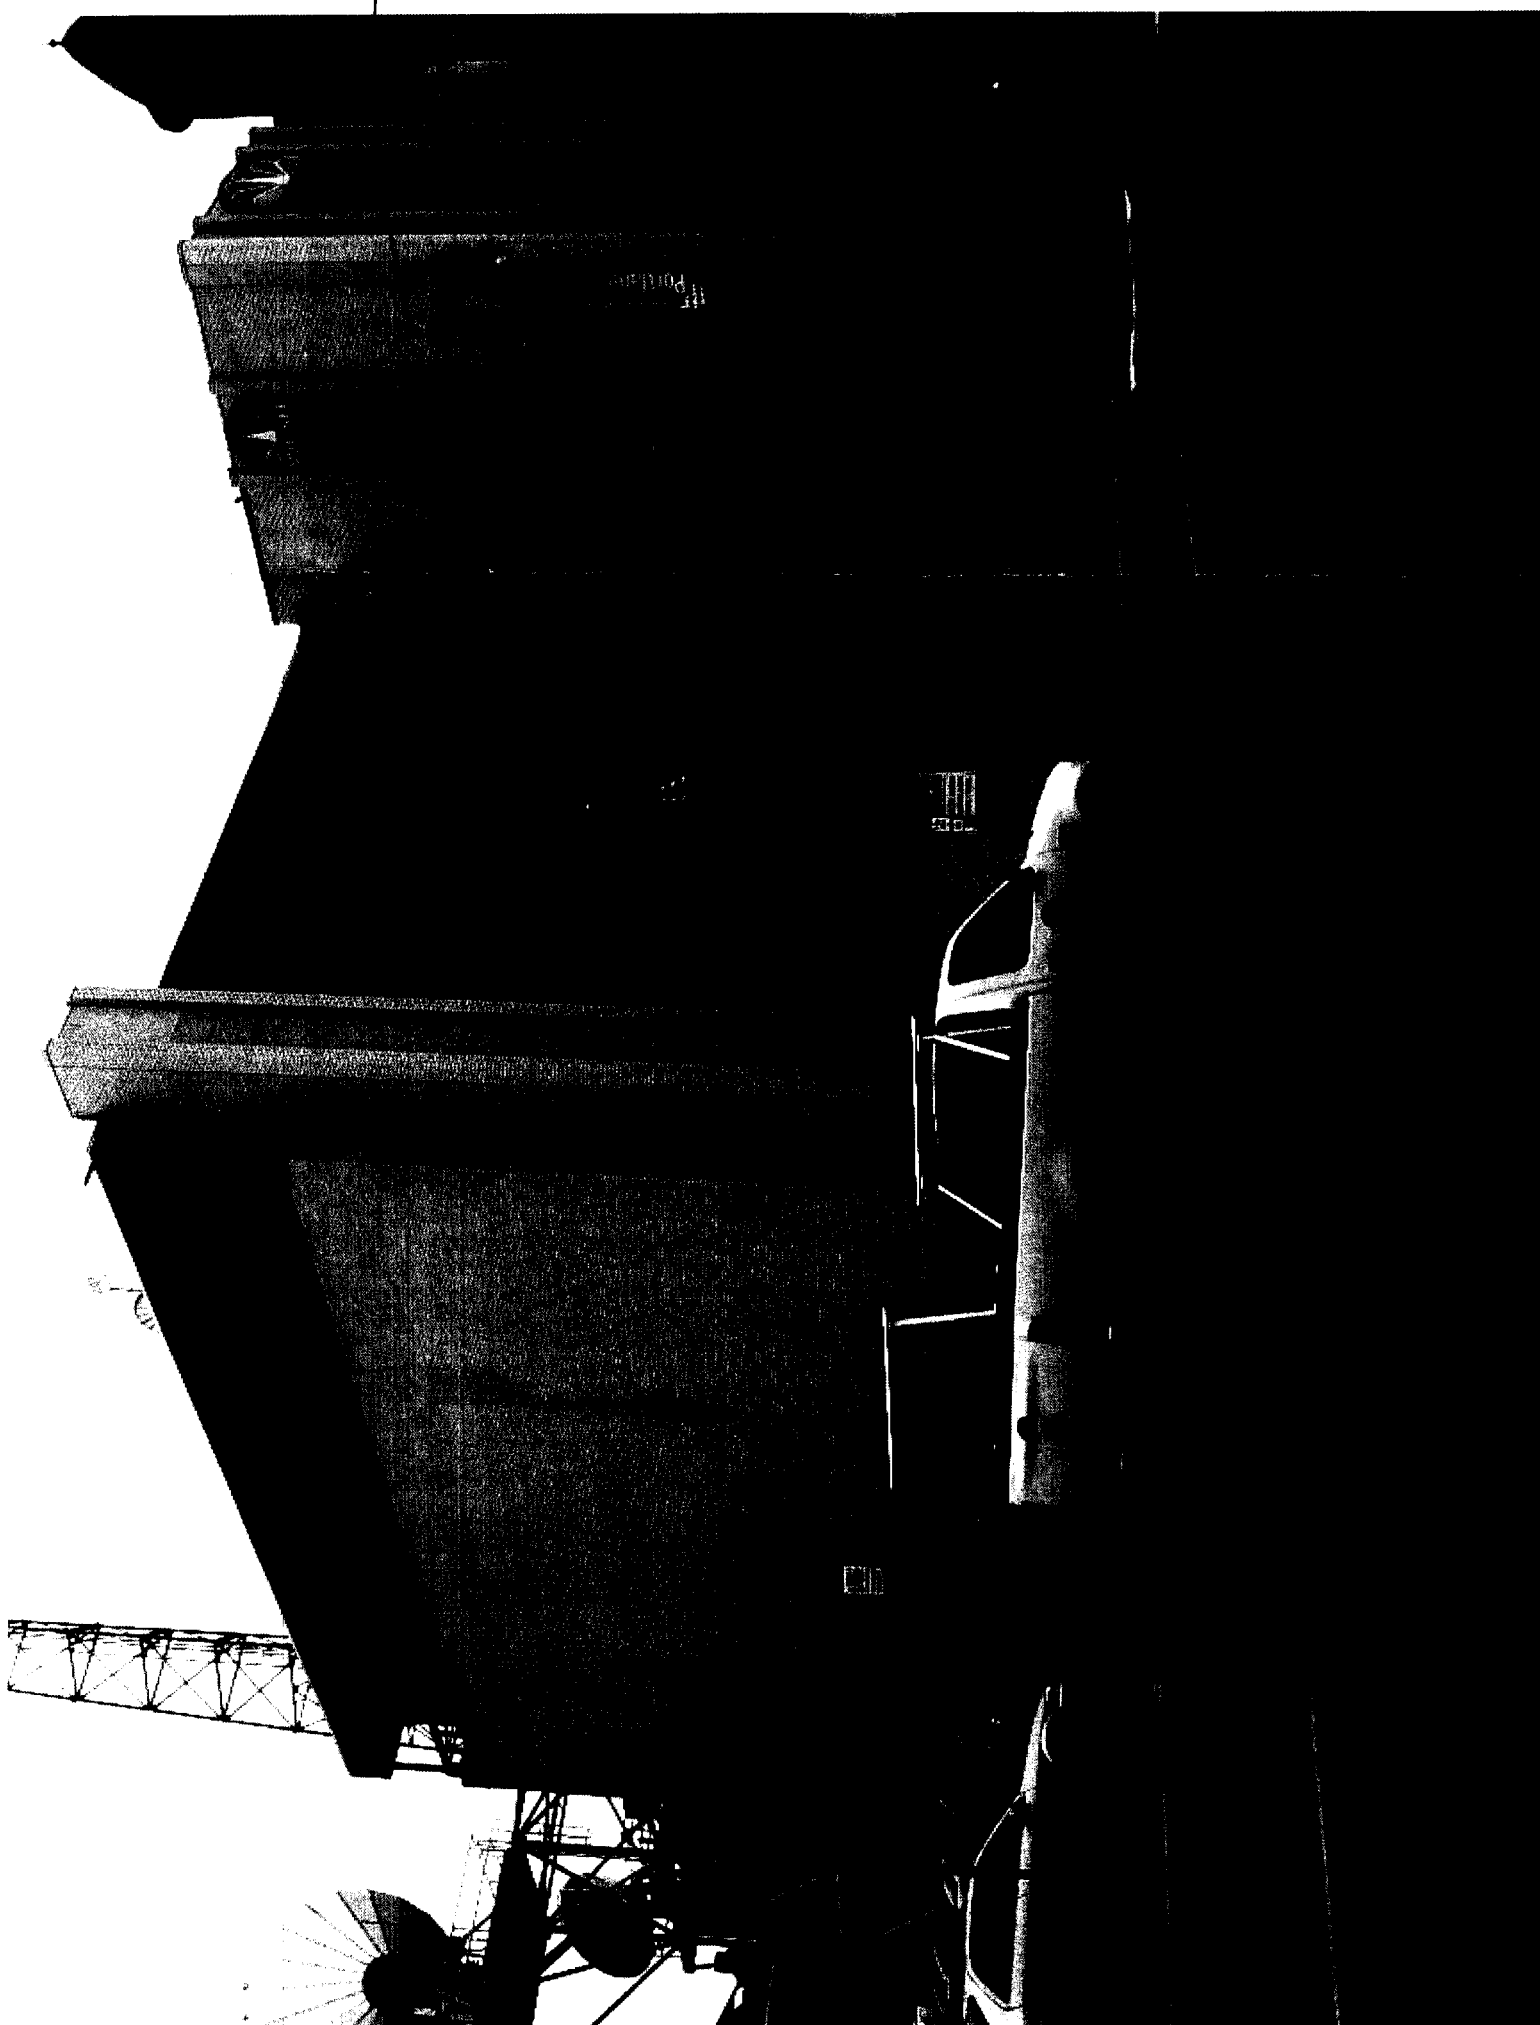

PERSPECTIVE VIEW

