

NOTE: FOR MORE DETAILS INFORMATION ON MEMBER SIZES, ANCHORING, BASEPLATES, ETC. REFERENCE STRUCTURAL DRAWINGS

location of wall washer

A6	CORNICE DETAIL & Light fixture	OCT 29 2007
1"=1'-0"	AE102, AE201, AE202	

6

7

8

9


10

OUTDOOR LIGHTING


EX-5 SERIES

EXTENDED ARM MOUNT
SINGLE LUMINAIRES

1 & 2 LAMP FLUORESCENT
T5, T5HO, T8, T8HO & LONG TWIN TUBE

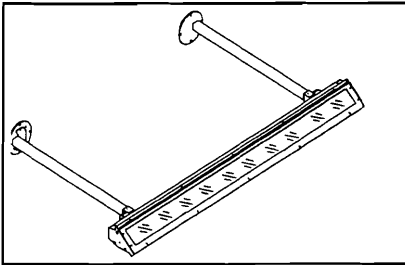

Ordering Information

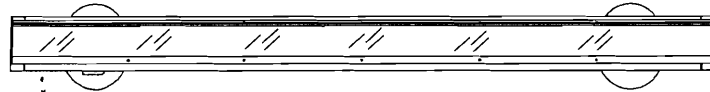

EX5 Exterior 5 - Linear Fluorescent

PREFIX ①

EAS Extended Arm Mount - Single Luminaire, 12' Maximum

MOUNTING ②

③	④	⑤	⑥	
Reflector Type	Lamp Type	Lamp Wattage	Available Luminaire Lengths	Total Number Of Lamps
SA Single Lamp 	T5	14W 21W 28W	2' 3', 6' 4', 8', 12'	1 1, 2 1, 2, 3
TA Twin Lamp 	T5	14W 21W 28W	2' 3', 6' 4', 8', 12'	2 2, 4 2, 4, 6
SA Single Lamp 	T5HO	24W 39W 54W	2' 3', 6' 4', 8', 12'	1 1,2 1,2,3
TA Twin Lamp 	T5HO	24W 39W 54W	2' 3', 6' 4', 8', 12'	2 2, 4 2, 4, 6
SA Single Lamp 	T8	17W 25W 32W	2' 3', 6' 4', 8', 12'	1 1, 2 1, 2, 3
SA Single Lamp 	T8HO **	44W 65W 86W	4', 8', 12' 6' 8'	1, 2, 3 1 1
SA Single Lamp 	LTT	40W 50W	2', 4', 6', 8', 12' 2', 4', 6', 8', 12'	1, 2, 3, 4, 6 1, 2, 3, 4, 6

For continuous runs, specify nominal run length in feet.

** See remote NEMA enclosure details for T8HO lamps.

REFLECTOR / LAMP / LUMINAIRE LENGTH

1 120V
2 277V
7 347V (Consult Factory)

VOLTAGE ⑦

TW Textured White
TBL Textured Black
TBR Textured Bronze
TN Textured Natural
TS Textured Sandstone
TV Textured Verdi
SF Specify Finish
CC Custom Finish (Contact Factory)

FINISH ⑧

PL Prismatic Acrylic Lens (8' Maximum)
PC Clear Polycarbonate Lens (8' Maximum)
LV Louver
VS Visor
DM Dimming Ballast * (120V or 277V only)
WCF Color Lens
1F Single Inline Fusing For 120V
BP Emergency Battery Pack
EM Emergency Circuit

* Not available with 55W, 80W LTT Lamps.

OPTIONS ⑨

ORDERING EXAMPLE

EX5 / EAS-24" / SA / T5HO / 54W / 8' / 2 / TS / PL
① ② ③ ④ ⑤ ⑥ ⑦ ⑧ ⑨

PREFIX	MOUNTING	REFLECTOR	LAMP	WATTAGE	LENGTH	VOLTAGE	FINISH	OPTIONS
EX5	EAS-_____							

Approved: _____

Job Name: _____

Type: _____

I N S I G H T



TEL: 505 345-0888 FAX: 505 345-3838
www.insightlighting.com



EX5-EAS
08/30/05

OUTDOOR LIGHTING

EX-5 SERIES

EXTENDED ARM MOUNT
SINGLE LUMINAIRES


1 & 2 LAMP FLUORESCENT
T5, T5HO, T8, T8HO & LONG TWIN TUBE

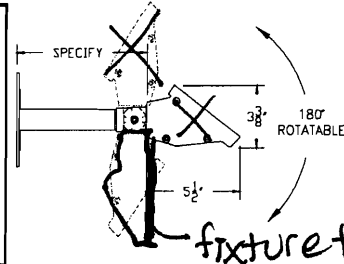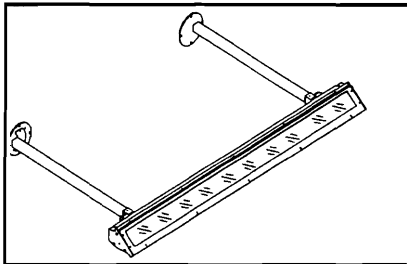


NOMINAL FIXTURE LENGTH (See drawings below)	2'	3'	4'	6'	8'	12'
'A'	26"	38"	50"	74"	98"	146"
'B'	14"	26"	38"	62"	50"	98"

fixture to be mtd. down & towards bldg.


2' - 6' Lengths

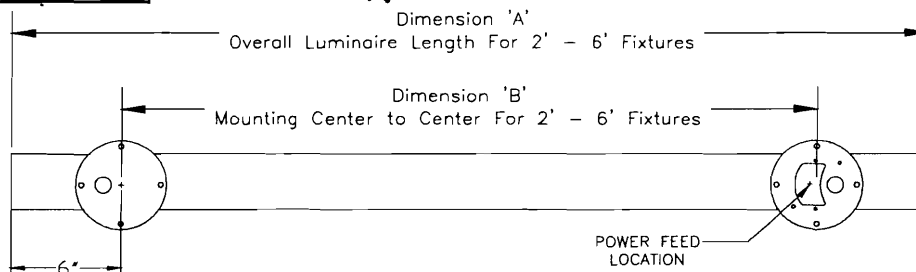


8' - 12' Lengths

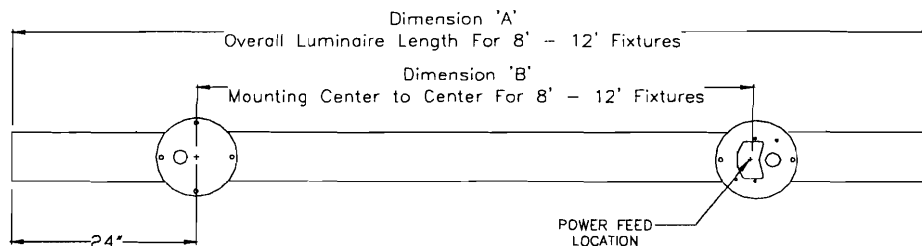

Mounting Plate Detail

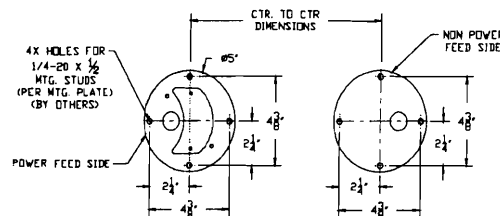

Nema Enclosure For T8HO Ballast
Minimum 18 Gauge wire,

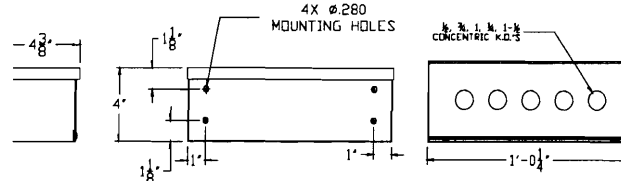

SPECIFICATIONS

Housing: An extruded aluminum housing, single piece die-cast aluminum end plates.

Mounting: Extruded aluminum arms attach to the luminaire with minimal hardware, allowing for adjustment of the rotatable housing. The wall bracket is heavy duty gauge aluminum supplied with a gasketed access cover to the J-box (by others) for ease of wiring. Additional structural support within the wall is required (by others). The luminaire is adjustable in 5 degree increments.

Lens: Hinged door assembly is supplied with a standard clear virgin acrylic lens and is held in place by pre-anodized extruded aluminum rails. Fasteners are retained to housing and door rail with stainless steel hardware. Stainless steel threaded inserts are used for similar metal fastening. Lens is sealed to housing with a single piece closed cell memory retentive silicone gasket.

Reflector: Computer aided, die cut and precisely formed reflectors are made of 95% high specular peened anodized aluminum.

Electrical: Ballasts are integral electronic, power factor greater than .90, thermally protected, less than 10% THD. Minimum starting temperature is 0° F (-20° F for T8HO ballast).

Finish: All painted surfaces are pretreated and polyester powder coated with UV inhibitors. Standard painted finishes are available in textured white, black, natural, bronze, satin and graphite.

Labels: Underwriters Laboratories and Canadian Standards approved for Wet Locations. IP65 Rated



Approved: _____

Job Name: _____

Type: _____

I N S I G H T



TEL: 505 345-0888 FAX: 505 345-3838
www.insightlighting.com

EX5-EAS
08/30/05

Certificate of Flame Resistance



ISSUED BY
Glen Raven Custom Fabrics, LLC
1831 North Park Avenue
Glen Raven, NC 27217

(Phone) 336/227-6211 (Fax) 336/229-4039

Date treated or
manufactured

7-09-2007

This is to certify that the materials described below have been flame-retardant treated (or are inherently nonflammable).

FOR

LEAVITT & PARRIS INC
256 READ STREET
PORTLAND
ME 041033446

Certification is hereby made that: (Check "a" or "b")



- (a) The articles described below this Certificate have been treated with a flame-retardant chemical approved and registered by the State Fire Marshal and that the application of said chemical was done in conformance with the laws of the State of California and the Rules and Regulations of the State Fire Marshal.

Name of chemical used _____ Chem. Reg. No. _____

Method of application _____



- (b) The articles described below are made from a flame-resistant fabric or material registered and approved by the State Fire Marshal for such use.

Trade name of flame-resistant fabric or material used

88031

FIRESIST HUV BURGUNDY

Reg. No. F-368.05

The Flame-Retardant Process Used WILL NOT Be Removed By Washing

Glen Raven Custom Fabrics, LLC

Name of Applicator or Production Superintendent

By

Steven L. Ellington

General Manager/Steven L. Ellington

Control Number 38391

Order Number 98455

PO Number

Invoice Number 1438564

Quantity 62.60

110 FREE STREET

Portland MAINE

Awning Detail

shop drawings

OCT 29 2007

where does this go?

@ 1 Awning (1st Floor)

@ 6 Awnings (1st Floor)

@ 4 Awnings (2nd/3rd Floors)

RECEIVED

OCT 24 2007

SMRT, Inc.

- Awning Colors -

88037 Sunbrella HUV Forest Green

ZACHAU CONSTRUCTION INC

JOB NAME: 110 FREE ST. & GARAGE
PORTLAND, MAINE

SUBMITTAL #: 7

DIVISION #: 10731 per AE601

ACTION: APPROVED ☒

APPROVED AS NOTED ☐

REVISE & RESUBMIT ☐

REJECTED ☐

COMMENTS:

BY: BWH DATE: 10/24/07

ROPE TRACK

reduce this one
to length of
loading dock +
steps - verify
length in field

LACE TO FRONT

40'

15'6"

6'6"


ROPE TRACK

WELDED FRAME


Lag

ATTACHMENT DETAIL -

110 FREE STREET
Portland ME
BANNER DETAIL
SHOP DRAWING

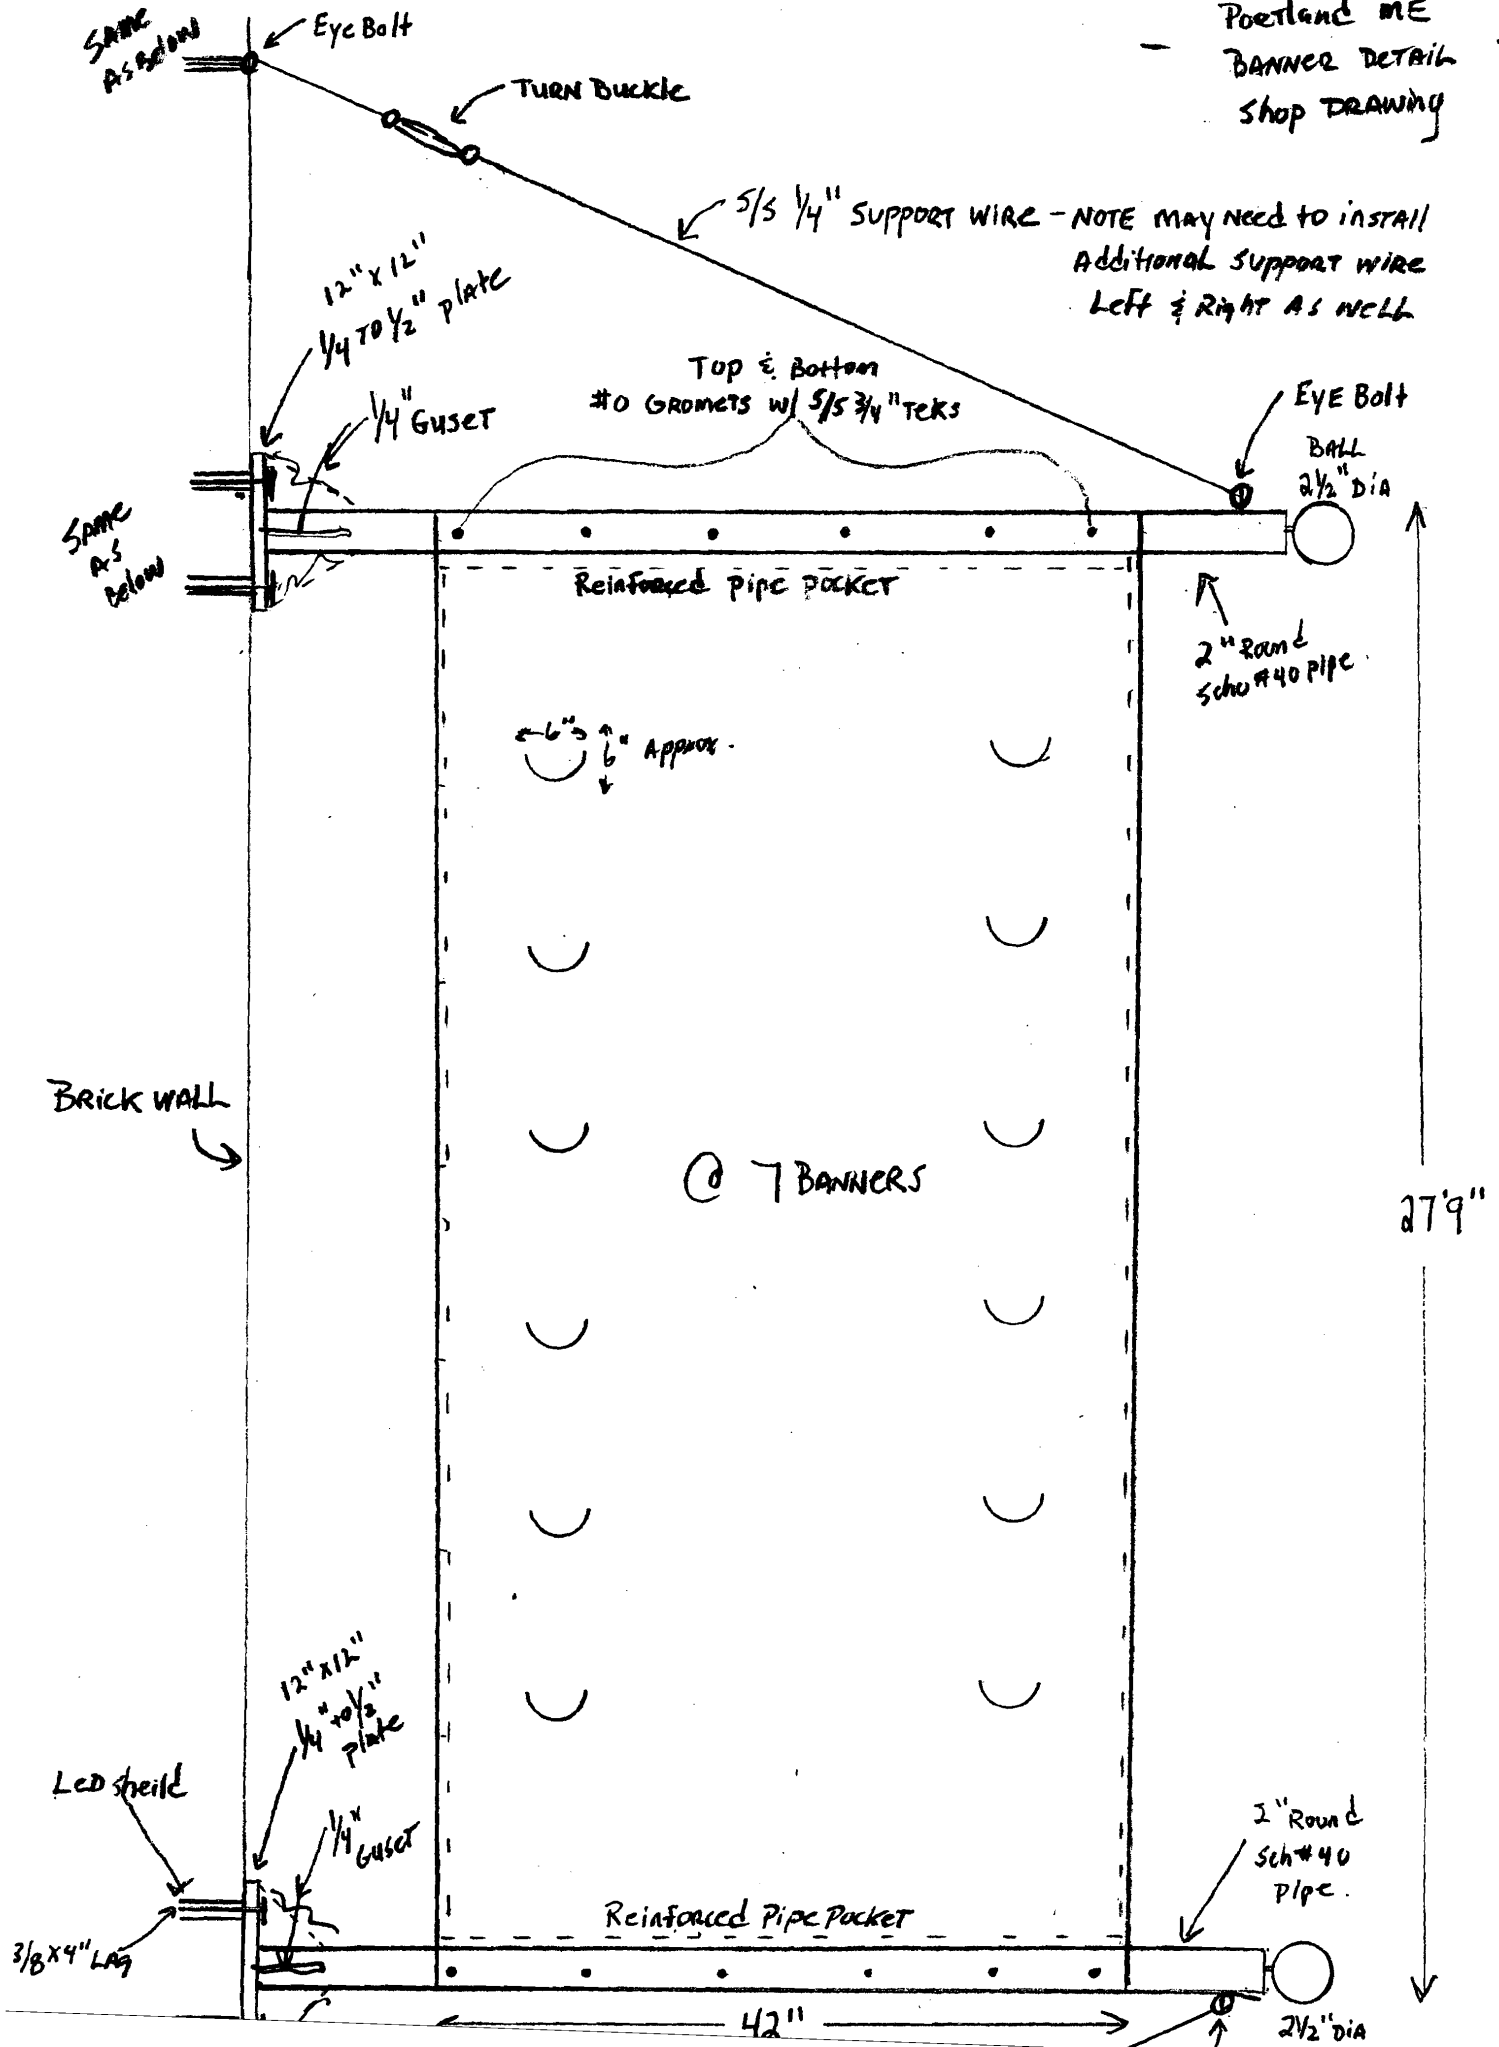

BAWNER BRACKET FRAME DET.
Shop Drawing

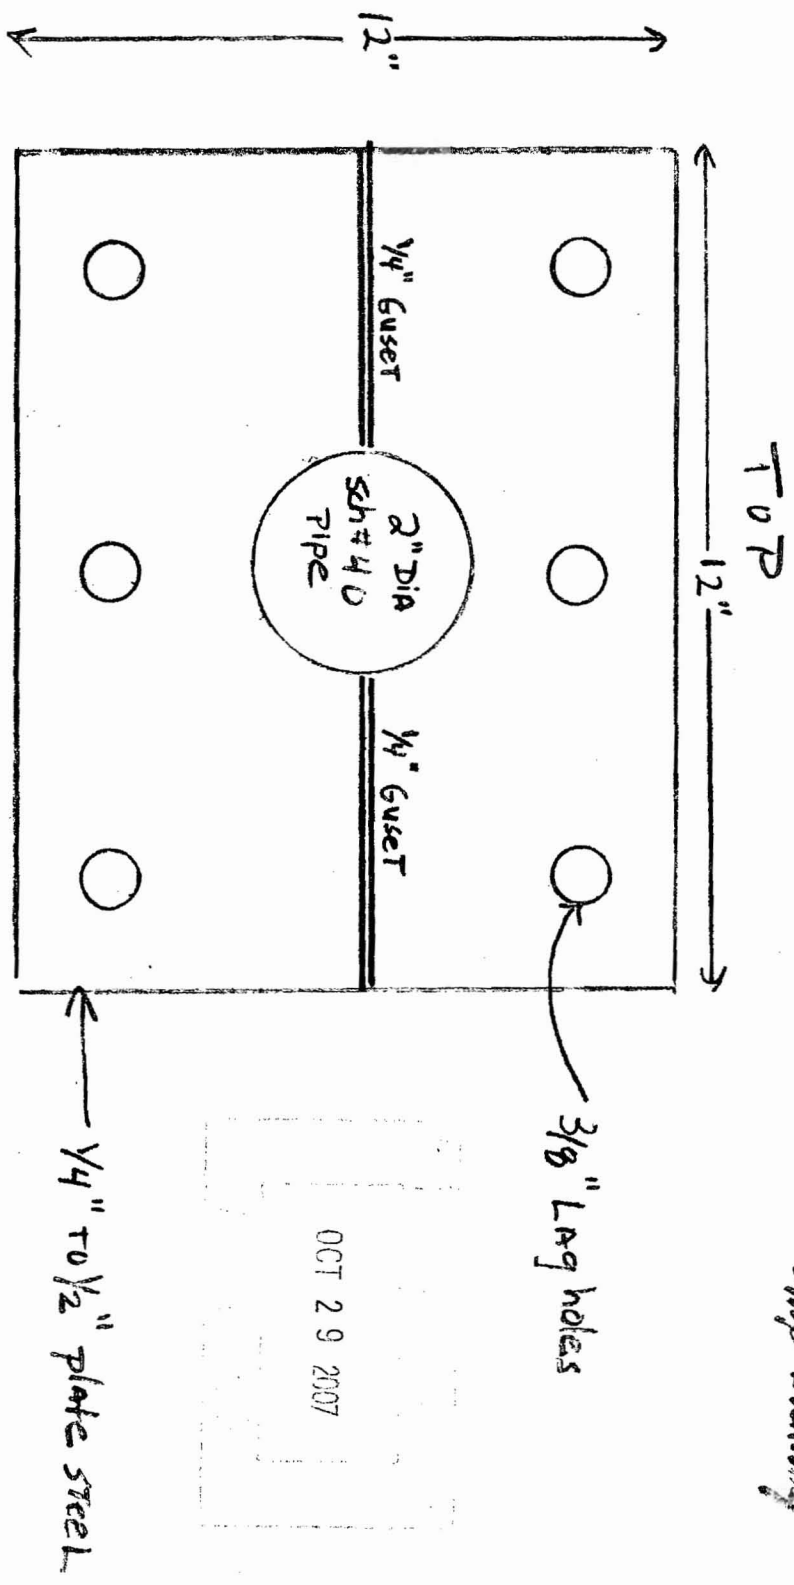

BAWNER COLORS (NON-FR SIMBALLA)

- #4656 SPRUCE
- #4657 FOREST GREEN
- #4605 HEMLOCK TONED
- #4600 ECHO GREEN
- #4645 SEAGRASS GREEN

OCT 29 2007



SPECIFICATIONS

DESCRIPTION:

Fabric woven from an inherently fire retardant polymer, backed with a durable urethane/acrylic coating.

WEIGHT:

9.5 oz. per square yard

WIDTH:

60"/ 152.4 cm

COLOR:

Very resistant to Ultraviolet rays & color degradation (see warranty). Most colors tested up to 1,500 hours in fadeometer with minimal or no change. Fade resistant to most chemicals.

DURABILITY/AVERAGE LIFE SPAN:

5 years (Depends on climate and proper use of fabric).

SURFACE:

Basket weave - soil/stain release finish.

UNDERSIDE:

Urethane/acrylic

TRANSPARENCY LEVEL:

Light shades translucent for good illuminated use.

ABRASION RESISTANCE:

Excellent

FLEXIBILITY:

Excellent in both hot and very cold conditions.
Will not crack.

FLAME RESISTANCE:

Firesist HUV is inherently flame retardant, passing the following flame retardant requirements:

California State Fire Marshal Title 19.

Section 13115. Registration #F-36805.

Section 1237. Test Procedure #801.

NFPA 701-99 Test Method 2.

CPAI-84: Tent walls and roof.

UFAC Upholstered Furniture. Class 1.

Outside North America: Consult Glen Raven for Specifications.

MILDEW RESISTANCE:

Excellent (if maintained and cleaned)

CHEMICAL RESISTANCE:

Excellent

WATER REPELLENCY:

Excellent

OIL RESISTANCE:

Good

SEWABILITY:


Excellent

HEAT SEALING:

Can be heat sealed using sealing tape & heat source such as radio frequency and wedge welders.

protection

you can feel

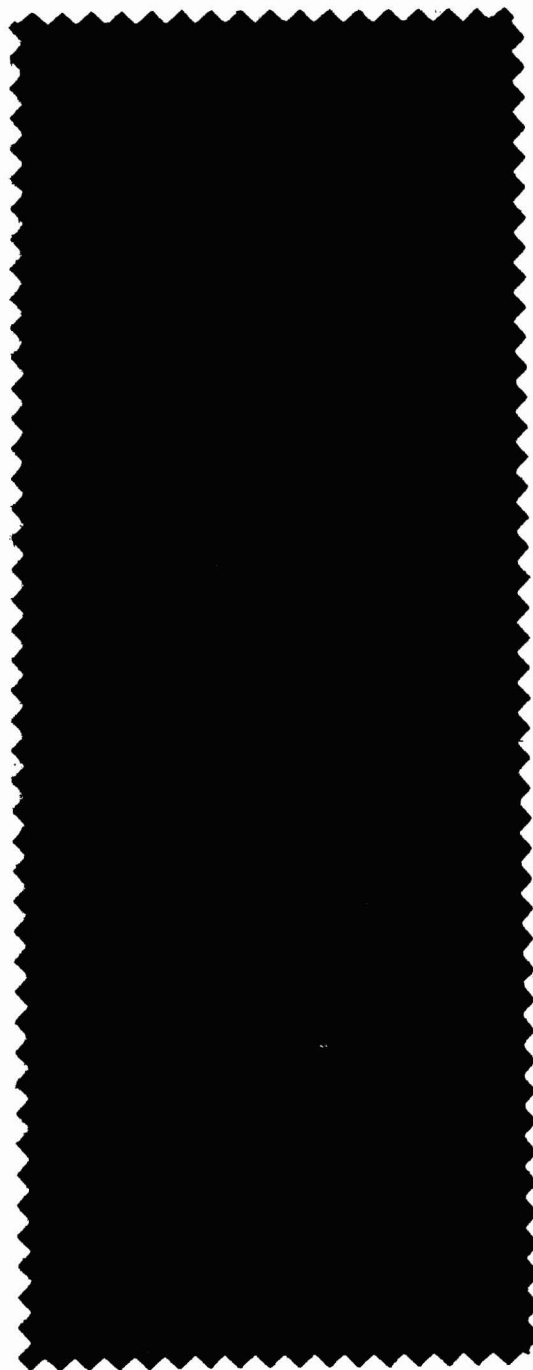

STYLE NO.

CRIMSON RED

88003-0000