

Permit # 940292 City of Portland BUILDING PERMIT APPLICATION

ION Fee 170.00 Zone _____ Map # _____ Lot # _____

Please fill out any part which applies to job. Proper plans must accompany form.

Owner: Holy Trinity Church Phone # _____
 Address: 133 Pleasant St Ptld, ME
 LOCATION OF CONSTRUCTION 133 Pleasant St
 Contractor: Grant Hayes Assoc. Sub.: _____
 Address: 184 Mayall Rd Gray, ME 04039 Phone # 657-4699
 Est. Construction Cost: 30,000. Proposed Use: Church w/elevator
 Past Use: Church
 # of Existing Res. Units _____ # of New Res. Units _____
 Building Dimensions L _____ W _____ Total Sq. Ft. _____
 # Stories: _____ # Bedrooms _____ Lot Size: _____
 Is Proposed Use: Seasonal _____ Condominium _____ Conversion _____
 Explain Conversion Const additinn to add an elevator as per plans

For Official Use Only

Date 11 April 1994 Subdivision: _____
 Inside Fire Limits _____ Name _____
 Bldg Code _____ Lot _____
 Time Limit _____ Ownership: _____ Public _____ Private _____
 Estimated Cost _____

PERMIT ISSUED
APR 20 1994
 CITY OF PORTLAND

Zoning:
 Street Frontage Provided: _____
 Provided Setbacks: Front _____ Back _____ Side _____
Review Required:
 Zoning Board Approval: Yes _____ No _____ Date: _____
 Planning Board Approval: Yes _____ No _____ Date: _____
 Conditional Use: _____ Variance _____ Site Plan _____ Subdivision _____
 Shoreland Zoning Yes _____ No _____ Floodplain Yes _____ No _____
 Special Exception _____
 Other (Explain) _____

039-D-009
Foundation:
 1. Type of Soil: _____
 2. Set Backs - Front _____ Rear _____ Side(s) _____
 3. Footings Size: _____
 4. Foundation Size: _____
 5. Other _____

Floor:
 1. Sills Size: _____ Sills must be anchored.
 2. Girder Size: _____
 3. Lally Column Spacing: _____ Size: _____
 4. Joists Size: _____ Spacing 16" O.C.
 5. Bridging Type: _____ Size: _____
 6. Floor Sheathing Type: _____ Size: _____
 7. Other Material: _____

Exterior Walls:
 1. Studding Size _____ Spacing _____
 2. No. windows _____
 3. No. Doors _____
 4. Header Sizes _____ Span(s) _____
 5. Bracing: Yes _____ No _____
 6. Corner Posts Size _____
 7. Insulation Type _____ Size _____
 8. Sheathing Type _____ Size _____
 9. Siding Type _____ Weather Exposure _____
 10. Masonry Materials _____
 11. Metal Materials _____

Interior Walls:
 1. Studding Size _____ Spacing _____
 2. Header Sizes _____ Span(s) _____
 3. Wall Covering Type _____
 4. Fire Wall if required _____
 5. Other Materials _____

Ceiling:
 1. Ceiling Joists Size: _____
 2. Ceiling Strapping Size _____ Spacing _____
 3. Type Ceilings: _____
 4. Insulation Type _____ Size _____
 5. Ceiling Height: _____

Roof:
 1. Truss or Rafter Size _____ Span _____
 2. Sheathing Type _____ Size _____
 3. Roof Covering Type _____

Chimneys:
 Type: _____ Number of Fire Places _____
 Date: _____
 Signature: _____

Heating:
 Type of Heat: _____

Electrical:
 Service Entrance Size: _____ Smoke Detector Required Yes _____ No _____

Plumbing:
 1. Approval of soil test if required Yes _____ No _____
 2. No. of Tubs or Showers _____
 3. No. of Flushes _____
 4. No. of Lavatories use Group A-4 Type 3-B
 5. No. of Other Fixtures _____

Swimming Pools:
 1. Type: _____
 2. Pool Size: _____ x _____ Square Footage _____
 3. Must conform to National Electrical Code and State Law.

Permit Received By Mary Greath

Signature of Applicant Michael Hayes Date 11 Apr '94

CEO's District 2

CONTINUED TO REVERSE SIDE

White - Tax Assessor

Ivory Tag - CEO


PERMIT ISSUED WITH LETTER

[Signature]

CONCEPTUAL SITE PLAN
1" = 20'-0"

PLEASANT STREET


EXISTING SIDEWALK

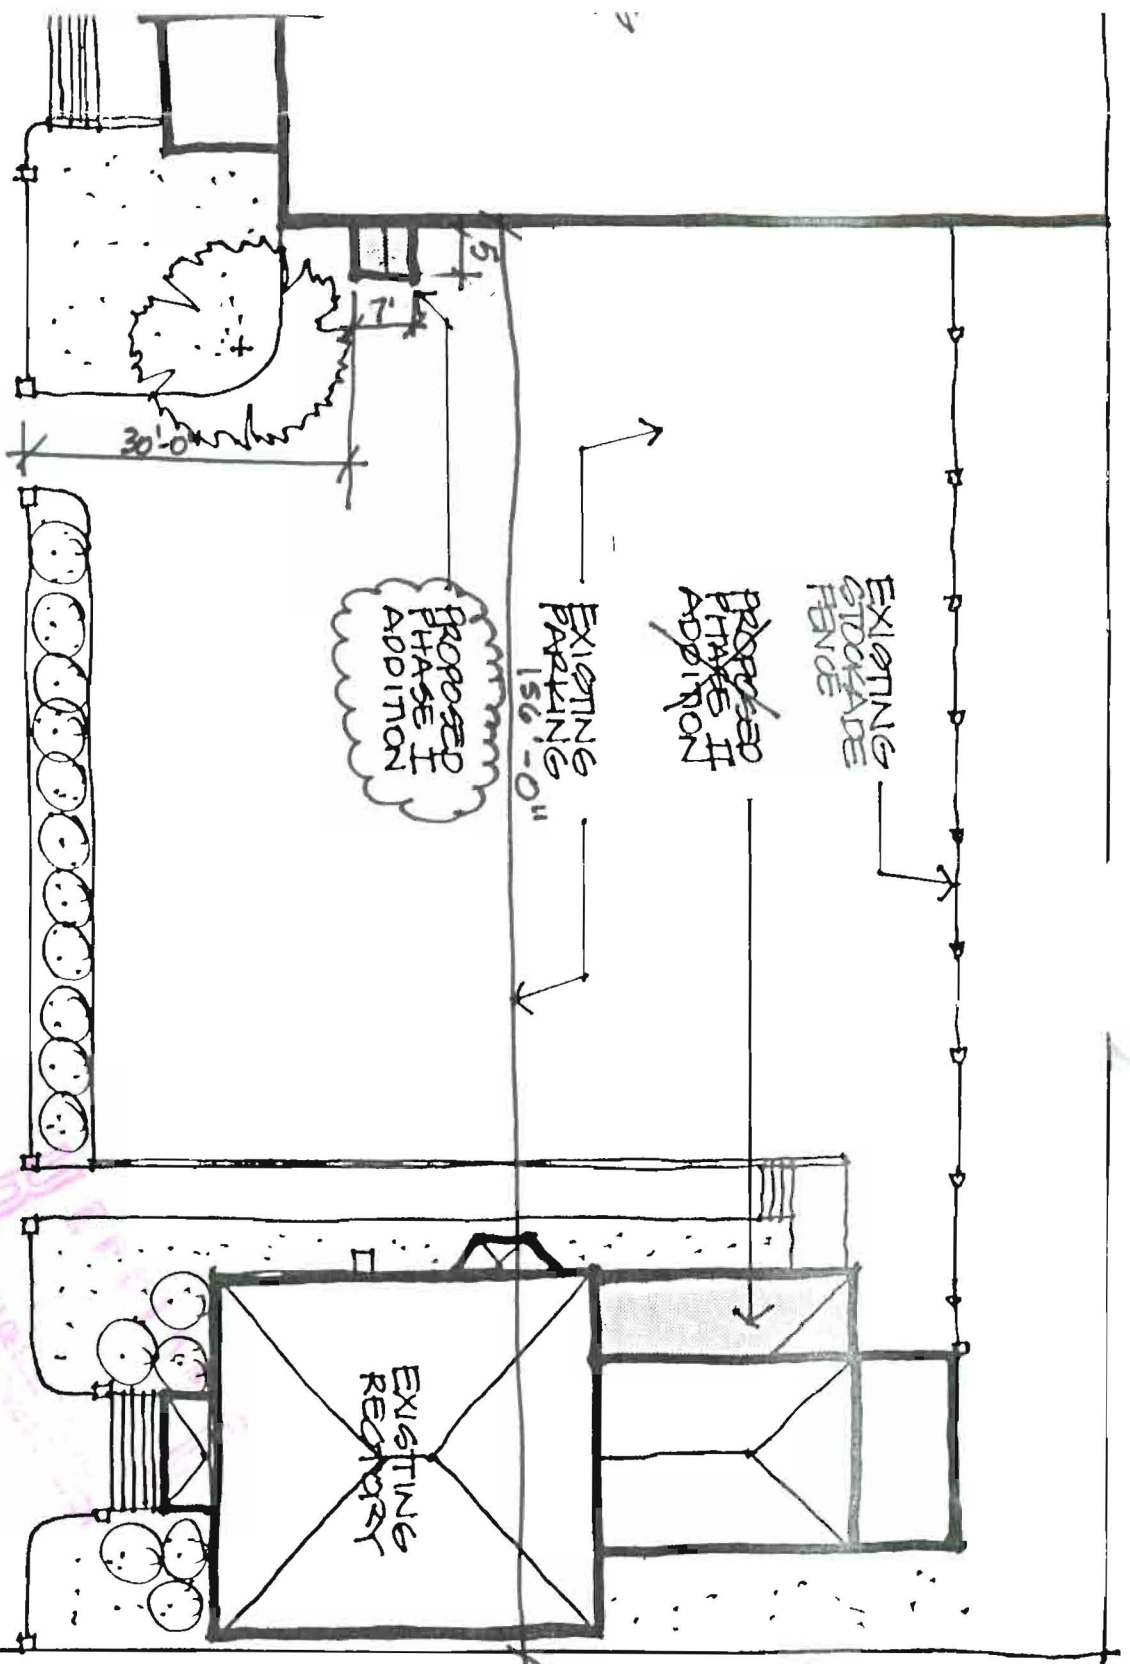

**HOLY TRINITY GREEK
ORTHODOX CHURCH**

133 PLEASANT STREET
PORTLAND MAINE

GRANT HAYS ASSOCIATES
ARCHITECTURE INTERIOR DESIGN
184 MAYALL ROAD GRAY, MAINE 04039 207 657 4699

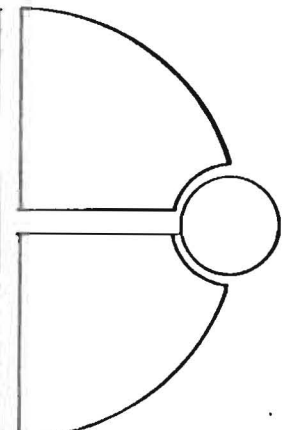

Inspection Services
Samuel P. Hoffses
Chief



Planning and Urban Development
Joseph E. Gray Jr.
Director

CITY OF PORTLAND

April 20, 1994

Grant Hayes Assoc.
184 Mayall Rd.
Gray, Me. 04039

RE: 133 Pleasant Street

Dear Sir,


Your application to install a elevator has been reviewed and a permit is herewith issued subject to the following requirements: This permit doesn't preclude the applicant from meeting applicable State and Federal laws.

No Certificate of Occupancy can be issued until all requirements of this letter are met.

1. The conditions if Historical Preservation shall be maintained.
2. The installing of the proposed elevator shall meet the requirements of the City's Building Code, the BOCA National Building Code/1993.

If you have any questions regarding these requirements, please do not hesitate to contact this office.

Sincerely,

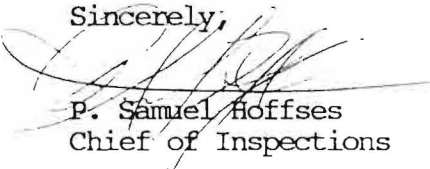
P. Samuel Hoffses
Chief of Inspections

CAT

PLOT PLAN



Never called for any inspections -
unable to access space -
work complete w/out inspections ✓

FEES (Breakdown From Front)

Base Fee \$ _____
Subdivision Fee \$ _____
Site Plan Review Fee \$ _____
Other Fees \$ _____
(Explain) _____
Late Fee \$ _____

Type	Inspection Record	Date
_____	_____	/ /
_____	_____	/ /
COMMENTS

CERTIFICATION

I hereby certify that I am the owner of record of the named property, or that the proposed work is authorized by the owner of record and that I have been authorized by the owner to make this application as has authorized agent and I agree to conform to all applicable laws of this jurisdiction. In addition, if a permit for work described in this application is issued, I certify that the code official or the code official's authorized representative shall have the authority to enter areas covered by such permit at any reasonable hour to enforce the provisions of the code(s) applicable to such permit.

SIGNATURE OF APPLICANT

ADDRESS

PHONE NO.

RESPONSIBLE PERSON IN CHARGE OF WORK, TITLE

PHONE NO.