


(A) DETAIL - SOUTH ENTRY DOOR - REVISED

1/4" = 1'-0"

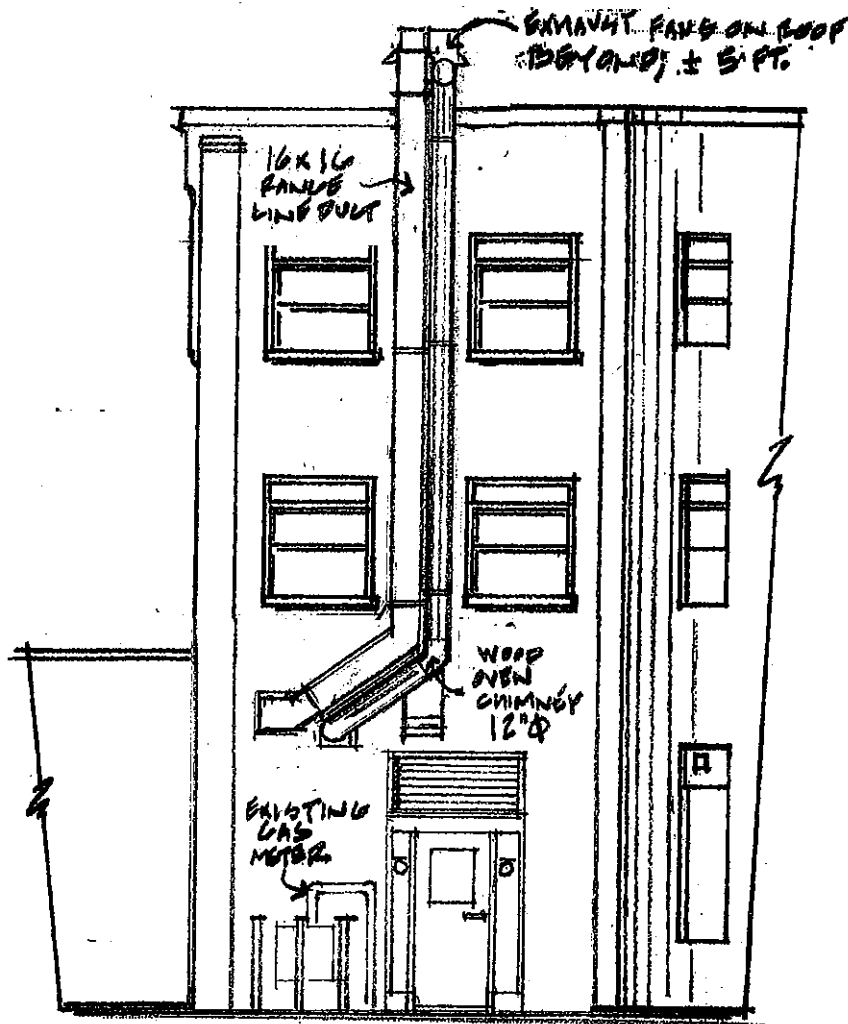

618 Congress Street
Portland, Maine

Restaurant
for
Lazzari LLC

Buell Heminway

ARCHITECTS
Portland, Maine
(207) 772-8892

Date: MARCH 1, 2017
Scale: SHOWN
Drawn By: POWELL
Date/Revisions:

Title:

PART SOUTH
ELEVATION
+ DETAIL
REVISED ①
DRAWING A-B

① PART SOUTH ELEVATION ~ KITCHEN VENTING - REVISED
SEE DETAIL (A) (REVISED) ABOVE

1/8" = 1'-0"