


1st Floor As-Built Plan  
1/4"=1'-0"

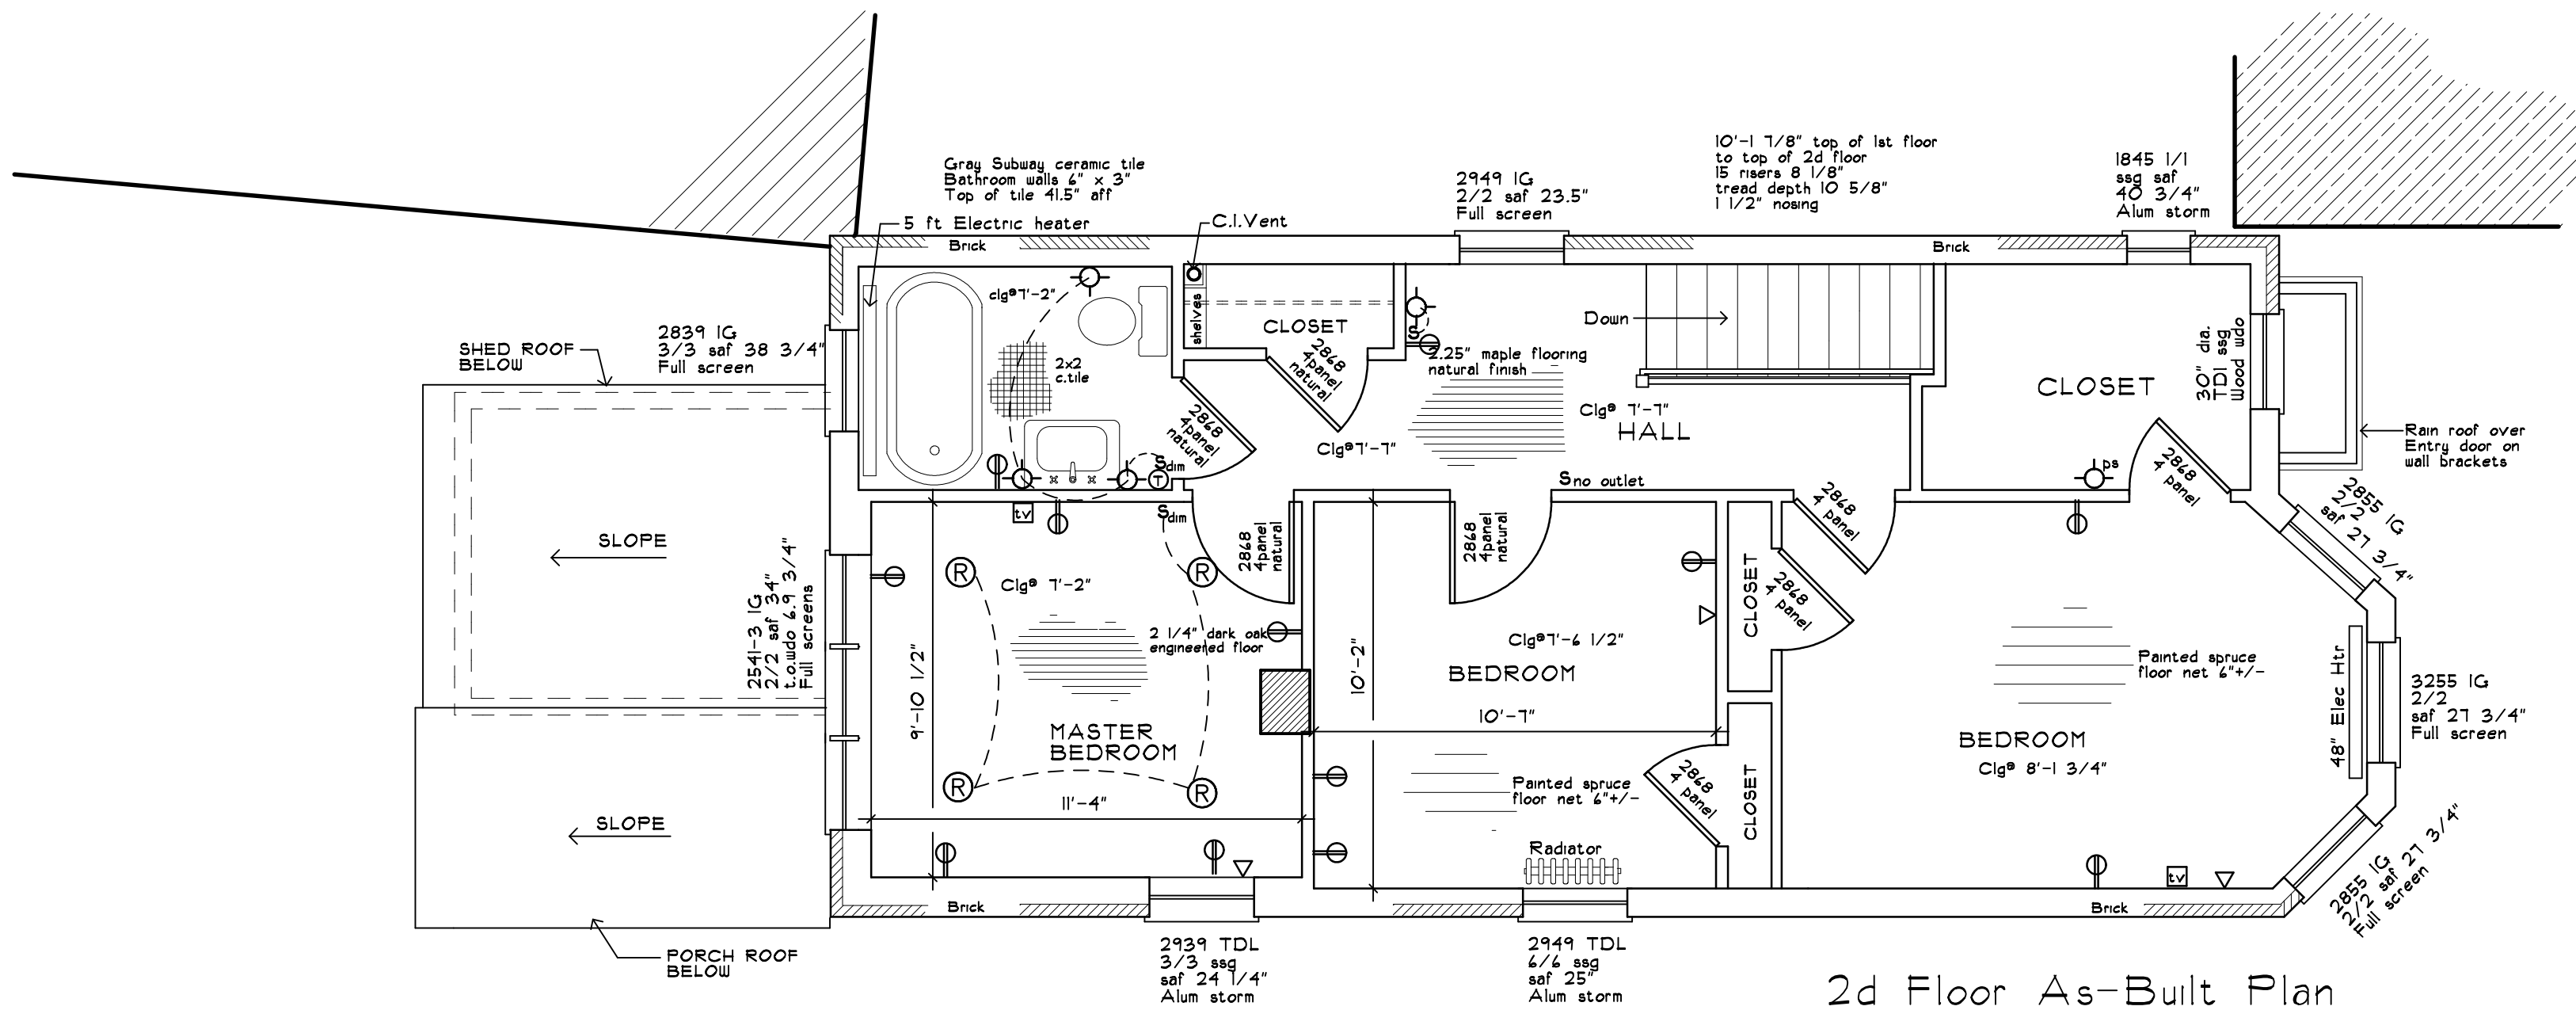

2d Floor As-Built Plan  
1/4"=1'-0"

4 Meeting House Lane, WEST BATH, MAINE 04530  
**JAMES HOARE** Architectural Design  
 Phone (207) 443-6257 cell 151-2134

REVISIONS

ALEX FISHER RESIDENCE  
 67 HIGH STREET  
 PORTLAND, MAINE

DRAWINGS THIS SHEET  
 As-Built First Floor Plan  
 As-Built 2d Floor Plan

DATE	
Number	
Drawn By	JH
Checked By	

AB-2