


FOR CONTINUATION SEE DRAWING FA-202

FILE PATH: P:\2012\147\Danforth On High\REV1\Fire Alarm Drawings\FA-201_FA-202.dwg

LAST PRINTED: 5/29/2013 10:14:39 AM LAST SAVED BY: MDESIAATA

24" x 36"

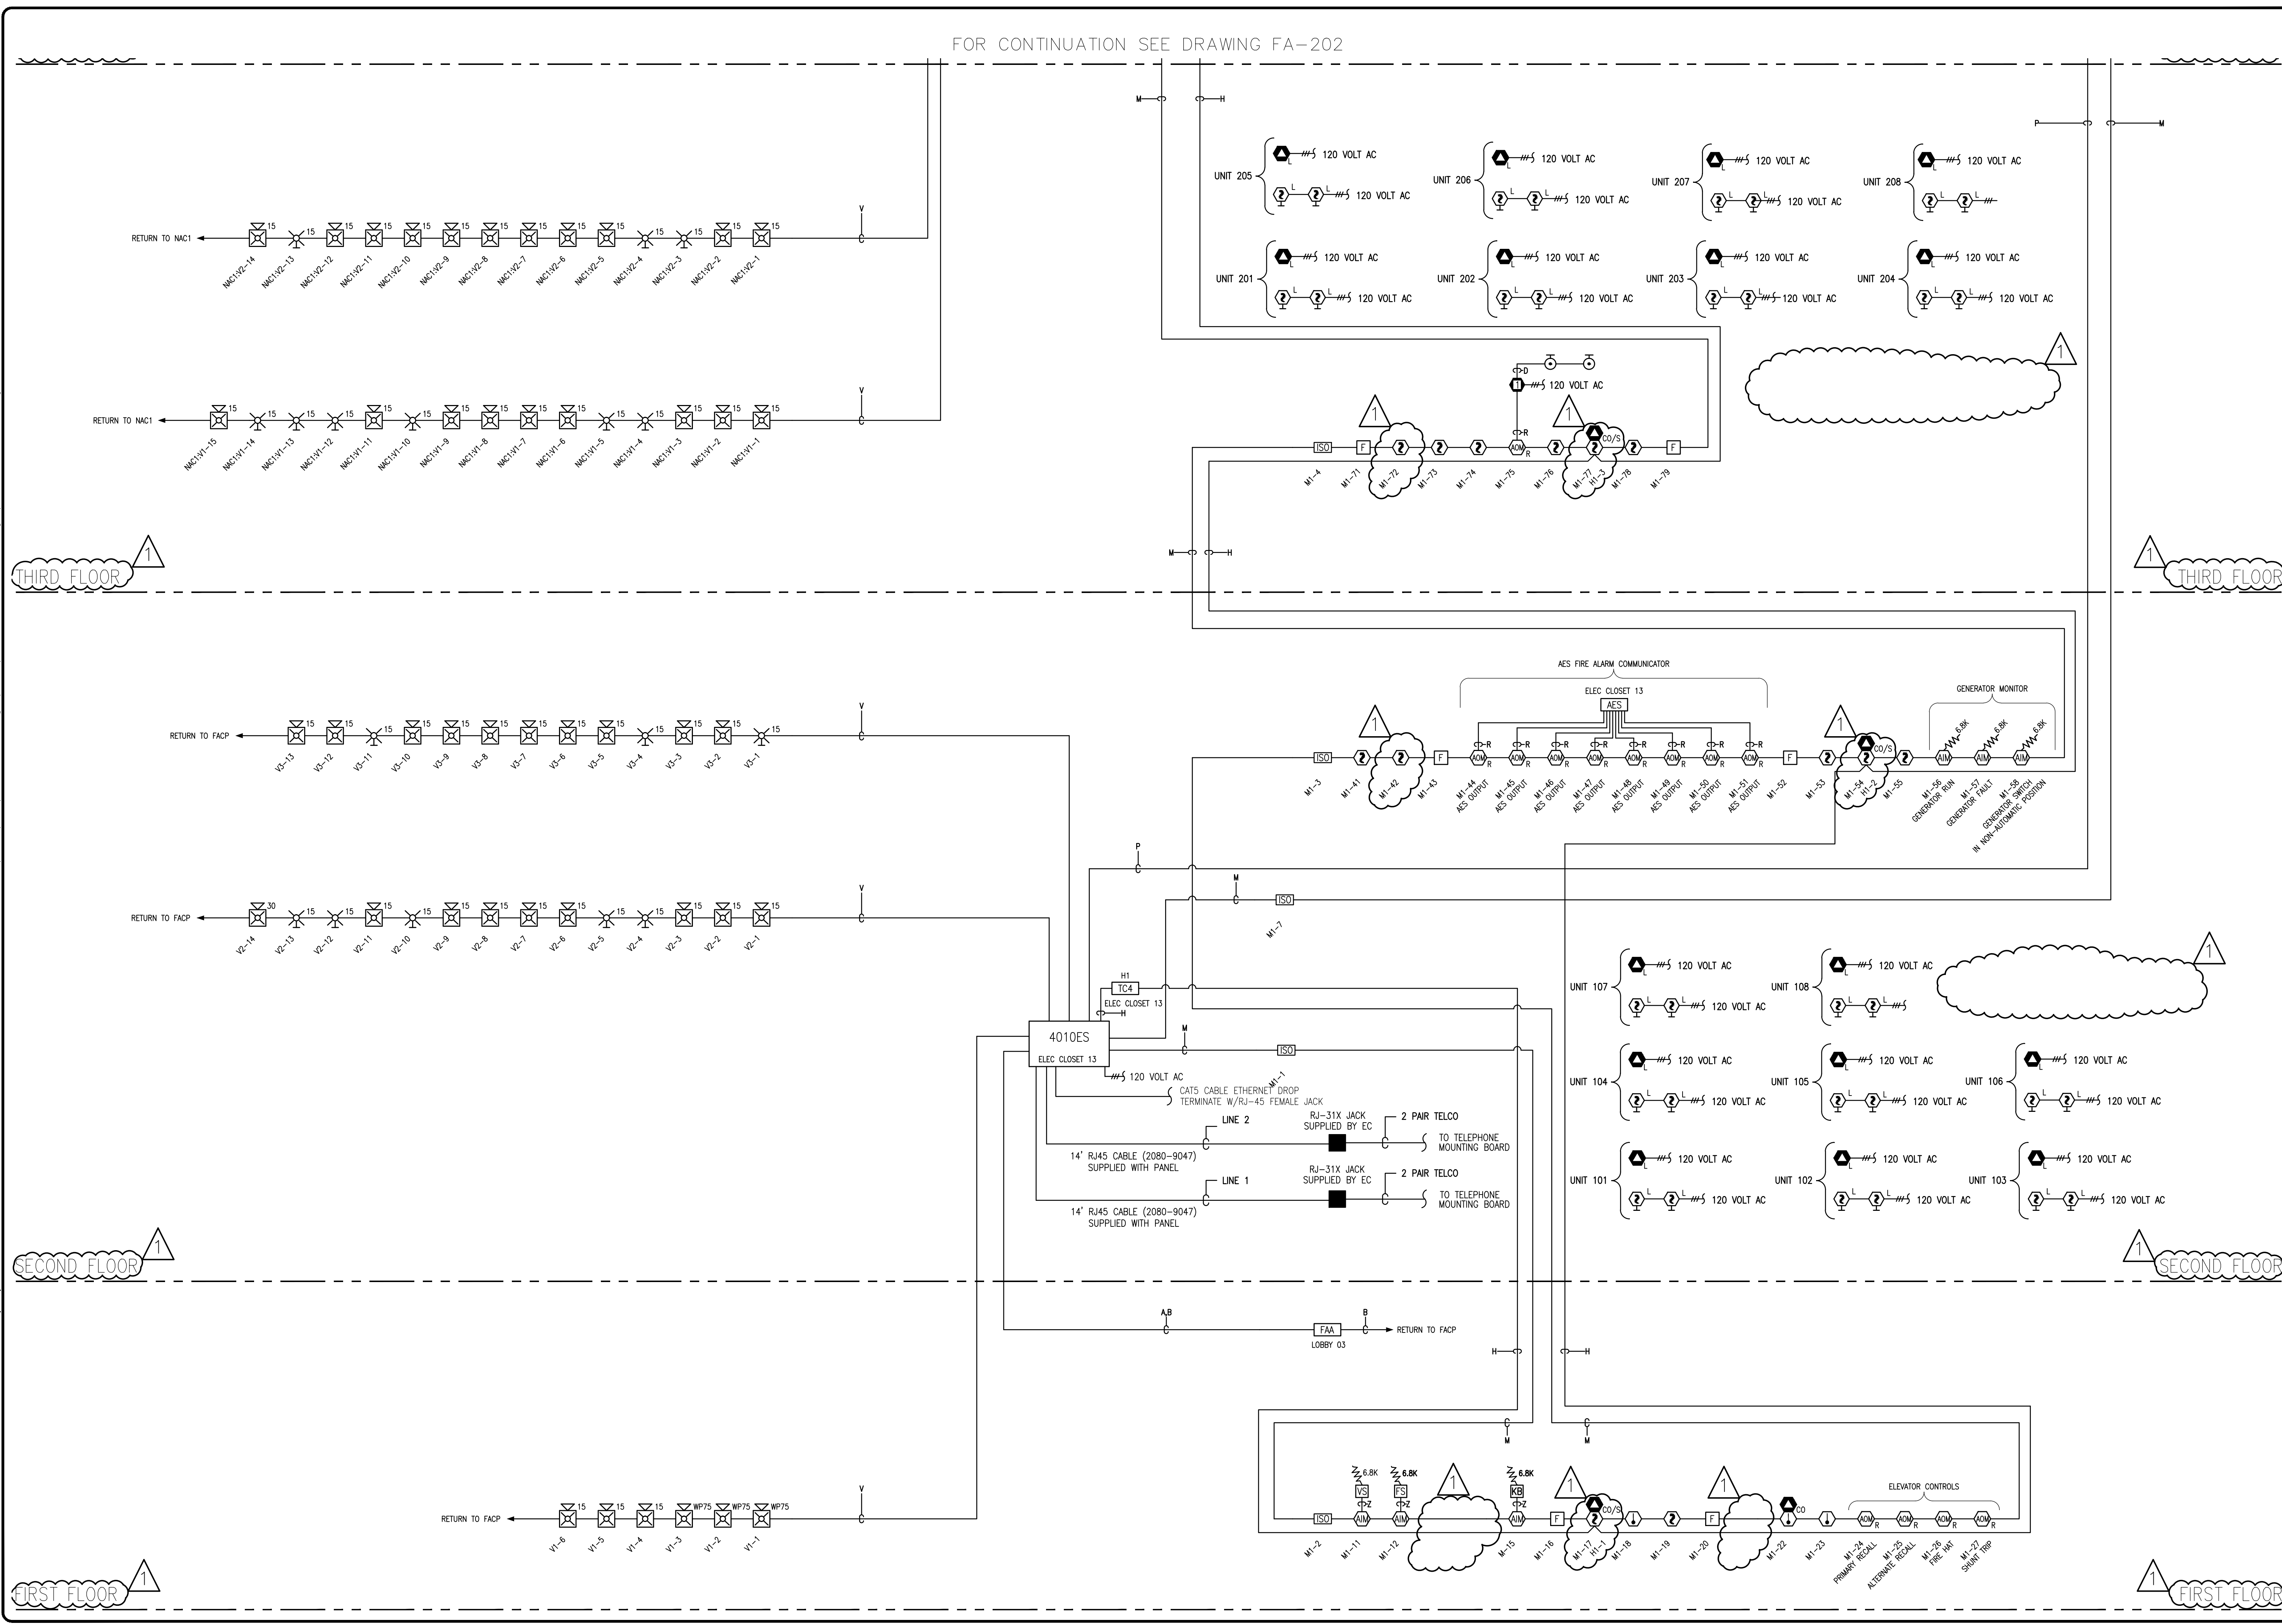

SimplexGrinnell BE SAFE.
 A Tyco International Company
 20 THOMAS DRIVE
 WESTBROOK, ME 04092
 SALES: 207-842-6440
 SERVICE: 207-842-6440
 FAX: 207-842-6439

CHG BY	
REVISION DESCRIPTION	
NO.	3/28/12
DATE	3/20/13
REVISION	REVISED PER FIRE DEPARTMENT REVIEW COMMENTS DATED 3/20/13

**FIRE ALARM & SMOKE DETECTION SYSTEM
 RISER DIAGRAM
 DANFORTH ON HIGH**

DRAWN BY:	M.DESIATA	DATE:	10/10/12
CHECKED BY:	S.KALAFARSKI	DATE:	10/19/12
PROJECT NUMBER:	966796101		
SHEET TITLE:	FIRE ALARM/SMOKE SYSTEM RISER DIAGRAM		
SHEET NUMBER:	FA-201		

81 DANFORTH STREET
 PORTLAND, ME 04101
 FA-201_FA-202.dwg