


FILE PATH: P:\2012\147\Danforth On High\REV\ Fire Alarm Drawings\FA-201\_FA-202.dwg

LAST PRINTED: 3/29/2013 10:14:41 AM LAST SAVED BY: MDESJATA

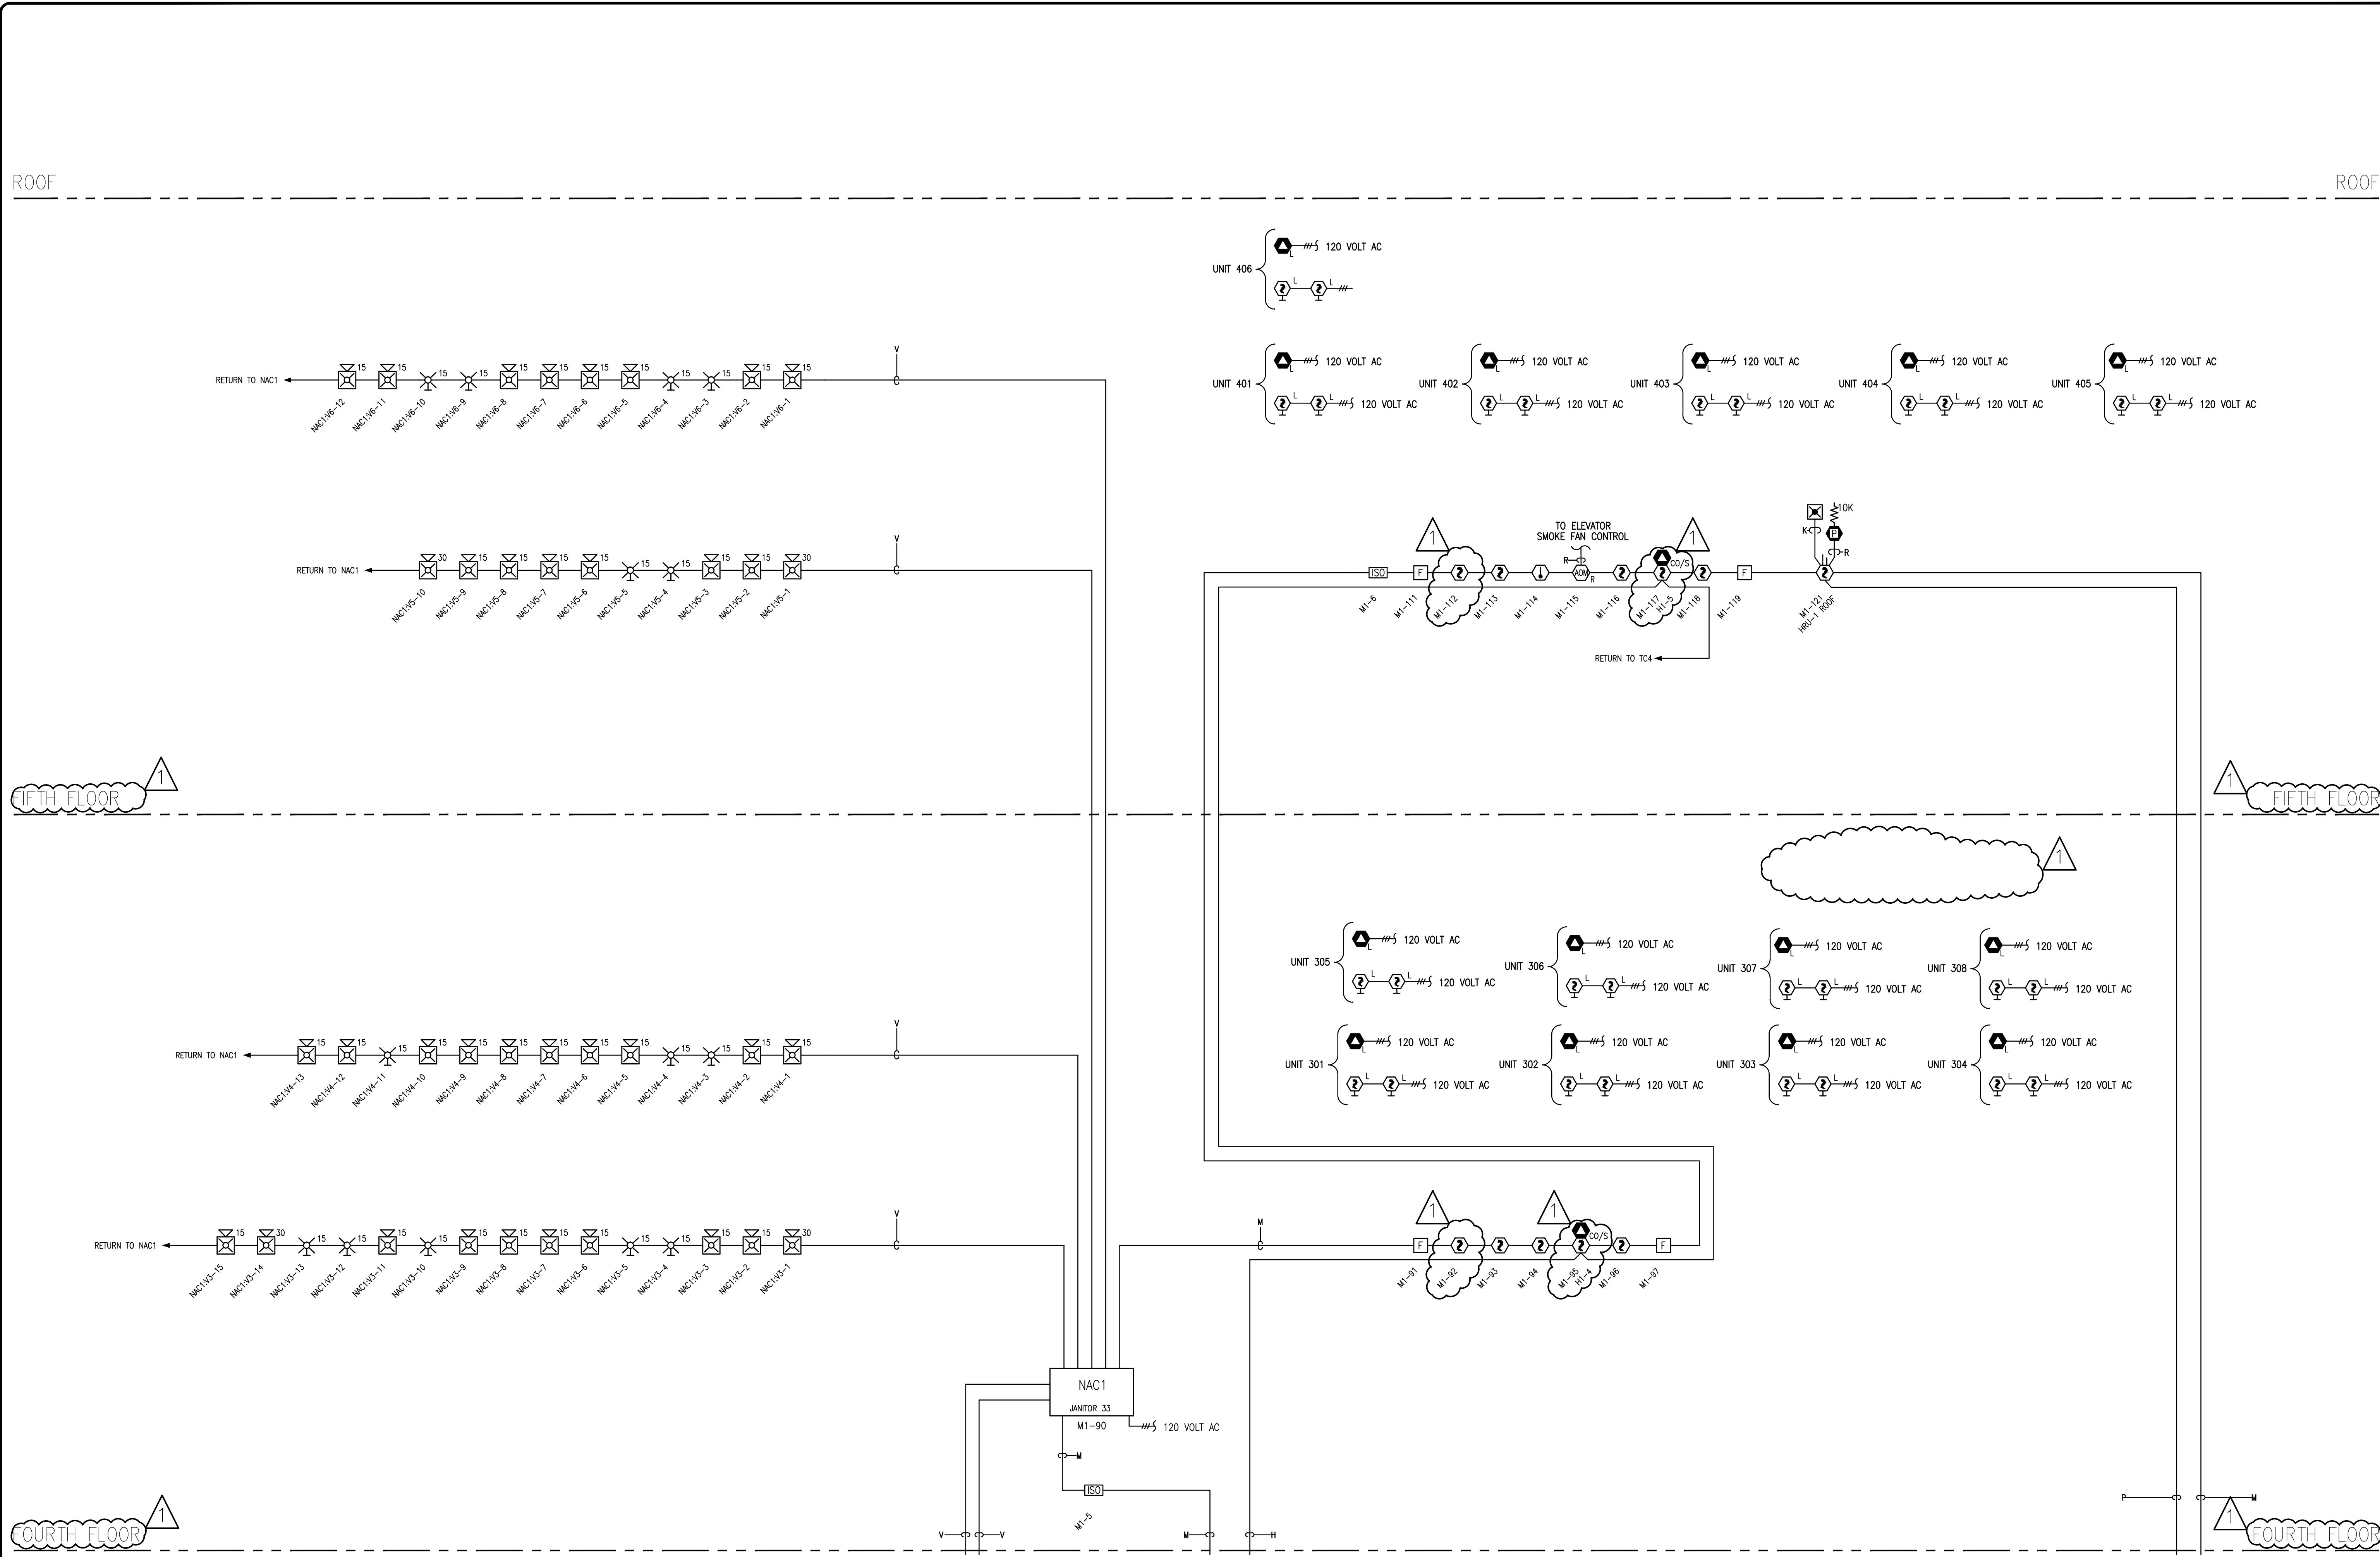

FOR CONTINUATION SEE DRAWING FA-201

**SimplexGrinnell BE SAFE.**  
 A Tyco International Company  
 20 THOMAS DRIVE  
 WESTBROOK, ME 04092  
 SALES: 207-842-6440  
 SERVICE: 207-842-6440  
 FAX: 207-842-6439  
 © 2012 SIMPLEXGRINNELL, LP  
 ALL RIGHTS RESERVED

CHG BY	
REVISION DESCRIPTION	
NO.	1
DATE	3/28/12
REVISED PER FIRE DEPARTMENT REVIEW COMMENTS DATED 3/20/13	

**FIRE ALARM & SMOKE DETECTION SYSTEM  
 RISER DIAGRAM**  
 DANFORTH ON HIGH  
 81 DANFORTH STREET  
 PORTLAND, ME 04101

DRAWN BY:	M.DESIATA	DATE:	10/10/12
CHECKED BY:	S.KALAFARSKI	DATE:	10/19/12
PROJECT NUMBER:	966796101		
SHEET TITLE:	FIRE ALARM/SMOKE SYSTEM RISER DIAGRAM		
SHEET NUMBER:	FA-202		

FA-201\_FA-202.dwg