

NO. ~~48/50~~ <sup>44</sup> Pleasant ST. ST., DIVISION Port.

REG. NO. 1911 CODE NO. ~~P-38-97~~

NAME Sherman Scribner PG 1-32

NAME Mark Foley

NAME Dennis

RENISERVICE RECORD

SIZE OF PIPE 3/4"

KIND OF PIPE COP

MAIN TO STOP 15'

STOP TO ST. LINE 9'

ST. LINE TO BLDG. 3/4 COP'

DATE 5/5/61

DEPTH OF MAIN 5'


SIZE OF TAP 3/4"

DEPTH ON PRIVATE 5'

SHUT AT CORP.

REMARKS (SEE REVERSE) 5M 1-60 E.P.

MEASURES

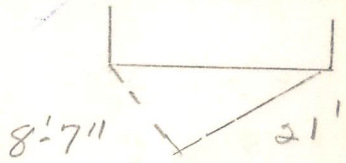

Installed Conc. Meter Box P.W.D. 5/5/61

