


CONNECTION SIMILAR TO ORIGINAL WILL NEED TO RE-ENGINEER/UPSIZE SLIGHTLY TO ADDRESS ADDED LOAD CONNECTIONS SUPPORTS GRAVITY AND LATERAL LOAD

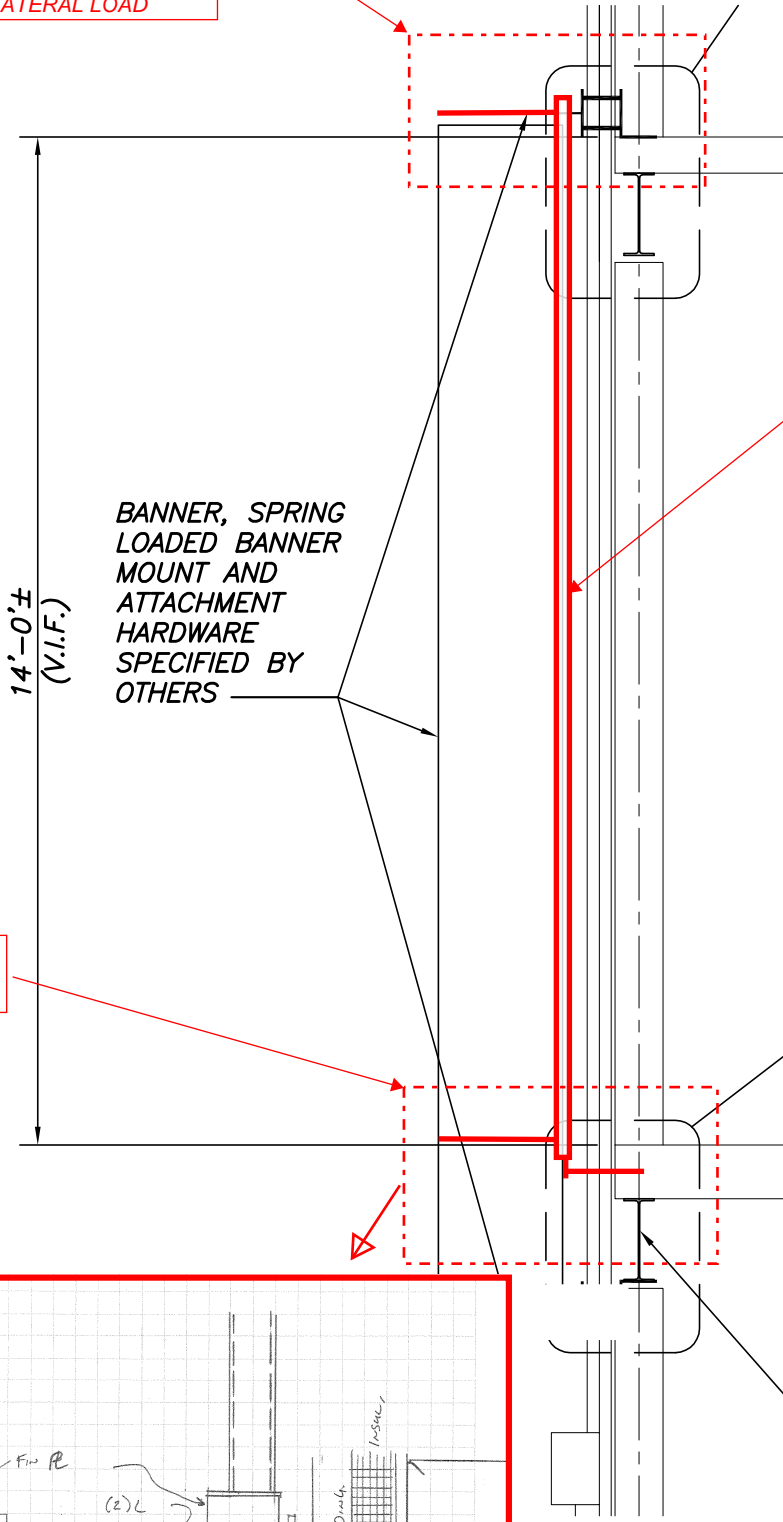


HSS 6x2 ORIENTED "FLAT" TO BUILDING

BANNER, SPRING LOADED BANNER MOUNT AND ATTACHMENT HARDWARE SPECIFIED BY OTHERS

14'-0"± (N.I.F.)

CONNECTION TO RESIST LATERAL ONLY (IN AND OUT OF PAGE)

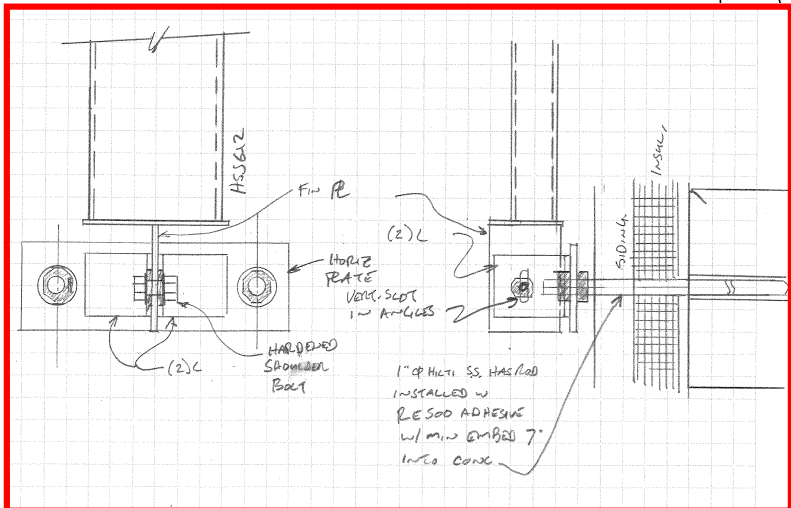

GMRI BANNERS  
3/19/14  
PRELIMINARY