

Construction Delay only → old plans obsolete 4/25/02

Ok for Zoning

NOW OR FO  
SERE  
TATYAN

CCRD 16  
CCRD 12

TOTAL AREA = ±  
±

Front - 25' req. - 25' shown exactly  
rear - 25' req. - 25' shown exactly  
side 20' req. - 29' & 40' + shown

R-2

lot cov. ok

Site Plan 1/8" = 1'-0"  
Proposed Addition to  
76 Elizabeth St  
Peaks Island  
April 1, 2002

PG 1

REPAIR/RECONSTRUCT  
EXIST. AIRLOCKS  
REQ'D. INSULATE  
WALLS.

← B  
REPLACE WINDOW w/  
DOOR FOR FUTURE  
ACCESS TO BACK YARD  
SECURE DOOR CLOSED  
UNTIL FUTURE USE.

CONFORM TO FOOTPRINT  
OF EXIST. DECK  
(±4'-3")

±19'-9"

← EXIST.  
WINDOW

0"  
(EXIST  
ELEV.)

3 RISERS @ 7 3/4"  
2 TREADS @ 8" WIDE  
TO 15" WIDE

12 RISERS UP @ 7 3/4"  
TREAD @ 10", 1" NOSING

HAIR

FLOOR

-23.25"

±5'-6" x  
9'-3"

5' LONG BASEBOARD  
HEAT- CONNECT TO  
EXIST. HOUSE SYSTEM

3'x3'  
LANDING

4" SQ POST  
2 RISERS @ 7 3/4"

OPEN  
UNDER  
STAIRS

FLOOR

-33.75"

12'-6" x 21'-6"  
FAMILY ROOM

ORNAMENTAL GAS (PROPANE)  
HEATING STOVE-VENTED  
TO OUTSIDE

6'x8'  
PORCHE

-31.0"

9'-3"

3 RISERS - EQUAL @ 17"  
2 TREADS @ 14"  
36" WIDE

← B

6'

← A


22'-6"

13'-6"

First Floor Plan

Proposed Addition to  
76 Elizabeth St  
Peaks Island  
April 1, 2002


pg 2

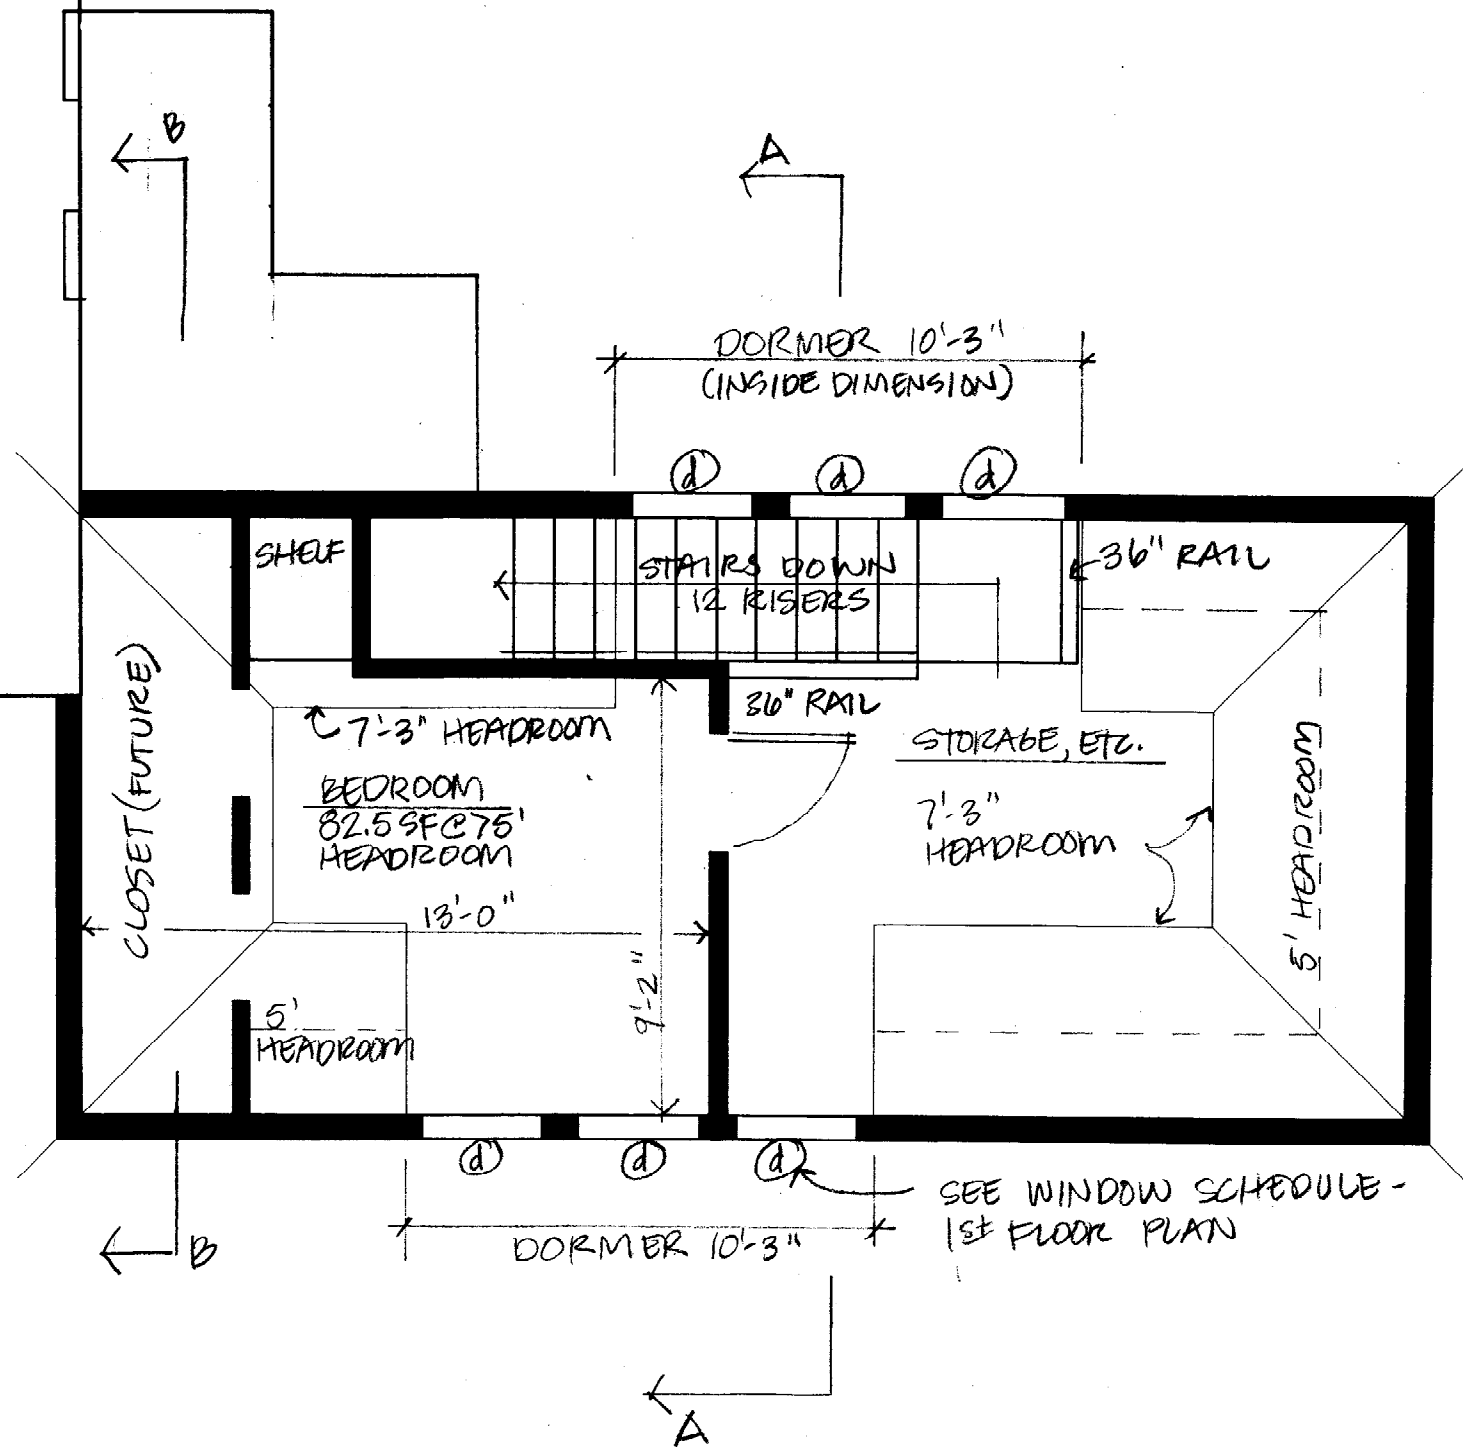

Second Floor Plan

Proposed Addition to  
 76 Elizabeth St  
 Peaks Island  
 April 1, 2002

pg 3

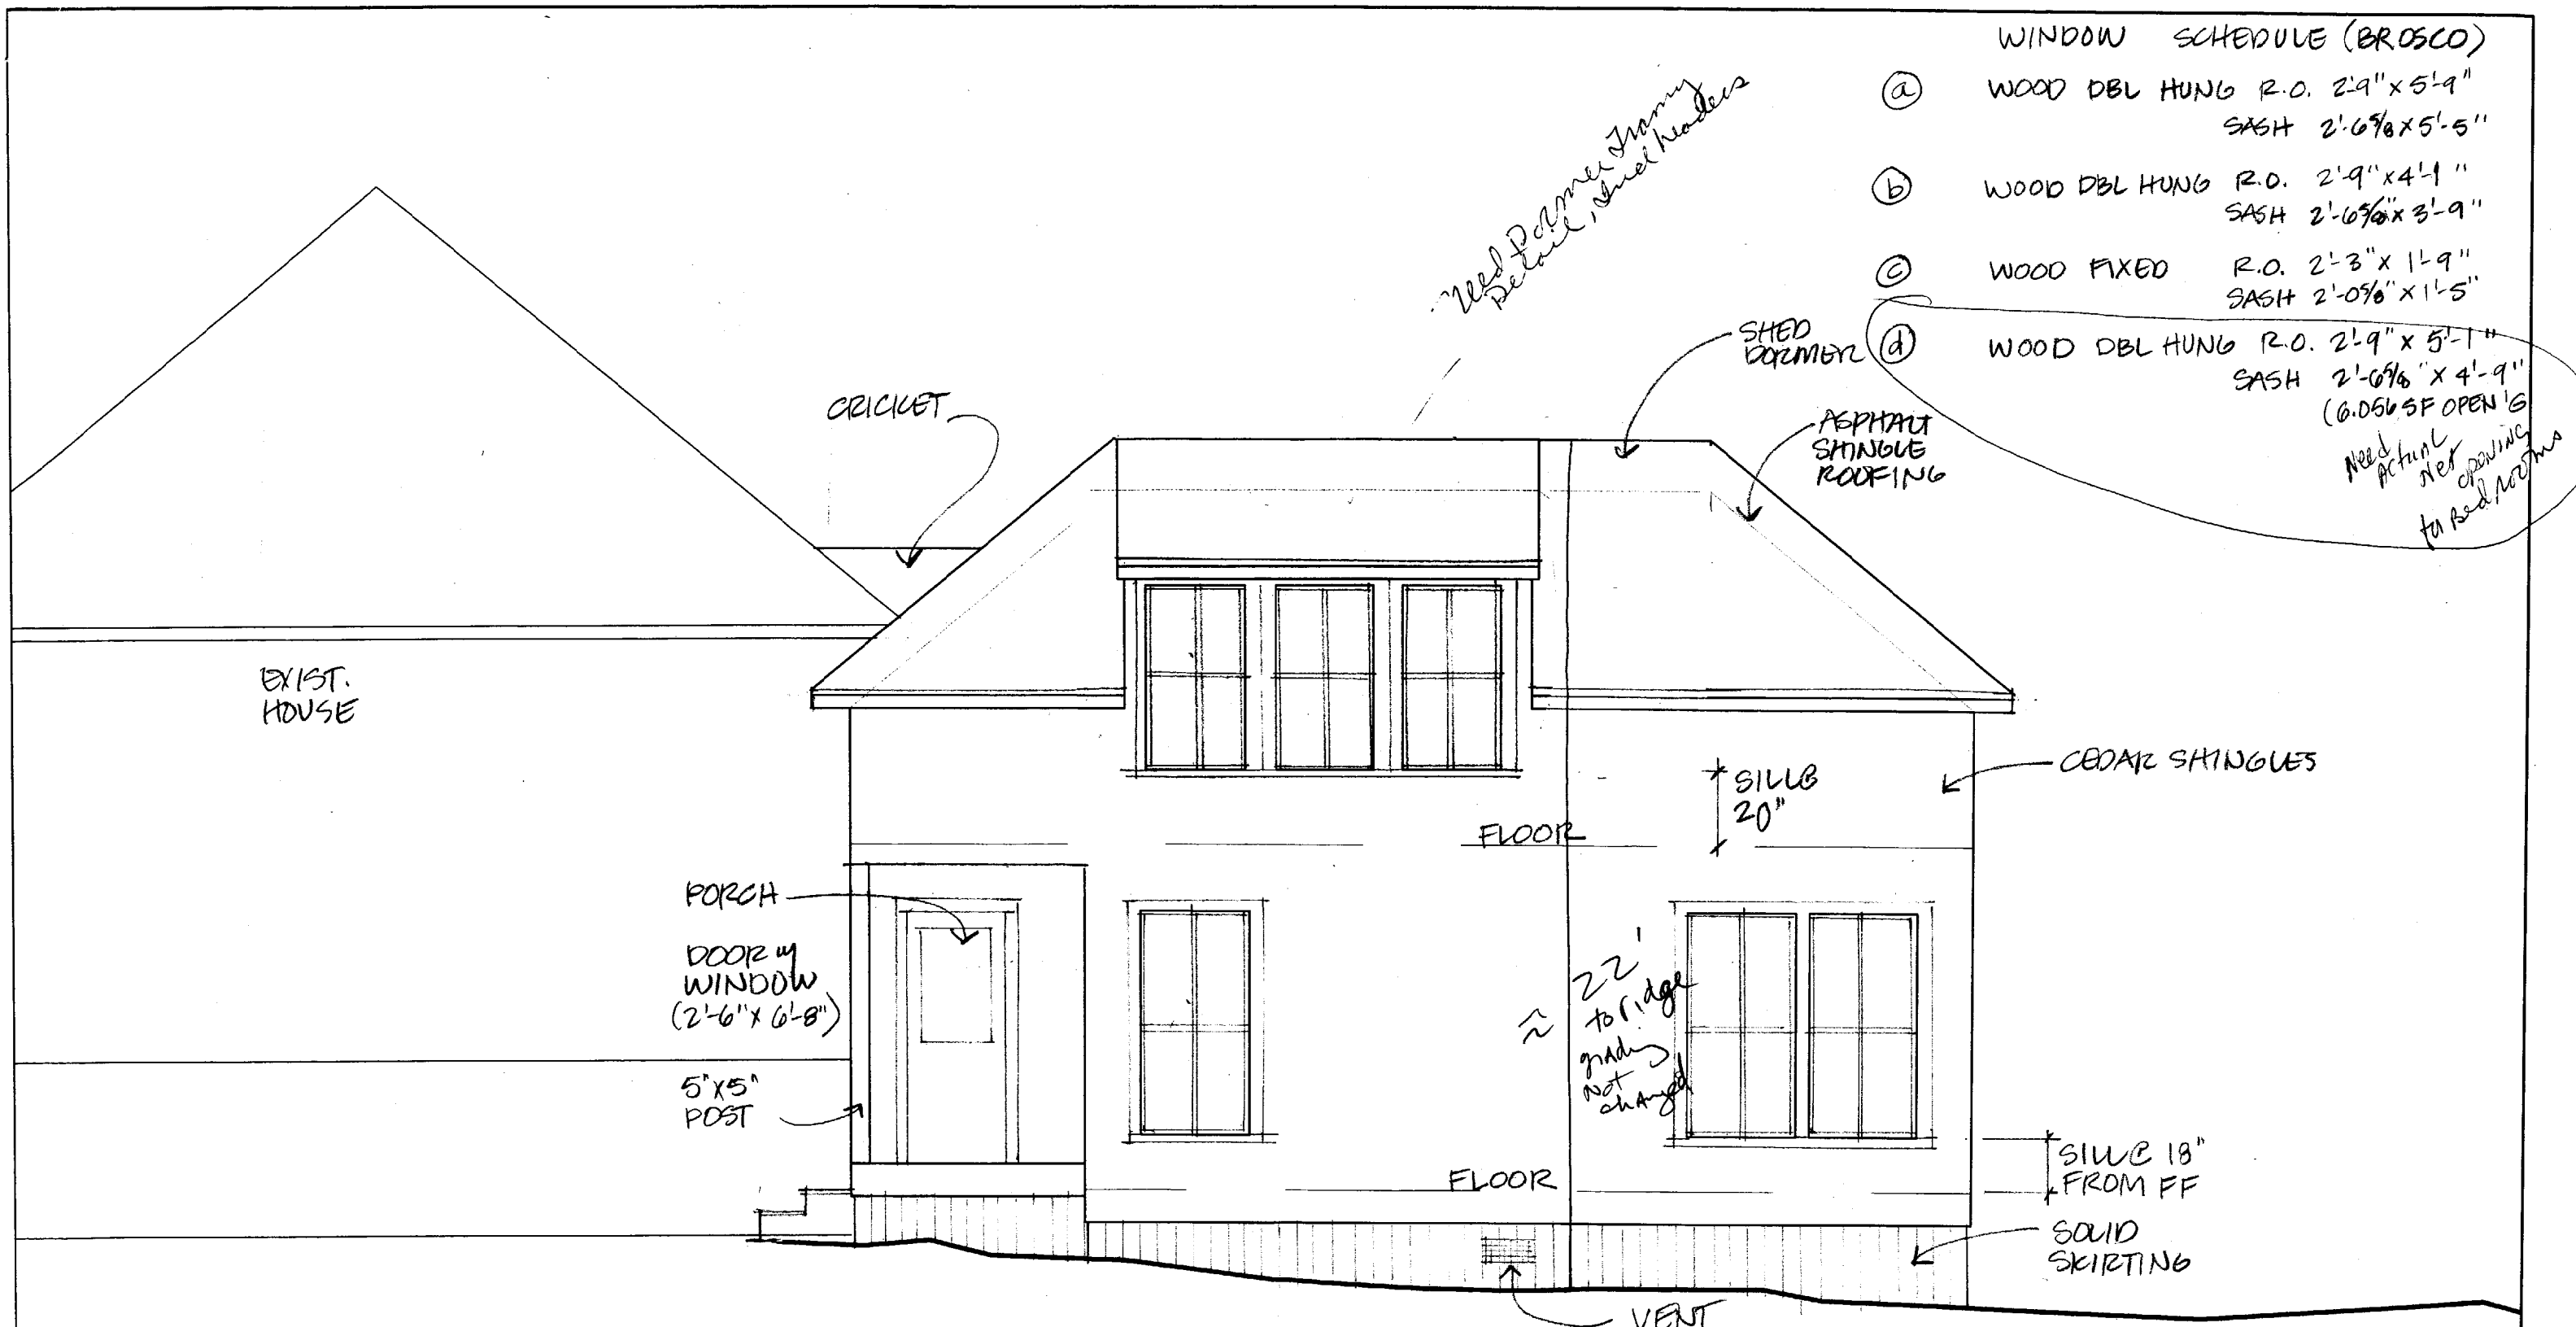

WINDOW SCHEDULE (BROSCO)

- (a) WOOD DBL HUNG R.O. 2'-9" x 5'-9"  
SASH 2'-6 7/8" x 5'-5"
- (b) WOOD DBL HUNG R.O. 2'-9" x 4'-1"  
SASH 2'-6 7/8" x 3'-9"
- (c) WOOD FIXED R.O. 2'-3" x 1'-9"  
SASH 2'-0 5/8" x 1'-5"
- (d) WOOD DBL HUNG R.O. 2'-9" x 5'-1"  
SASH 2'-6 7/8" x 4'-9"  
(6.056 SF OPEN'G)

Need actual net opening for shed dormer

Need Dormer Framing Detail, Shed Headers

EXIST. HOUSE

CRICKET

SHED DORMER

ASPHALT SHINGLE ROOFING

CEDAR SHINGLES

FLOOR

SILL 20"

PORCH  
DOOR w WINDOW  
(2'-6" x 6'-8")

5'x5' POST

22' to bridge grade not changed

FLOOR

SILL 18" FROM FF

SOLID SKIRTING


VENT

1/4" = 1'-0"

South Elevation

Proposed Addition to  
76 Elizabeth St  
Peaks Island  
April 1, 2002

PR4

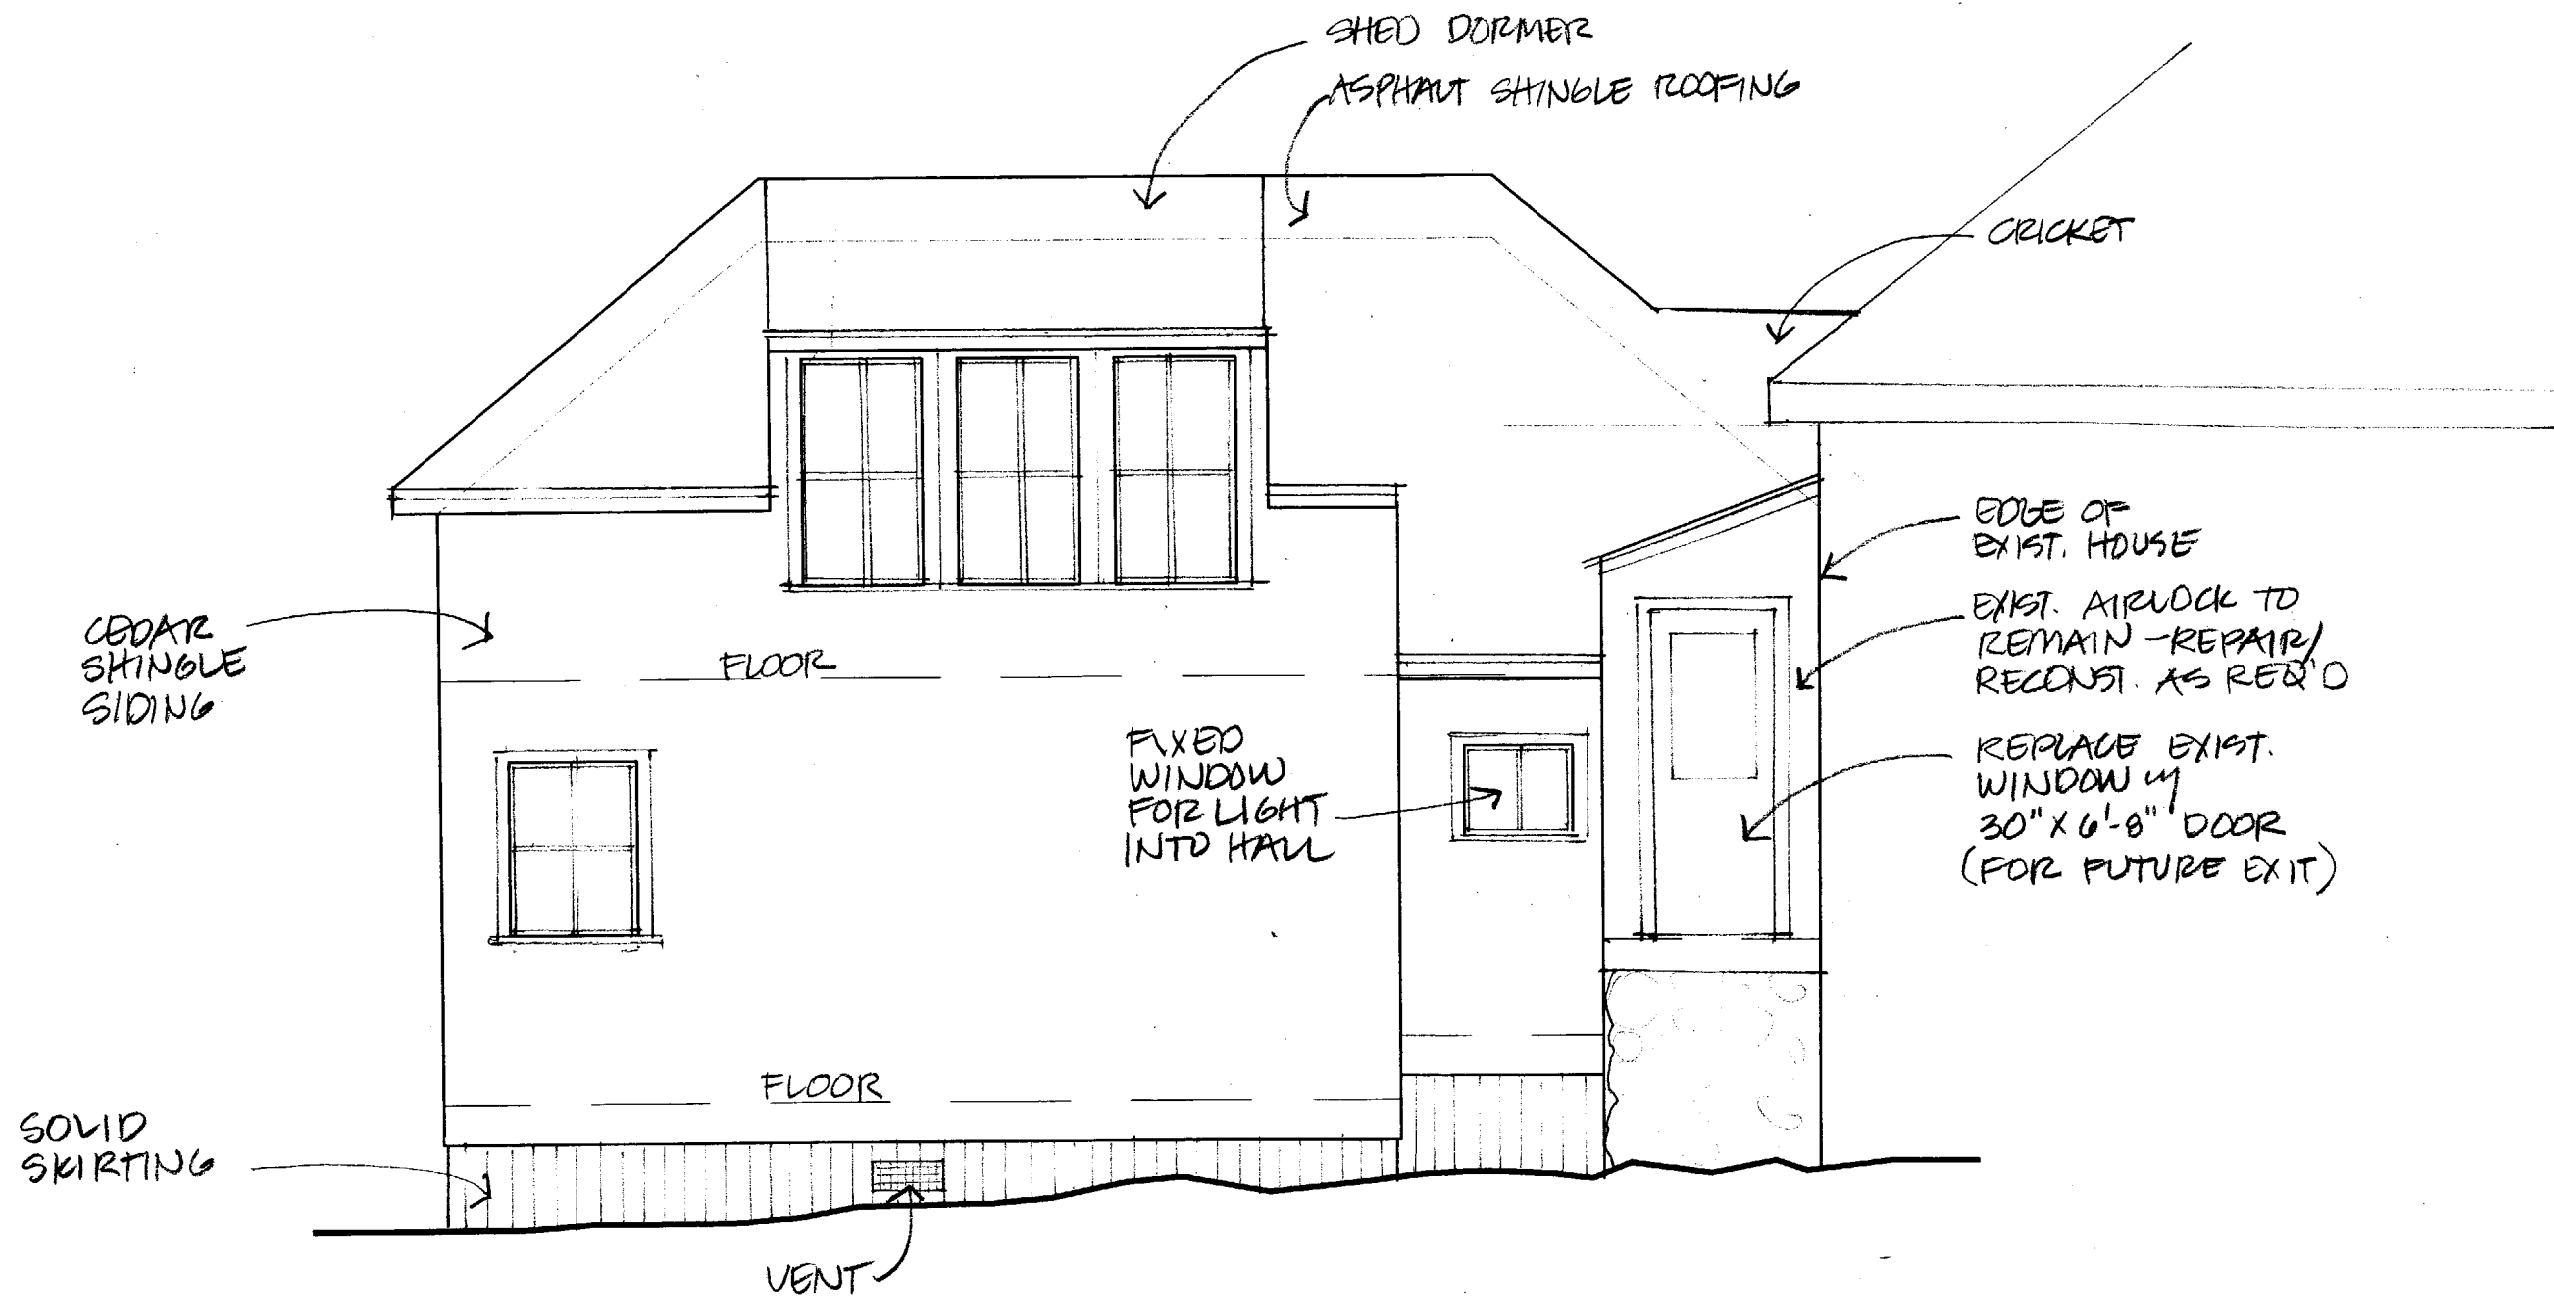


1/4" = 1'-0"

North Elevation

Proposed Addition to  
 76 Elizabeth St  
 Peaks Island  
 April 1, 2002

pg 5

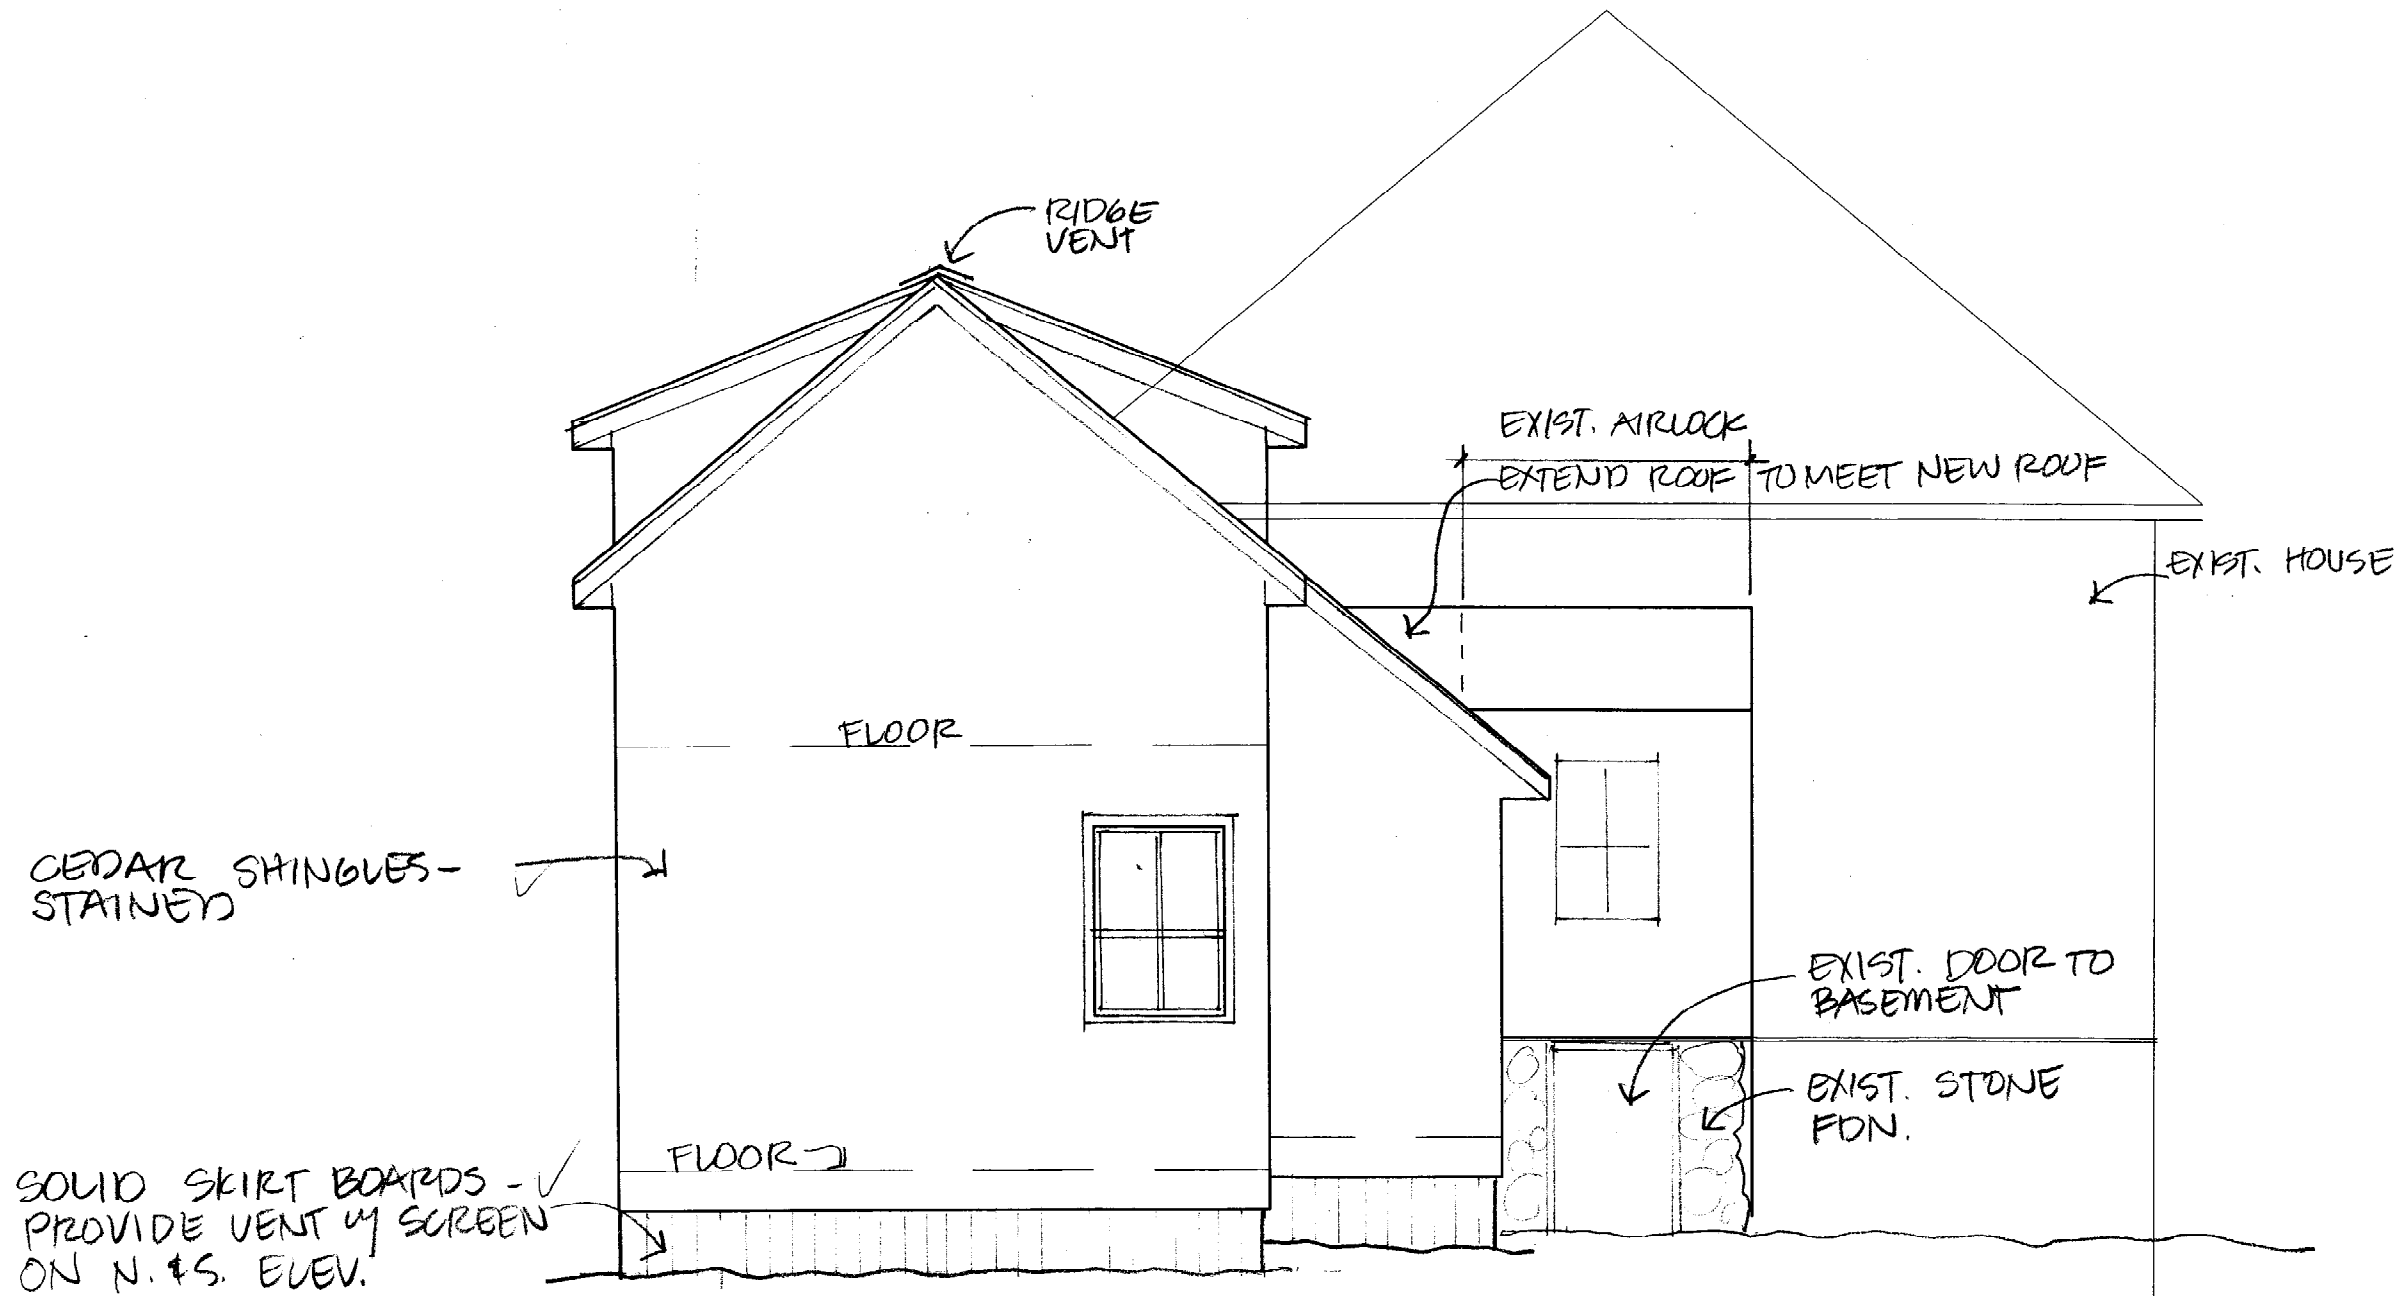


1/4" = 1'-0"

East Elevation

Proposed Addition to  
 76 Elizabeth St  
 Peaks Island  
 April 1, 2002

*Handwritten signature*

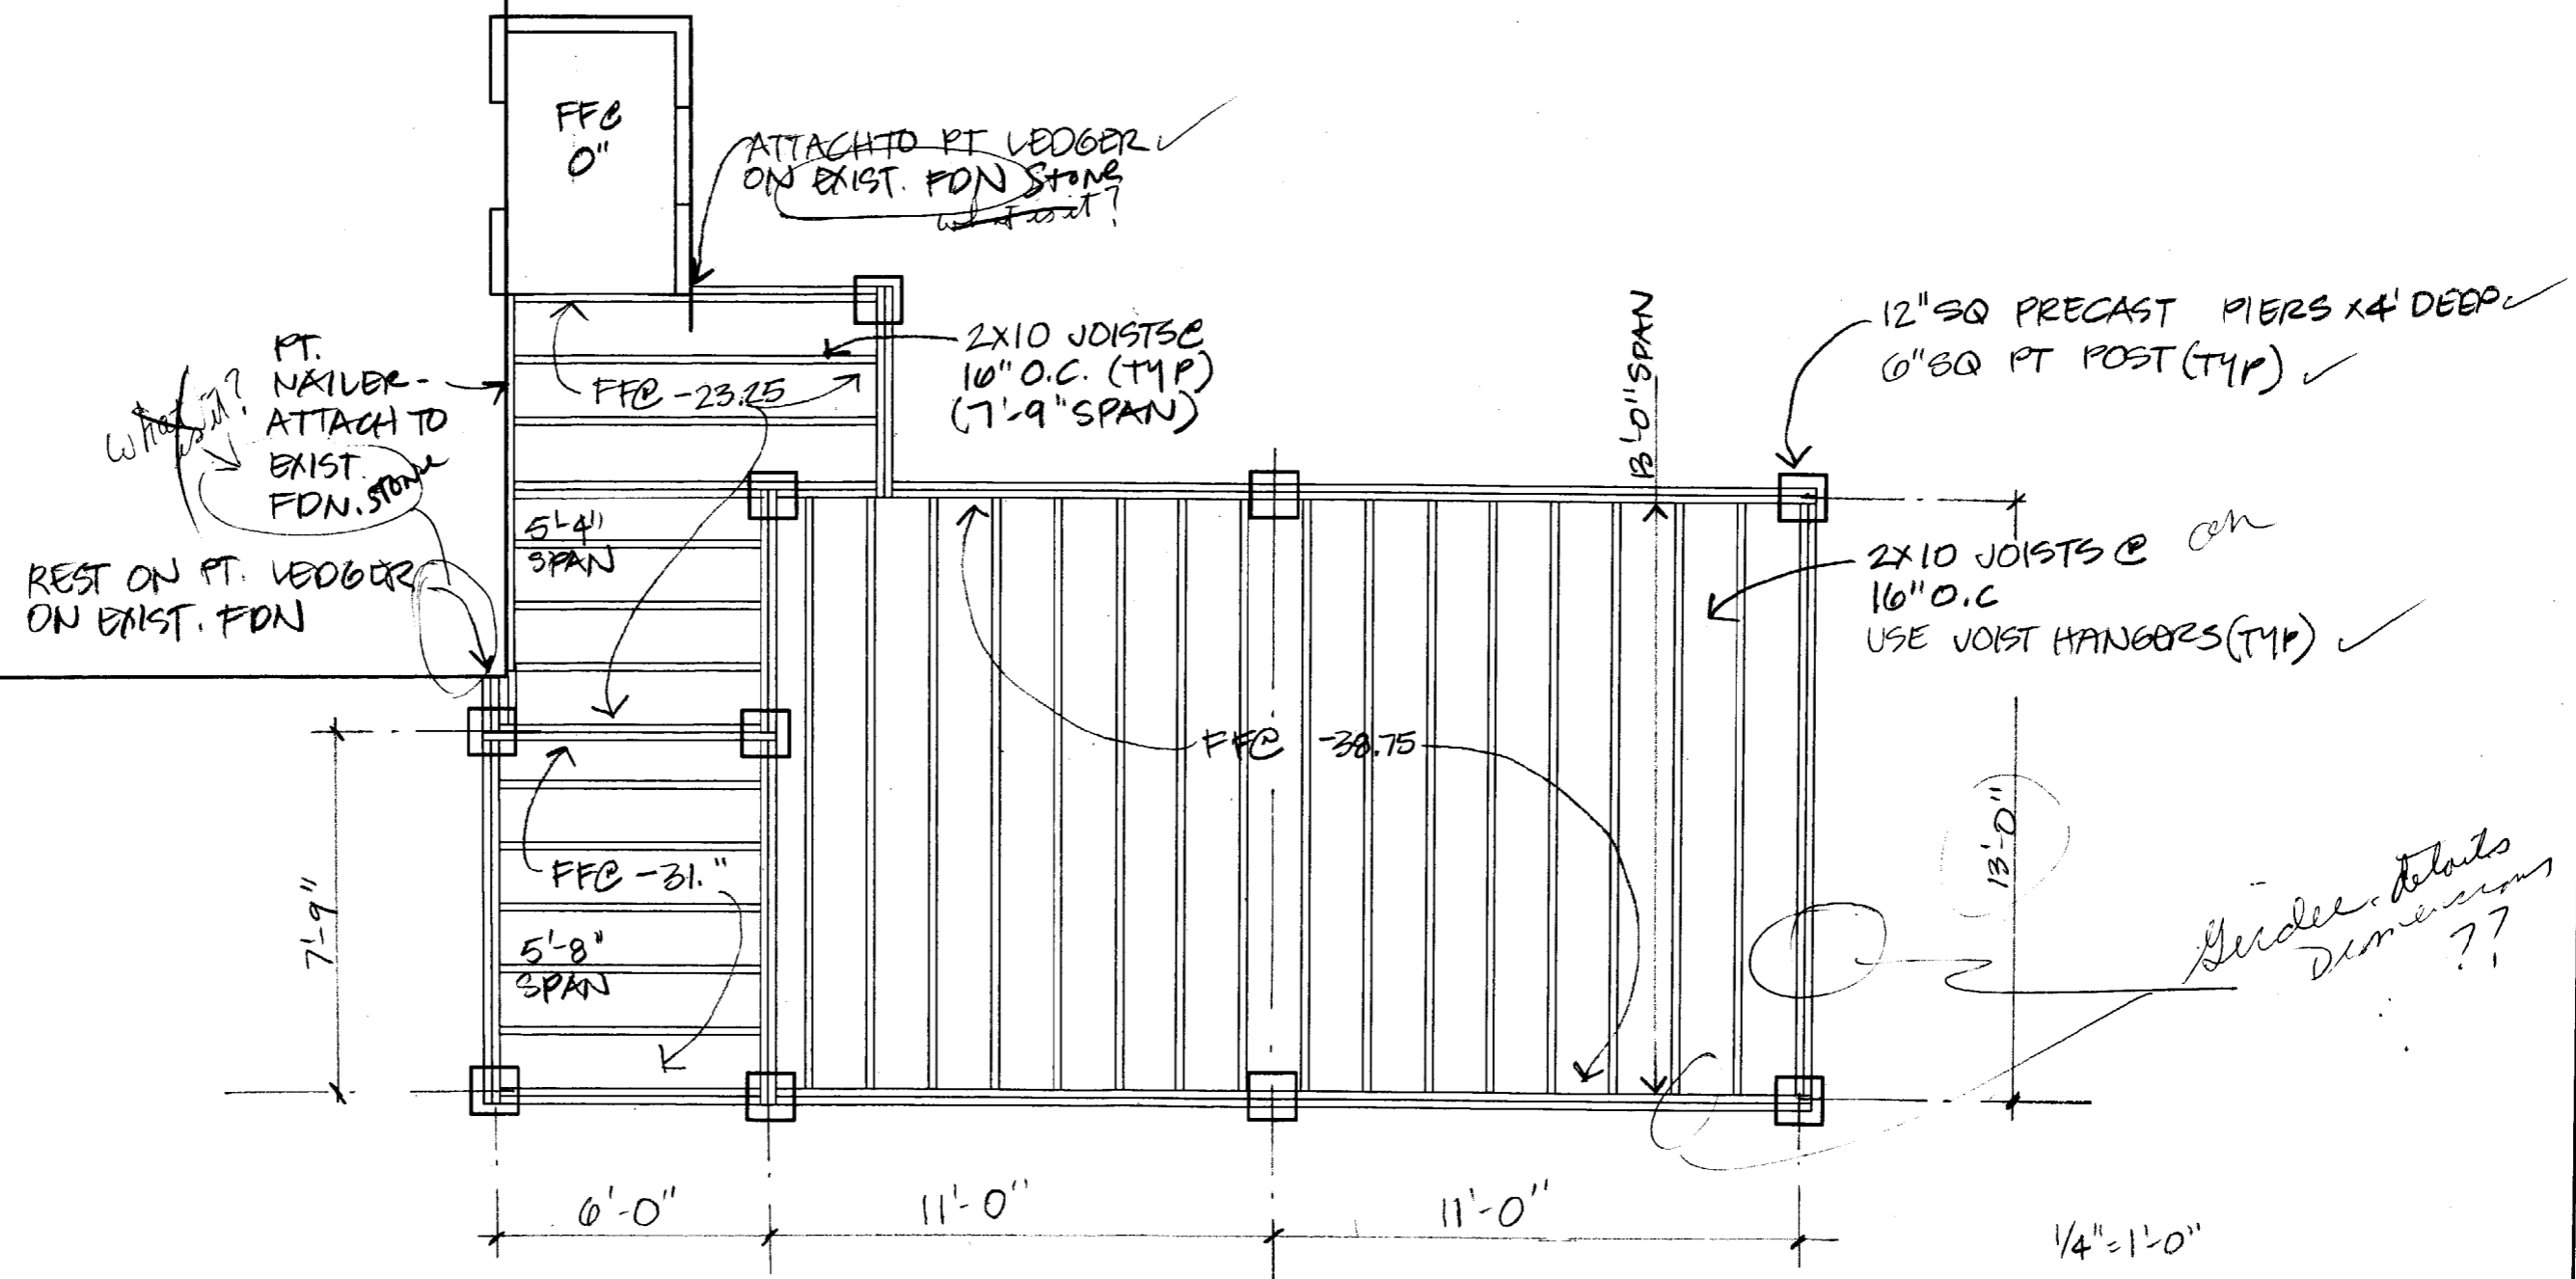


First Floor Framing Plan  
 Proposed Addition to  
 76 Elizabeth St  
 Peaks Island  
 April 1, 2002

pg 7

EXIST.  
HOUSE

EXIST AIRLOCK

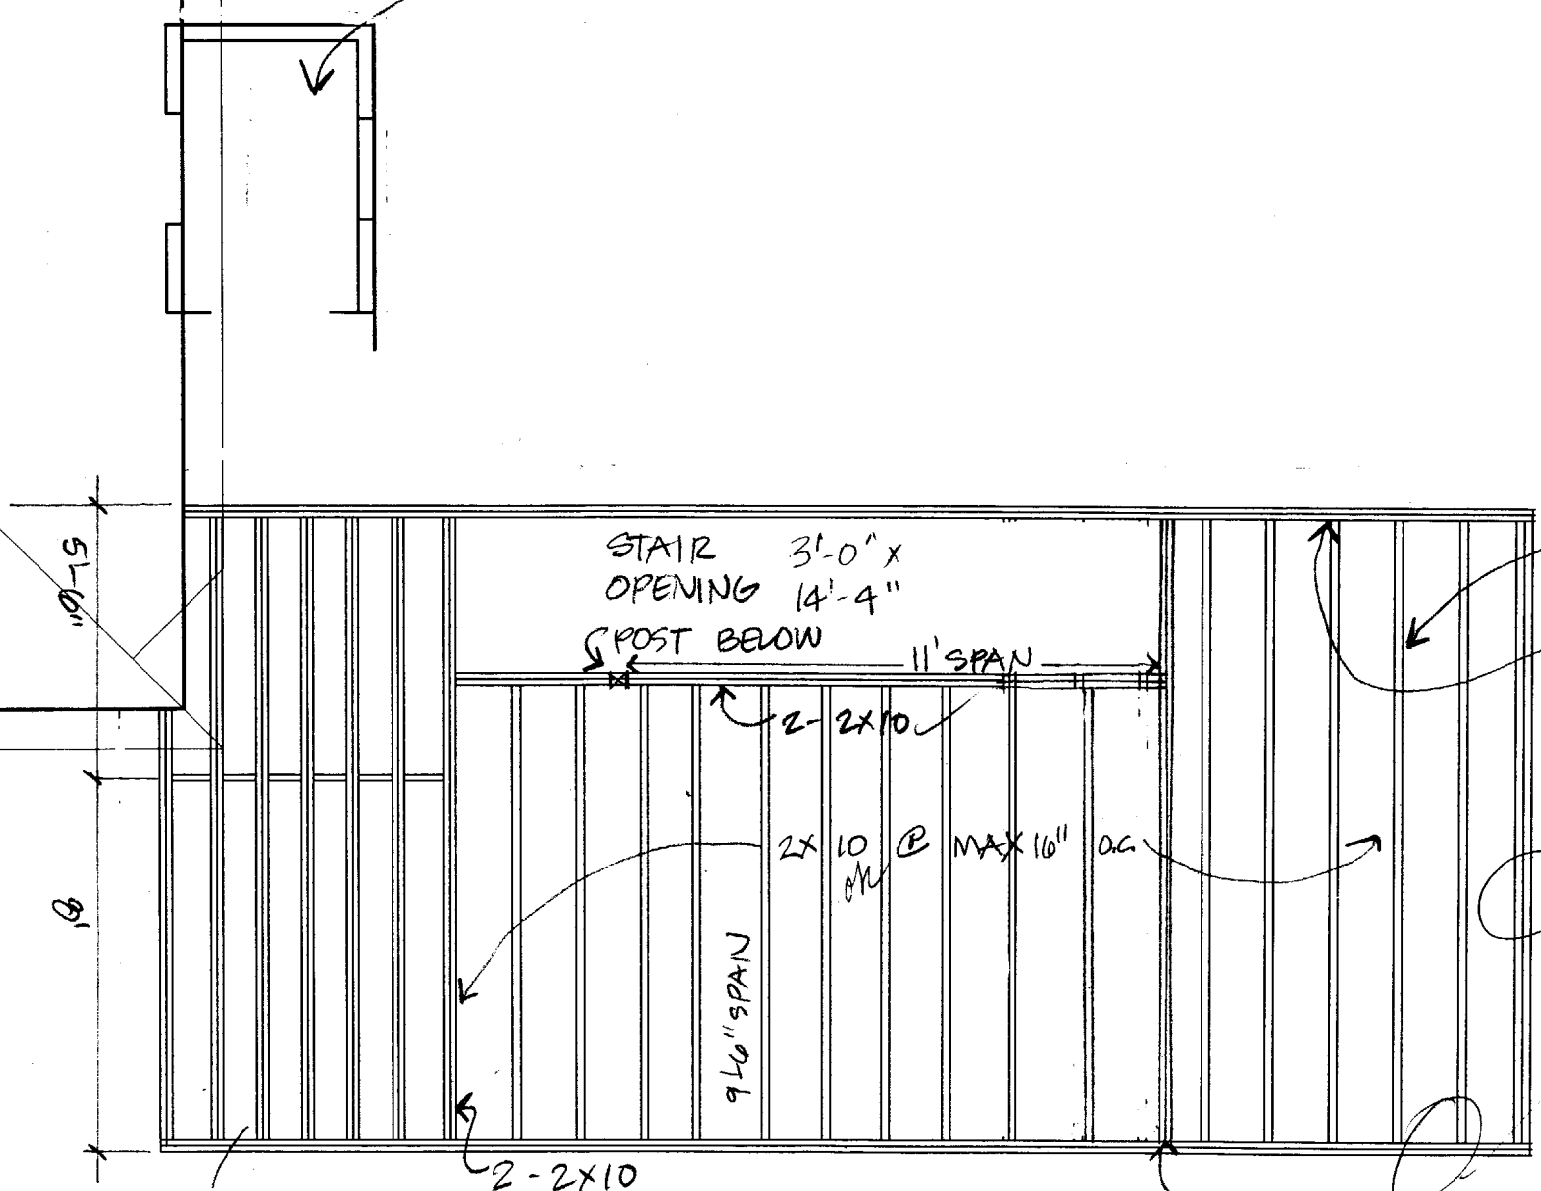

13' Span  
OK  
2x10 FRAMING  
@ 16" O.C. (MAX)  
JOIST HANGERS (TYP)

Grids detail &  
DIMENSIONS?

DOUBLE 2x6 FRAMING  
@ ±11" O.C. - OVER HALL &  
PORCH AREA

1/4" = 1'-0"

Second Floor Framing Plan


Proposed Addition to  
76 Elizabeth St  
Peaks Island  
April 1, 2002

pg 8



Need Framing Detail

11'-3" DORMER -

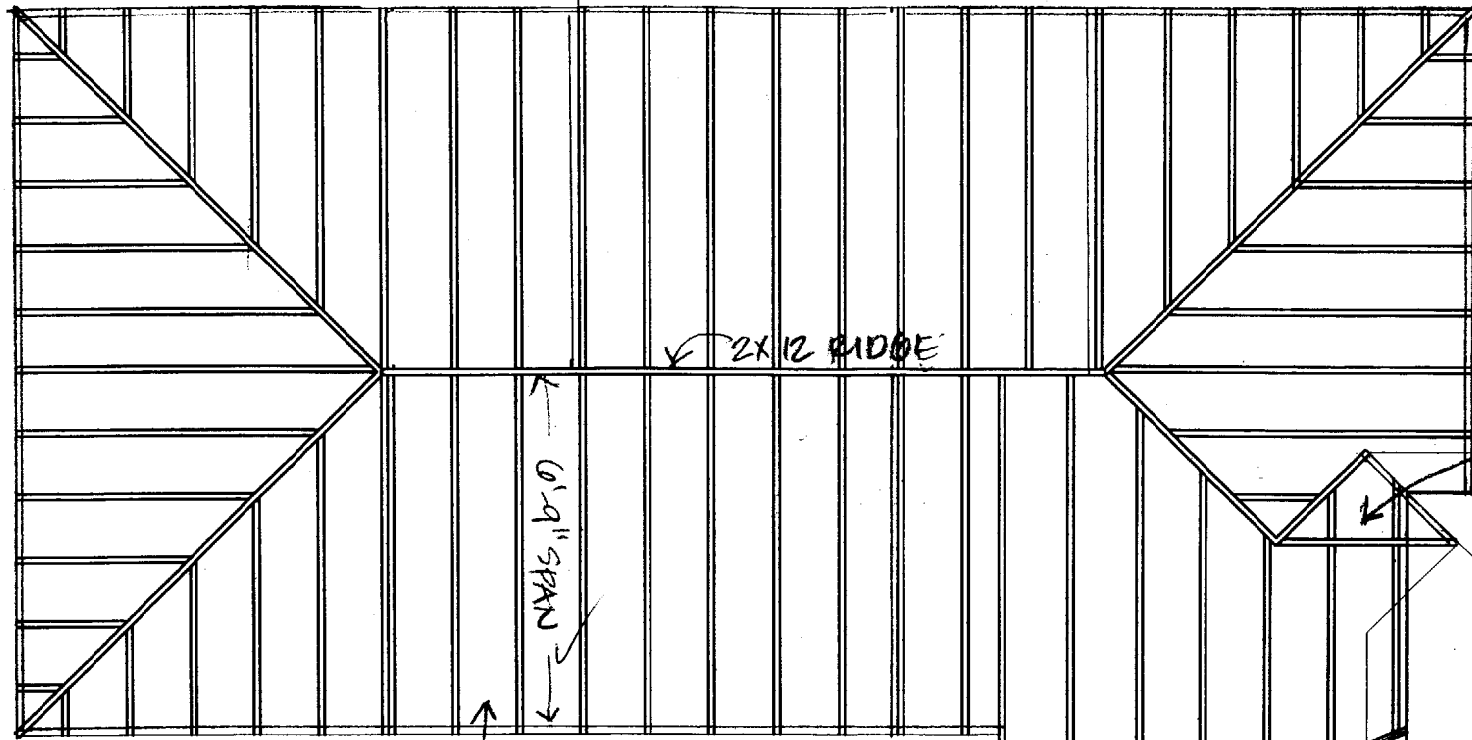

PROVIDE CRICKET WHERE NEW ROOF MEETS EXIST. TO DRAIN AS REQ'D

2x12" RAFTERS @ 16" O.C. (MAX SPACING)

11'-3" DORMER

Need Framing Detail

2" x 6" RAFTERS @ EXIST. AIRLOCK

4' SPAN

EXIST. HOUSE

1/4" = 1'-0"

Roof Framing Plan

Proposed Addition to  
76 Elizabeth St  
Peaks Island  
April 1, 2002

pg 9

SECTION  
THRU  
DORMER

RIDGE VENT

2X12 RAFTERS ✓

SHEATHING ✓

ASPHALT SHINGLES ✓

4/12 ✓

2X6 COLLAR TIES ✓

7'-0"

42" HIGH  
RAILING  
@  
OPENING  
MAX 4"  
OPENING  
must be  
7/4 →

T&G FLOOR - PINE EL. 60.75"

2X10 JOISTS ✓

EXPOSED JOISTS & FLOOR

MUST MEET  
1014.6.3  
TOP 3 STEPS -  
WINDERS

11 RISERS  
FROM LANDING  
@ 8 1/4" EA  
TREADS @ 9" <sup>NO</sup> <sub>MUST</sub> <sup>BE</sup> <sub>7 3/4" X 10" NET</sub> <sup>W/</sup> <sub>NOS 177</sub>

2-2X12 STRINGERS

VAPOR BARRIER ✓  
T&G PINE ✓  
WALL FINISH

FIBERGLAS ✓  
WALL INSUL

2X6 STUDS ✓  
MAX 16" O.C  
BRACING AS REQ'D ✓

T&G PINE ✓  
FLOOR  
EL. -40"

LANDING EL. -24"

2X10 JOISTS ~~12 1/2" SPA~~ ~~15" SPA~~ ~~15" SPA~~


2" RIGID INSUL ✓  
1/4" HARDWARE CLOTH ✓

6X6 PT. POST ✓  
SKIRTING ✓

REMOVE FOAM -  
REPLACE W/ 8" CRUSHED STONE ✓  
VAPOR BARRIER ✓  
PRECAST CONG PIERS -  
12" SQ (TOP) 16" SQ (BOTTOM) ✓  
X 4' DEEP. SET FLUSH W/ GRADE ✓

FLOOR TO FLOOR = 8'-10 3/4"

Section A-A 1/2" = 1'-0"  
Proposed Addition to  
76 Elizabeth St  
Peaks Island  
April 1, 2002

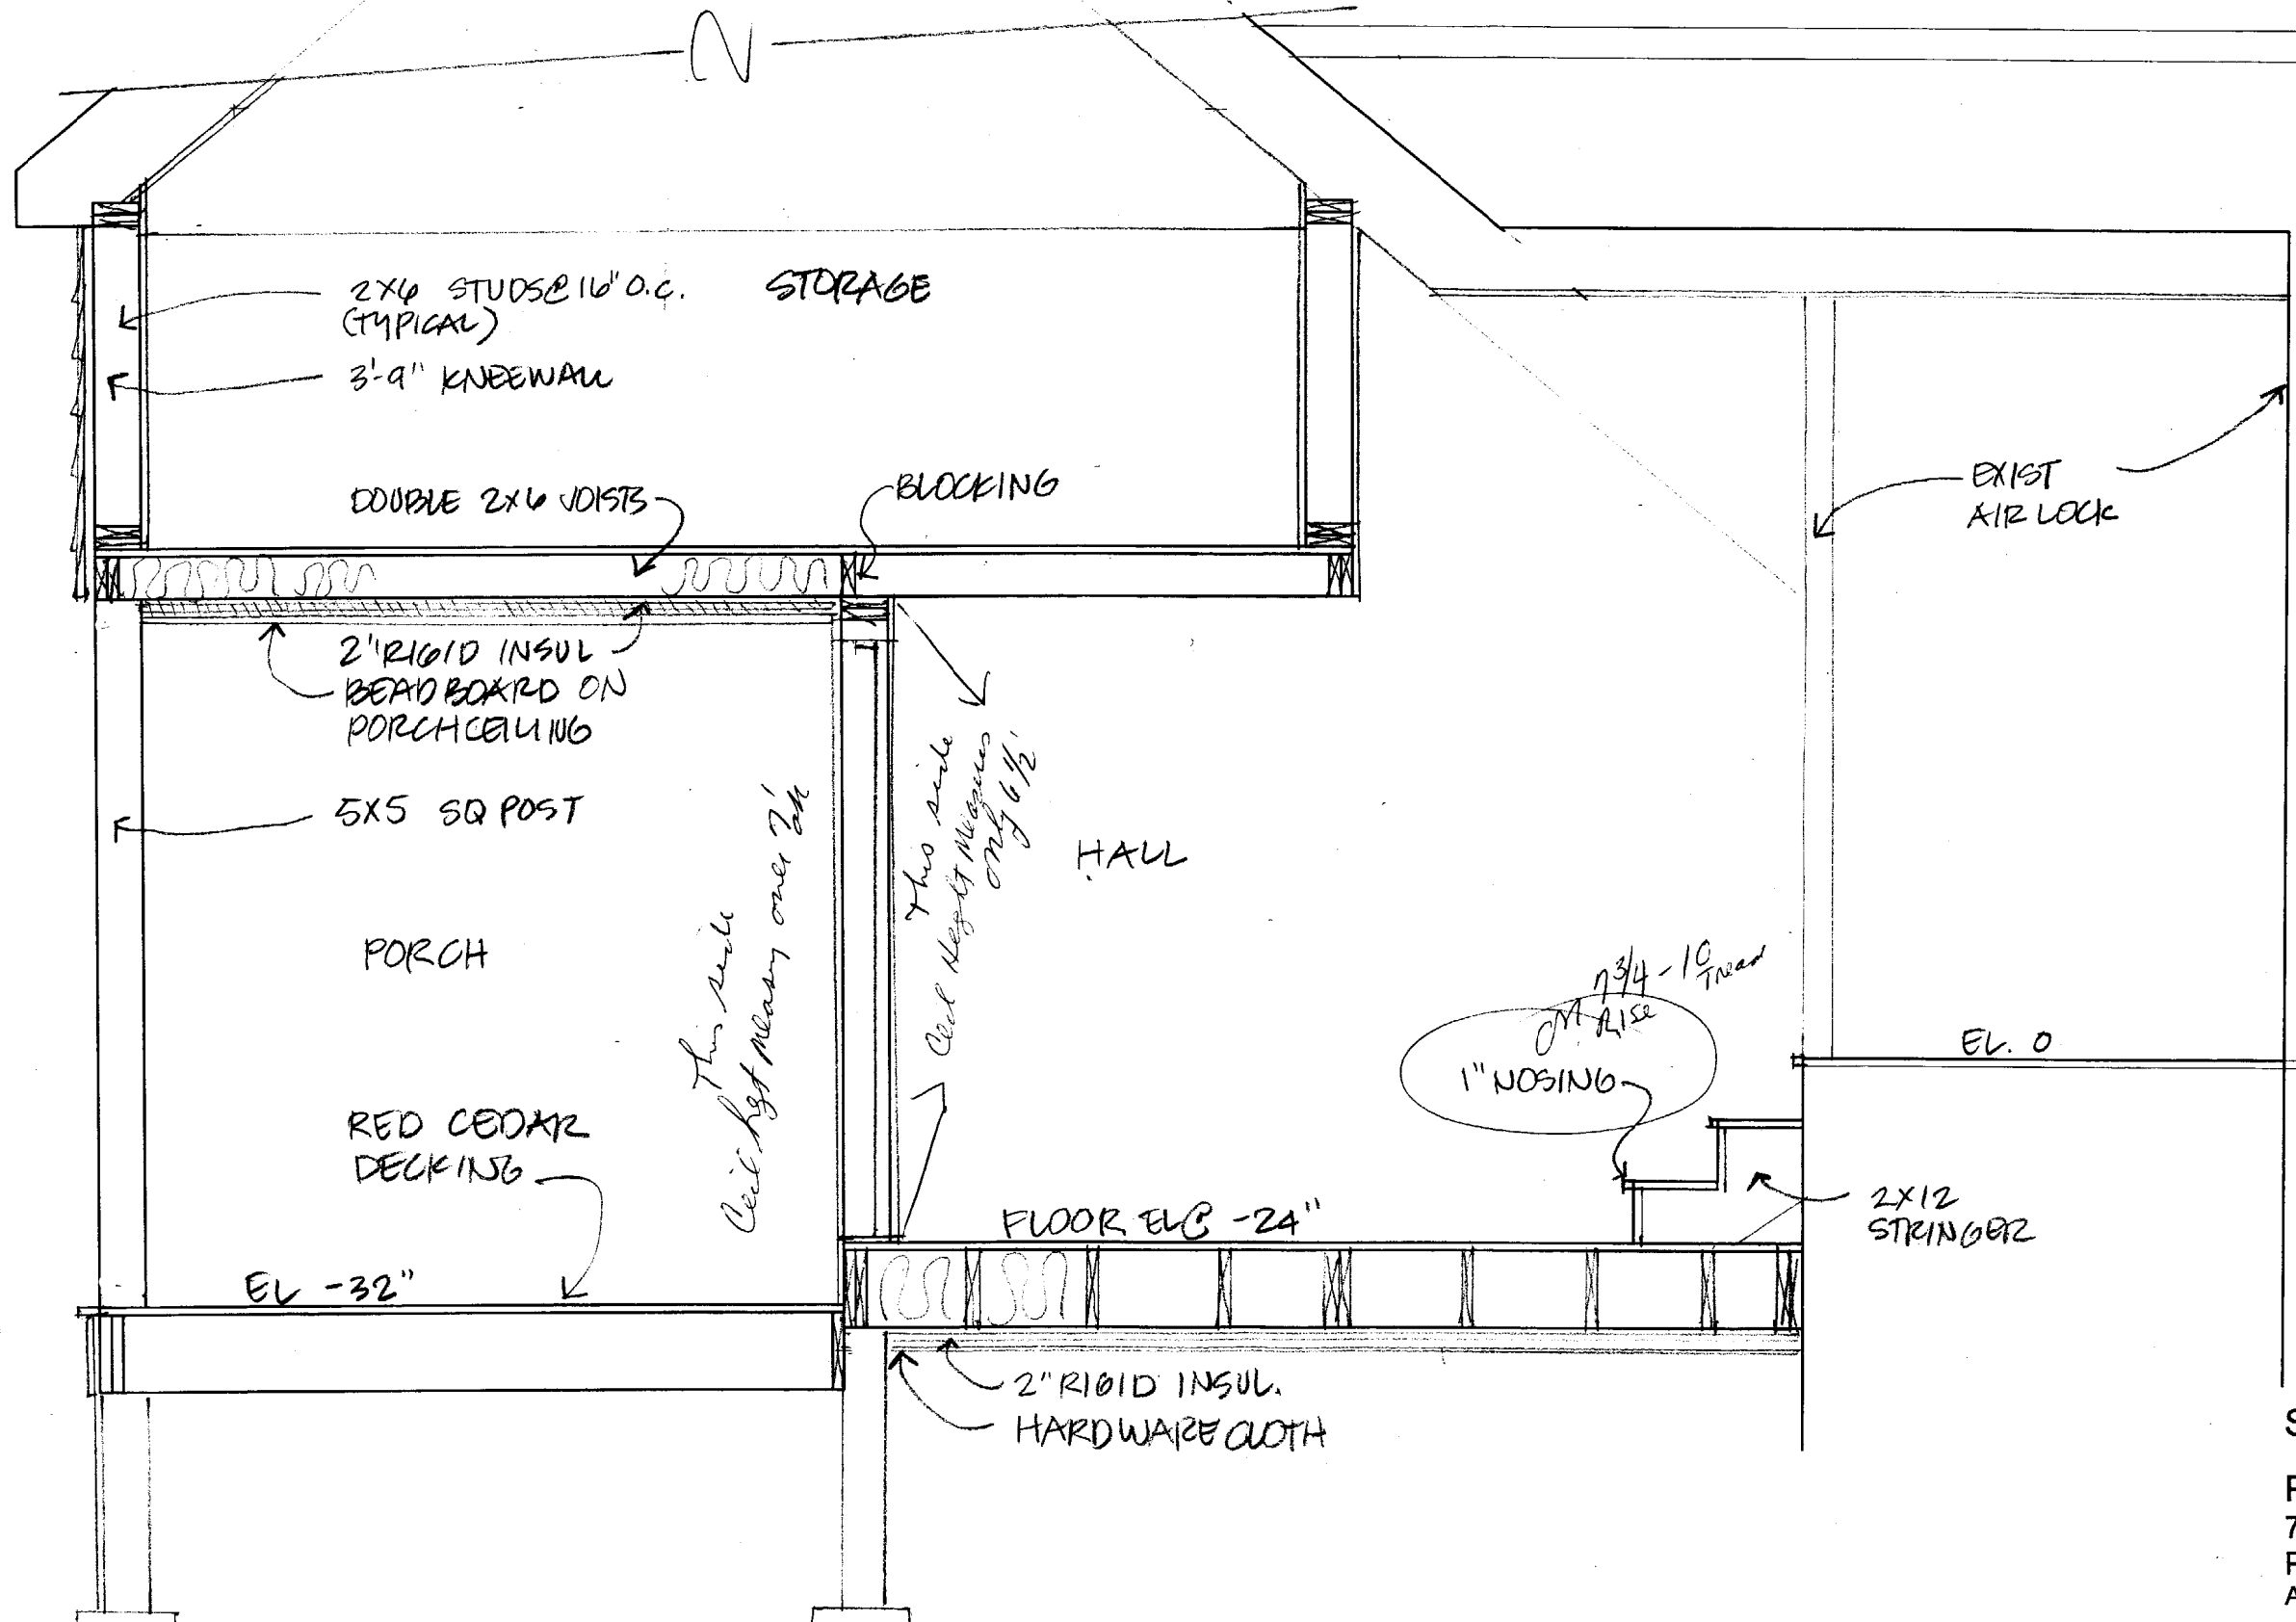

2x4 STUDS @ 16' O.C. (TYPICAL) STORAGE  
 3'-9" KNEEWALL

DOUBLE 2x6 JOISTS BLOCKING

2' RIGID INSUL  
 BEAD BOARD ON  
 PORCH CEILING

5x5 SQ POST

PORCH

RED CEDAR  
 DECKING

EL -32"

*This side  
 Ceiling means one 2x4*

*This side  
 Ceiling means  
 one 6 1/2"*

HALL

FLOOR EL -24"

7/8" - 10 Tread  
 1" NOSING

EXIST  
 AIR LOCK

EL. 0

2x12  
 STRINGER


2' RIGID INSUL.  
 HARDWARE CLOTH

1/2" = 1'-0"

Section B-B

Proposed Addition to  
 76 Elizabeth St  
 Peaks Island  
 April 1, 2002

*PKI*

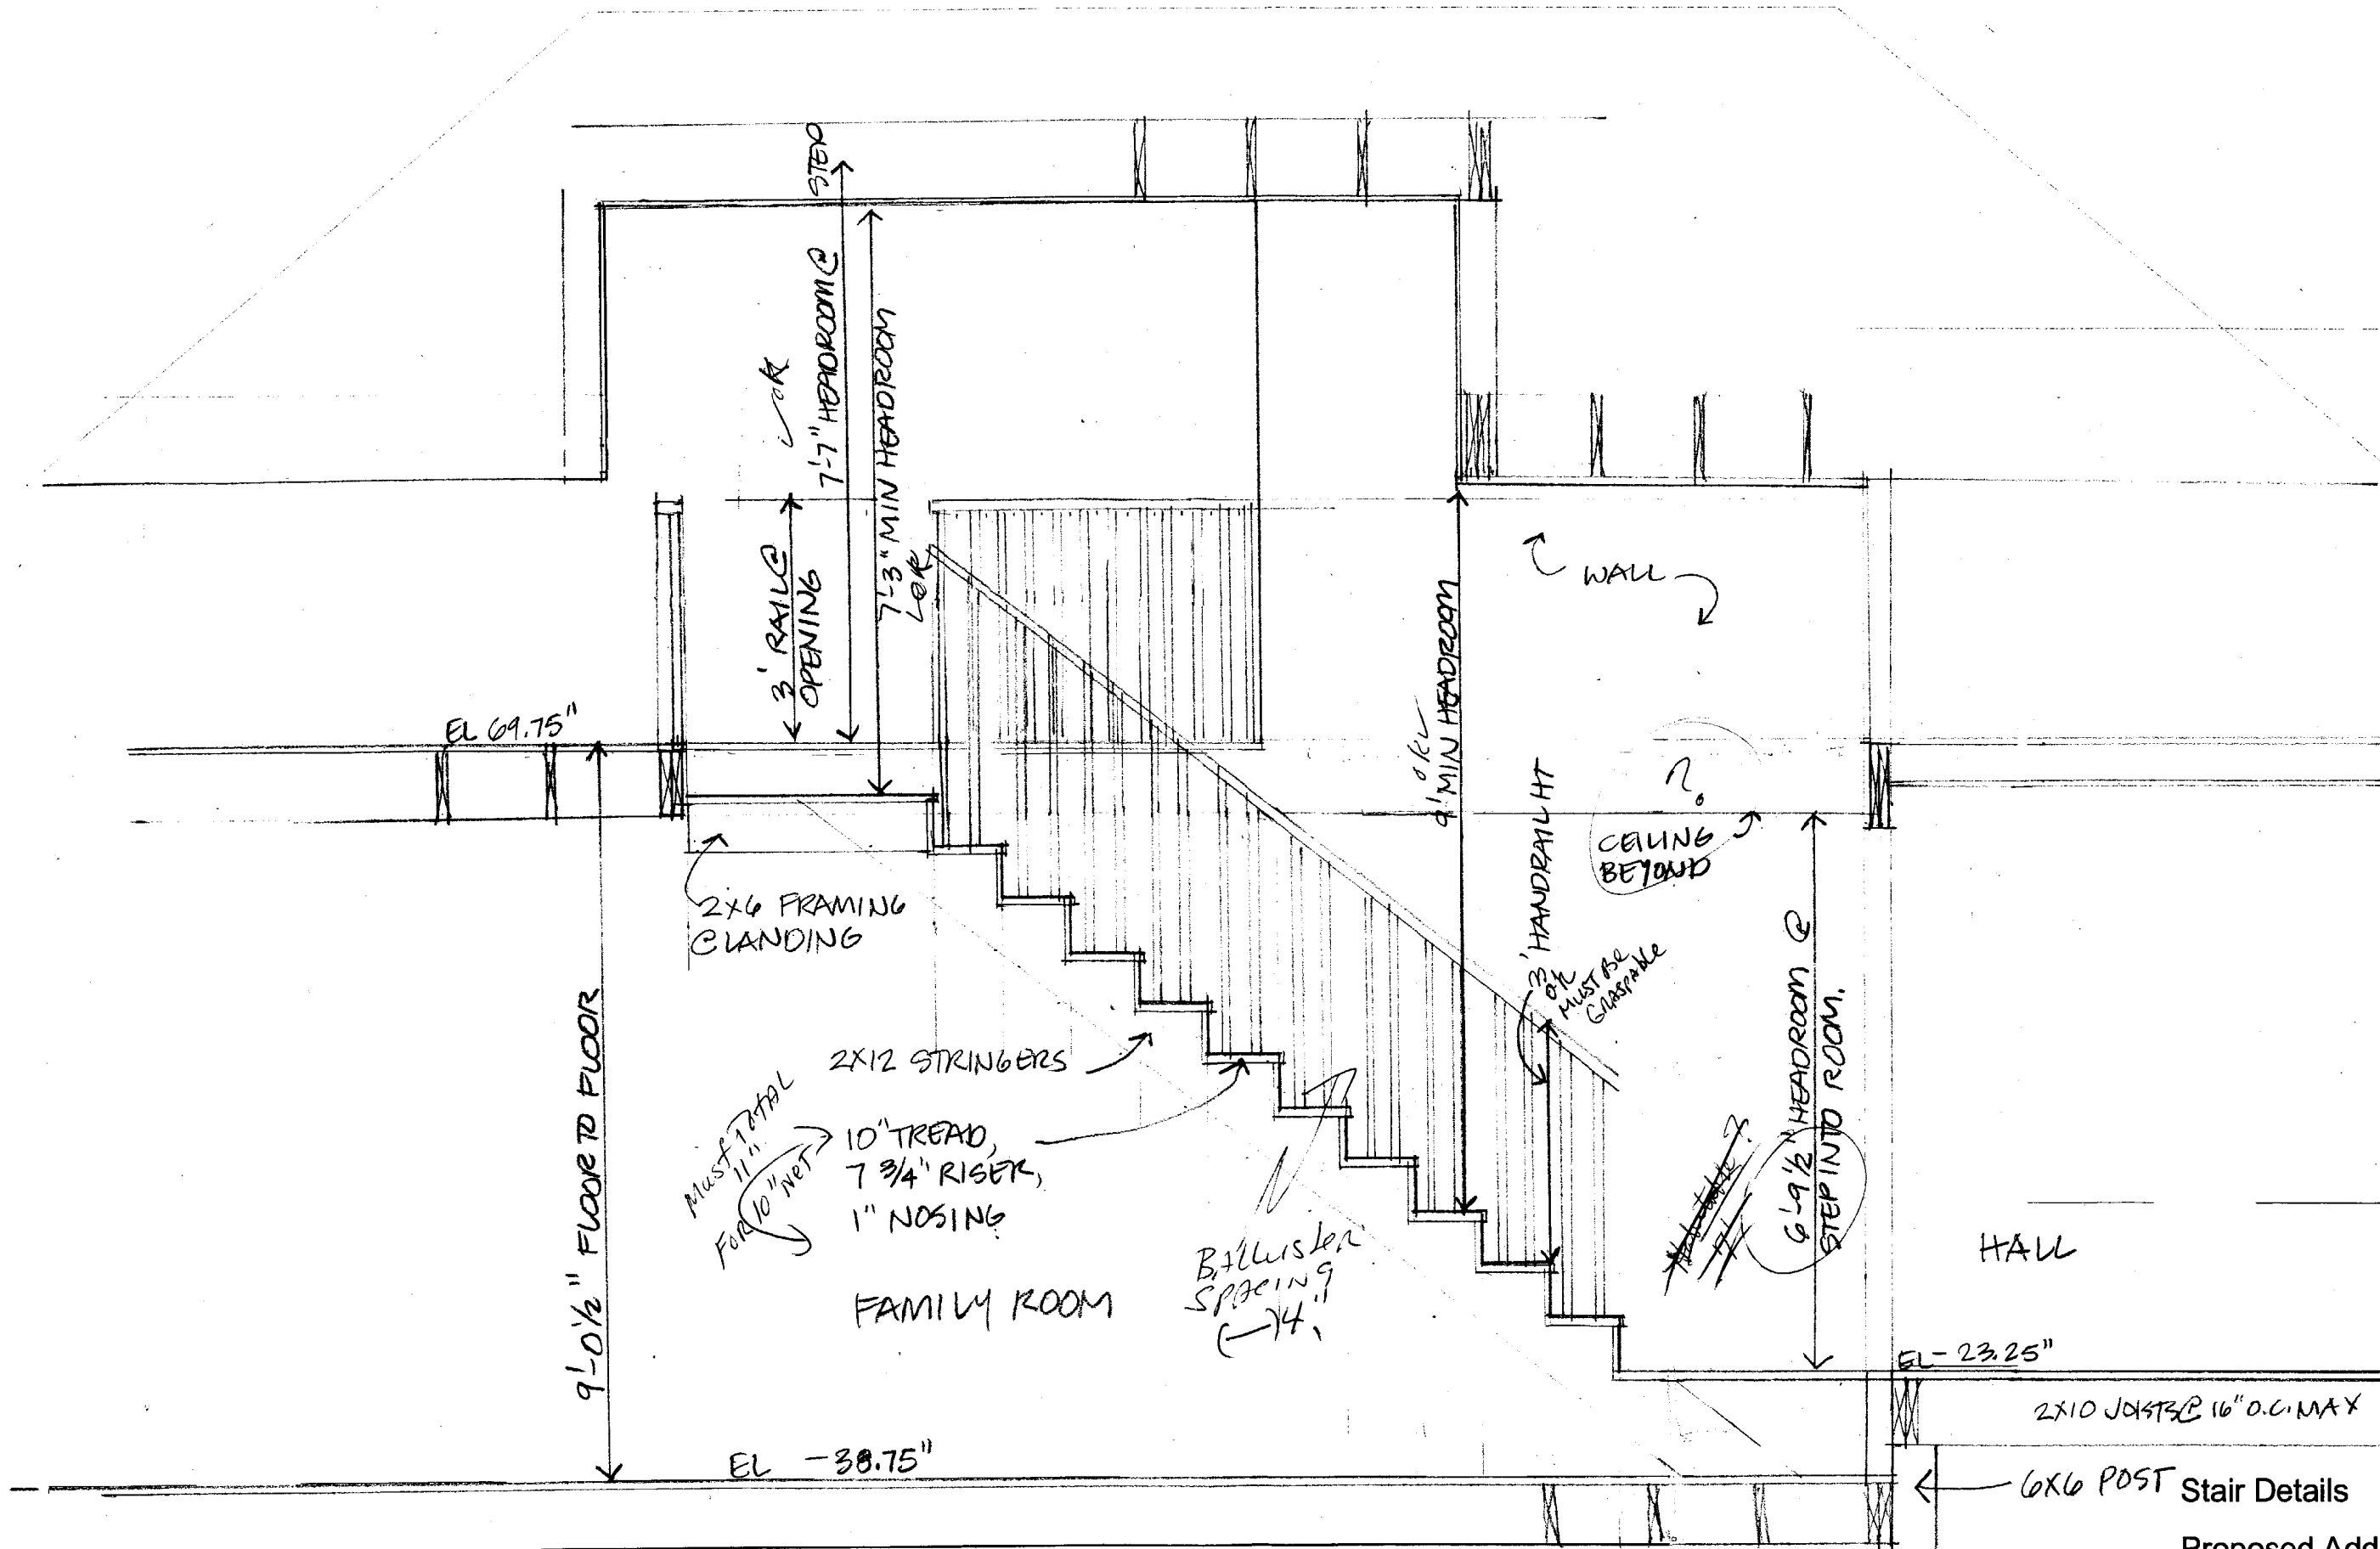

EL 69.75"

3' RAIL @  
OPENING  
7-7" HEADROOM @  
STEP

7-3" MIN HEADROOM

2x6 FRAMING  
CLADDING

9'-0 1/2" FLOOR TO FLOOR

2x12 STRINGERS

MUST TOTAL  
11" FOR  
10" NET

10" TREAD,  
7 3/4" RISER,  
1" NOSING

FAMILY ROOM

BALLUSTER  
SPACING  
4"

9' MIN HEADROOM

3' HANDRAIL HT  
OR  
MUST BE  
GRASPABLE

CEILING  
BEYOND

6-9 1/2" HEADROOM @  
STEP INTO ROOM.

HALL

EL -23.25"

2x10 JOIST @ 16" O.C. MAX

6x6 POST

Stair Details

Proposed Addition to  
76 Elizabeth St  
Peaks Island  
April 1, 2002 1/2" = 1' 0"

PA 12

**City of Portland, Maine - Building or Use Permit Application**

389 Congress Street, 04101 Tel: (207) 874-8703, Fax: (207) 874-8716

Permit No: 02-0253	ISSUE DATE: APR 24 2002	CBL: 043 H001001
Owner Name: General Marine Construction	Owner Address: 446 Commercial St	Phone:
Contractor Name: n/a	Contractor Address: PORTLAND	Phone:
Lessee/Buyer's Name: n/a	Phone: n/a	Permit Type: Signs - Permanent
		Zone: WCT

Location of Construction: 450 Commercial St	Owner Name: General Marine Construction	Owner Address: 446 Commercial St
Business Name: n/a	Contractor Name: n/a	Contractor Address: PORTLAND
Lessee/Buyer's Name: n/a	Phone: n/a	Permit Type: Signs - Permanent
		Zone: WCT

Past Use: Commercial / Retail; Seafood	Proposed Use: Commercial / Same; Erect 16 sq. ft. Sign	Permit Fee:	Cost of Work: \$0.00	CEO District: 2
--	--	-------------	----------------------	-----------------

FIRE DEPT: <input checked="" type="checkbox"/> Approved <input type="checkbox"/> Denied <i>N/A</i>	INSPECTION: Use Group: U-Sign Type: BOCA 1999 Signature: <i>T/M</i>
--	--

Proposed Project Description: Erect 16 sq. ft. Sign

*Shall remove old 4x8' sign per application*

PEDESTRIAN ACTIVITIES DISTRICT (P.A.D.)

Action:  Approved  Approved w/Conditions  Denied

Signature: \_\_\_\_\_ Date: \_\_\_\_\_

Permit Taken By: *gg* Date Applied For: 03/22/2002

**Zoning Approval**

- This permit application does not preclude the Applicant(s) from meeting applicable State and Federal Rules.
- Building permits do not include plumbing, septic or electrical work.
- Building permits are void if work is not started within six (6) months of the date of issuance. False information may invalidate a building permit and stop all work..

**Special Zone or Reviews**

Shoreland  
 Wetland  
 Flood Zone  
 Subdivision  
 Site Plan

Maj  Minor  MIM

Date: *OK* *4/12/02*

**Zoning Appeal**

Variance  
 Miscellaneous  
 Conditional Use  
 Interpretation  
 Approved  
 Denied

Date: \_\_\_\_\_

**Historic Preservation**

Not in District or Landmark  
 Does Not Require Review  
 Requires Review  
 Approved  
 Approved w/Conditions  
 Denied

*Deb A 4/12/02*  
*to Deb A 4/12/02*

Date: \_\_\_\_\_

*DA 4/22/02*

**CERTIFICATION**

I hereby certify that I am the owner of record of the named property, or that the proposed work is authorized by the owner of record and that I have been authorized by the owner to make this application as his authorized agent and I agree to conform to all applicable laws of this jurisdiction. In addition, if a permit for work described in the application is issued, I certify that the code official's authorized representative shall have the authority to enter all areas covered by such permit at any reasonable hour to enforce the provision of the code(s) applicable to such permit.

SIGNATURE OF APPLICANT \_\_\_\_\_ ADDRESS \_\_\_\_\_ DATE \_\_\_\_\_ PHONE \_\_\_\_\_

RESPONSIBLE PERSON IN CHARGE OF WORK, TITLE \_\_\_\_\_ DATE \_\_\_\_\_ PHONE \_\_\_\_\_

Application ID Number: 2-0253

Department: Zoning

Status: Approved with Conditions

Reviewer: Marge Schmuckal

Comments:

450 Commercial St - microfiche does not show a retail use - only shows a change of use for wholesale - would need a change of use first before sign permit  
4/8/02 Came in for a change of use - so now I can approve signage

Approval Date: 04/12/2002

Issue Date: 03/22/2002

OK to Issue Permit

Name: Marge Schmuckal

Phone: [Redacted]

Date: [Redacted]

Conditions:

The old 4' x 8' sign shall be removed as stated in the permit application to allow for the new signage.

Create Date: 03/22/2002 By: gg

Update Date: 04/12/2002 By: mes

0 0 0 2 5 3

THIS IS NOT A PERMIT/CONSTRUCTION MAY NOT COMMENCE UNTIL THE PERMIT IS ISSUED

# SIGNAGE APPLICATION

THIS IS NOT A PERMIT  
CONSTRUCTION CANNOT NOT COMMENCE UNTIL THE PERMIT IS ISSUED

In the interest of processing your application in the quickest possible manner, please complete the Information below for a Building or Use Permit.

If you or the property owner owes real estate or personal property taxes or user charges on any property within the City, payment arrangements must be made before permits of any kind are accepted.

Location/Address of Construction: <u>450 Commercial ST</u>		
Total Square Footage of Proposed Structure <u>12,000</u>	Square Footage of Lot	
Tax Assessor's Chart, Block & Lot Number  Chart# <u>043</u> Block# <u>H</u> Lot# <u>001</u>	Owner: <u>ROBERT HALE</u>	Telephone #: <u>772-5354</u>
Lessee/Buyer's Name (If Applicable) <u>FREE RANGE FISH</u>	Owner's/Purchaser/Lessee Address: <u>450 Commercial ST Portland, ME</u>	Total s.f of signs <sup>16'</sup> <del>4</del> <u>1</u> * .20 <del>\$20</del> , plus \$30.00 TOTAL \$ <del>82.20</del> <u>46</u>
Current use: <u>RETAIL SEAFOOD</u> Proposed use: <u>SAME</u>		
Project description: <u>TO FREE RANGE FISH.</u>		
Applicants Name, Address & Telephone: <u>FREE RANGE FISH</u> <u>C/O M. Terry 103 A16A ST. PORTLAND, ME 04103</u> <u>761-2787</u>		
Contractor's Name, Address & Telephone:		
Who shall we contact when the permit is ready: <u>Maggie Terry</u> Telephone: <u>207-831-8813</u> <u>cell</u>		
If you would like it mailed, what mailing address should we use:		
		Rec'd By:

**SIGNAGE PRE-APPLICATION**

PLEASE ANSWER ALL QUESTIONS

WCT

ADDRESS: 450 Commercial Street ZONE: Commercial

OWNER: Roger Hall (Building owner)

APPLICANT: Free Range Fish & Lobster - Tenant

ASSESSOR NO. \_\_\_\_\_

PLEASE CIRCLE APPROPRIATE ANSWER

SINGLE TENANT LOT? YES  NO  MULTI-TENANT LOT? YES  NO

FREESTANDING SIGN? (ex. Pole Sign) YES  NO  DIMENSIONS \_\_\_\_\_ HEIGHT \_\_\_\_\_

MORE THAN ONE SIGN? YES  NO  DIMENSIONS \_\_\_\_\_ HEIGHT \_\_\_\_\_

SIGN ATTACHED TO BLDG.? YES  NO  DIMENSIONS 48" x 48" = 16"

MORE THAN ONE SIGN? YES  NO  DIMENSIONS \_\_\_\_\_

AWNING: YES  NO  IS AWNING BACKLIT? YES  NO  HEIGHT OFF SIDEWALK \_\_\_\_\_

IS THERE ANY MESSAGE, TRADEMARK OR SYMBOL ON IT? \_\_\_\_\_

LIST ALL EXISTING SIGNAGE AND THEIR DIMENSIONS: 4' x 8' Deny taken down <sup>Sh</sup>

\*\*\* TENANT BLDG. FRONTAGE (IN FEET): 62 1/2 FT  
\*\*\* REQUIRED INFORMATION

AREA FOR COMPUTATION


**YOU SHALL PROVIDE:**  
**A SITE SKETCH AND BUILDING SKETCH SHOWING EXACTLY WHERE EXISTING AND NEW SIGNAGE IS LOCATED MUST BE PROVIDED. SKETCHES AND/OR PICTURES OF PROPOSED ARE ALSO REQUIRED.**

SIGNATURE OF APPLICANT: [Signature] DATE: 3/21/2012





Floor


What's up is coming down

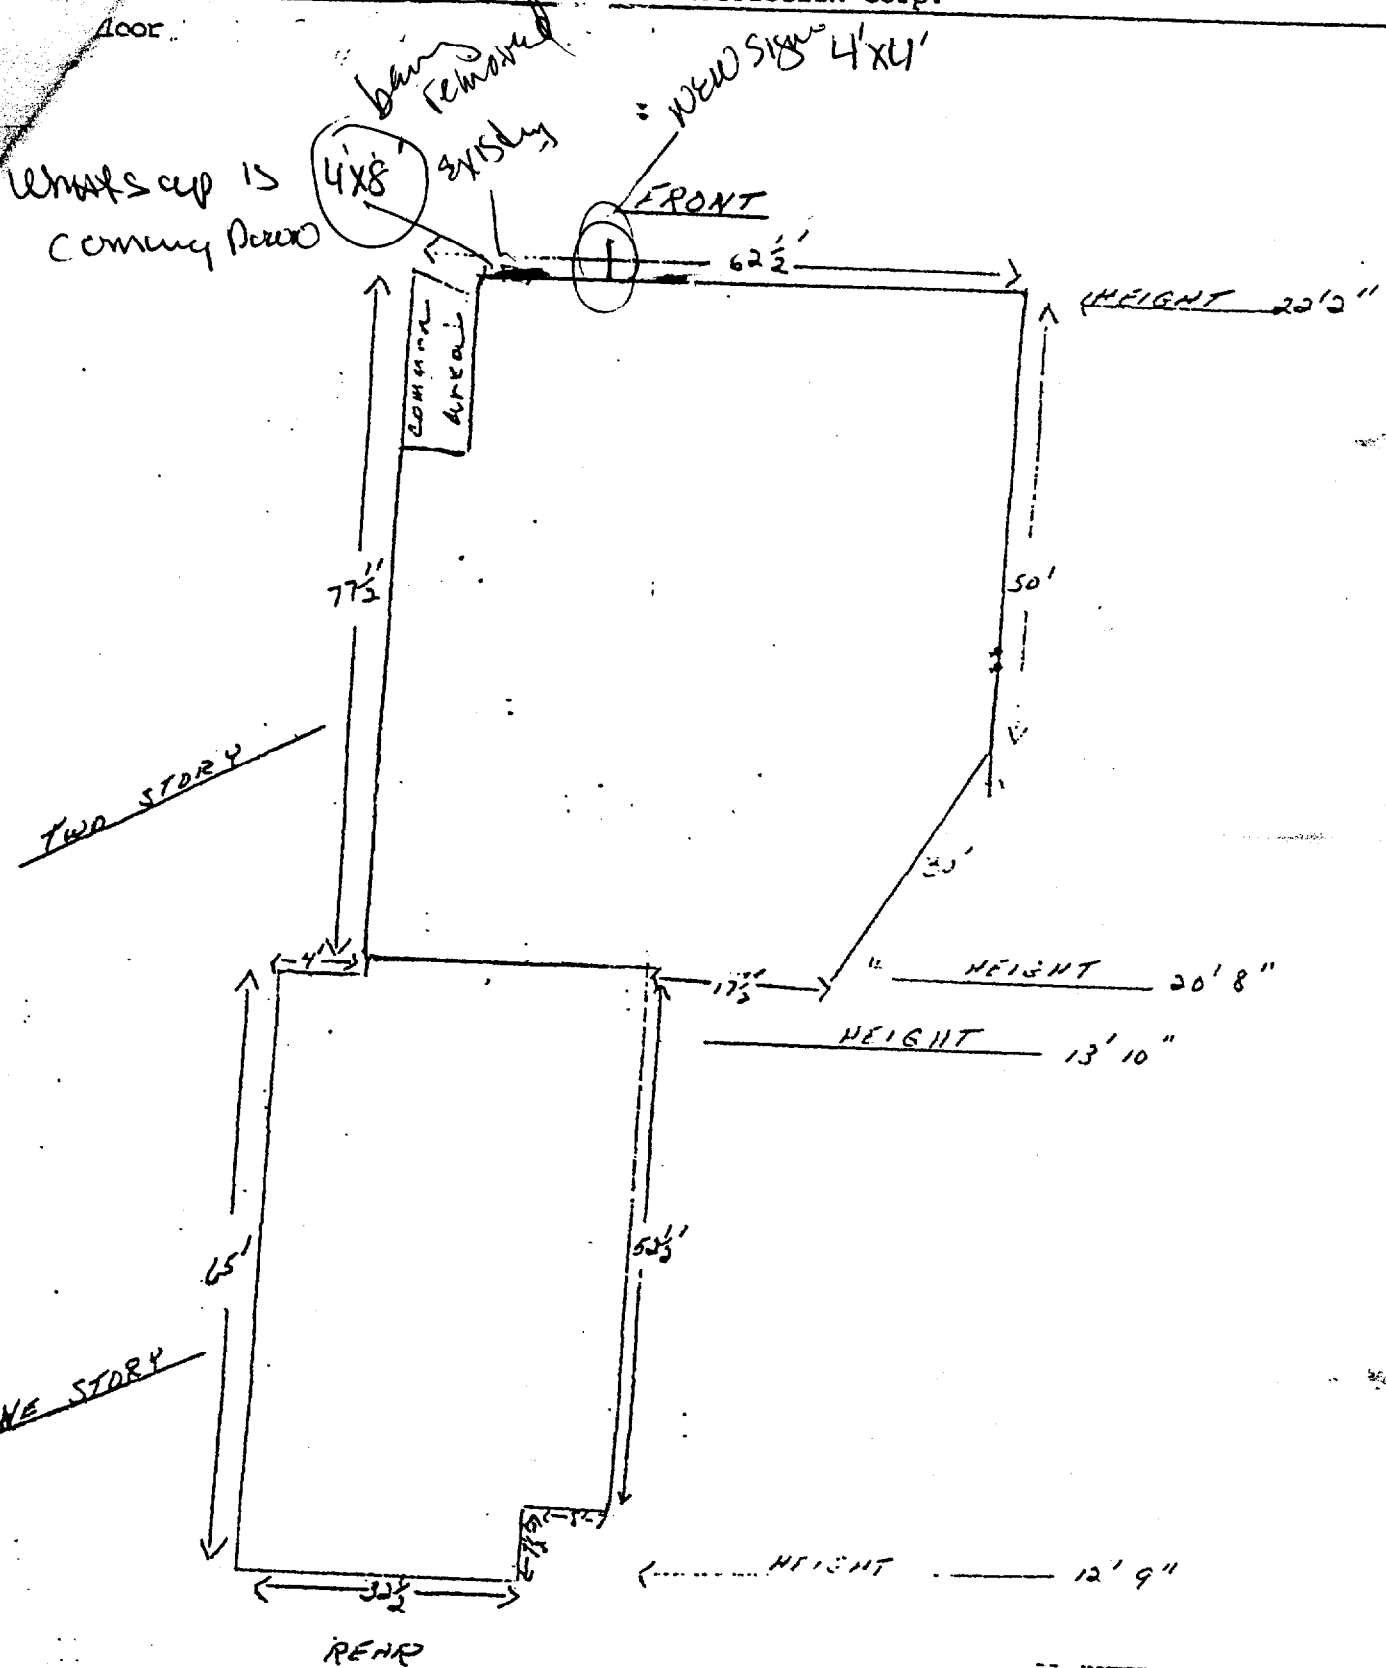

SCALE 1" = 30'	
1st floor	7,149.3 sq ft
2nd floor	4,881.3 sq ft
Total	12,030.6 sq ft

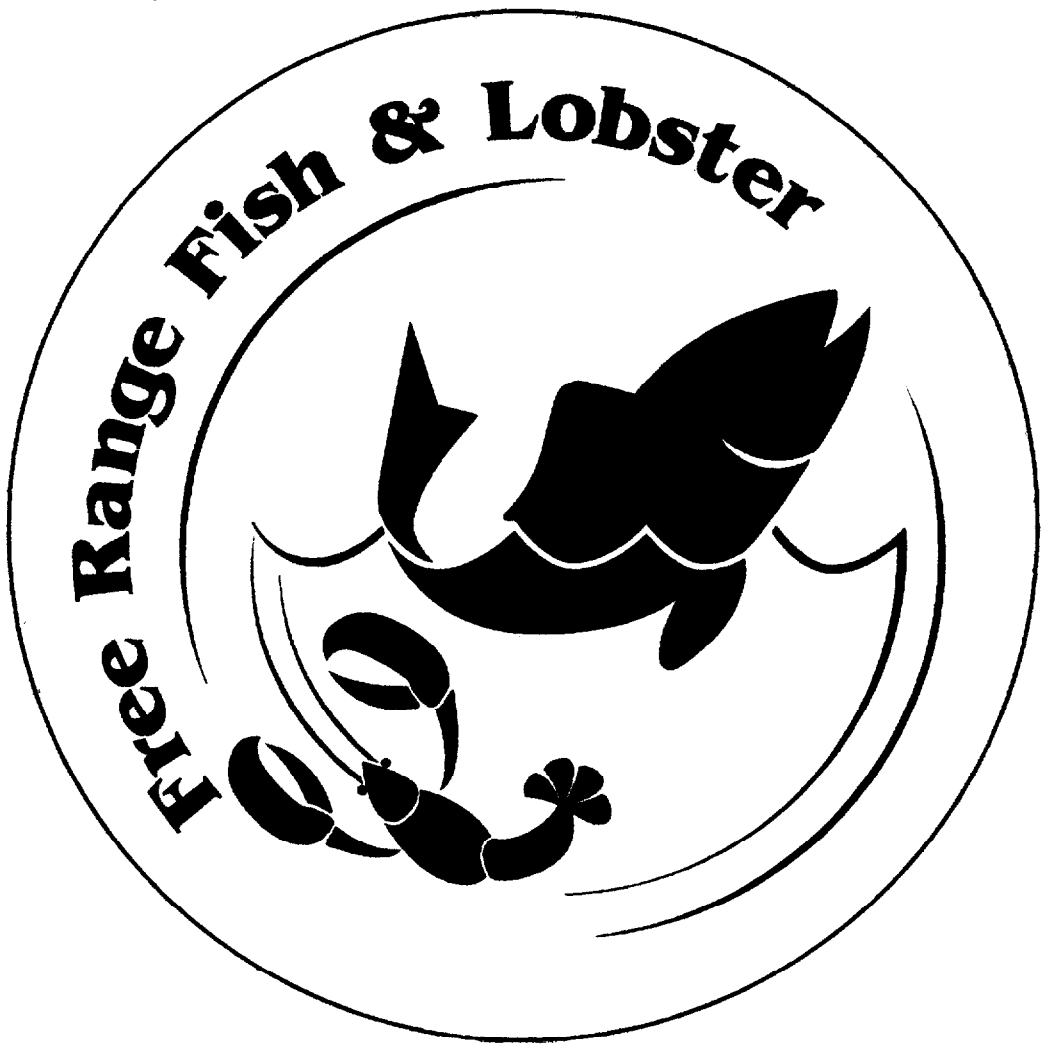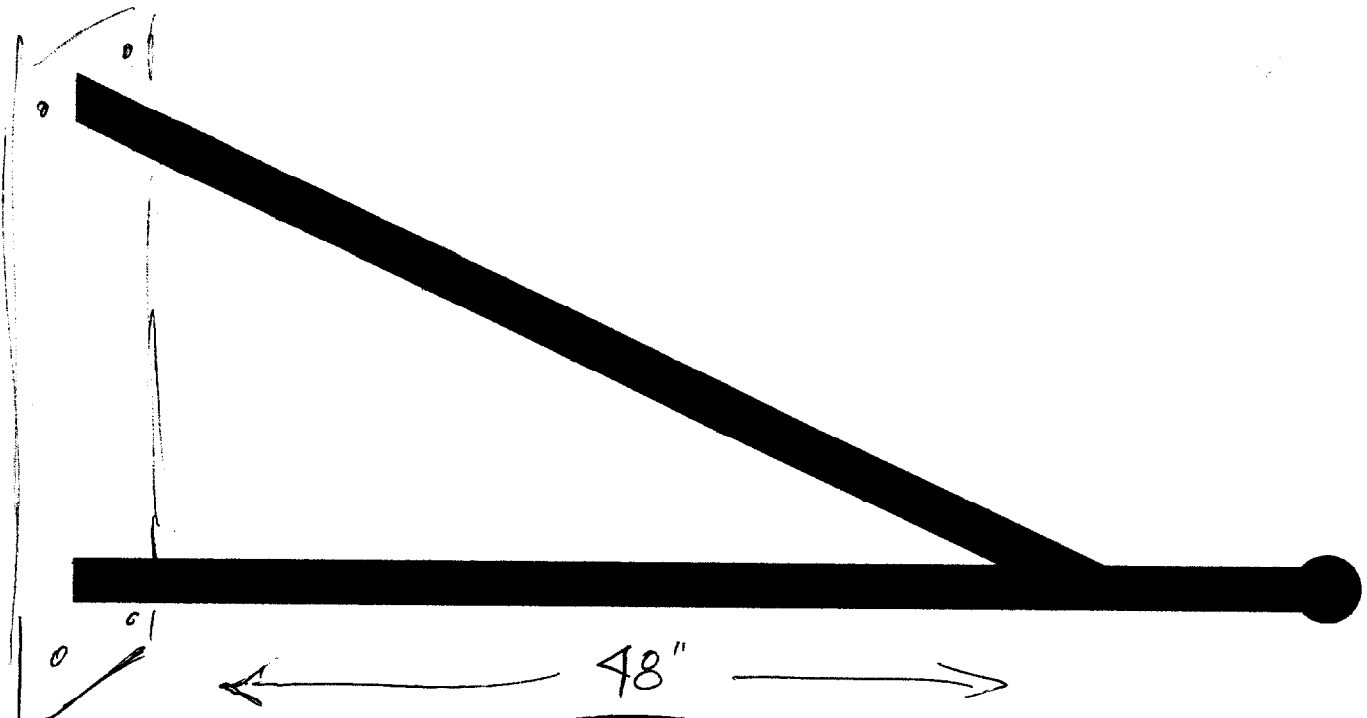

**WE PACK TO TRAVEL**

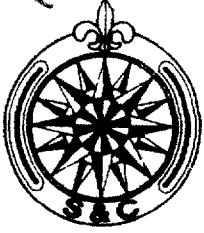

**Smithwick & Clarke Insurance, Inc.**  
Local Knowledge • Experience Worldwide™

400 Commercial Street  
Portland, ME 04101

Telephone: 207-761-1636  
Facsimile: 207-761-2045  
Toll Free: 1-800-370-1883

---

January 7, 2002


Free Range Fish Co.  
103 Alba Street  
Portland, ME 04103

Dear Insured,

Enclosed is a copy of the certificate of insurance for your records. A copy was mailed to City of Portland in today's mail as well. An endorsement will be issued by the insurance company very shortly and I will mail you a copy upon receipt.

Feel free to call if any questions.

Sincerely,

  
Suzanne Veilleux



# CERTIFICATE OF LIABILITY INSURANCE

DATE  
01/07/2002INSURER  
Whick & Clarke Insurance, Inc.  
Commercial Street

THIS CERTIFICATE IS ISSUED AS A MATTER OF INFORMATION ONLY AND CONFERS NO RIGHTS UPON THE CERTIFICATE HOLDER. THIS CERTIFICATE DOES NOT AMEND, EXTEND OR ALTER THE COVERAGE AFFORDED BY THE POLICIES BELOW.

## INSURERS AFFORDING COVERAGE

Portland ME 04101-

INSURER A: North American Specialty Ins Co.

INSURER B:  
INSURER C:  
INSURER D:  
INSURER E:

Portland ME 04103-

## TERMS

POLICIES OF INSURANCE LISTED BELOW HAVE BEEN ISSUED TO THE INSURED NAMED ABOVE FOR THE POLICY PERIOD INDICATED. NOTWITHSTANDING ANY REQUIREMENT, TERM OR CONDITION OF ANY CONTRACT OR OTHER DOCUMENT WITH RESPECT TO WHICH THIS CERTIFICATE MAY BE ISSUED OR MAY PERTAIN, INSURANCE AFFORDED BY THE POLICIES DESCRIBED HEREIN IS SUBJECT TO ALL THE TERMS, EXCLUSIONS AND CONDITIONS OF SUCH POLICIES. REGATE LIMITS SHOWN MAY HAVE BEEN REDUCED BY PAID CLAIMS.

TYPE OF INSURANCE	POLICY NUMBER	POLICY EFFECTIVE DATE (MM/DD/YY)	POLICY EXPIRATION DATE (MM/DD/YY)	LIMITS
GENERAL LIABILITY	AQC0000031-00	11/01/2001	11/01/2002	EACH OCCURRENCE \$ 1,000,000
<input checked="" type="checkbox"/> COMMERCIAL GENERAL LIABILITY				FIRE DAMAGE (Any one fire) \$ 100,000
<input type="checkbox"/> CLAIMS MADE <input checked="" type="checkbox"/> OCCUR		/ /	/ /	MED EXP (Any one person) \$ 5,000
		/ /	/ /	PERSONAL & ADV INJURY \$ 1,000,000
GEN'L AGGREGATE LIMIT APPLIES PER:		/ /	/ /	GENERAL AGGREGATE \$ 2,000,000
<input type="checkbox"/> POLICY <input type="checkbox"/> PRO-JECT <input type="checkbox"/> LOC		/ /	/ /	PRODUCTS - COMP/OP AGG \$ 1,000,000
AUTOMOBILE LIABILITY		/ /	/ /	COMBINED SINGLE LIMIT (Ea accident) \$
<input type="checkbox"/> ANY AUTO		/ /	/ /	BODILY INJURY (Per person) \$
<input type="checkbox"/> ALL OWNED AUTOS		/ /	/ /	BODILY INJURY (Per accident) \$
<input type="checkbox"/> SCHEDULED AUTOS		/ /	/ /	PROPERTY DAMAGE (Per accident) \$
<input type="checkbox"/> HIRED AUTOS		/ /	/ /	AUTO ONLY - EA ACCIDENT \$
<input type="checkbox"/> NON-OWNED AUTOS		/ /	/ /	OTHER THAN EA ACC \$
GARAGE LIABILITY		/ /	/ /	AUTO ONLY: AGG \$
<input type="checkbox"/> ANY AUTO		/ /	/ /	EACH OCCURRENCE \$
EXCESS LIABILITY		/ /	/ /	AGGREGATE \$
<input type="checkbox"/> OCCUR <input type="checkbox"/> CLAIMS MADE		/ /	/ /	\$
<input type="checkbox"/> DEDUCTIBLE		/ /	/ /	\$
<input type="checkbox"/> RETENTION \$		/ /	/ /	\$
WORKERS COMPENSATION AND EMPLOYERS' LIABILITY		/ /	/ /	WC STATUTORY LIMITS OTHER \$
		/ /	/ /	E.L. EACH ACCIDENT \$
		/ /	/ /	E.L. DISEASE - EA EMPLOYEE \$
		/ /	/ /	E.L. DISEASE - POLICY LIMIT \$
OTHER		/ /	/ /	

DESCRIPTION OF OPERATIONS/LOCATIONS/VEHICLES/EXCLUSIONS ADDED BY ENDORSEMENT/SPECIAL PROVISIONS  
Certificate holder is named as additional insured only with respect to the sign or portion thereof adjacent to on or over City's property.CERTIFICATE HOLDER  ADDITIONAL INSURED; INSURER LETTER: \_\_\_\_\_

## CANCELLATION

City of Portland  
9 Congress Street

SHOULD ANY OF THE ABOVE DESCRIBED POLICIES BE CANCELLED BEFORE THE EXPIRATION DATE THEREOF, THE ISSUING INSURER WILL ENDEAVOR TO MAIL 10 DAYS WRITTEN NOTICE TO THE CERTIFICATE HOLDER NAMED TO THE LEFT, BUT FAILURE TO DO SO SHALL IMPOSE NO OBLIGATION OR LIABILITY OF ANY KIND UPON THE INSURER, ITS AGENTS OR REPRESENTATIVES.

Portland ME 04101-

AUTHORIZED REPRESENTATIVE

## IMPORTANT

If the certificate holder is an ADDITIONAL INSURED, the policy(ies) must be endorsed. A statement on this certificate does not confer rights to the certificate holder in lieu of such endorsement(s).

If SUBROGATION IS WAIVED, subject to the terms and conditions of the policy, certain policies may require an endorsement. A statement on this certificate does not confer rights to the certificate holder in lieu of such endorsement(s).

## DISCLAIMER


The Certificate of Insurance on the reverse side of this form does not constitute a contract between the issuing insurer(s), authorized representative or producer, and the certificate holder, nor does it affirmatively or negatively amend, extend or alter the coverage afforded by the policies listed thereon.

**THIS IS NOT A PERMIT/CONSTRUCTION MAY NOT COMMENCE UNTIL THE PERMIT IS ISSUED**

**If the property is located in a HISTORIC DISTRICT, a separate sketch is required indicating the design, dimensions, construction materials and source of illumination if any. A photograph of the building façade should be submitted, showing where each sign is to be installed.**

**Certification**

*I hereby certify that I am the Owner of record of the named property, or that the owner of record authorizes the proposed work and that I have been authorized by the owner to make this application as his/her authorized agent. I agree to conform to all applicable laws of this jurisdiction. In addition, if a permit for work described in this application is issued, I certify that the Code Official's authorized representative shall have the authority to enter all areas covered by this permit at any reasonable hour to enforce the provisions of the codes applicable to this permit.*

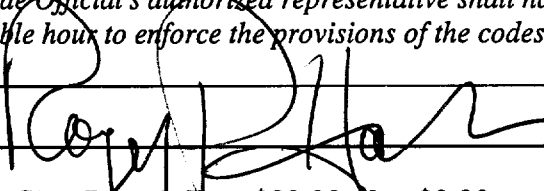Signature of applicant:  Date: 1-A-02

**Sign Permit Fee: \$30.00 plus \$0.20 per square foot.**

***A building permit is also required for any awning based on cost of work-\$30.00 for the first \$1,000.00 and \$6.00 for each additional \$1,000.00***

**BY FILLING OUT THIS APPLICATION IS DOES NOT MEET THAT YOU WILL BE APPROVED FOR THE AMOUNT OF SIGNAGE YOU ARE APPLYING FOR**

**IT IS SUGGESTED THAT YOU DO NOT ORDER ANY SIGNAGE UNTIL YOU HAVE RECEIVED YOUR SIGN PERMIT THAT HAS BEEN SIGNED BY THE BUILDING, ZONING AND POSSIBLE HISTORICAL OFFICIALS OF THIS OFFICE**

TO: FREE RANGE      DATE: 4/1  
 ATTN: MAGGIE      PHONE:  
 FROM: DON      FAX: 780-1710

**LOOKING TO MAKE A BIG IMPRESSION?**

# LARGE FORMAT DIGITAL PRINTING

• OUTSTANDING QUALITY • QUICK TURNAROUND

**PLUS**

• EXCEPTIONAL PRICES

• BANNERS • POSTERS • VEHICLE GRAPHICS AND MORE!

MAGGIE -

HERE'S THE SKETCH (SIDE VIEW) OF THE BRACKET-  
 ING ARRANGEMENT WE'LL BE MOUNTING ON  
 THE EXISTING STAINLESS STEEL RAILING OUT  
 ON THAT BALCONY. THE HEAVY DUTY BRACKET  
 WILL BE THROUGH BOLTED TO A 3/8" x 4"  
 STEEL FLAT BAR WHICH IN TURN WILL BE  
 BOLTED TO THE RAILING. THE RAILING IS 3/8"  
 STAINLESS STEEL (WELDED) AND IS LABBED INTO  
 THE BUILDING AND THE BALCONY - IT IS EXCEPTION-  
 ALLY SECURE. YOU MAY WANT TO TAKE PHOTOS  
 OF THE RAILING TO SHOW THE CITY.

**THE**  
**Signery**

PLEASE ADVISE

and Creative



**MAINE'S MOST COMPLETE SIGNAGE RESOURCE**

299 FOREST AVE. PORTLAND, ME. 04101  
 FAX: 879-1570      TEL: 879-7700

# Colonial Metal Works

21 Hardy Road  
Falmouth, Maine 04105  
(207) 797-2463

Bradford L. Crawford

RE: Free Range Fish Hobster

Date: 4-1-02  
3/8" TYP.

