

THIS IS NOT A BOUNDARY SURVEY


INSPECTION OF PREMISES
 I HEREBY CERTIFY TO Douglas Title Co.

133 York Street
 Portland, Maine

Job Number: 417-19
 Inspection Date: 06-27-12
 Scale: 1" = 30'

The monumentation is ~~not~~ in harmony with current deed description. *Deed is Vague*
 The building setbacks are ~~not~~ in conformity with town zoning requirements. *"Grandfathered"*
 The dwelling does not ~~appear to~~ fall within the special flood hazard zone as delineated by the Federal Emergency Management Agency.
 The land does not ~~appear to~~ fall within the special flood hazard zone as indicated on community-panel # 2300510013 B.

BUYER: Year 15, LLC
 SELLER: Bethany Ruth Cary

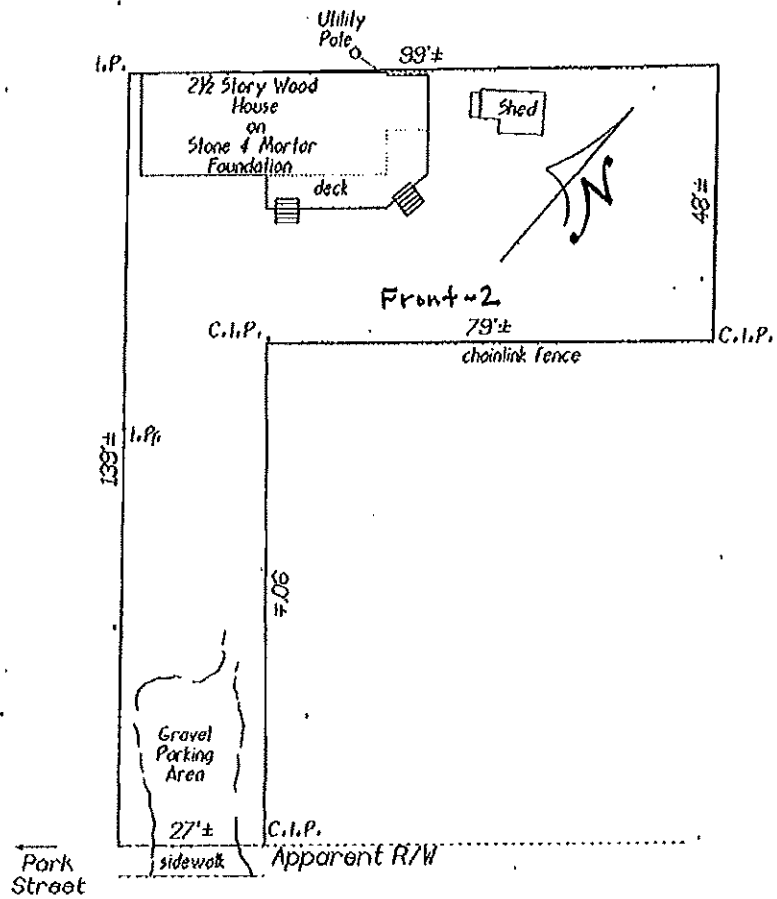

York Street
 (bituminous)

[Handwritten signature]

THIS PROPERTY IS SUBJECT TO ALL RIGHTS AND EASEMENTS OF RECORD. THOSE THAT ARE EVIDENT ARE SHOWN. THIS PLAN MIGHT NOT REVEAL CONFLICTS WITH ABUTTING DEEDS.

Bruce R. Bowmah
 INCORPORATED
 184 John Small Road
 Chebeague Island, Maine 04017
 Phone: (207) 846-1663
 Fax: (207) 846-1664



PLAN BOOK _____ PAGE _____ LOT _____
 DEED BOOK 22276 PAGE 211 COUNTY Cumberland

THIS PLAN IS NOT FOR RECORDING Drawn by: *[Signature]*