



1-2-15

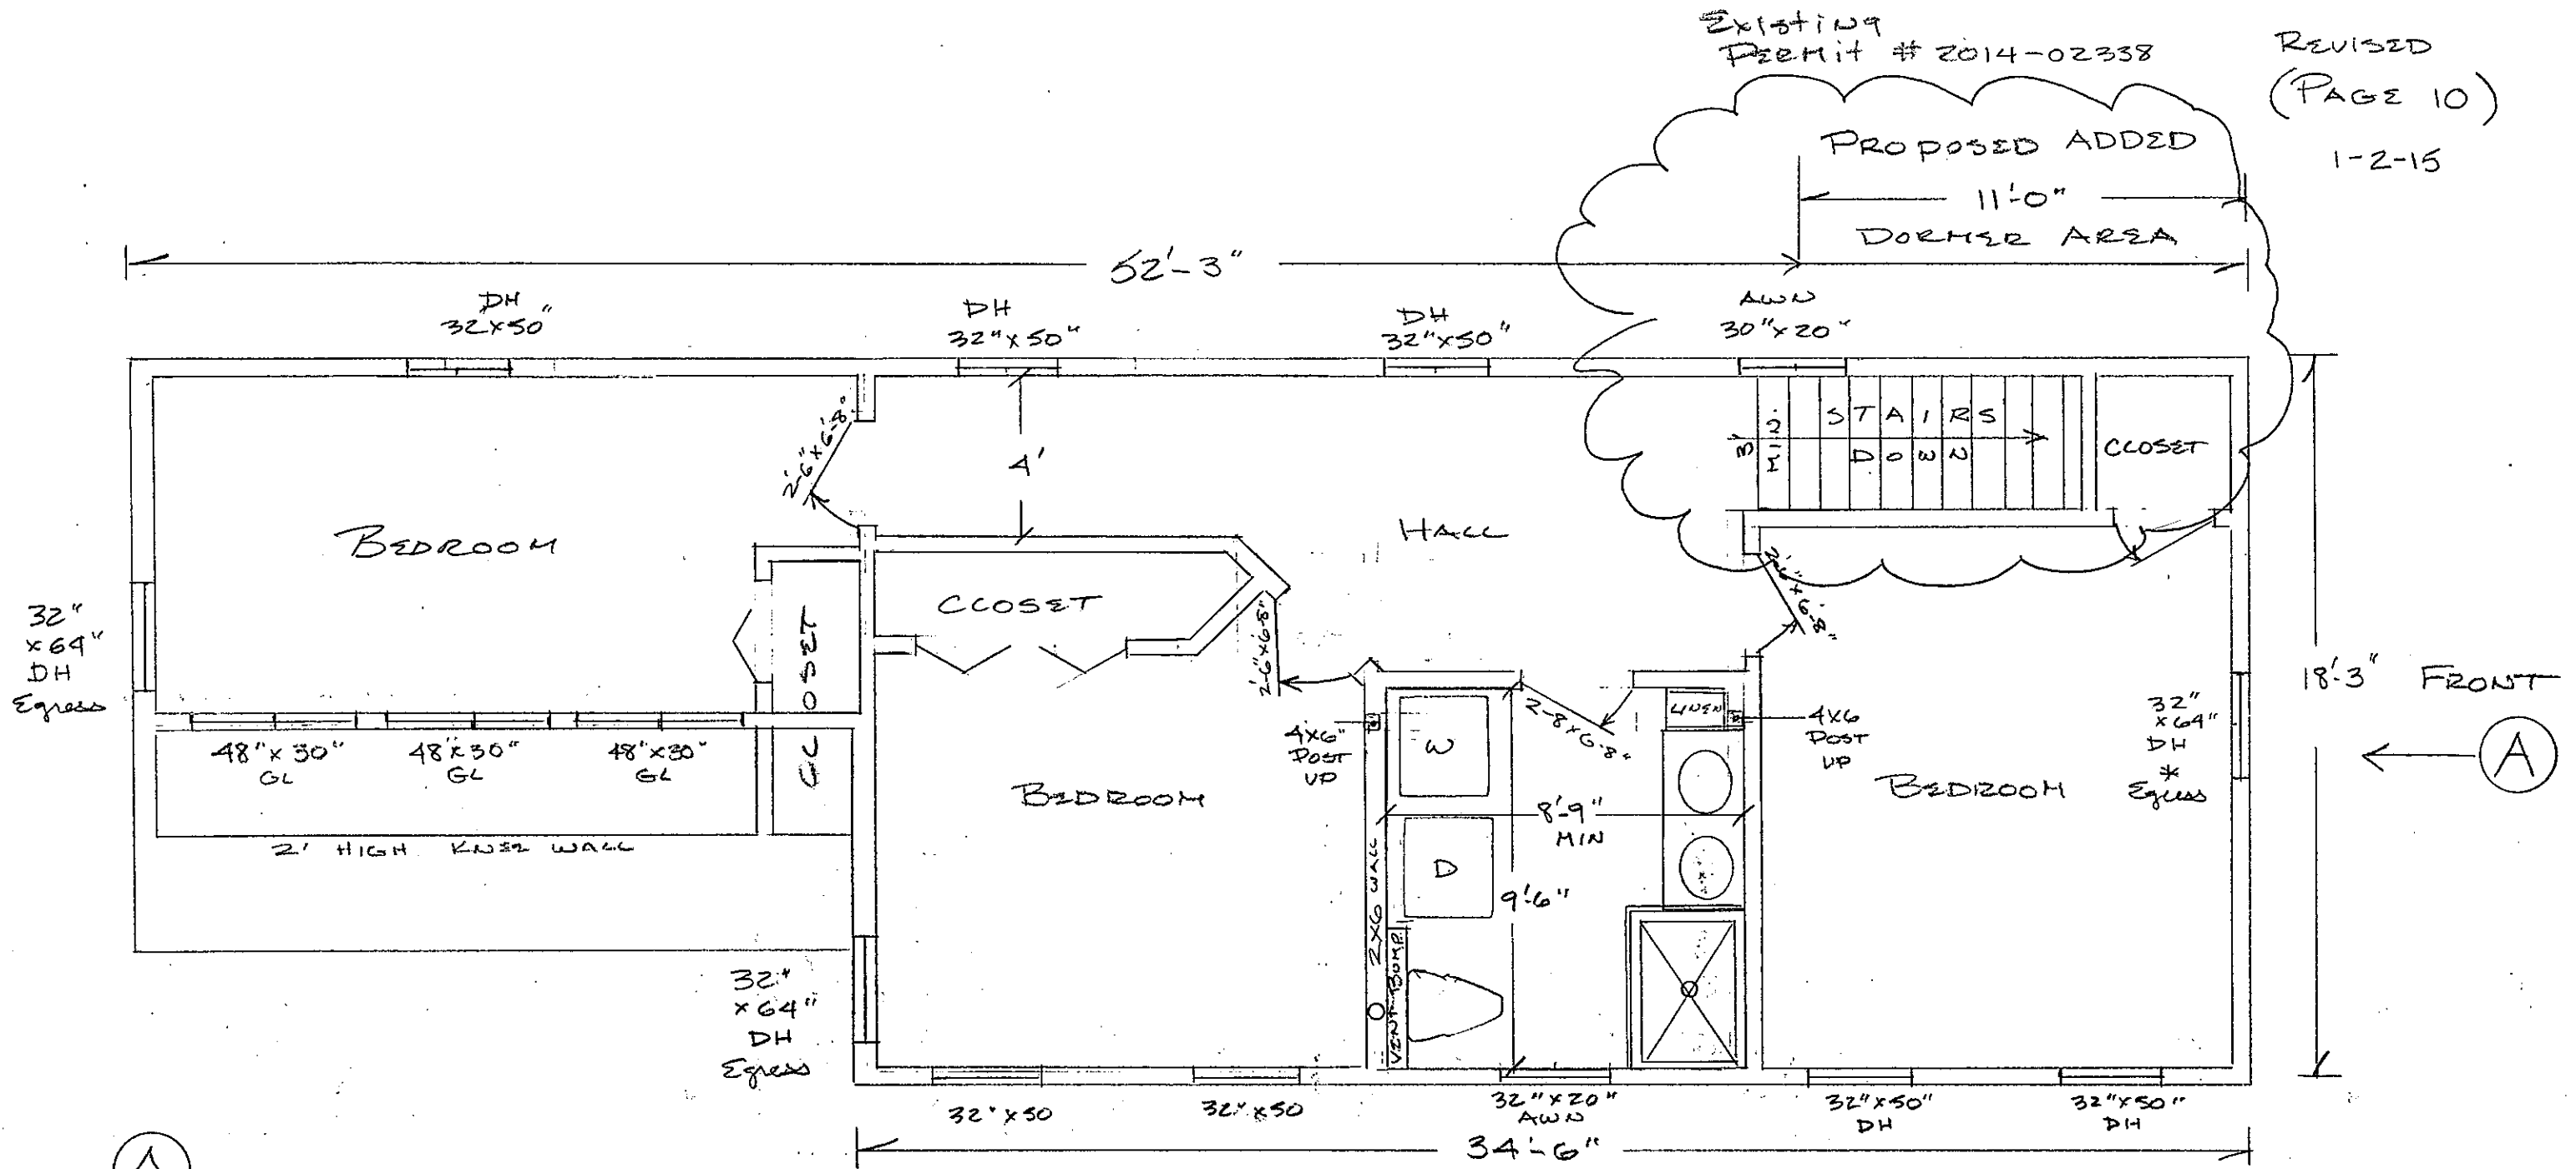

(A)

SCALE 1/4" = 1'

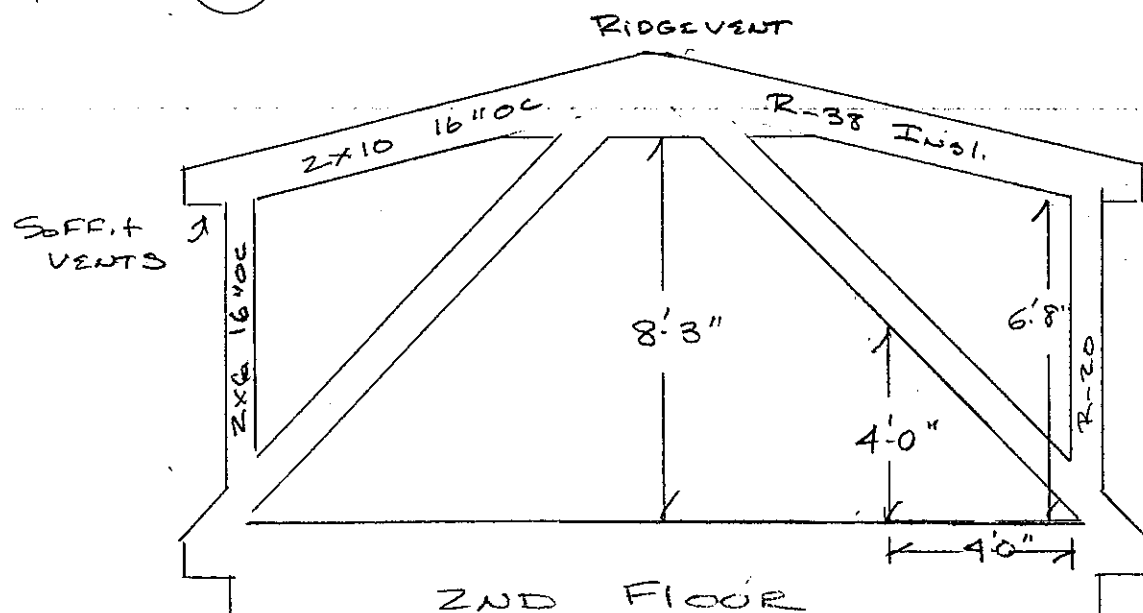

* PROPOSED 3RD FLOOR LAYOUT *

NOTE TO PLAN REVIEW :

* CURRENT 3RD FLOOR USAGE ALLOWED ON PERMIT # 2014-02338 298'/1045' 28.5%

* PROPOSED ADDED SPACE REQUESTED 44' SQ 298' + 44' = 342'/1045' 30.5%

Bob TERENZONI
16 TATE ST.
PORTLAND, ME.
(781) 844-6367