



1-2-15

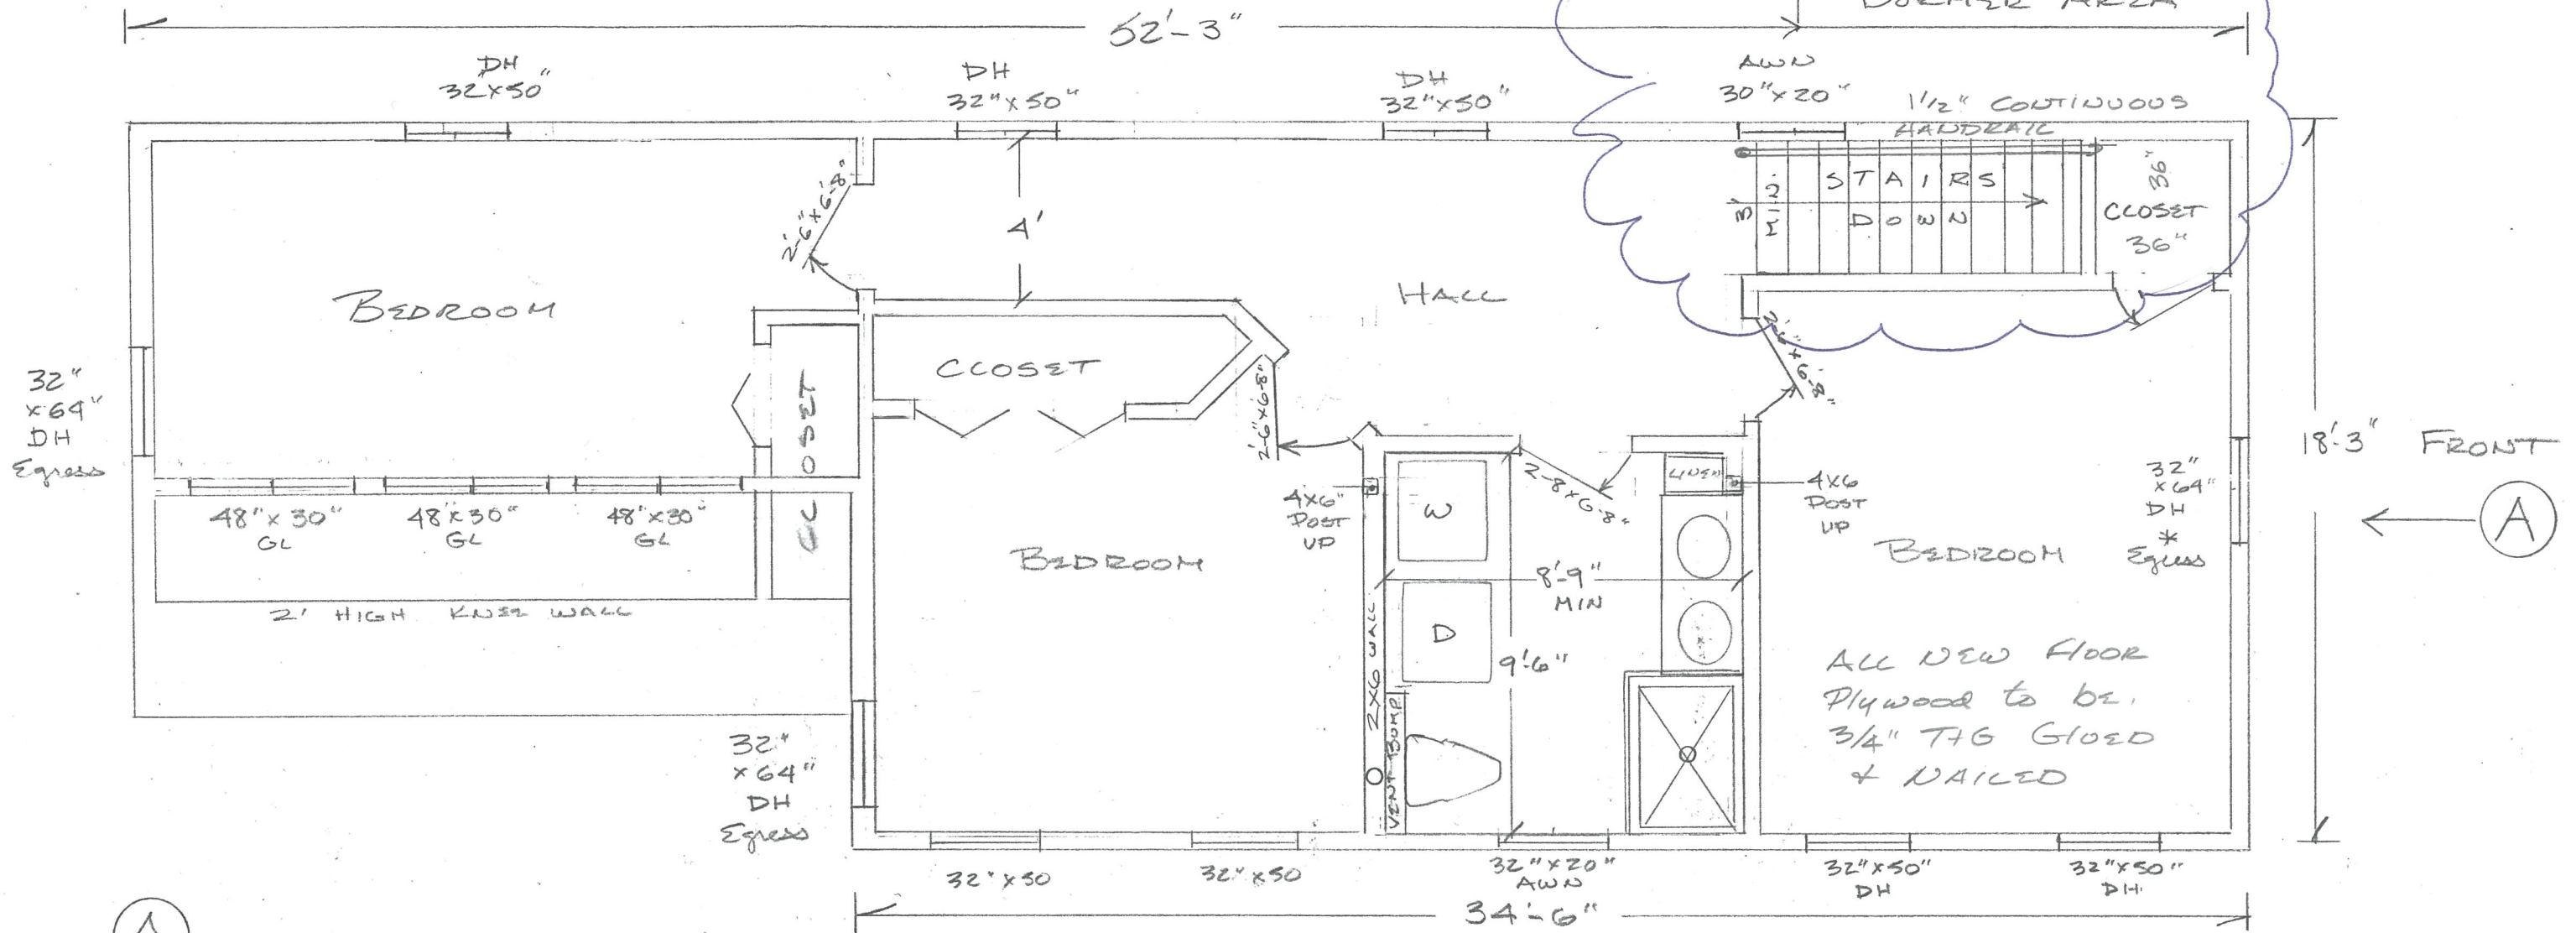

(A)

SCALE 1/4" = 1'

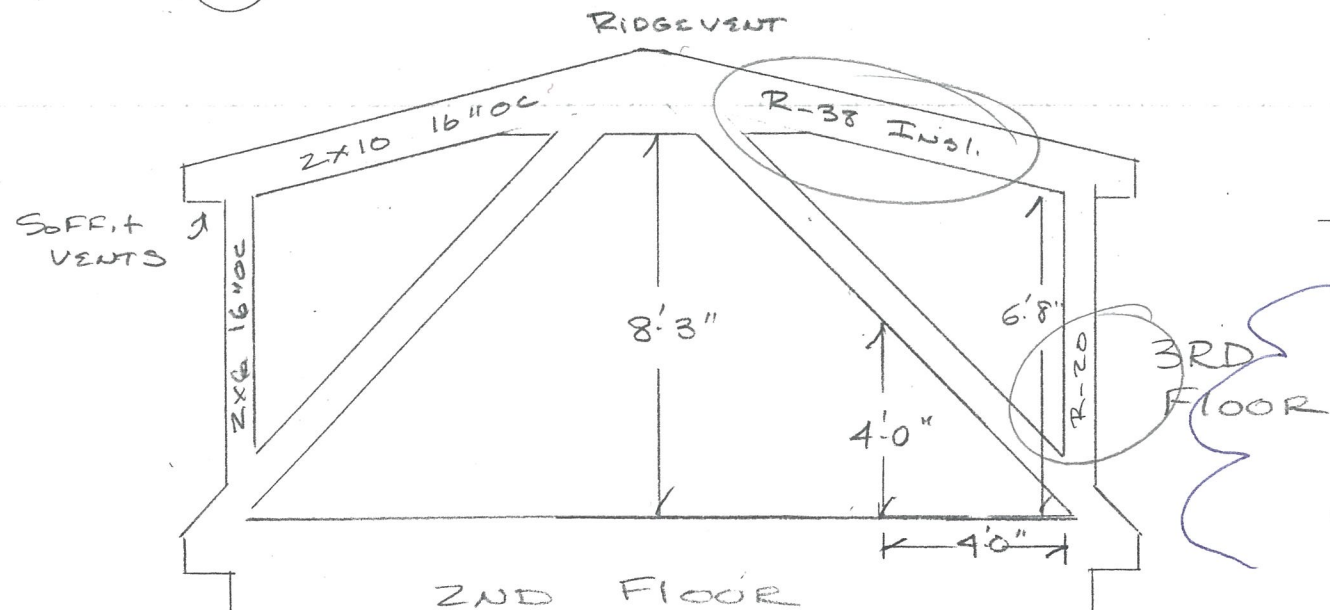

\* PROPOSED 3RD FLOOR LAYOUT \*

NOTE TO PLAN REVIEW :

\* CURRENT 3RD FLOOR USAGE ALLOWED ON PERMIT #2014-02338 298'/1045' 28.5%

\* PROPOSED ADDED SPACE REQUESTED 44'39' 298'+44' = 342'/1045' 30.5%

Bob TERENZONI  
16 TATE ST.  
PORTLAND, ME.  
(781) 844-6367