

A. Shower Stalls

B. Sinks

Change A3 Built

RECEIVED

MAY 11 2012

Dept. of Building Inspections
City of Portland Maine

* Bathroom Layout - Add Showers & note
Kitchenette Sinks.


Revision - 5-11-12

Dept. of Building Inspections
City of Portland Maine

RECEIVED
MAY 11 2012

BRACKETT STREET

SIDEWALK

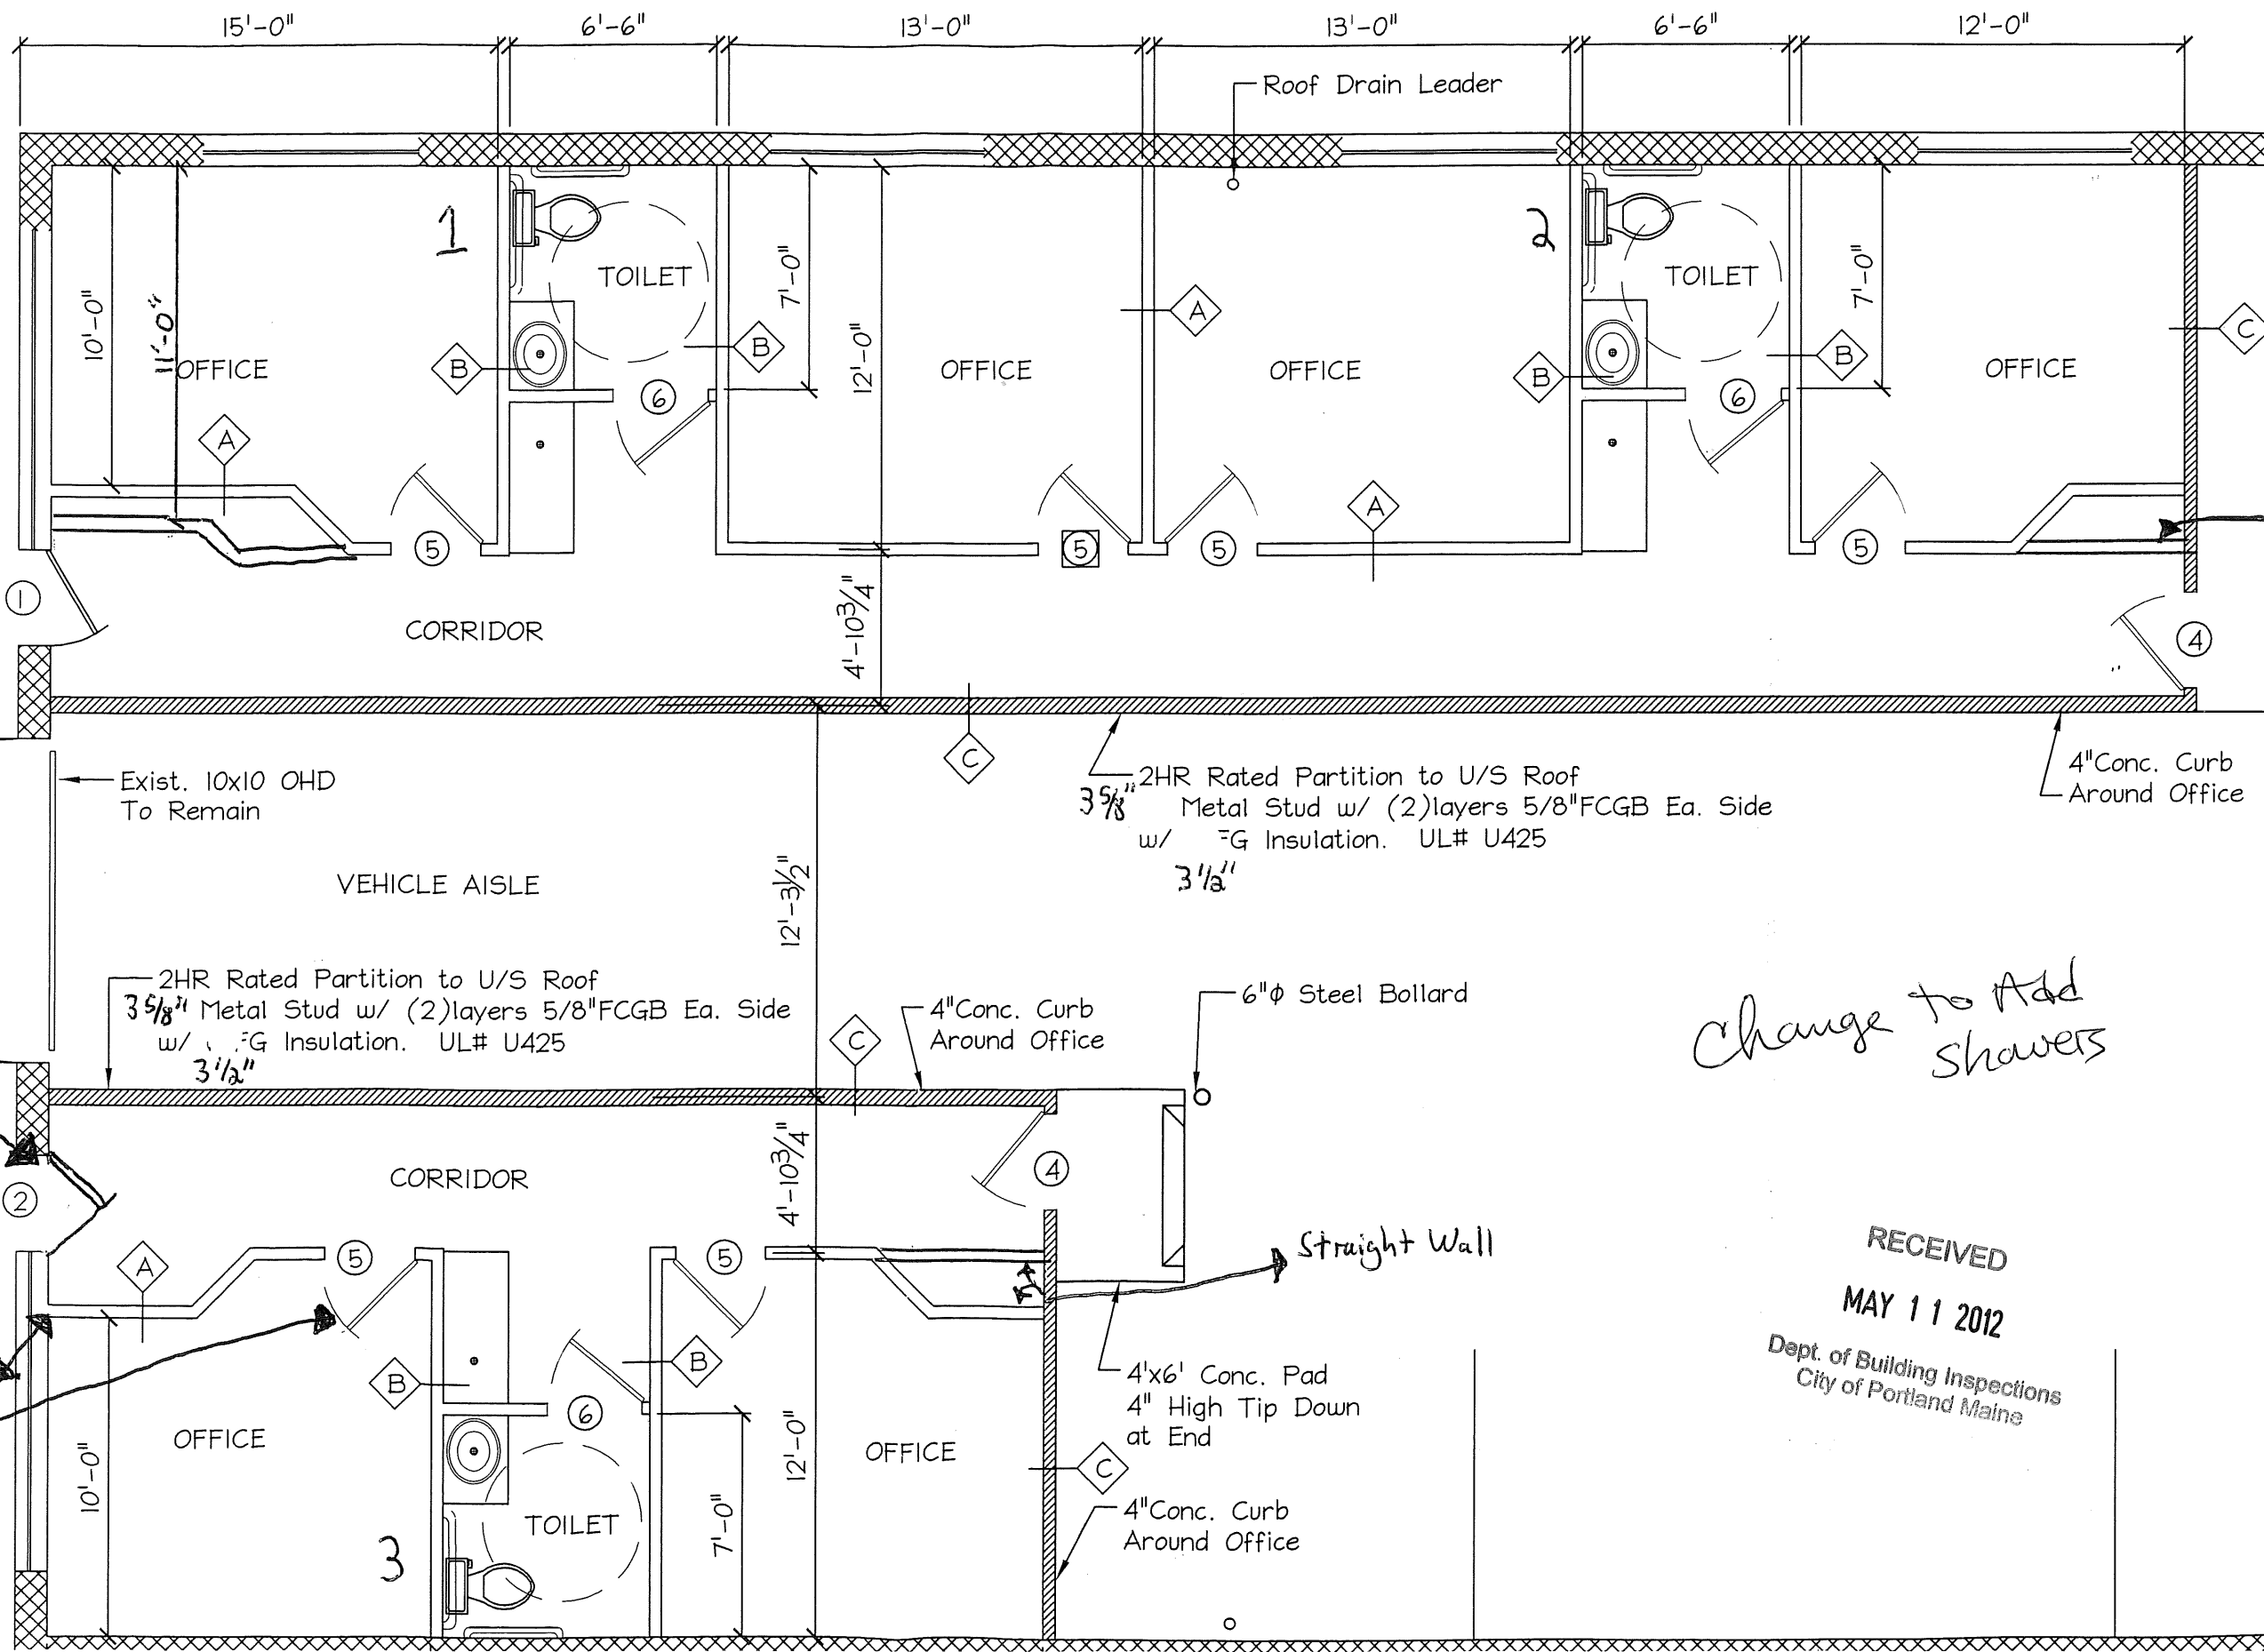

Exist. 10x10 OHD
To Remain

2HR Rated Partition to U/S Roof
3 5/8" Metal Stud w/ (2) layers 5/8" FCGB Ea. Side
w/ FG Insulation. UL# U425
3 1/2"

2HR Rated Partition to U/S Roof
3 5/8" Metal Stud w/ (2) layers 5/8" FCGB Ea. Side
w/ FG Insulation. UL# U425
3 1/2"

4" Conc. Curb
Around Office

Left swing door

New Exterior Door
To Match Exist.

Eliminate Wall
& door

Straight Wall

4'x6' Conc. Pad
4" High Tip Down
at End

4" Conc. Curb
Around Office

Change to Add
Showers

RECEIVED
MAY 11 2012

Dept. of Building Inspections
City of Portland Maine