



architects, llc

724 Rockland Street (Office)  
P.O. Box 189 (Mailing)  
Rockport, Maine 04856

Tel: 207.236.6545  
Web: www.2Arch.com  
© Copyright 2010. 2A architects llc

Registration: ■

Project: ■

769 Congress Street  
Portland, Maine

Client ■ Community ■ Environment

Consultant: ■

AS-BUILT FOR  
DESIGN PLANNING  
ONLY

Sheet Issue Date:  
As-Built Plan Issue 09.10.14

Project Start Date:  
August 2014

Project Number: ■

14-119



Sheet Title: ■

AS-BUILT  
THIRD & FOURTH  
FLOOR PLANS

Sheet Plot Date:  
09/10/2014 AB3.2B\_769Congress\_SecondFlr.dwg

Sheet Number: ■

AB3.1

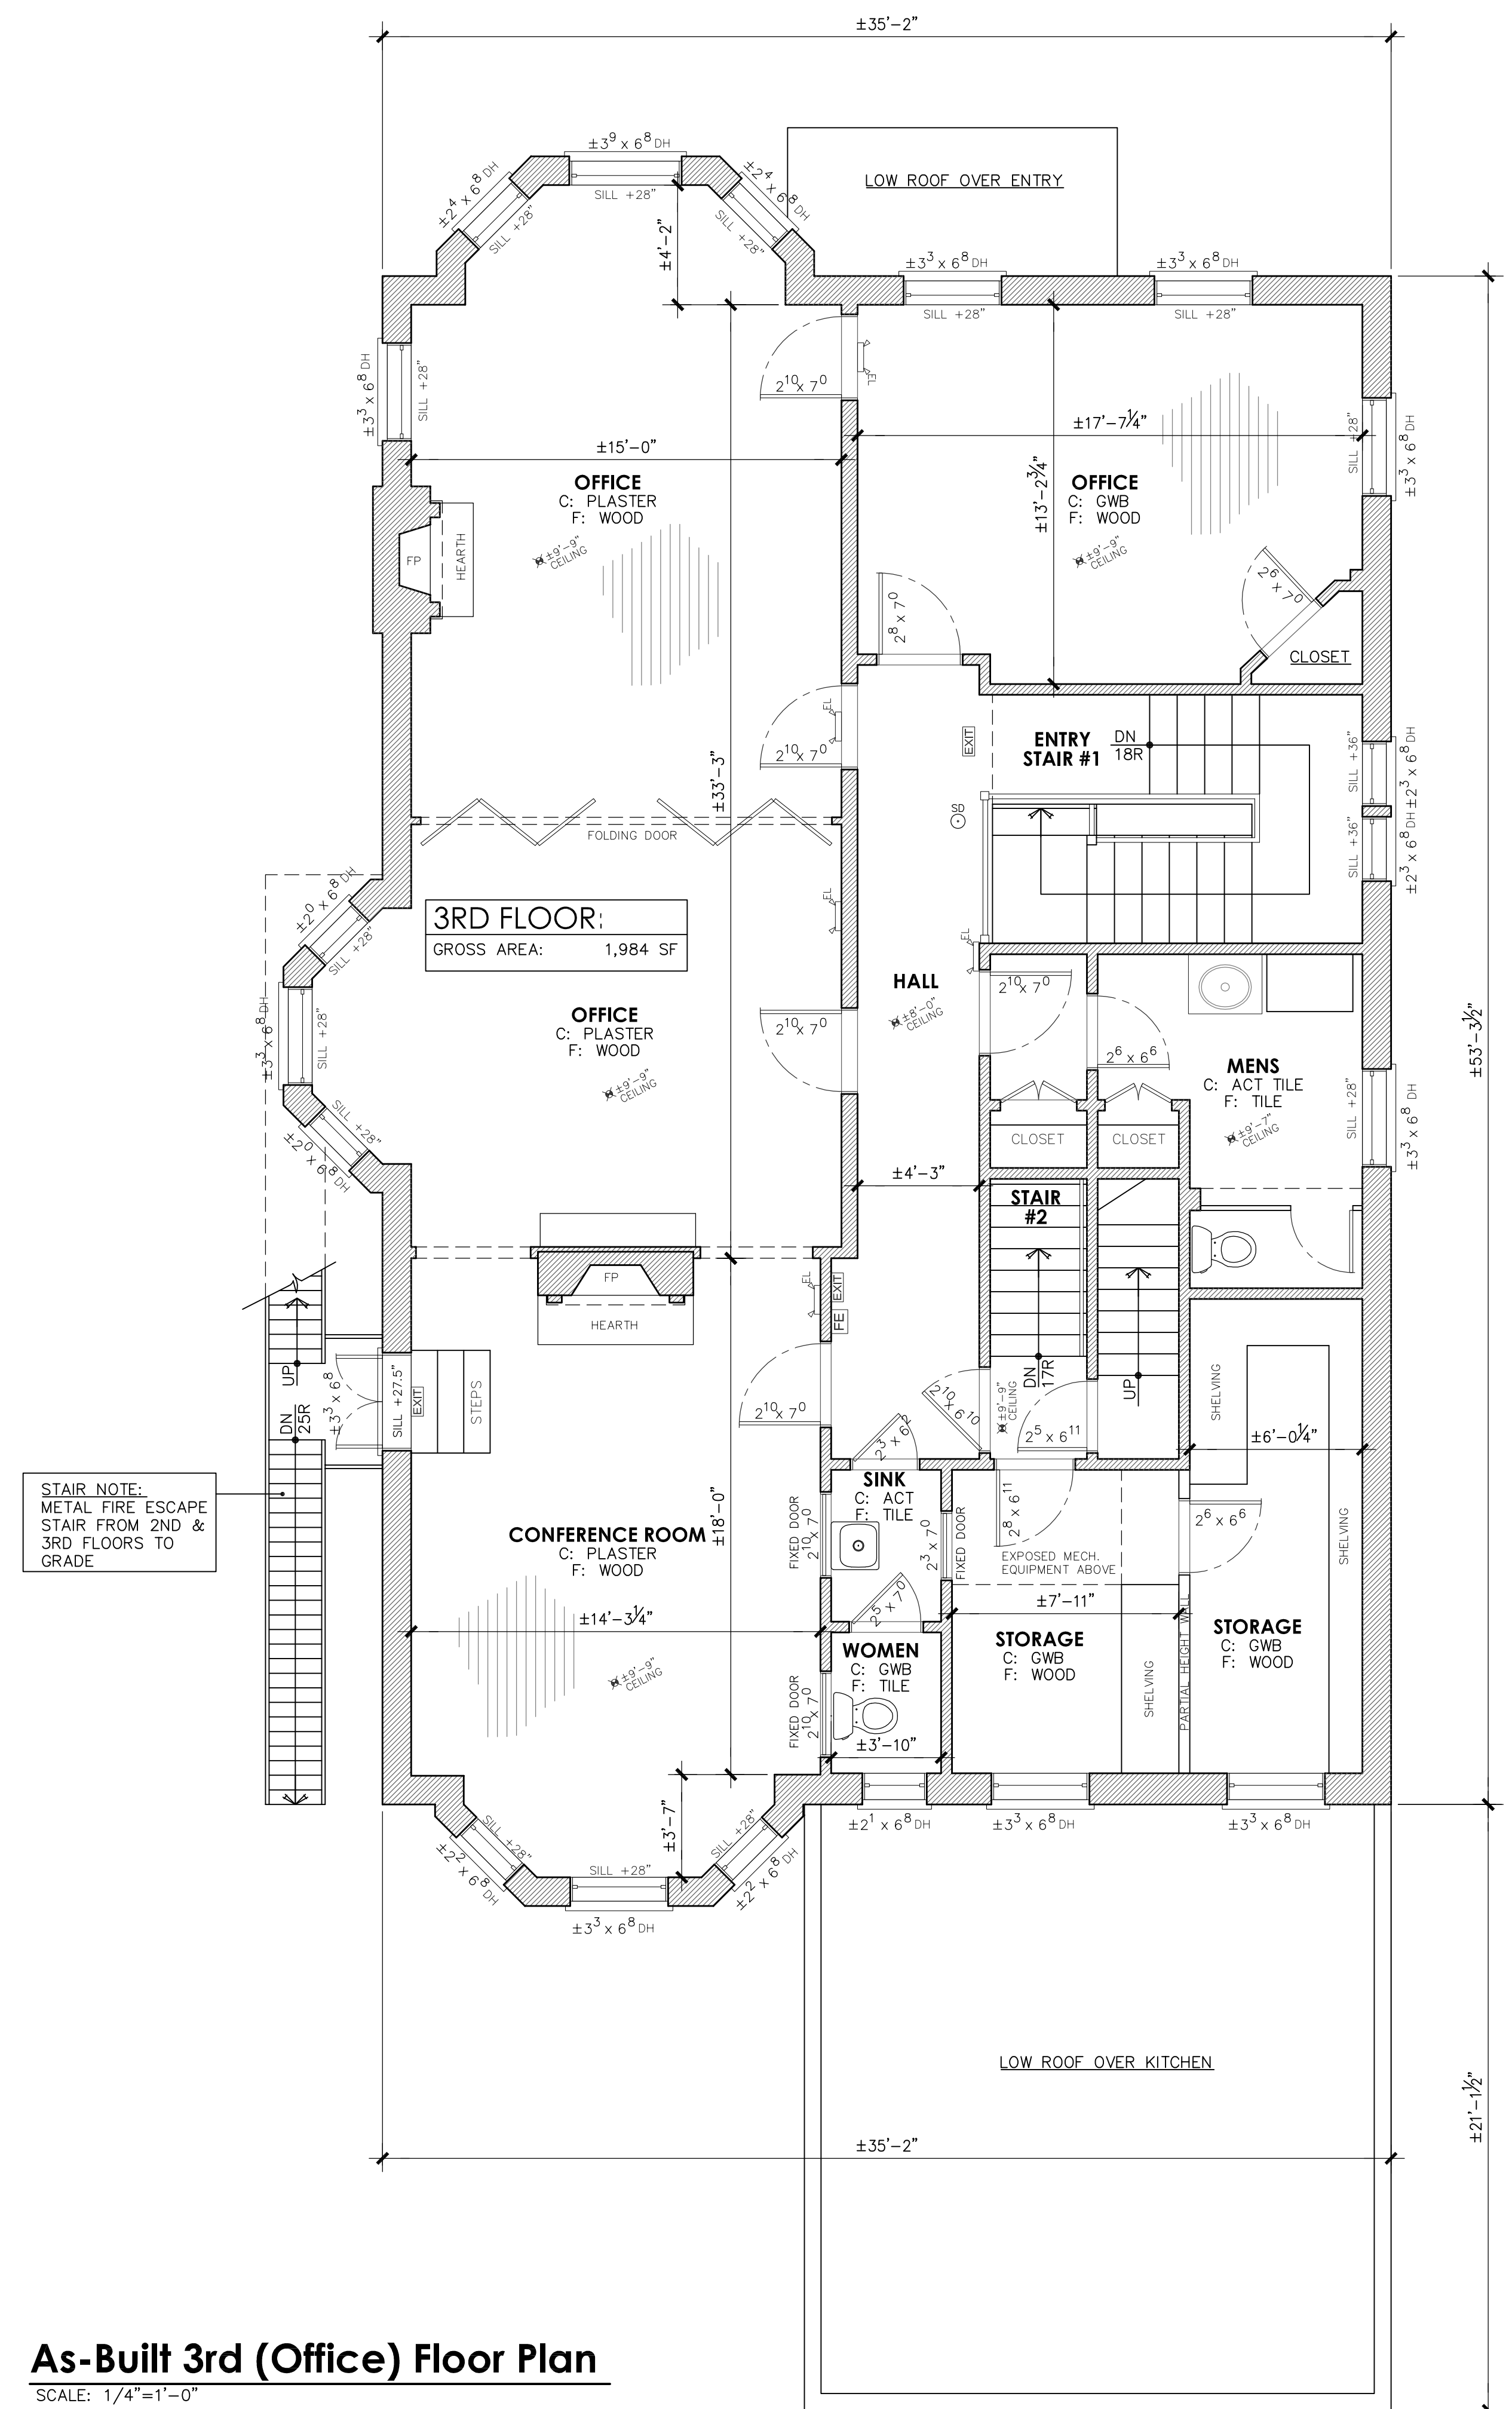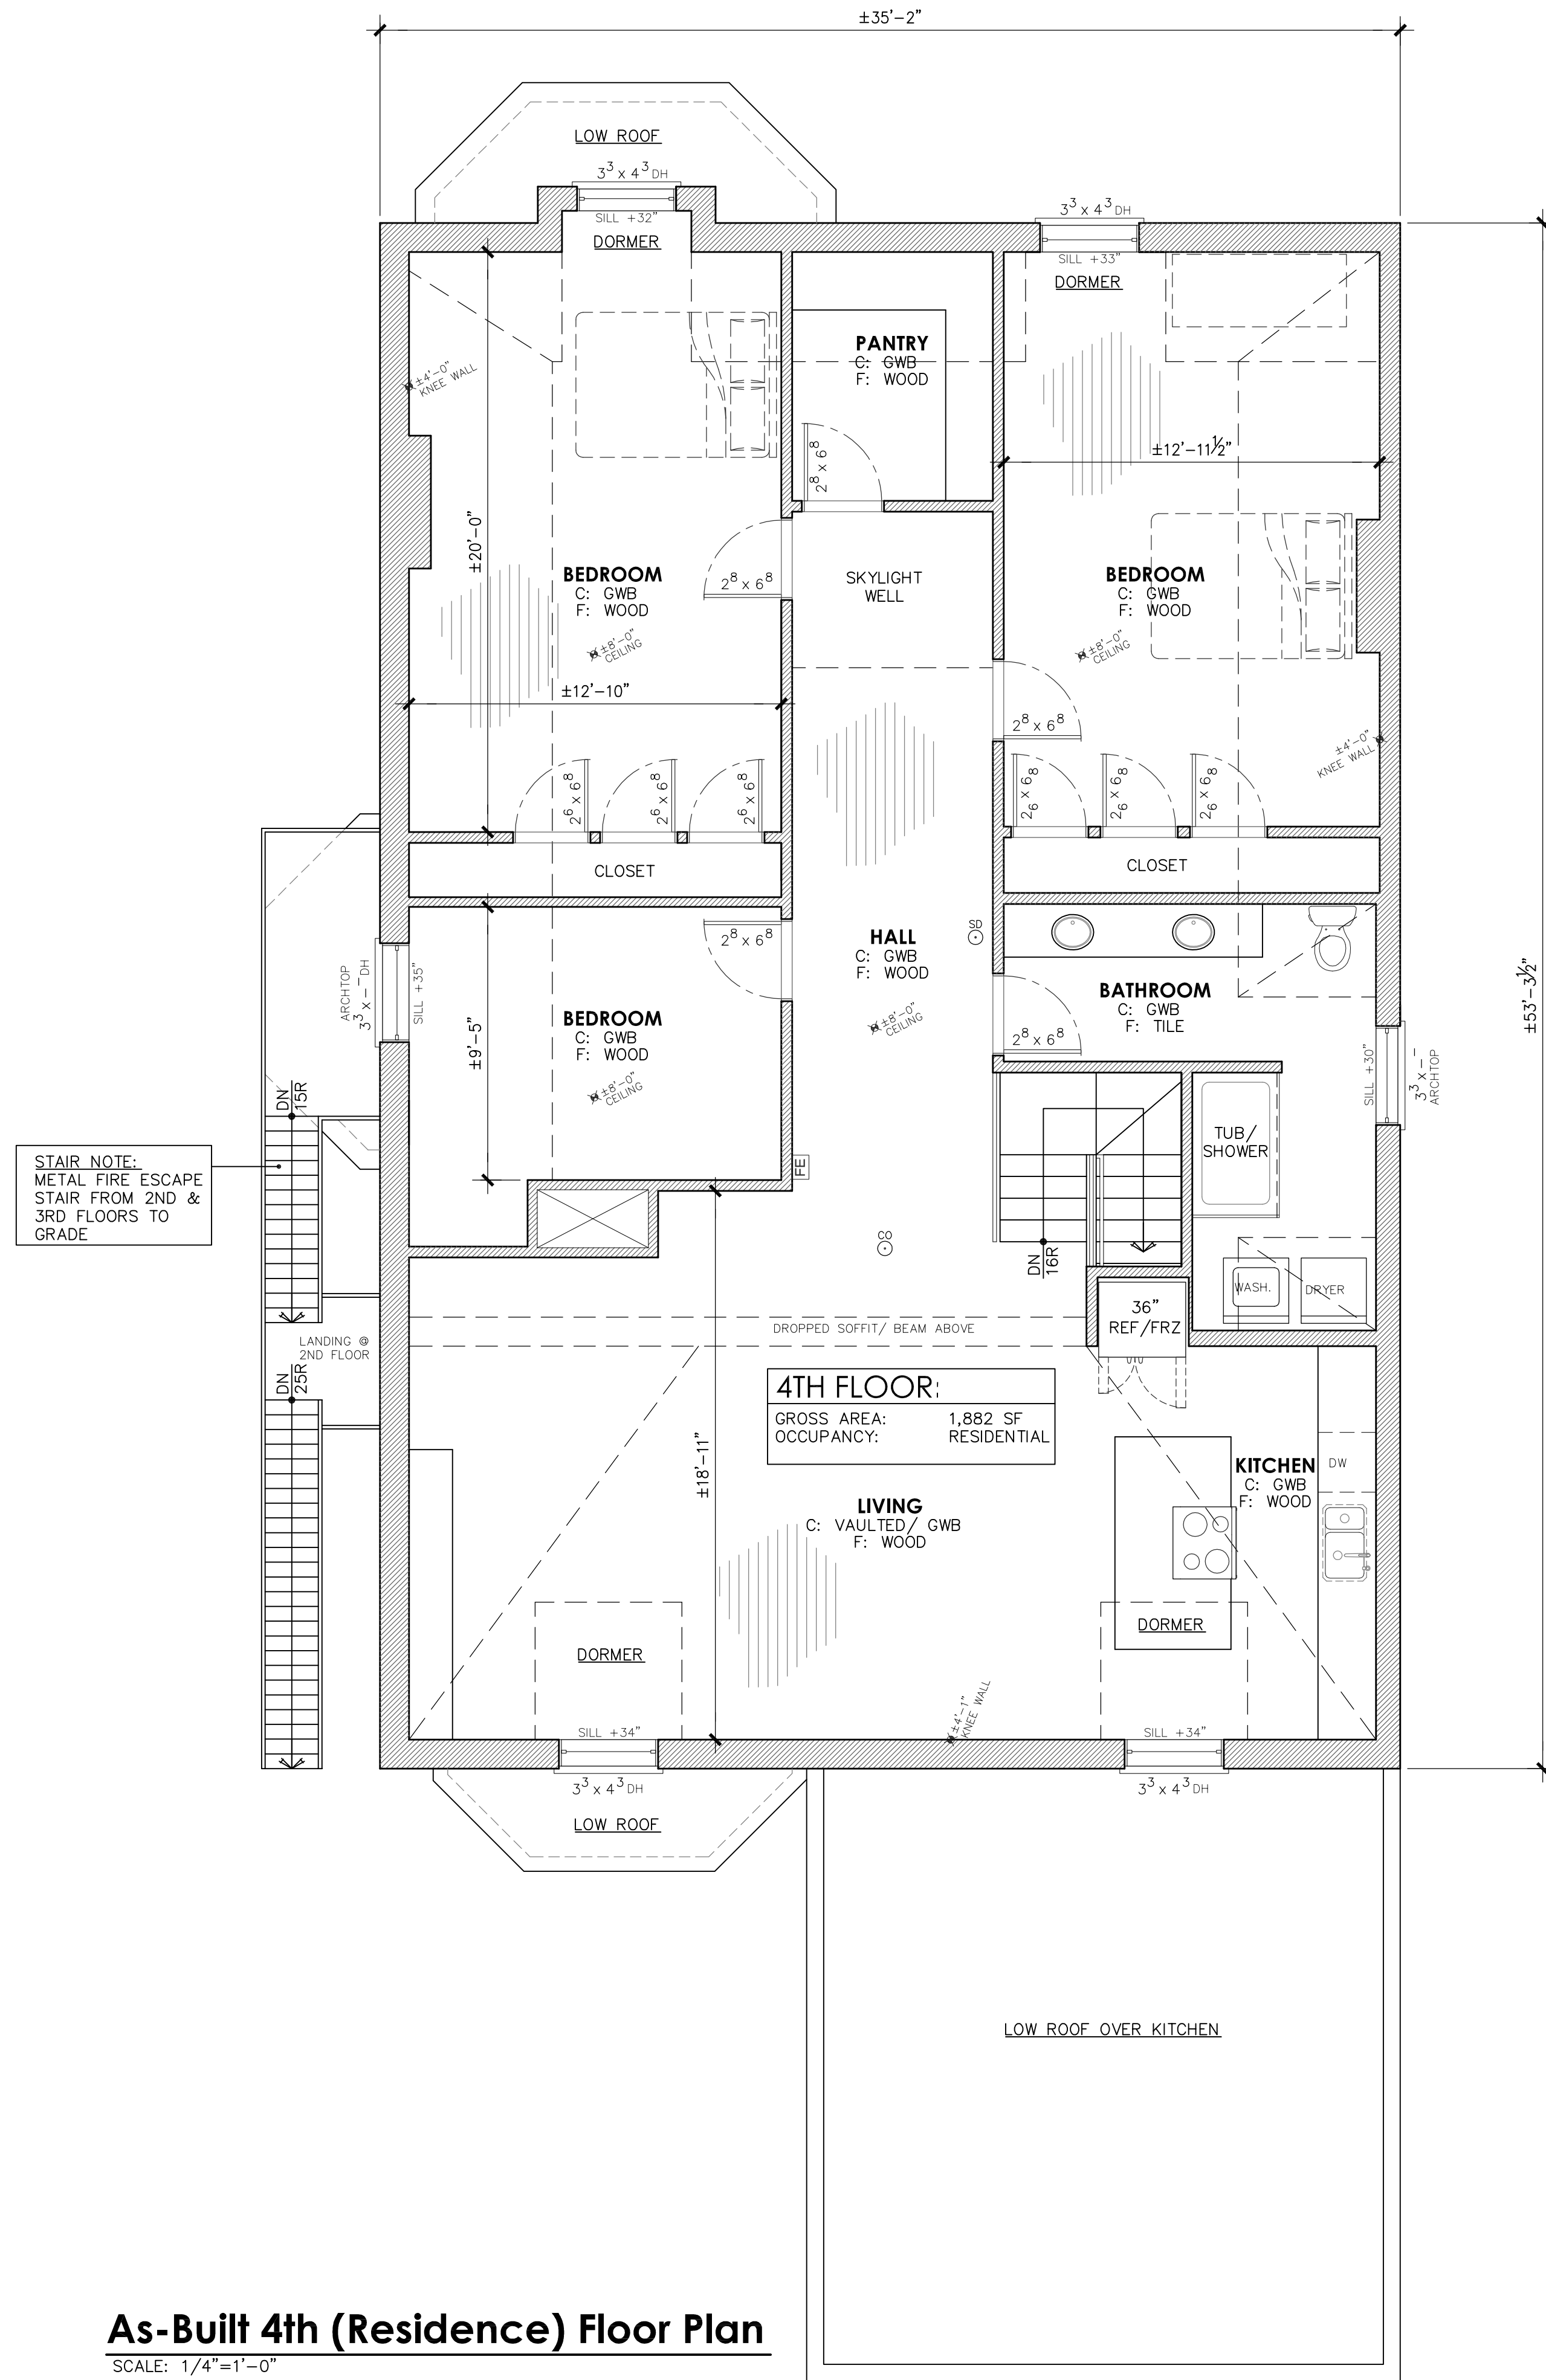

As-Built 4th (Residence) Floor Plan

SCALE: 1/4"=1'-0"  
0 2 4 8FT.

As-Built 3rd (Office) Floor Plan

SCALE: 1/4"=1'-0"  
0 2 4 8FT.