



REPLACE BOTH EAVE TRIM AND ROOF TO MATCH EXISTING ADJACENT BAY

REPAIR AND RE-ROOF BAY WINDOW SKIRT TRIM

RETAIN AND REPAIR EXISTING FIRE ESCAPES

RETAIN AND REPAIR EXISTING FIRE ESCAPES

NEW EXTERIOR PAINT TREATMENT

EXISTING METER LOCATION TO REMAIN




EXISTING SLATE ROOF TO REMAIN

REPAIR AND RE-ROOF BAY WINDOW SKIRT TRIM


NEW CONSTR. @ FRONT ENTRY STEPS & PORCH- EXISTING FLOOR DECK TO REMAIN, REPLACE RAILING AS REQUIRED

1
A2.5 EXTERIOR ELEVATIONS
SCALE: 1/2" = 1'-0"

10 MELLETT ST.
PORTLAND
MAINE 04103

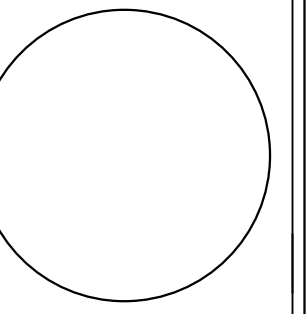

WHIPPLE
CALLENDER
ARCHITECTS

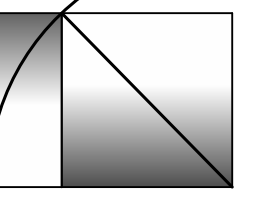

136 PLEASANT AVE.
PORTLAND, ME 04103
P 207.775.2696
F 207.775.3631
www.whipplecallender.com

DESCRIPTION

DATE

MARK

DATE:

<DATE OF ISSUE>

CHECKED BY:

#Contact Full Name

DRAWN BY:

JAD

JOB:

#Pin

SHEET TITLE:

A2.5