



HATTERAS ASPHALT SHINGLES AT BARE AREAS.

REPAIR EXISTING EAVES TO MATCH EXISTING

RETAIN AND REPAIR EXISTING FIRE ESCAPES

INSPECT INSTALLATION AND FINISH WINDOW TRIM TO MATCH EXISTING SIMPLE CASSE OPENING

REPAIR AND RE-ROOF BAY WINDOW SKIRT TRIM



NEW EPDM ROOFING WITH SOLID BLOCKING AT FUTURE DECK POST LOCATIONS


NEW EAVE TRIM TO MATCH EXISTING

NEW DOOR AT EXISTING LOCATION TO REMAIN


REBUILD EAVE, INCORPORATE EXISTING REMAINING DETAIL

NEW EXT. ELEVATION TO MATCH EXISTING

INFILTRATION FEATURE/ WALKWAY

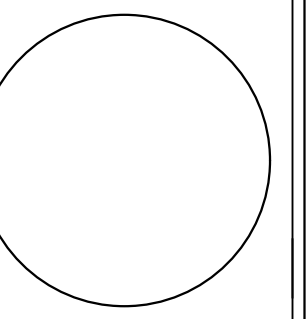

WHIPPLE
CALLENDER
ARCHITECTS

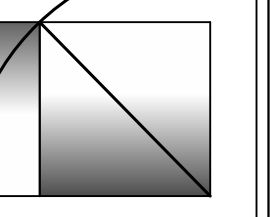

136 PLEASANT AVE.
PORTLAND, ME 04103
P 207.775.2696
F 207.775.3631
www.whipplecallender.com

DESCRIPTION

DATE

MARK

DATE:

<DATEOFISSUE>

CHECKED BY:

#Contact Full Name

DRAWN BY:

JAD

JOB:

#Pin

SHEET TITLE:

1 EXT. ELEVATIONS
A2.6 SCALE: 1/2" = 1'-0"

THIS DRAWING IS AN INSTRUMENT OF SERVICE AND SHALL REMAIN THE PROPERTY OF WHIPPLE CALLENDER ARCHITECTS. IT SHALL NOT BE USED FOR ANY OTHER PURPOSE THAT FOR WHICH IT IS SPECIFICALLY FURNISHED