



2
A3.2
SCALE: 1 1/2" = 1'-0"

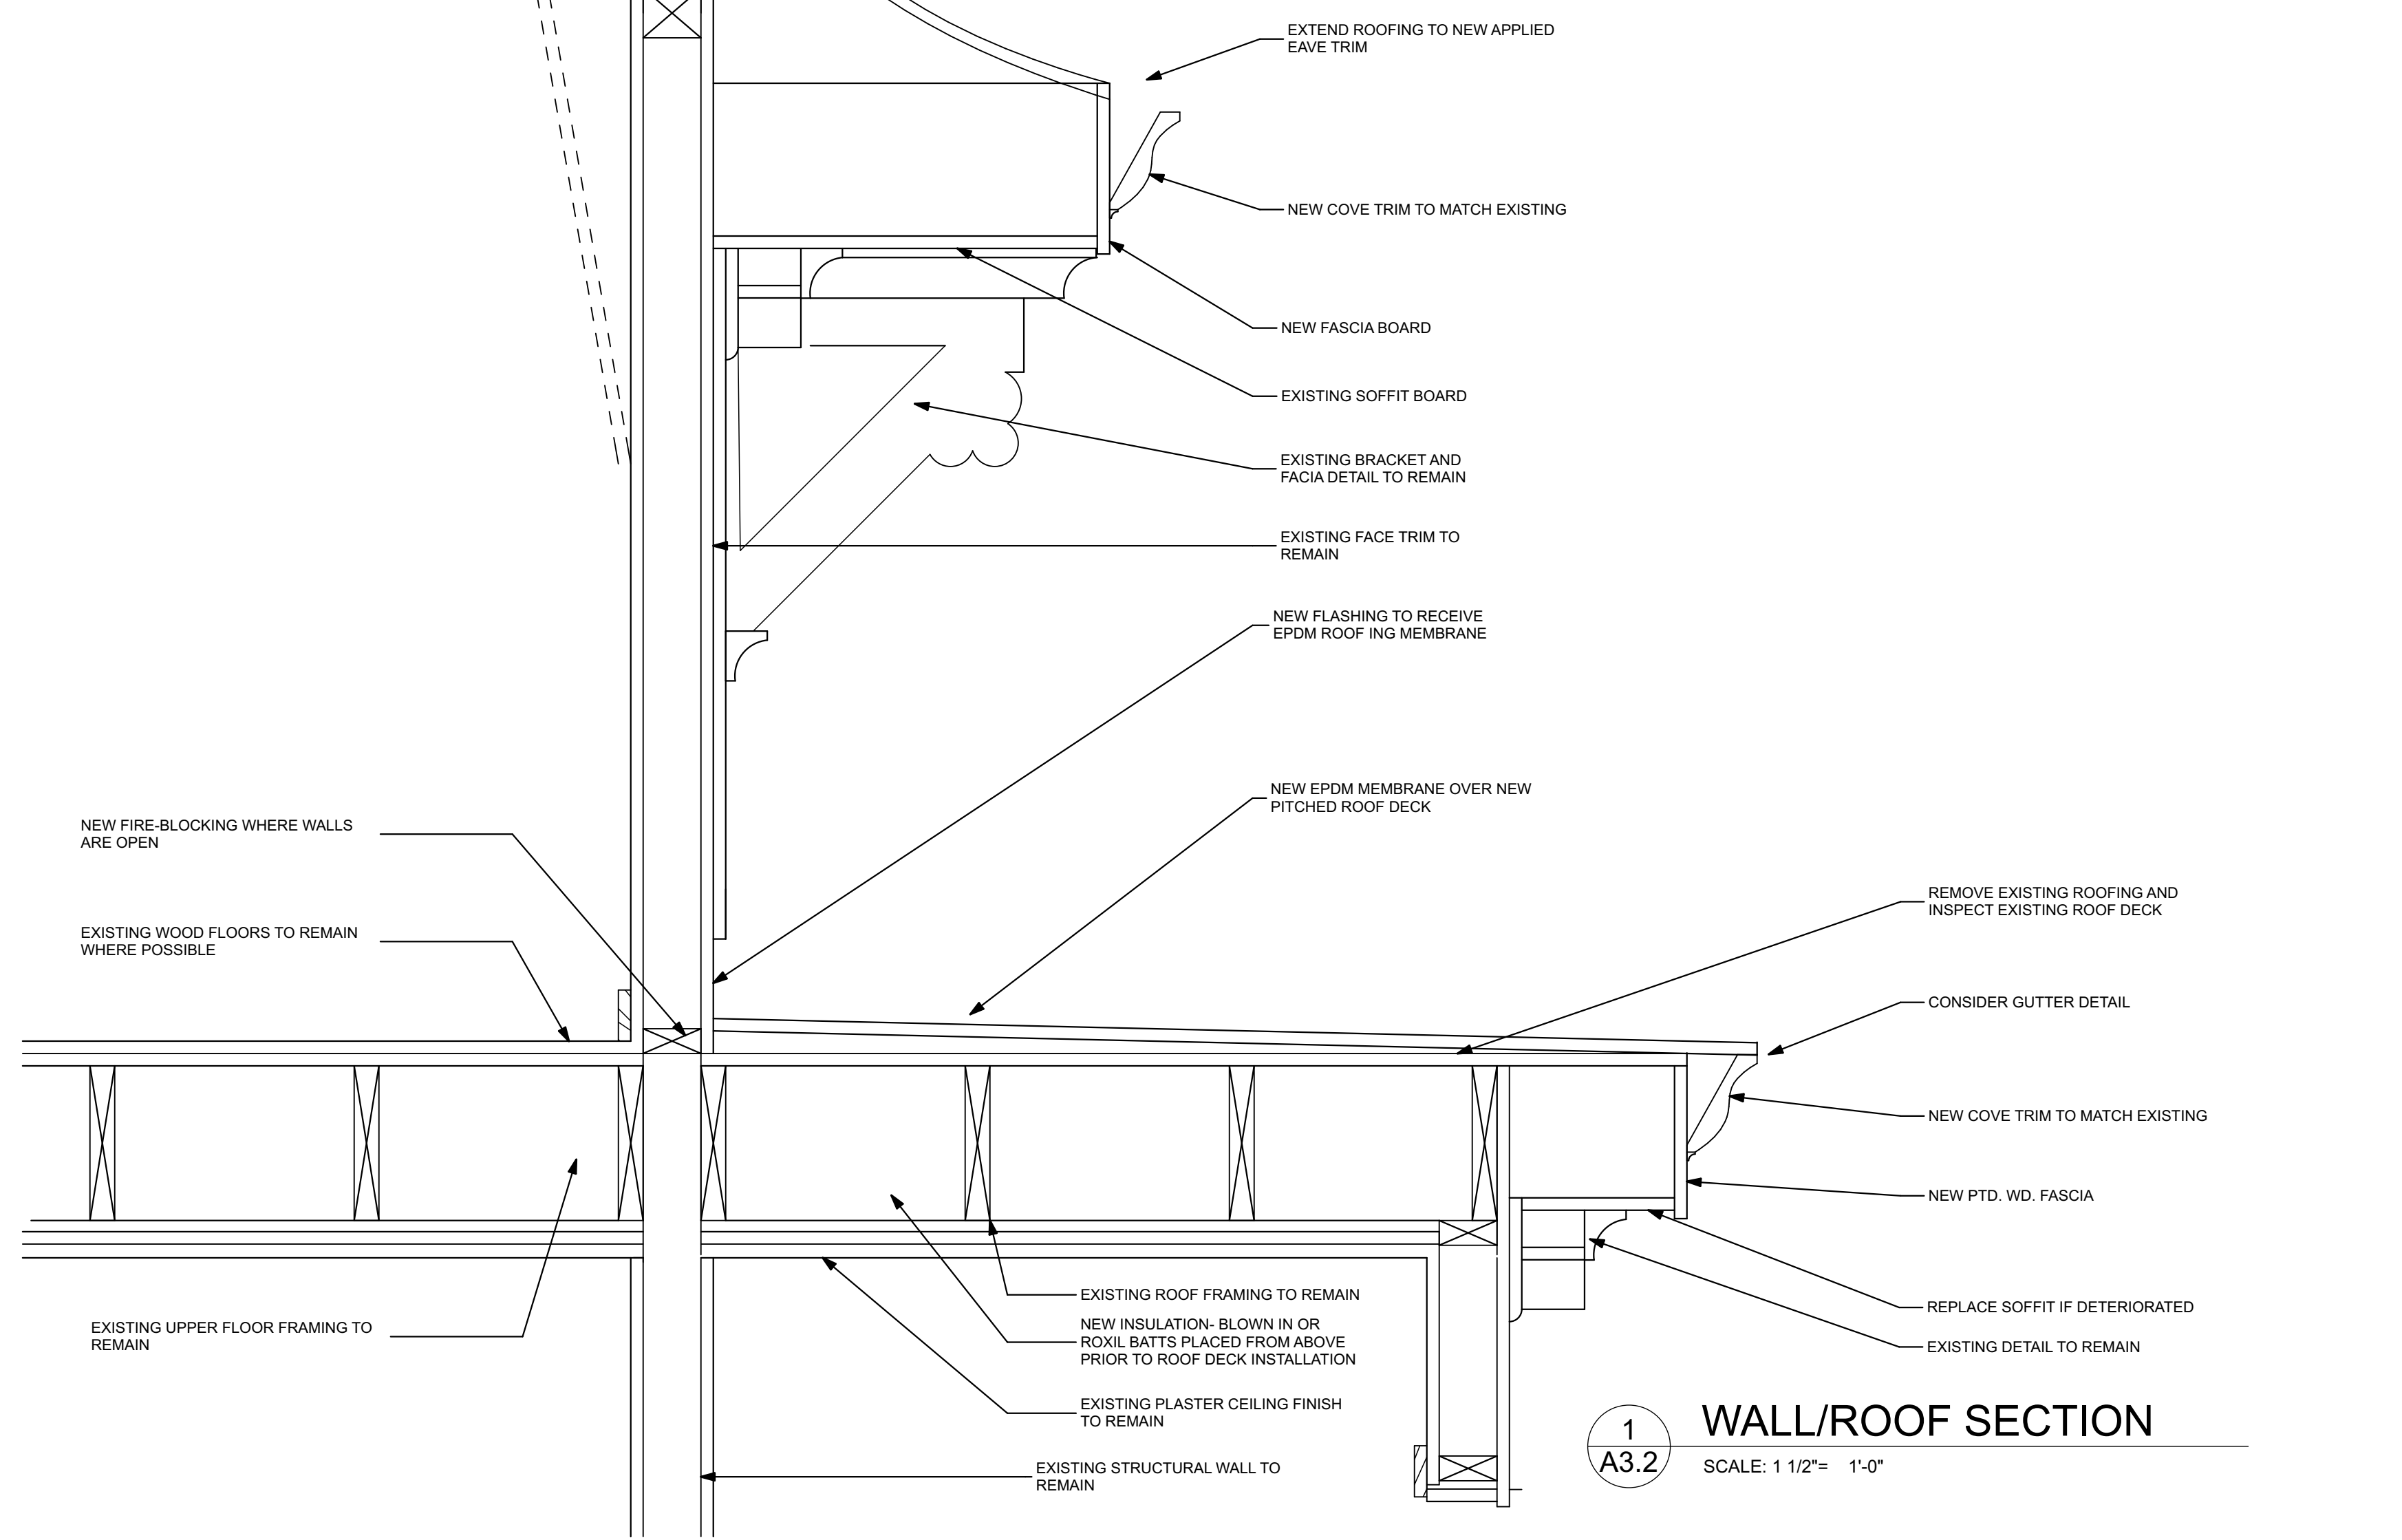


1
A3.2
SCALE: 1 1/2" = 1'-0"

THIS DRAWING IS AN INSTRUMENT OF SERVICE AND SHALL REMAIN THE PROPERTY OF WHIPPLE CALLENDER ARCHITECTS. IT SHALL NOT BE USED FOR ANY OTHER PURPOSE THAT FOR WHICH IT IS SPECIFICALLY FURNISHED.

10 MELLETT ST.
PORTLAND
MAINE 04103

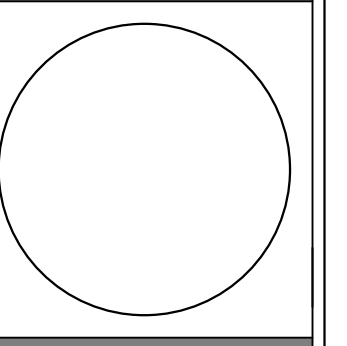

WHIPPLE
CALLENDER
ARCHITECTS

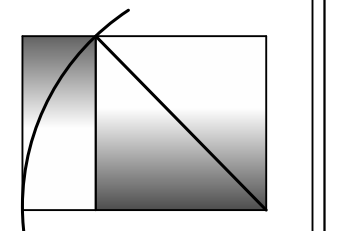

136 PLEASANT AVE.
PORTLAND, ME 04103
P 207.775.2696
F 207.775.3631
www.whipplecallender.com

DATE	DESCRIPTION

DATE: <DATEOFISSUE>
CHECKED BY: #Contact Full Name
DRAWN BY: JAD
JOB: #Pin
SHEET TITLE:

A3.2