


WHIPPLE  
 CALLENDER  
 ARCHITECTS

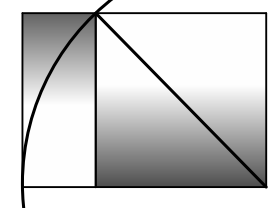

136 PLEASANT AVE.  
 PORTLAND, ME 04103  
 P 207.775.2696  
 F 207.775.3631  
 www.whipplecallender.com

NOTE- ALL EXISTING WHITE TRIM AT FLOORS ONE AND TWO TO BE PAINTED HIGH GLOSS WHITE

DOOR SCHEDULE-ALL DOORS WOOD UNLESS NOTED OTHERWISE			ALL NEW & EGRESS DOORS LEVER HANDLED TYPICAL			
MARK	TYPE	LOCATION	MAKE/ MODEL	UNIT SIZE	STYLE	REMARKS
B01	REPURPOSE EXISTING	APARTMENT TO LAUNDRY		3'-0" x 6'-8"	HINGED	
B02	NOT USED					
B03	REPURPOSE EXISTING	SITTING AREA TO BATH		3'-0" x 6'-8"	HINGED	
B04	REPURPOSE EXISTING	KITCHEN TO BEDROOM		3'-0" x 6'-8"	HINGED	
B05	REPURPOSE EXISTING	BEDROOM TO CLOSET		3'-0" x 6'-8"	HINGED	
B06						
B07						
B08						
B09						
B10						
101	EXISTING TO REMAIN	PORCH TO ENTRY VESTIBULE	REFINISH DOORS	EXISTING	HINGED PAIR	REPAIR/ REPLACE EXISTING GLASS
102	EXISTING TO REMAIN	ENT. VEST. TO STAIR HALL	REFINISH DOORS	EXISTING	HINGED PAIR	
103	EXISTING TO REMAIN	STAIR HALL TO LIBRARY		EXISTING	HINGED PAIR	
104	EXISTING TO REMAIN	PARLOR TO LIBRARY		EXISTING	HINGED PAIR	
105	EXISTING TO REMAIN	STAIRHALL TO BASEMENT HALL		EXISTING	FOUR PANEL PTD.	
106	NOT USED					
107	EXISTING TO REMAIN	KITCHEN TO BASEMENT HALL		EXISTING	FOUR PANEL PTD.	
108	EXISTING TO REMAIN	LIBRARY TO DINING		EXISTING	HINGED FOLDING DOOR	PHYSICALLY PROTECT EXISTING TRIM DURING ENTIRE CONSTRUCTION PRIOD
109	EXISTING TO REMAIN	MUDROOM TO LAUNDRY		EXISTING	FOUR PANEL PTD.	
110	NEW EXTERIOR DOOR	EXT. TO MUDROOM	VERIFY EXISTING			DOOR STYLE TBD
111	RE-USE EXISTING	MUDROOM TO 1/2 BATH	VERIFY EXISTING		FOUR PANEL PTD.	INSTALL RE-PURPOSED DOOR SELECTED BY OWNER EXISTING METAL DOOR TO REMAIN
112	EXISTING TO REMAIN	BULKHEAD DOOR- EXT. APT. ENTRY AT GRADE		EXISTING		
113	SALV. COPPER DOOR	MUDROOM TO KITCHEN			PORTHOLE WINDOW	
201	CLEAR OPENING	STAIRHALL TO SUNROOM		EXISTING TO REMAIN	MOORISH TRIM	PHYSICALLY PROTECT EXISTING TRIM DURING ENTIRE CONSTRUCTION PRIOD
202	EXISTING	STAIRHALL TO TV ROOM- WETBAR		EXISTING TO REMAIN	MOORISH TRIM	
203	EXISTING	STUDIO TO CLOSET				
204	EXISTING TO REMAIN	STAIRHALL TO RED ROOM		2'-8" x 6'-8"	FOUR PANEL PTD.	
205	EXISTING TO REMAIN	REDROOM TO CLOSET		2'-8" x 6'-8"	FOUR PANEL PTD.	DOORS 205 & 206 TO MATCH
206	RE-USE EXISTING	REDROOM TO CLOSET		2'-8" x 6'-8"	FOUR PANEL PTD.	DOORS 205 & 206 TO MATCH
207	EXISTING TO REMAIN	STAIR HALL TO WHITE ROOM		2'-8" x 6'-8"	FOUR PANEL PTD.	
208	EXISTING TO REMAIN	STAIRHALL TO BATHROOM		2'-8" x 6'-8"	FOUR PANEL PTD.	
209	EXISTING TO REMAIN	WHITE ROOM TO CLOSET		2'-8" x 6'-8"	FOUR PANEL PTD.	
210	EXISTING TO REMAIN	MAIN STAIR HALL TO BEDROOM		2'-8" x 6'-8"	FOUR PANEL PTD.	
211	RE-USE EXISTING	GREEN ROOM TO BATHROOM		2'-6" x 6'-8"	FOUR PANEL PTD.	
212	EXISTING TO REMAIN	GREEN ROOM TO CLOSET		3' x 6'-10"	FOUR PANEL PTD.	
213						
214						
301	EXISTING TO REMAIN	STAIR HALL TO ATTIC		EXISTING	FOUR PANEL PTD.	
302	NEW/ SALVAGED	STAIRHALL TO POWDER ROOM		2'-6" x 6'-8"		
303	NEW	DRESSING ROOM TO DECK		3'-0" x 6'-8"	SINGLE PANEL	FULL GLASS DOOR WITH TRANSOM
304	SAUNA DOOR	BATHROOM TO SAUNA		3'-0" x 6'-8"	SAUNA DOOR	PROVIDE/ INSTALL GUARD AS NOTED
305		BEDROOM TO BATHROOM				CUSTOM SLIDING DOOR
306	USE NEW DOOR PROVIDED BY OWNER	BATHROOM TO EXT.		3'-0" x 6'-8"	SINGLE PANEL	FULL GLASS DOOR- ON SITE AND NEW
307	RE-USE EXISTING	STAIRHALL TO BEDROOM				

1 DOOR SCHEDULE  
 A6.1 SCALE: 1/4" = 1'-0"

FINISH SCHEDULE					
ROOM NO./ NAME	FLOOR	WALLS	BASE	CEILING	NOTES/REMARKS
B01 LAUNDRY	USE EXISTING FLOORING PROVIDED ON SITE	NEW PAINTED GWB- SW 7000 WHITE EGGSHELL	PTD. WOOD BASE	NEW PAINTED GWB	NEW SEALED CONC. SLAB
B02-SITTING AREA	USE EXISTING FLOORING PROVIDED ON SITE	NEW PAINTED GWB- SW 7000 WHITE EGGSHELL	PTD. WOOD BASE	NEW PAINTED GWB	NEW SEALED CONC. SLAB
B03-KITCHEN	USE EXISTING FLOORING PROVIDED ON SITE	NEW PAINTED GWB- SW 7000 WHITE EGGSHELL	PTD. WOOD BASE	NEW PAINTED GWB	NEW SEALED CONC. SLAB
B04- BEDROOM	USE EXISTING FLOORING PROVIDED ON SITE	NEW PAINTED GWB- SW 7000 WHITE EGGSHELL	PTD. WOOD BASE	NEW PAINTED GWB- MR	NEW SEALED CONC. SLAB
B05- BATHRM.	USE EXISTING FLOORING PROVIDED ON SITE	NEW PAINTED GWB-MR SEMI GLOSS	AZEK BASE	NEW PAINTED GWB-MR	NEW SEALED CONC. SLAB
101- STAIR HALL/ ENTRY	EXISTING WOOD TO REMAIN AS MUCH AS POSSIBLE	PROTECT EXIST. WALL COVERINGS AS MUCH AS POSSIBLE	EXIST. WOOD BASE REPAIRED/ REFINISHED	NEW PAINTED GWB	SW 7000 IBIS WHITE EGGSHELL- PROTECT EXISTING WALL COVERINGS
102- PARLOR	EXISTING WOOD TO REMAIN AS MUCH AS POSSIBLE	PROTECT EXIST. WALL COVERINGS AS MUCH AS POSSIBLE	EXIST. WOOD BASE REPAIRED/ REFINISHED	NEW PAINTED GWB	PAINT COLOR TBD
103-LIBRARY	EXISTING WOOD TO REMAIN	EXIST. REPAIRED/ PAINTED	EXIST. WOOD BASE REPAIRED/ REFINISHED	EXISTING PLASTER REPAIRED & PAINTED	SW 7000 IBIS WHITE EGGSHELL- PROTECT EXISTING WALL COVERINGS
104- DINING	CERAMIC TILE	NEW PAINTED GWB-BM 179 EGGSHELL	NEW WOOD BASE	NEW PAINTED GWB- SW 7000 IBIS WHITE EGGSHELL	WALL PAINT BM 179 EGGSHELL- CEILING PAINT SW IBIS WHITE SEMIGLOSS
105- KITCHEN	CERAMIC TILE	NEW PAINTED GWB-BM 170 EGGSHELL	NEW WOOD BASE	NEW PAINTED GWB- SW 7000 IBIS WHITE EGGSHELL	
106- MUDROOM	CERAMIC TILE	NEW PAINTED GWB- BM #179	NEW WOOD BASE	NEW PAINTED GWB- SW 7000 IBIS WHITE SEMIGLOSS	ALL SURFACES BM 179 SEMIGLOSS
107- LAUNDRY	CERAMIC TILE	NEW PAINTED GWB-MR BM #179	NEW WOOD BASE	NEW PAINTED GWB- SW 7000 IBIS WHITE SEMIGLOSS	ALL SURFACES BM 179 SEMIGLOSS
108-1/2 BATH	CERAMIC TILE	NEW PAINTED GWB-MR BM #179	NEW WOOD BASE	NEW PAINTED GWB- SW 7000 IBIS WHITE SEMIGLOSS	ALL SURFACES BM 179 SEMIGLOSS
201-SUNROOM	OWNER SUPPLIED CERAMIC TILE	NEW PAINTED GWB-MR	NEW WOOD BASE	NEW GWB	EXPOSED UPPER WALL FRAMING TYP. AT NORTH WALL ONLY
202-STAIRHALL	EXISTING WD. TO REMAIN	PROTECT EXIST. WALL COVERINGS AS MUCH AS POSSIBLE	EXIST. WOOD BASE REPAIRED/ REFINISHED	EXISTING PLASTER REPAIRED & PAINTED	PAINT CEILING IBIS WHITE AND CLEAN SURFACES
203-REDROOM	EXISTING WD.	PROTECT EXIST. WALL COVERINGS AS MUCH AS POSSIBLE	EXIST. WOOD BASE REPAIRED/ REFINISHED	EXISTING PLASTER REPAIRED & PAINTED	PAINT CEILING IBIS WHITE AND PT. LOWER HALF OF WALLS HIGH GLOSS WHITE
204-WHITE ROOM	EXISTING WD.	EXIST. PLASTER PAINTED	EXIST. WOOD BASE REPAIRED/ REFINISHED	EXISTING PLASTER REPAIRED & PAINTED	PAINT CEILING IBIS WHITE AND CLEAN SURFACES
205-EXISTING BATH	WHITE CERAMIC HEX TILE	EXIST. PLASTER PAINTED	EXIST. WOOD BASE REPAIRED/ REFINISHED	PTD. SW 7000 IBIS WHITE SEMIGLOSS	FINISH TILE/ PAINT WORK
206-NEW BATH	WHITE CERAMIC HEX TILE	NEW PAINTED GWB-MR	TILE BASE	NEW PAINTED GWB- MR	BEADBOARD WALL FINISH DETAIL- PAINT UPPER WALLS & CEILING SW IBIS WHITE SEMIGLOSS
207-GREEN ROOM	PAINTED FLOOR	EXIST. PLASTER PAINTED	EXIST. WOOD BASE REPAIRED/ REFINISHED	EXISTING PLASTER REPAIRED- PTD. SW 7000 IBIS WHITE EGGSHELL	COLORS TO BE DETERMINED- CEILING SW 7000 IBIS WHITE EGGSHELL- NOTE NEW FINISHES AT SHARED WALL
208-TV ROOM/ WET BAR	EXISTING WD. FLOOR	EXIST. PLASTER PAINTED	EXIST. WOOD BASE REPAIRED/ REFINISHED		PAINT CEILING SW 7000 IBIS WHITE EGGSHELL- WALL PAINT TBD
301-STAIRHALL	EXIST SALV. FLOORING / DIAGONAL	PROTECT EXISTING WALL COVERINGS	NEW WOOD BASE	EXIST. PLASTER PAINTED	
302- DRESSING/ STUDY	SAND/ REFIN. WOOD FLOOR	NEW PAINTED GWB	NEW PTD. WD. BASE	NEW PAINTED GWB	STAIN COLOR TBD
303-MASTER BEDROOM	SAND/ REFIN. WOOD FLOOR	NEW PAINTED GWB	NEW PTD. WD. BASE	NEW PAINTED GWB	STAIN COLOR TBD
304- POWDER ROOM	NEW WOOD FLOOR	NEW PAINTED GWB	NEW PTD. WD. BASE	NEW PAINTED GWB	NEW WOOD ONLY IF SALVAGED WOOD IS INADEQUATE FOR DIAGONAL INSTALLATION
305- MASTER BATH	CERAMIC TILE	NEW PAINTED GWB- MR	CERAMIC TILE BASE	NEW PAINTED GWB-MR	
306- SAUNA	WHITE CERAMIC HEX TILE	NEW PAINTED GWB	EXIST. WD. REFINISHED	NEW GWB W/ BACKER BOARD	

2 FINISH SCHEDULE  
 A6.1 SCALE: 1/4" = 1'-0"