⊕ -⊘-CTV <del>-69-</del>64

 $\square$ 

S

E⊖

€

 $\bigcirc$ -(1)-

+2 +3 -( 4 )-

-(5)--(6)-

E1.1 E1.1 : Plotted on 10/19/15 at 10:44 AM by Joe Delaney. File Path: /Volumes/WCA Expansion Drive/ WCA Projects/2015 Projects/MHR Mellon Street House/MHR ArchiCAD Models/MHR Model v18 B.pln

## LIFE SAFETY SYMBOLS

SMOKE DETECTOR

CARBON MONOXIDE DETECTOR

ELECTRICAL SYMBOLS- "E" BESIDE SYMBOL DENOTES EXISTING ROUGH ELECTRICAL WORK

DUPLEX OUTLET 18" A.F.F. UNLESS NOTED OTHERWISE "WP" INDICATES WATERPROOF OUTLET PROVIDE GFI WHERE NOTED

DOUBLE DUPLEX OUTLET 18" A.F.F. UNLESS NOTED OTHERWISE "WP" INDICATES WATERPROOF OUTLET PROVIDE GFI WHERE NOTED

SPECIAL PURPOSE POWER OUTLET - CONSULT OWNER - RE STOVE, MICROWAVE, DISPOSAL

WALL PHONE JACK 18" A.F.F. UNLESS NOTED OTHERWISE

CABLE TV IF REQ'D - ASK OWNER

SWITCH

THREE-WAY SWITCH

COMPUTER - CONSULT OWNER - RE INTERNET CONNECTION

DUPLEX FLOOR OUTLET

CEILING FAN

EXHAUST FAN

LIGHTING SYMBOLS

RECESSED CAN FIXTURE- LED WARM LIGHT TYPICAL


WALL SCONCE

EXTERIOR WALL SCONCE

UTILITY LIGHT

SURFACE MOUNTED FIXTURE

PENDANT

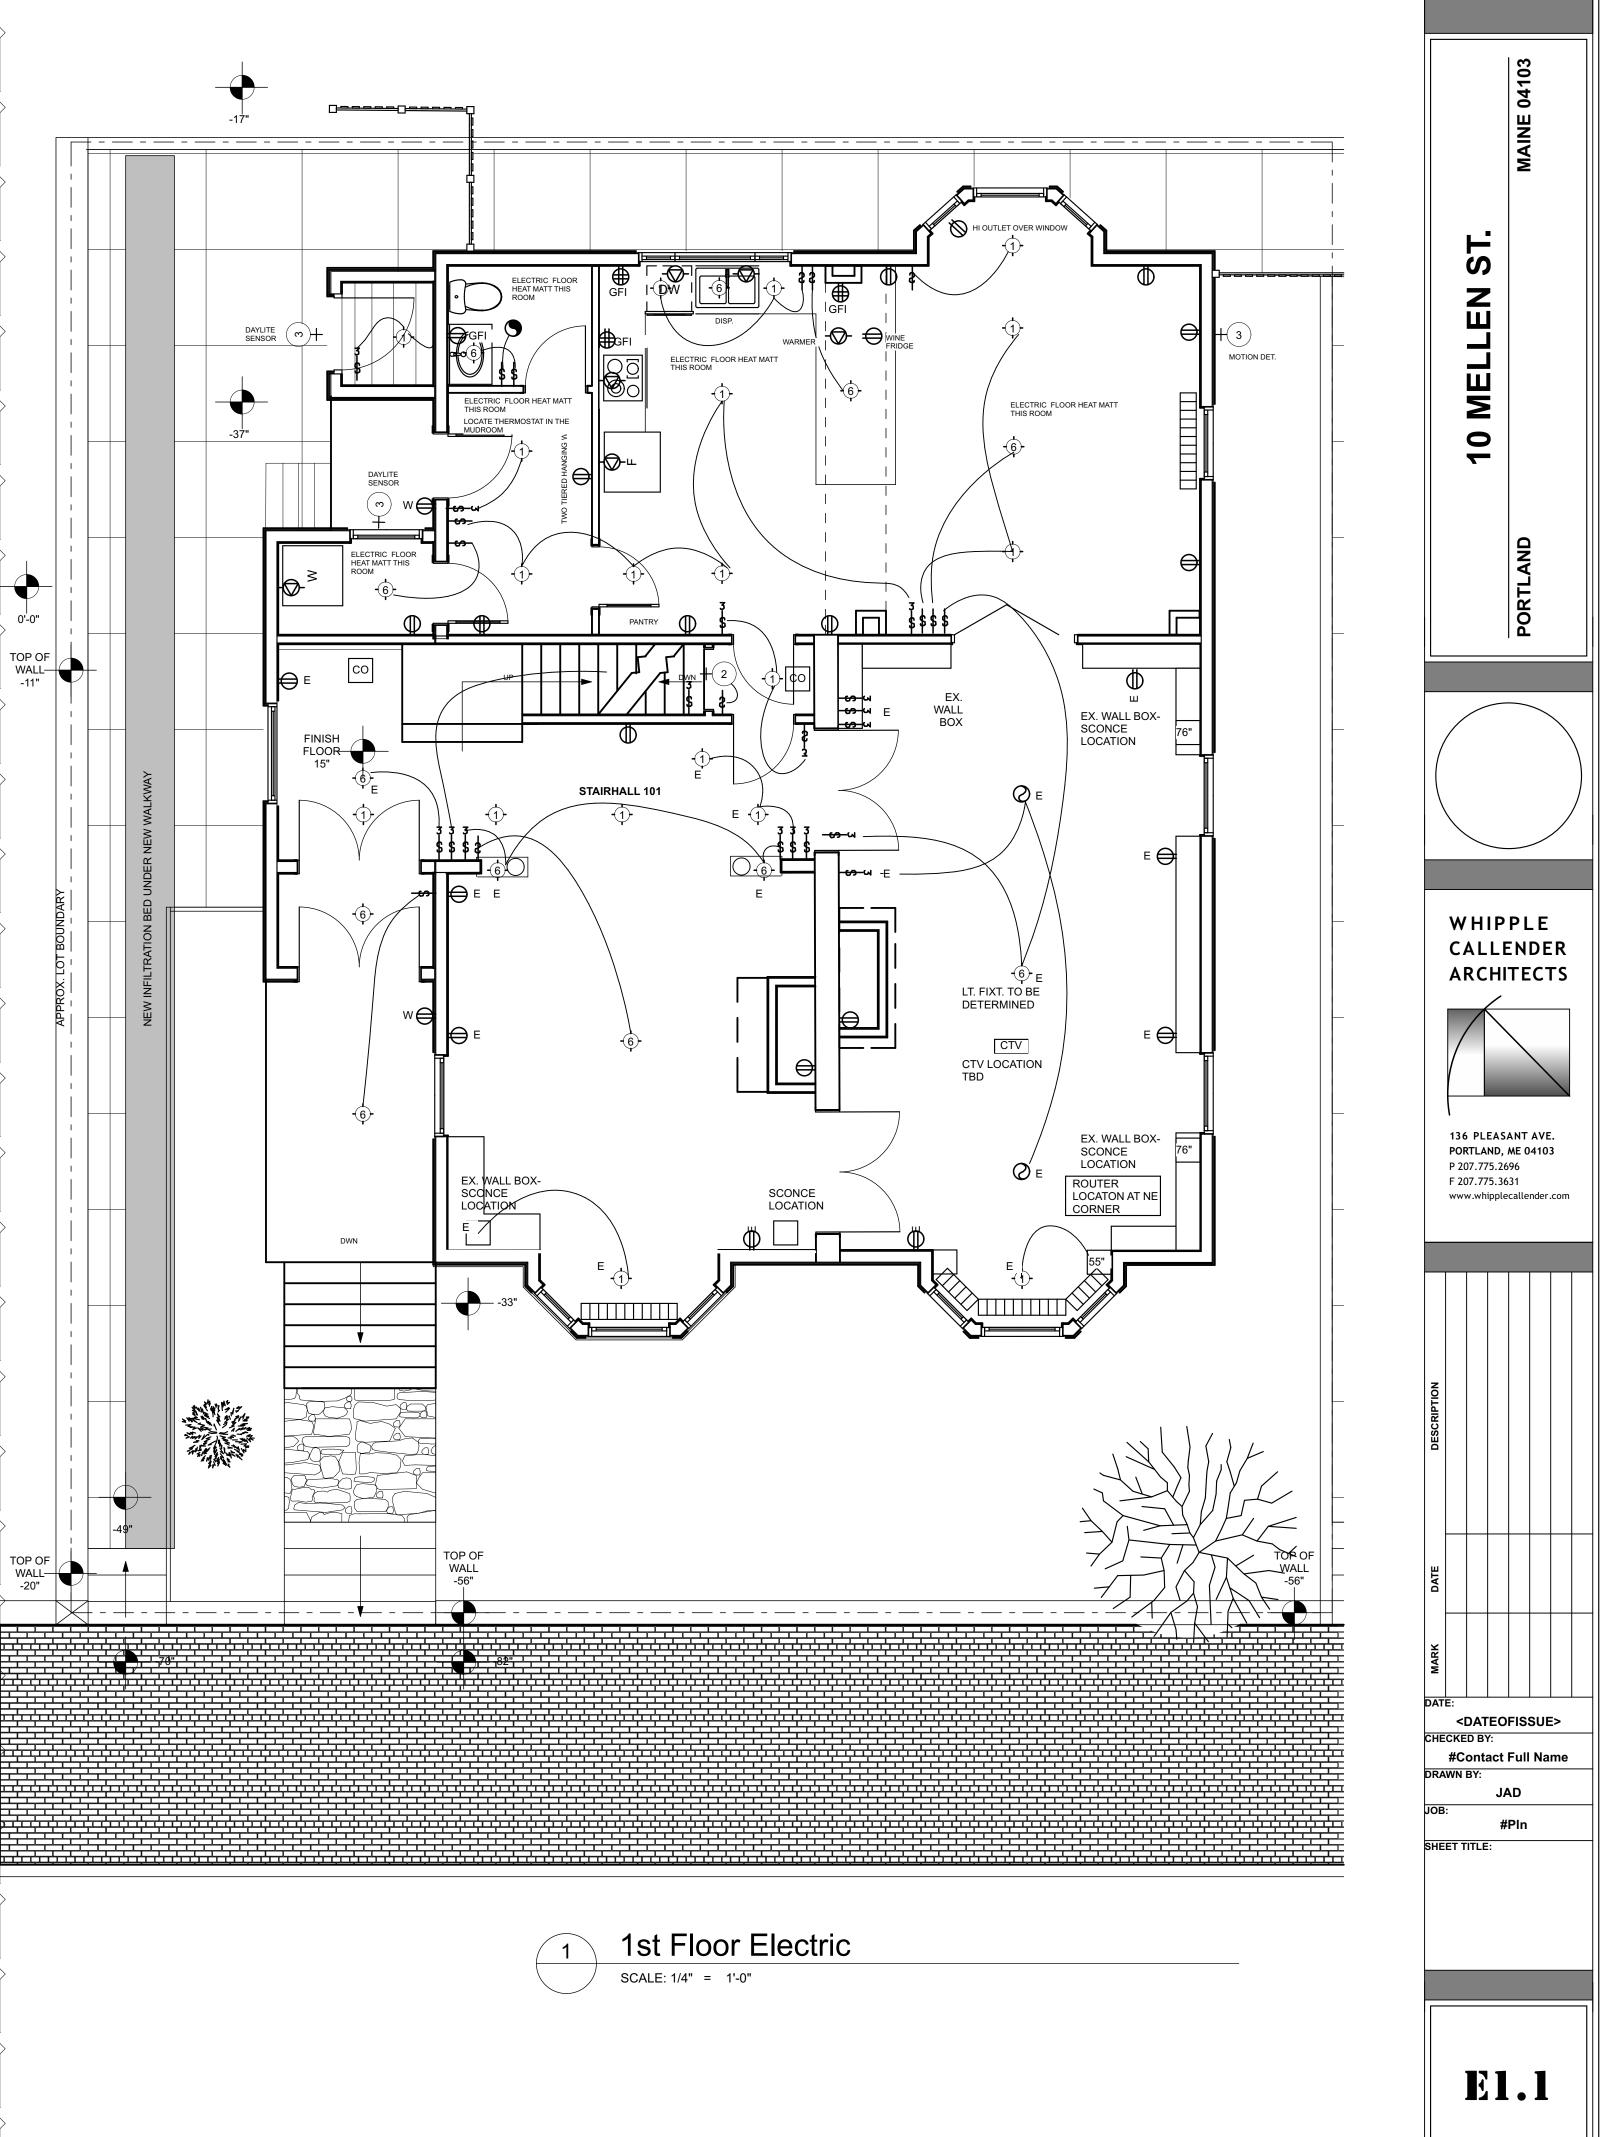



THIS DRAWING IS AN INSTRUMENT OF SERVICE AND SHALL REMAIN THE PROPERTY OF WHIPPLE CALLENDER ARCHITECTS. IT SHALL NOT BE USED FOR ANY OTHER PURPOSE THAT FOR WHICH IT IS SPECIFICALLY FURNISHED