



CHECKED BY:

SHEET TITLE:

E1.2



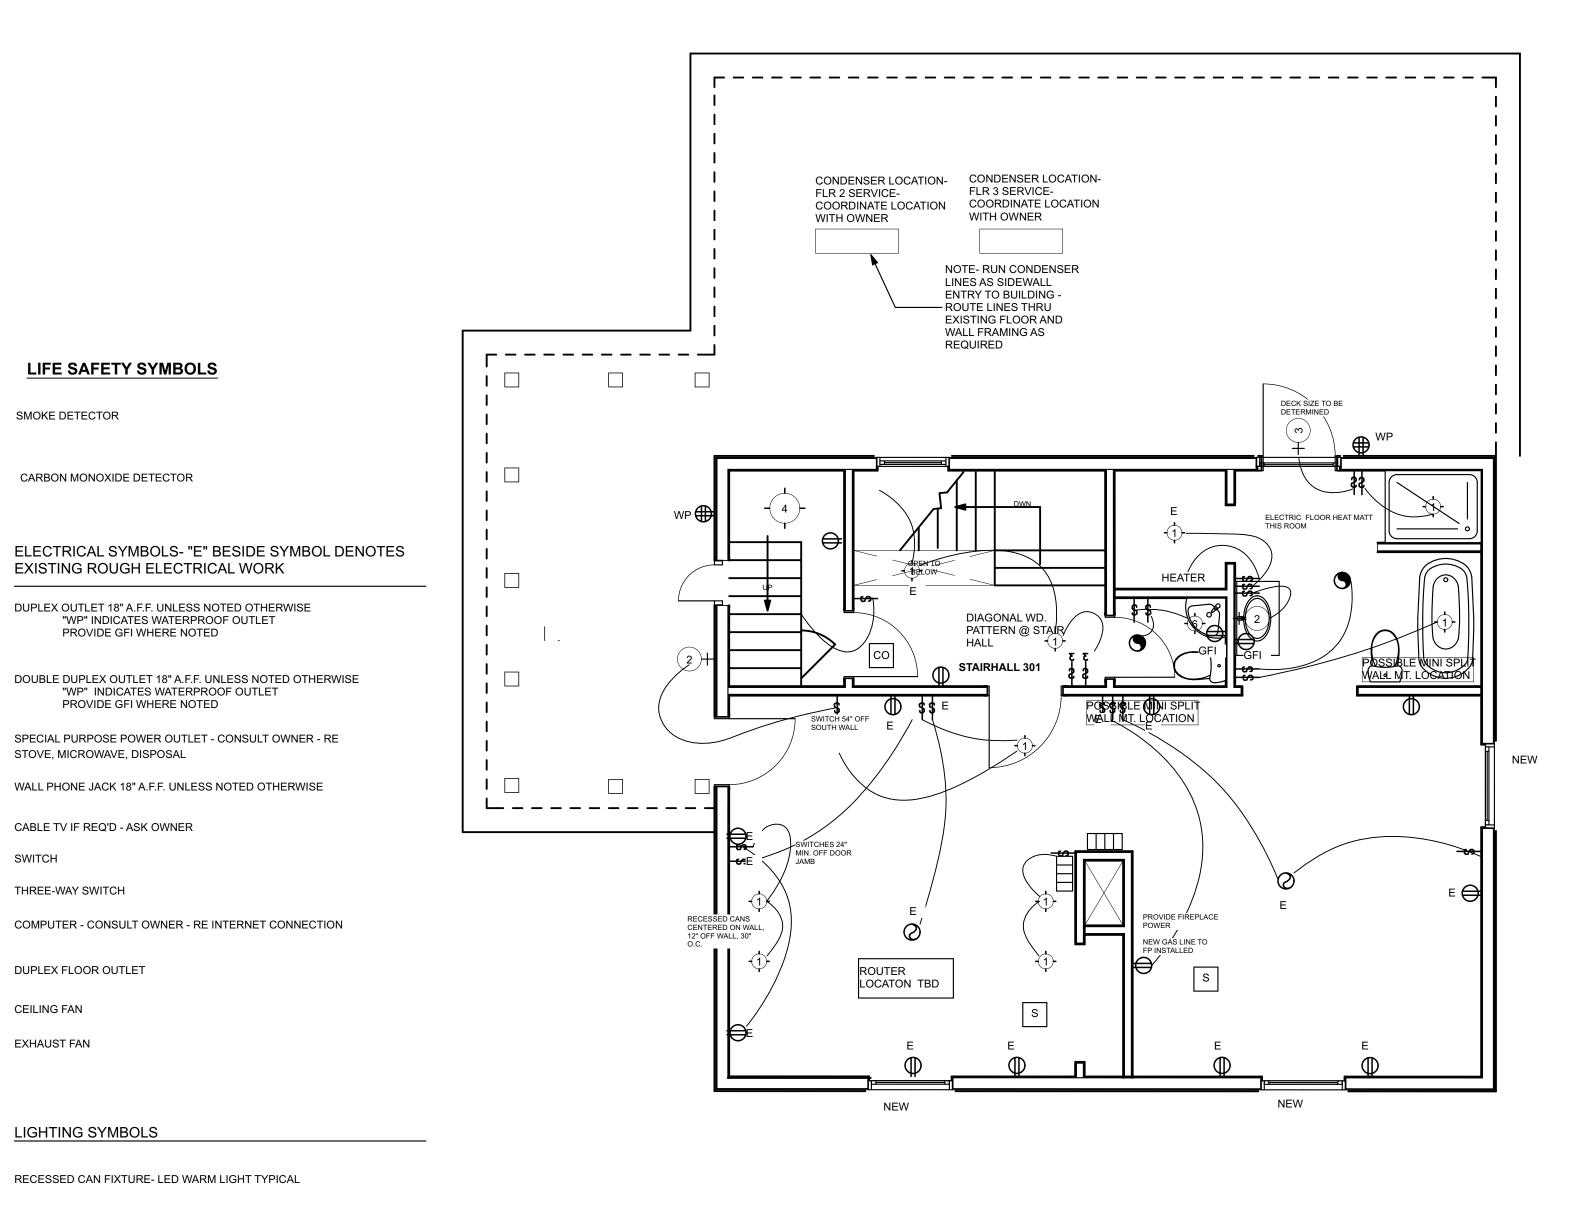

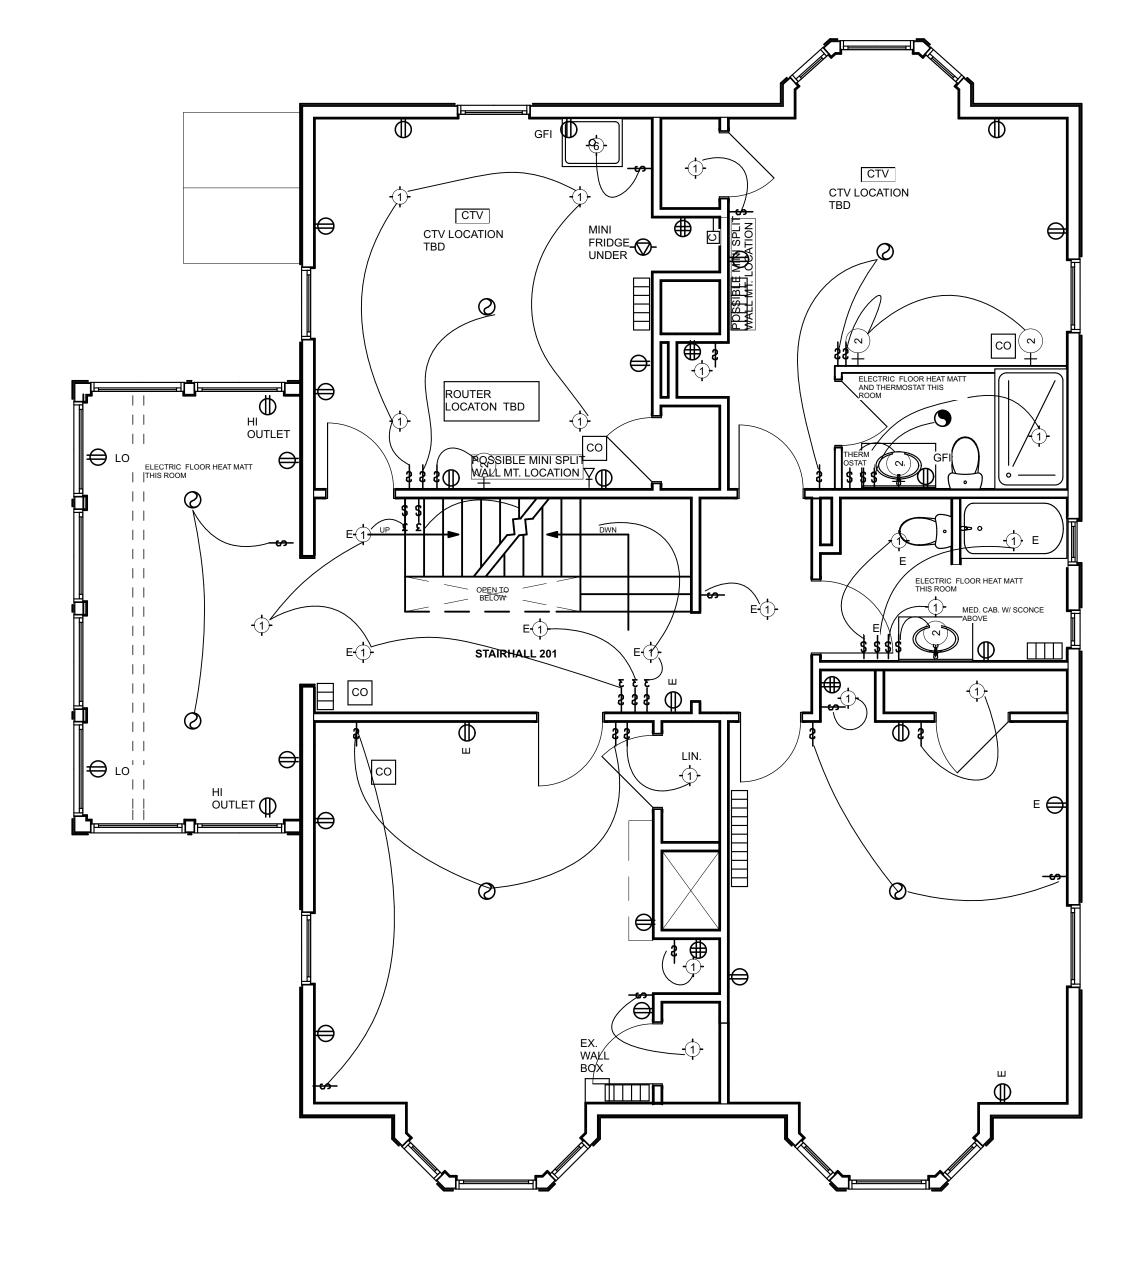

2nd Floor Electric

SCALE: 1/4" = 1'-0"

LIFE SAFETY SYMBOLS

CARBON MONOXIDE DETECTOR

STOVE, MICROWAVE, DISPOSAL

CABLE TV IF REQ'D - ASK OWNER

DUPLEX FLOOR OUTLET

LIGHTING SYMBOLS

EXTERIOR WALL SCONCE

SURFACE MOUNTED FIXTURE

CEILING FAN

EXHAUST FAN

WALL SCONCE

-( 4 )- UTILITY LIGHT

PENDANT

EXISTING ROUGH ELECTRICAL WORK

PROVIDE GFI WHERE NOTED

DUPLEX OUTLET 18" A.F.F. UNLESS NOTED OTHERWISE

"WP" INDICATES WATERPROOF OUTLET

"WP" INDICATES WATERPROOF OUTLET
PROVIDE GFI WHERE NOTED

SPECIAL PURPOSE POWER OUTLET - CONSULT OWNER - RE

WALL PHONE JACK 18" A.F.F. UNLESS NOTED OTHERWISE

COMPUTER - CONSULT OWNER - RE INTERNET CONNECTION

RECESSED CAN FIXTURE- LED WARM LIGHT TYPICAL

DOUBLE DUPLEX OUTLET 18" A.F.F. UNLESS NOTED OTHERWISE

SMOKE DETECTOR

THIS DRAWING IS AN INSTRUMENT OF SERVICE AND SHALL REMAIN THE PROPERTY OF WHIPPLE CALLENDER ARCHITECTS. IT SHALL NOT BE USED FOR ANY OTHER PURPOSE THAT FOR WHICH IT IS SPECIFICALLY FURNISHED

<DATEOFISSUE> #Contact Full Name