


A 4 BATHROOM FLOOR PLAN
AS BUILT


REV. 2

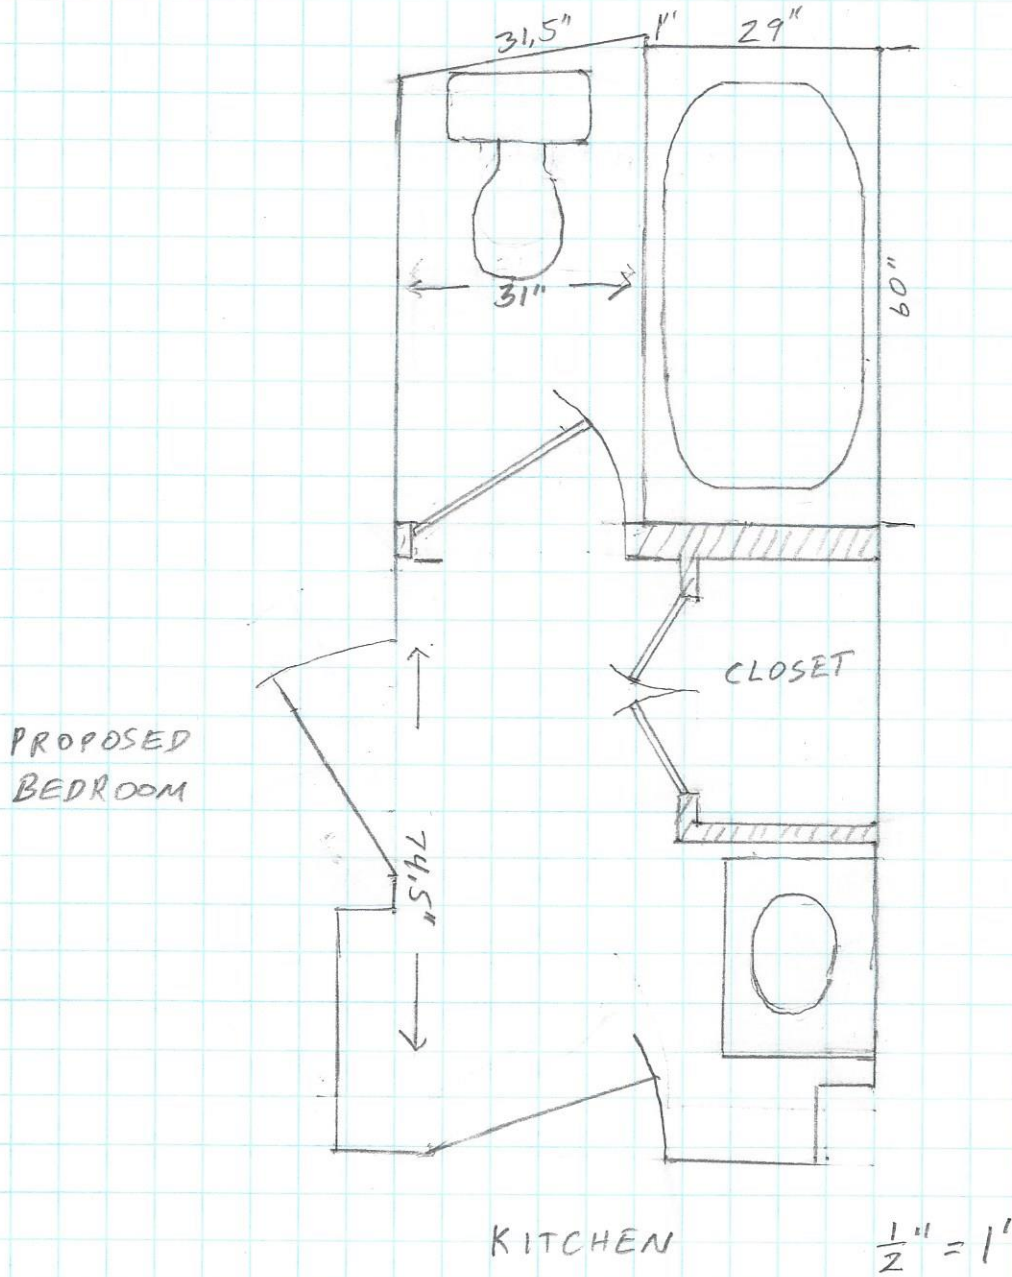

146-148 SHERMAN ST.

A5 BEDROOM FLOOR PLAN
AS BUILT

REV. 2

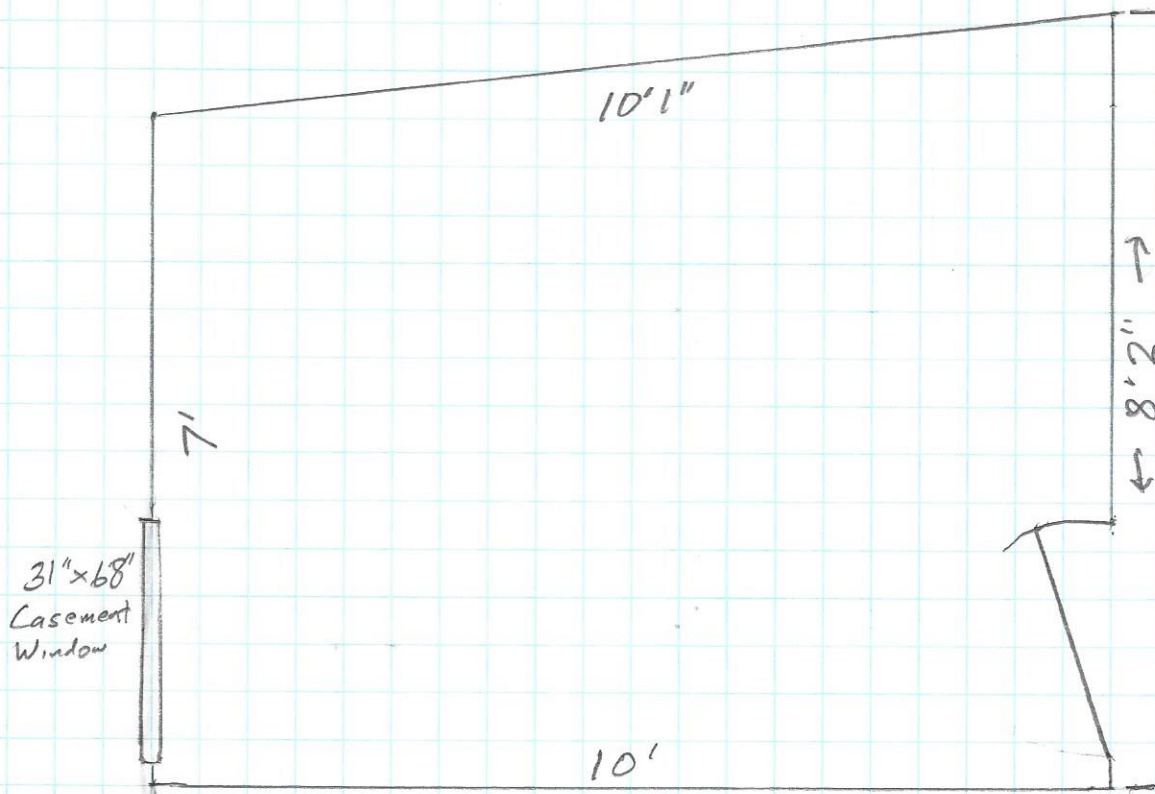

$\frac{1}{2}'' = 1'$

146-148 SHERMAN ST.