


Approved ( )  
 Approved as Corrected (✓)  
 If checked above, fabrication MAY be undertaken. Approval does not authorize changes to Contract Sum unless stated in separate letter or Change Order.  
 If checked below, fabrication MAY NOT be undertaken. Revisions NOT rectified copies for final approval. Correction shall be limited to items marked.  
 Revisions and Resubmit ( )  
 Not Approved ( )  
 Reviewing is only for conformance with the design concept of the Project and compliance with the information given in the Contract Documents. The Contractor is responsible for all dimensions, for information that pertains solely to the fabrication processes or to the means, methods, techniques, sequences and procedures of construction; and for coordination of the work of all trades.  
 THE RITCHIE ORGANIZATION  
 Date: 9/10/06 By: [Signature]

**RECEIVED**  
 AUG 14 2006  
 Simpson Gumpertz & Heger  
 Consulting Engineers Inc.  
 APPROVED  NOT APPROVED  
 REVISE AND RESUBMIT  
 RESUBMIT FOR RECORD COPY.  
 Checking is only for conformance with the design concept of the project and compliance with the information given in the Contract Documents. Contractor is responsible for dimensions to be confirmed and correlated at the job site for information that pertains solely to the fabrication processes or to the means, methods, techniques, sequences and procedures of construction; and for coordination of the work of all trades.  
 BY: M.J. Boland  
 DATE: 7/29/06  
 SIMPSON GUMPERTZ & HEGER INC.  
 CONSULTING ENGINEERS  
 41 SEYON ST., BUILDING 1, SUITE 500  
 WALTHAM, MA 02453


WILLIAM BERRY & SON, INC.  
 REVIEWED IN ACCORDANCE WITH THE CONTRACT DOCUMENTS.  
 THE SUBCONTRACTOR/VENDOR IS RESPONSIBLE FOR ALL DIMENSIONS, CORRECT FIT AND COORDINATION OF ALL ITEMS TO BE FURNISHED & INSTALLED.  
 BY: [Signature] DATE: 7/27/06  
 JOB #: 04-310-0 JOB NAME: 2578-014-2  
 SUBMISSION #: SPEC. REV. REF.  
 REVIEWED FOR CONSTRUCTION

FOR APPROVAL  
 JUL 31 2006

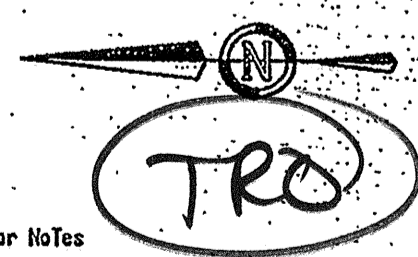

NOVEL IRON WORKS  
 250 Ocean Road  
 Greenland, NH 03840

No.	Date	Description	Notes	Drawn	Checked	Category
1	01-04-06	UPDATED TO SUIT APPROVAL				III

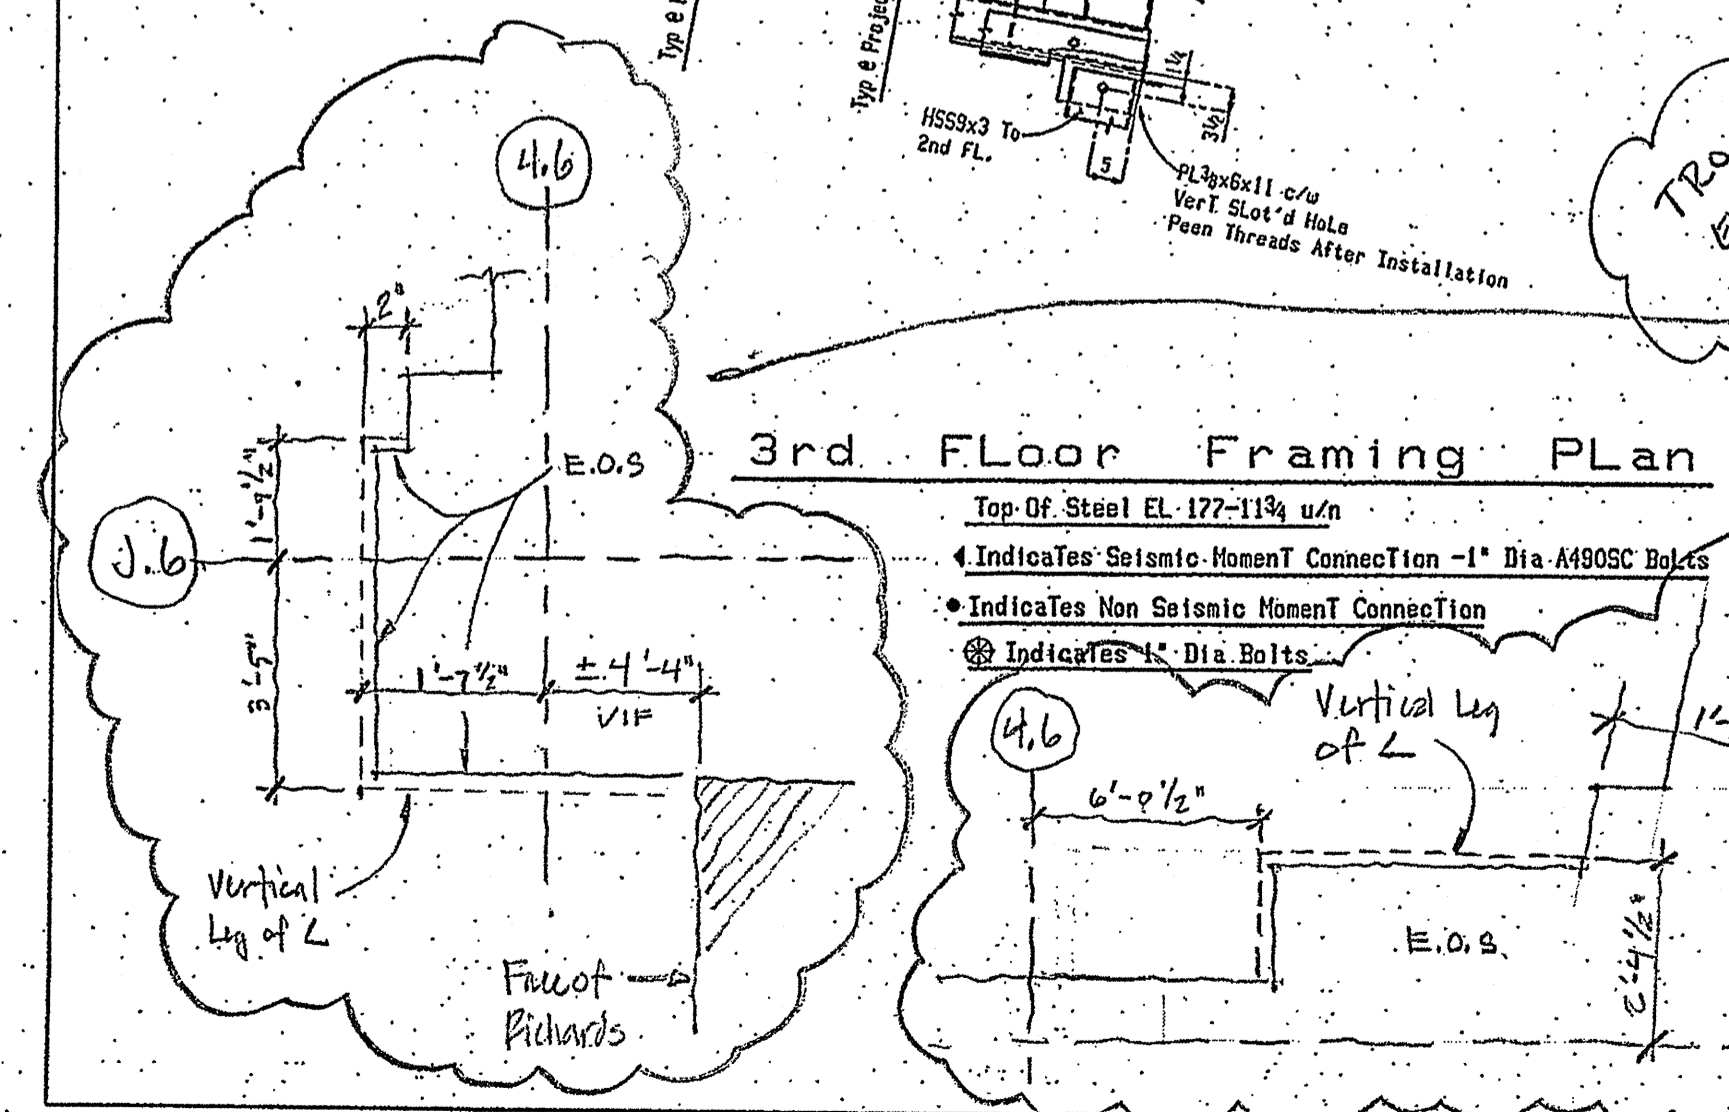

TRC to Review/Verify Extent of Rel. Lx and Revise Memo C10.  
 REL. Lx MUST BE PHASE OF RIBBON.  
 Vertical leg of L  
 Face of Column

Correct the Column  
 Steel Framing (By Others)

TRC to Review/Verify Extent of Rel. Lx and Revise Memo C10.  
 REL. Lx MUST BE PHASE OF RIBBON.

NO CHANGE REQ'D.

NO CHANGE REQ'D.