



Letter of Transmittal

POB 1145, 550 Cheshire Rd, Pittsfield
MA 01202

Date: February 12, 2018

Company: TURNER CONSTRUCTION
2 Seaport Lane 2nd Floor
Boston, MA 02210

Job Name: Maine Medical Center Vertical
Expansion PG

Location: Portland, ME

Job #: 51267

Phone: 617-438-1263

RE: Submittal #4 Double Tee Standard
Zurn Drain

Attention: Richard Martineau

We are sending you the following items:

- Mix Design Shop Drawings Framing Drawings Copy of Letter
- Specifications Sections Calculations Other

Copies	Drawing Number	Description
1	1	ZURN Z662 DATA SHEET

- These are sent for:
- Approval Your Use Record Set
 - Final Approval Coordination
 - Distribution Information Only

Remarks: FOR APPROVAL

TURNER CONSTRUCTION COMPANY
Reviewed for General Acceptance only. This review does not relieve the Subcontractor of the responsibility for making the work conform to the requirements of the contract. The Subcontractor is responsible for all dimensions, correct fabrication and accurate fit with the work of other trades.
SUBJECT TO ARCHITECTS APPROVAL
Signed <u>rmartineau</u> Date <u>Feb 20, 2018</u>
Submittal No. <u>221423-0001-0</u>

Signed:

Todd Haley

cc: File






Z662-PK

16 [406] EXTRA HEAVY-DUTY DRAIN FOR PRECAST CONCRETE PARKING DECK SYSTEM

SPECIFICATION SHEET

TAG _____

Dimensional Data (inches and [mm]) are Subject to Manufacturing Tolerances and Change Without Notice

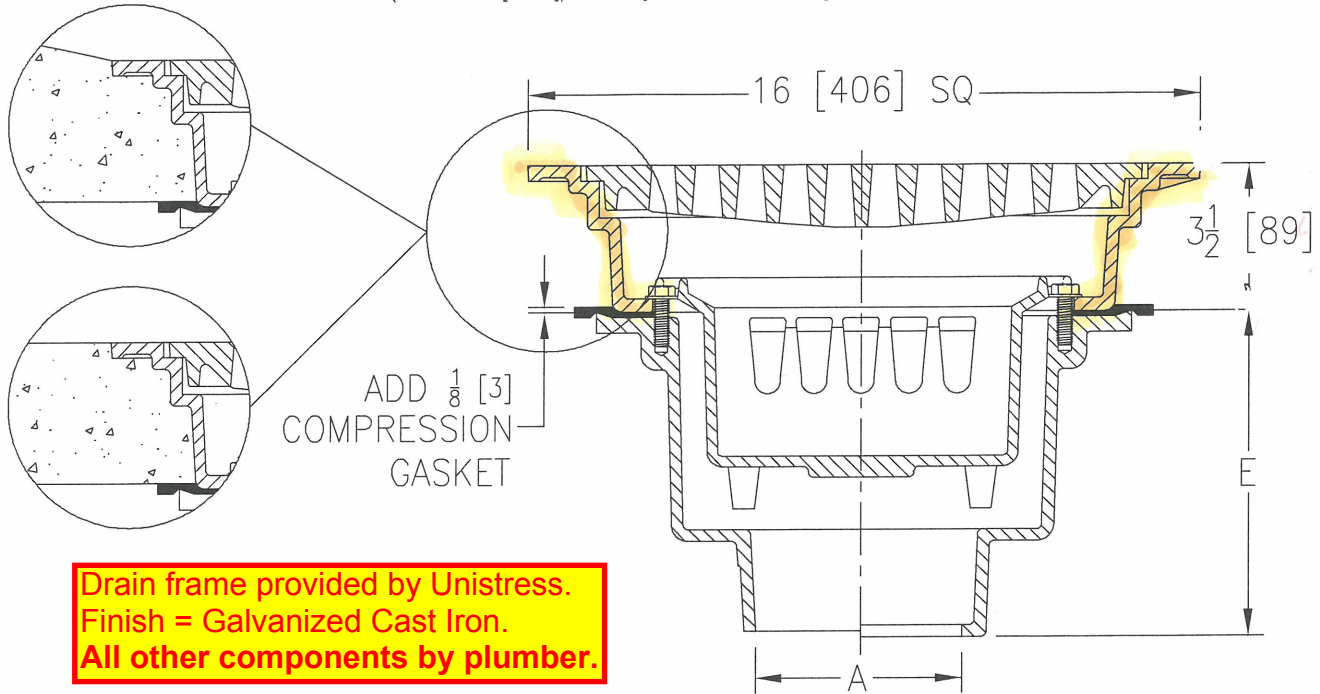

**Drain frame provided by Unistress.
Finish = Galvanized Cast Iron.
All other components by plumber.**

A Pipe Size	Approx. Wt. Lbs. [kg]	Grate Open Area Sq. In. [cm ²]
3-4 [76-102]	84 [38]	53 [342]
5-6 [127-152]	90 [41]	

ENGINEERING SPECIFICATION: Z662-PK

16 [406] Square top drain, Dura-Coated cast iron body with bottom outlet, gasket seal and hardware, seepage pan and combination membrane flashing clamp and frame for extra heavy-duty slotted loose grate with suspended sediment bucket.

OPTIONS (Check/specify appropriate options)

PIPE SIZE

- 3 thru 6 [76 thru 152]
- 3, 4, 6 [76, 102, 152]
- 3 [76]
- 4 thru 6 [102 thru 152]
- 3 thru 6 [76 thru 152]
- 3, 4 [76, 102]

(Specify size/type) OUTLET

- ___ IC Inside Caulk
- ___ IG Inside Caulk w/Sealtrol Gskt.
- ___ IP Threaded
- ___ IP Threaded
- ___ NH No-Hub
- ___ NL Neo-Loc

'E' BODY HT. DIM.

- 7 3/4 [197]
- 7 3/4 [197]
- 6 1/16 [154]
- 6 5/16 [160]
- 7 13/16 [198]
- 7 3/16 [183]

PREFIXES

- ___ Z D.C.C.I. Body and Grate*
- ___ ZB D.C.C.I Body w/ Polished Bronze Top (Add 3/16 [5] to 3 1/2 [89] and 11/16 [17] to 16 [406] Dim.)
- ___ ZN D.C.C.I Body w/ Polished Nickel Bronze Top (Add 3/16 [5] to 3 1/2 [89] and 11/16 [17] to 16 [406] Dim.)

SUFFIXES

- ___ -DG Duresist Grate
- ___ -G Galvanized Cast Iron
- ___ -SS Stainless Mesh Liner for Bucket
- ___ -TS Top Secured With Slotted Screws
- ___ -V Backwater Valve (See Z1099)
- ___ -VP Vandal-Proof Secured Top
- ___ -YA Aluminum Sediment Bucket
- ___ -90 90° Threaded Side Outlet Body

*REGULARLY FURNISHED UNLESS OTHERWISE SPECIFIED

REV. A DATE: 3/18/09 C.N. NO. 99820

DWG. NO. 84146 PRODUCT NO. Z662-PK

ZURN INDUSTRIES, LLC. ♦ SPECIFICATION DRAINAGE OPERATION ♦ 1801 Pittsburgh Ave. ♦ Erie, PA 16514

Phone: 814455-0921 ♦ Fax: 814454-7929 ♦ World Wide Web: www.zurn.com

In Canada: ZURN INDUSTRIES LIMITED ♦ 3544 Nashua Drive ♦ Mississauga, Ontario L4V1L2 ♦ Phone: 905405-8272 Fax: 905405-1292