


Seals

BECKER
structural engineers, inc.


75 York Street
Portland, ME 04101-4701
info@beckerstructural.com

Tel 207-879-1838
Fax 207-879-1822
www.beckerstructural.com

Consultant

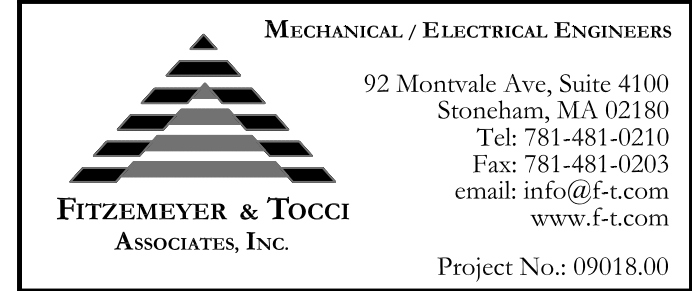

Consultant

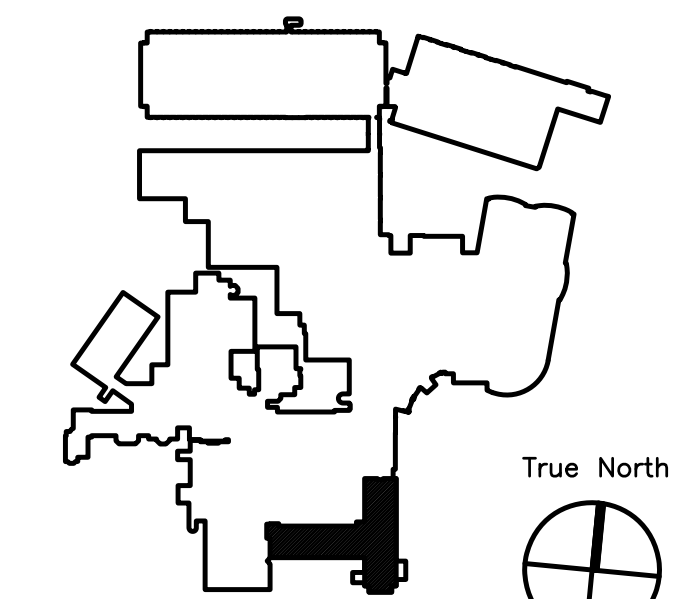

Key Plan N.T.S.

ADDENDUM#	Date	No
1	12/4/09	1
Revision		



MAINE MEDICAL CENTER
PAVILION 6 RENOVATIONS

MorrisSwitzer Project Number 28034
Date 11/19/09
Scale 1/8" = 1'-0"

Sheet Title and Number
**SECOND FLOOR
PAVILION "C" & "D"
INTERIM OCCUPANCY
ELECTRICAL PLAN
2E1.0**


SCOPE OF WORK NOTES:

- 1 PROVIDE NEW CARD READER, DOOR STRIKE AND JUNCTION BOX ABOVE CEILING FOR 120V WIRING. PROVIDE BRANCH CIRCUIT WIRING TO THE NEAREST 120/208,3Ø,4W EQUIPMENT PANEL SERVING THE AREA
- 2 ALL EXISTING LIGHTING, POWER, SWITCHING, FIRE ALARM, ETC IS TO REMAIN
- 3 REPLACE EXISTING NIGHTLIGHTS WITH NEW TAMPERPROOF LED NIGHTLIGHT AS MANUFACTURED BY KIRLIN #LW-05107-94 (BRUSHED 12 GAUGE STAINLESS STEEL COVER)
- 4 IN PATIENT ROOMS, REPLACE ALL HEAD WALL DEVICES WITH NEW TAMPER PROOF DEVICES AS FOLLOWS: MAINTAIN (2) CRITICAL RECEPTACLE LOCATIONS [(1) FOR THE BED, (1) FOR CONVENIENCE] AND (1) NORMAL RECEPTACLE. THE REMAINING RECEPTACLES ARE TO BE REMOVED. MAINTAIN CONTINUITY OF EXISTING BRANCH CIRCUITS AND INSTALL TAMPERPROOF BLANK PLATE WITH TAMPERPROOF SCREWS.
- 5 REMOVE EXISTING NURSECALL DEVICES IN THIS AREA. MAINTAIN EXISTING WIRING FOR CONNECTION TO NEW TAMPERPROOF PATIENT BED STATIONS. STAFF ASSIST STATION TO BE REMOVED. MAINTAIN CONTINUITY OF EXISTING BRANCH CIRCUITS AND INSTALL TAMPERPROOF BLANK PLATE WITH TAMPERPROOF SCREWS. RELOCATE EXISTING DOME LIGHT IN CORRIDOR TO CEILING ABOVE DOORWAY..
- 6 ALL DEVICES AND SWITCHING, (NOT ON HEAD WALL IN PATIENT ROOMS) SHALL BE REPLACED WITH NEW TAMPER PROOF TYPE DEVICES WITH TAMPERPROOF PLATE AND TAMPERPROOF SCREWS
- 7 ABANDON EXISTING RECESSED FLUORESCENT DOWN LIGHTS ABOVE CEILING FOR FUTURE USE. REMOVE ASSOCIATED SWITCHING. MAINTAIN CONTINUITY OF EXISTING BRANCH CIRCUITS AND INSTALL BLANK PLATE WITH TAMPERPROOF SCREWS.
- 8 ON EXISTING RECESSED TROFFERS SERVING THE AREA, PROVIDE 1/4" POLYCARBONATE SHIELD BETWEEN THE T-BAR CEILING AND TROFFER.
- 9 EXISTING TELEDATA DEVICES ARE TO BE REMOVED, MAINTAIN CONTINUITY OF EXISTING CIRCUITS AND INSTALL BLANK PLATE WITH TAMPERPROOF SCREWS.
- 10 REPLACE EXISTING PATIENT ROOM HEAD WALL FIXTURES WITH EXISTING MAINTAINED PATIENT ROOM HEAD WALL LIGHT FIXTURES RELOCATED FROM THE SIXTH FLOOR PHASE UNDER THIS SCOPE OF WORK. CLEAN, RELAMP AND REBALLAST WITH (3) 28 WATT F028SS/835/XPS/ECO LAMPS AND (1) QTP1x32T8/UNV/PSX/TC (1) QTP2x32T8/UNV/PSX/TC BALLASTS
- 11 EXISTING DEVICES ASSOCIATED WITH THE TELEVISION ARE TO BE REMOVED, MAINTAIN CONTINUITY OF EXISTING CIRCUITS AND INSTALL BLANK PLATE WITH TAMPERPROOF SCREWS.
- 12 REPLACE EXISTING PATIENT BATHROOM WALL FIXTURES WITH 4' SURFACE MOUNTED FLUORESCENT INSTITUTIONAL FIXTURE AS MANUFACTURED BY FAIL-SAFE # FMC-X-228SS-120-80-84-(BALLAST) -EBP-TCS-VRSO WITH (2) 28 WATT F028SS/835/XPS/ECO LAMPS (45 INPUT WATTS). BALLAST: (1) QTP2x32T8/UNV/PSX/TC
- 13 REMOVE EXISTING RECESSED CORRIDOR 2X2 FLUORESCENT LIGHTING. TURN FIXTURES OVER TO OWNER FOR RE-USE. MAINTAIN EXISTING BRANCH CIRCUITRY FOR CONNECTION TO NEW LIGHTING. PROVIDE NEW 2'X2' LENSED INSTITUTIONAL TROFFER. IN ACT CEILING, 2-U LAMP AS MANUFACTURED BY FAIL SAFE FSR-TG-X-24-2U6T8-UNV-LAMPS-80-86 -EBP-EBB1-PAF-EO-CLIP-U WITH (2) 28 WATT F028SSU/835/XPS/ECO (45 INPUT WATTS) CONNECT CORRIDOR FIXTURES TO EXISTING SWITCHING. ENSURE CIRCUIT AMPACITY IS NOT EXCEEDED. SPACE NEW FIXTURES 10'-0"O.C.
- 14 PROVIDE TAMPERPROOF LEXAN COVERS OVER ALL MANUAL PULL STATIONS
- 15 EXISTING EXIT SIGNS ARE TO REMAIN
- 16 REPLACE EXISTING PATIENT SHOWER LIGHTING FIXTURES WITH NEW 10" RECESSED FLUORESCENT LENSED INSTITUTIONAL SHOWER LIGHT AS MANUFACTURED BY KIRLIN #RVO1054-13-94 (FINISH)-45-46-LE (42W) WITH (2) 32 WATT CFQ32W LAMPS (69 INPUT WATTS)


IN THIS SCOPE OF WORK, (SECOND FLOOR PAVILIONS C & D INTERIM OCCUPANCY) REFER TO DRAWING 2E1.0 FOR ADDITIONAL INFORMATION.


REFER TO 2E1.0 FOR CONTINUATION

REFER TO 2E1.0 FOR CONTINUATION

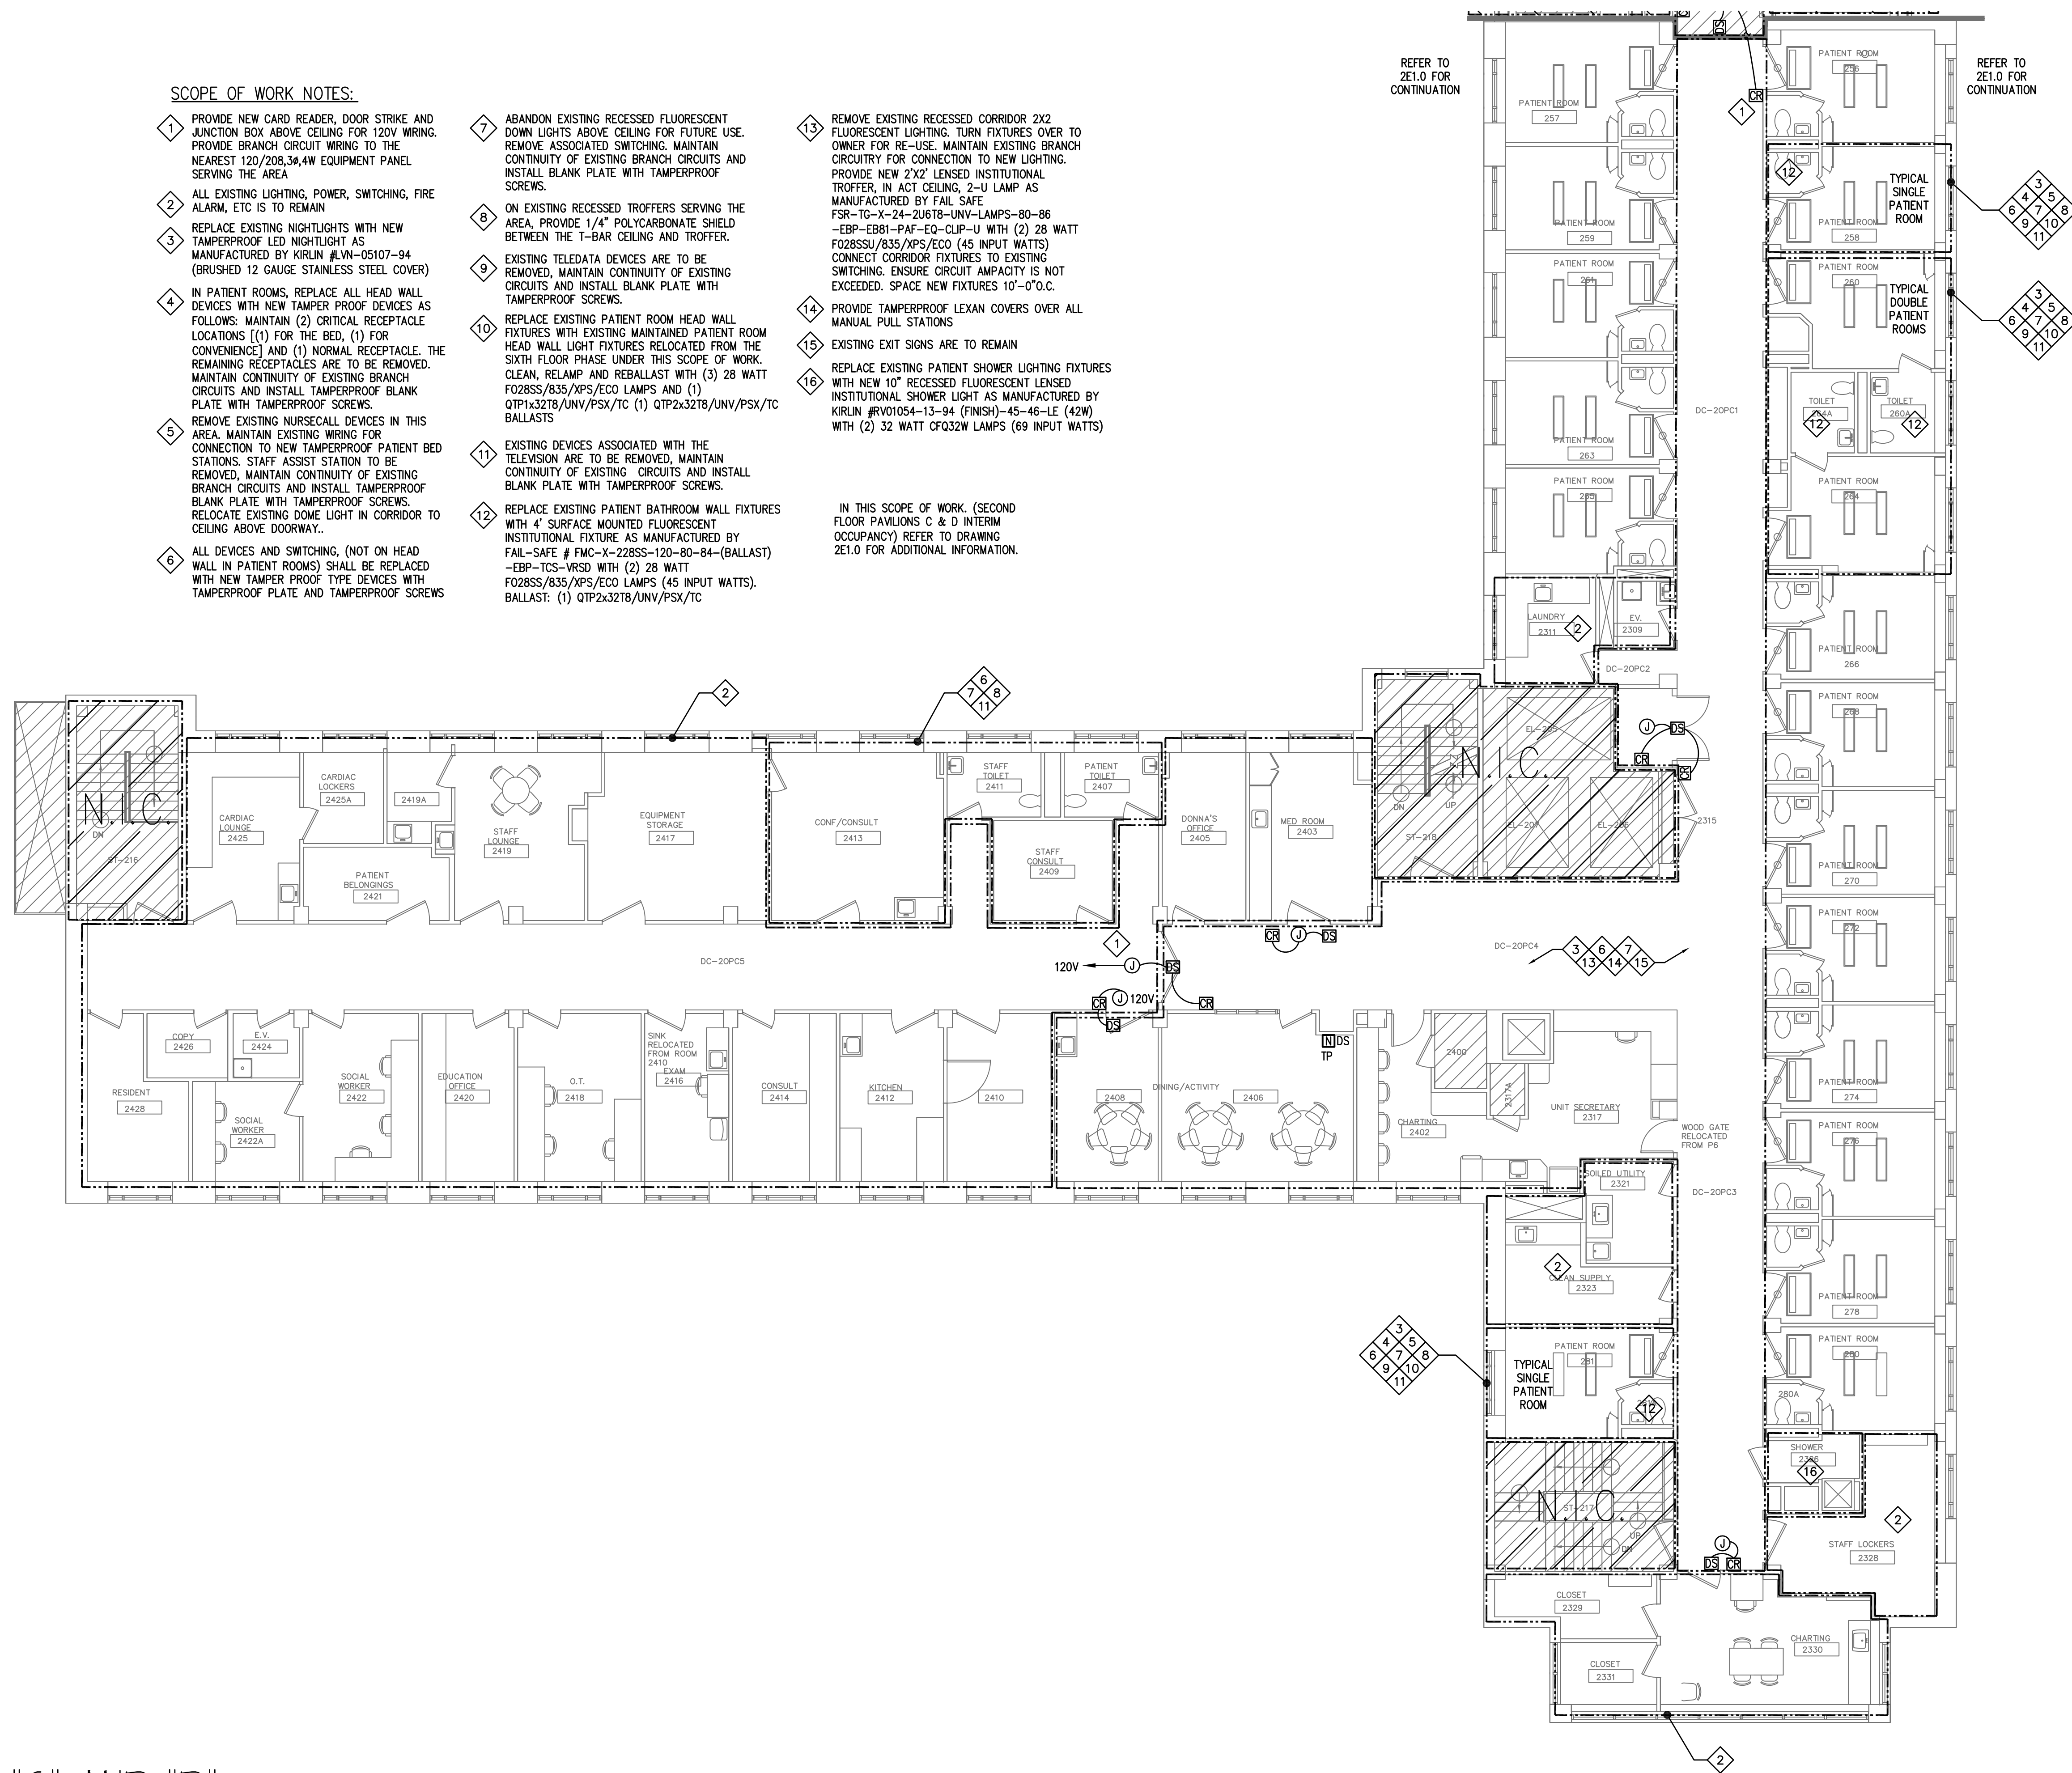

PAVILION "C" AND "D"

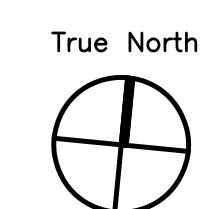

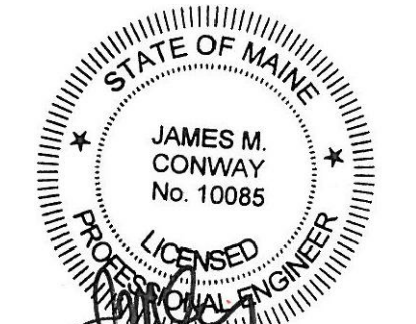

Seals

BECKER
structural engineers, inc.


75 York Street Portland, ME 04101-4701
Tel: 207-879-1838 Fax: 207-879-1822
info@beckerstructural.com www.beckerstructural.com

Consultant

MECHANICAL / ELECTRICAL ENGINEERS
92 Montvale Ave, Suite 4100
Snohomish, WA 98290
Tel: 781-481-0210 Fax: 781-481-0203
email: info@f-t.com www.f-t.com
Project No.: 09018.00

FITZMEYER & TOCCI
ASSOCIATES, INC.

Consultant

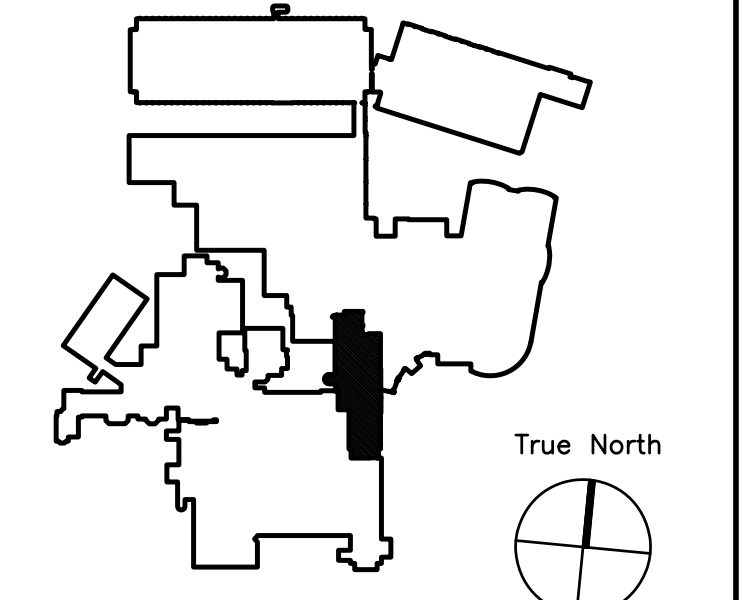

Key Plan N.T.S.




REVISION #	DATE	NO.
1	01/12/10	2
ADDENDUM #1	12/4/09	1
Revision	Date	No.



MAINE MEDICAL CENTER
PAVILION 6 RENOVATIONS

MorrisSwitzer Project Number: 28034
Date: 11/19/09
Scale: 1/8" = 1'-0"

SECOND FLOOR
PAVILION "A" INTERIM OCCUPANCY
ELECTRICAL PLAN
1E1.0

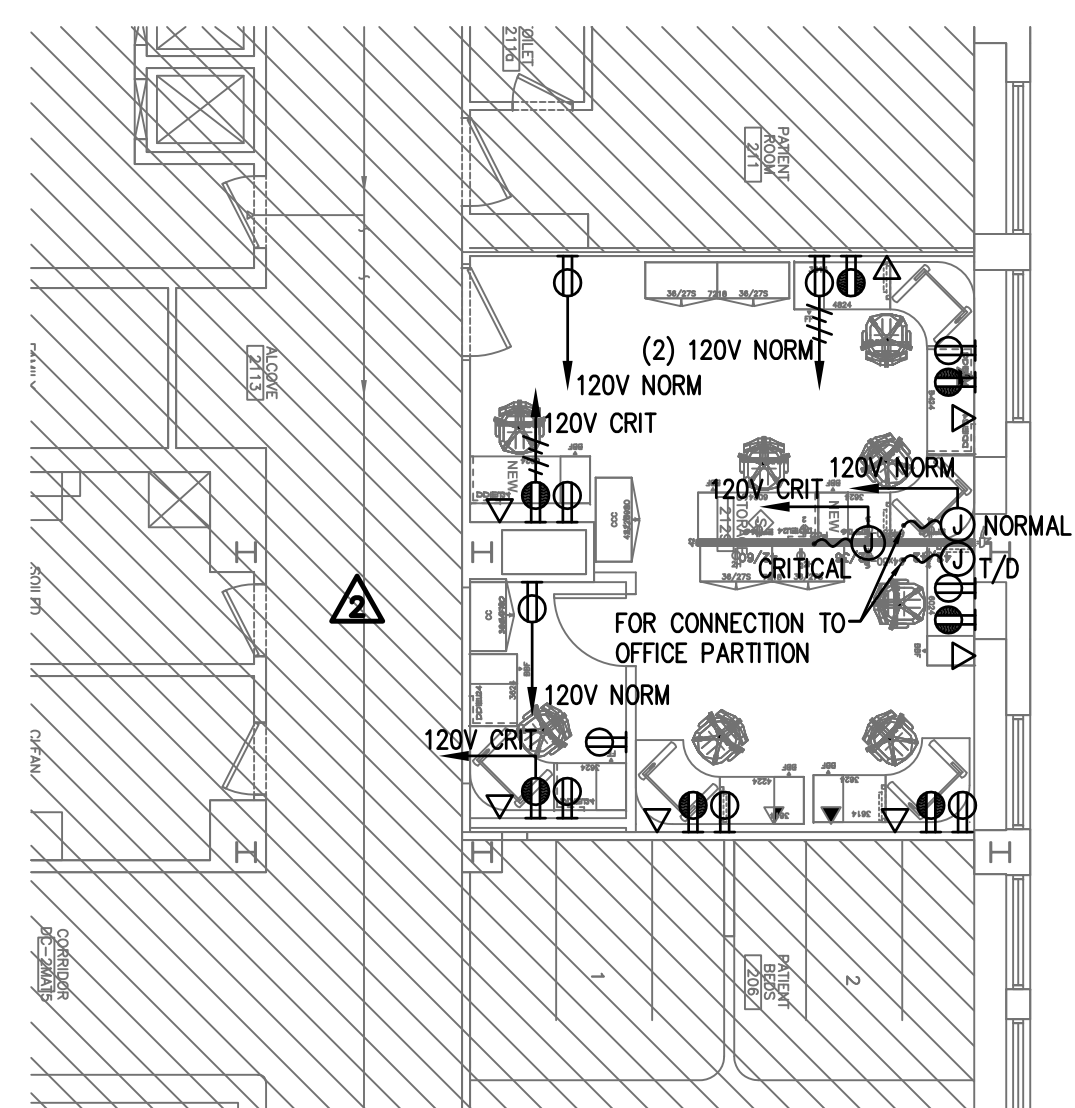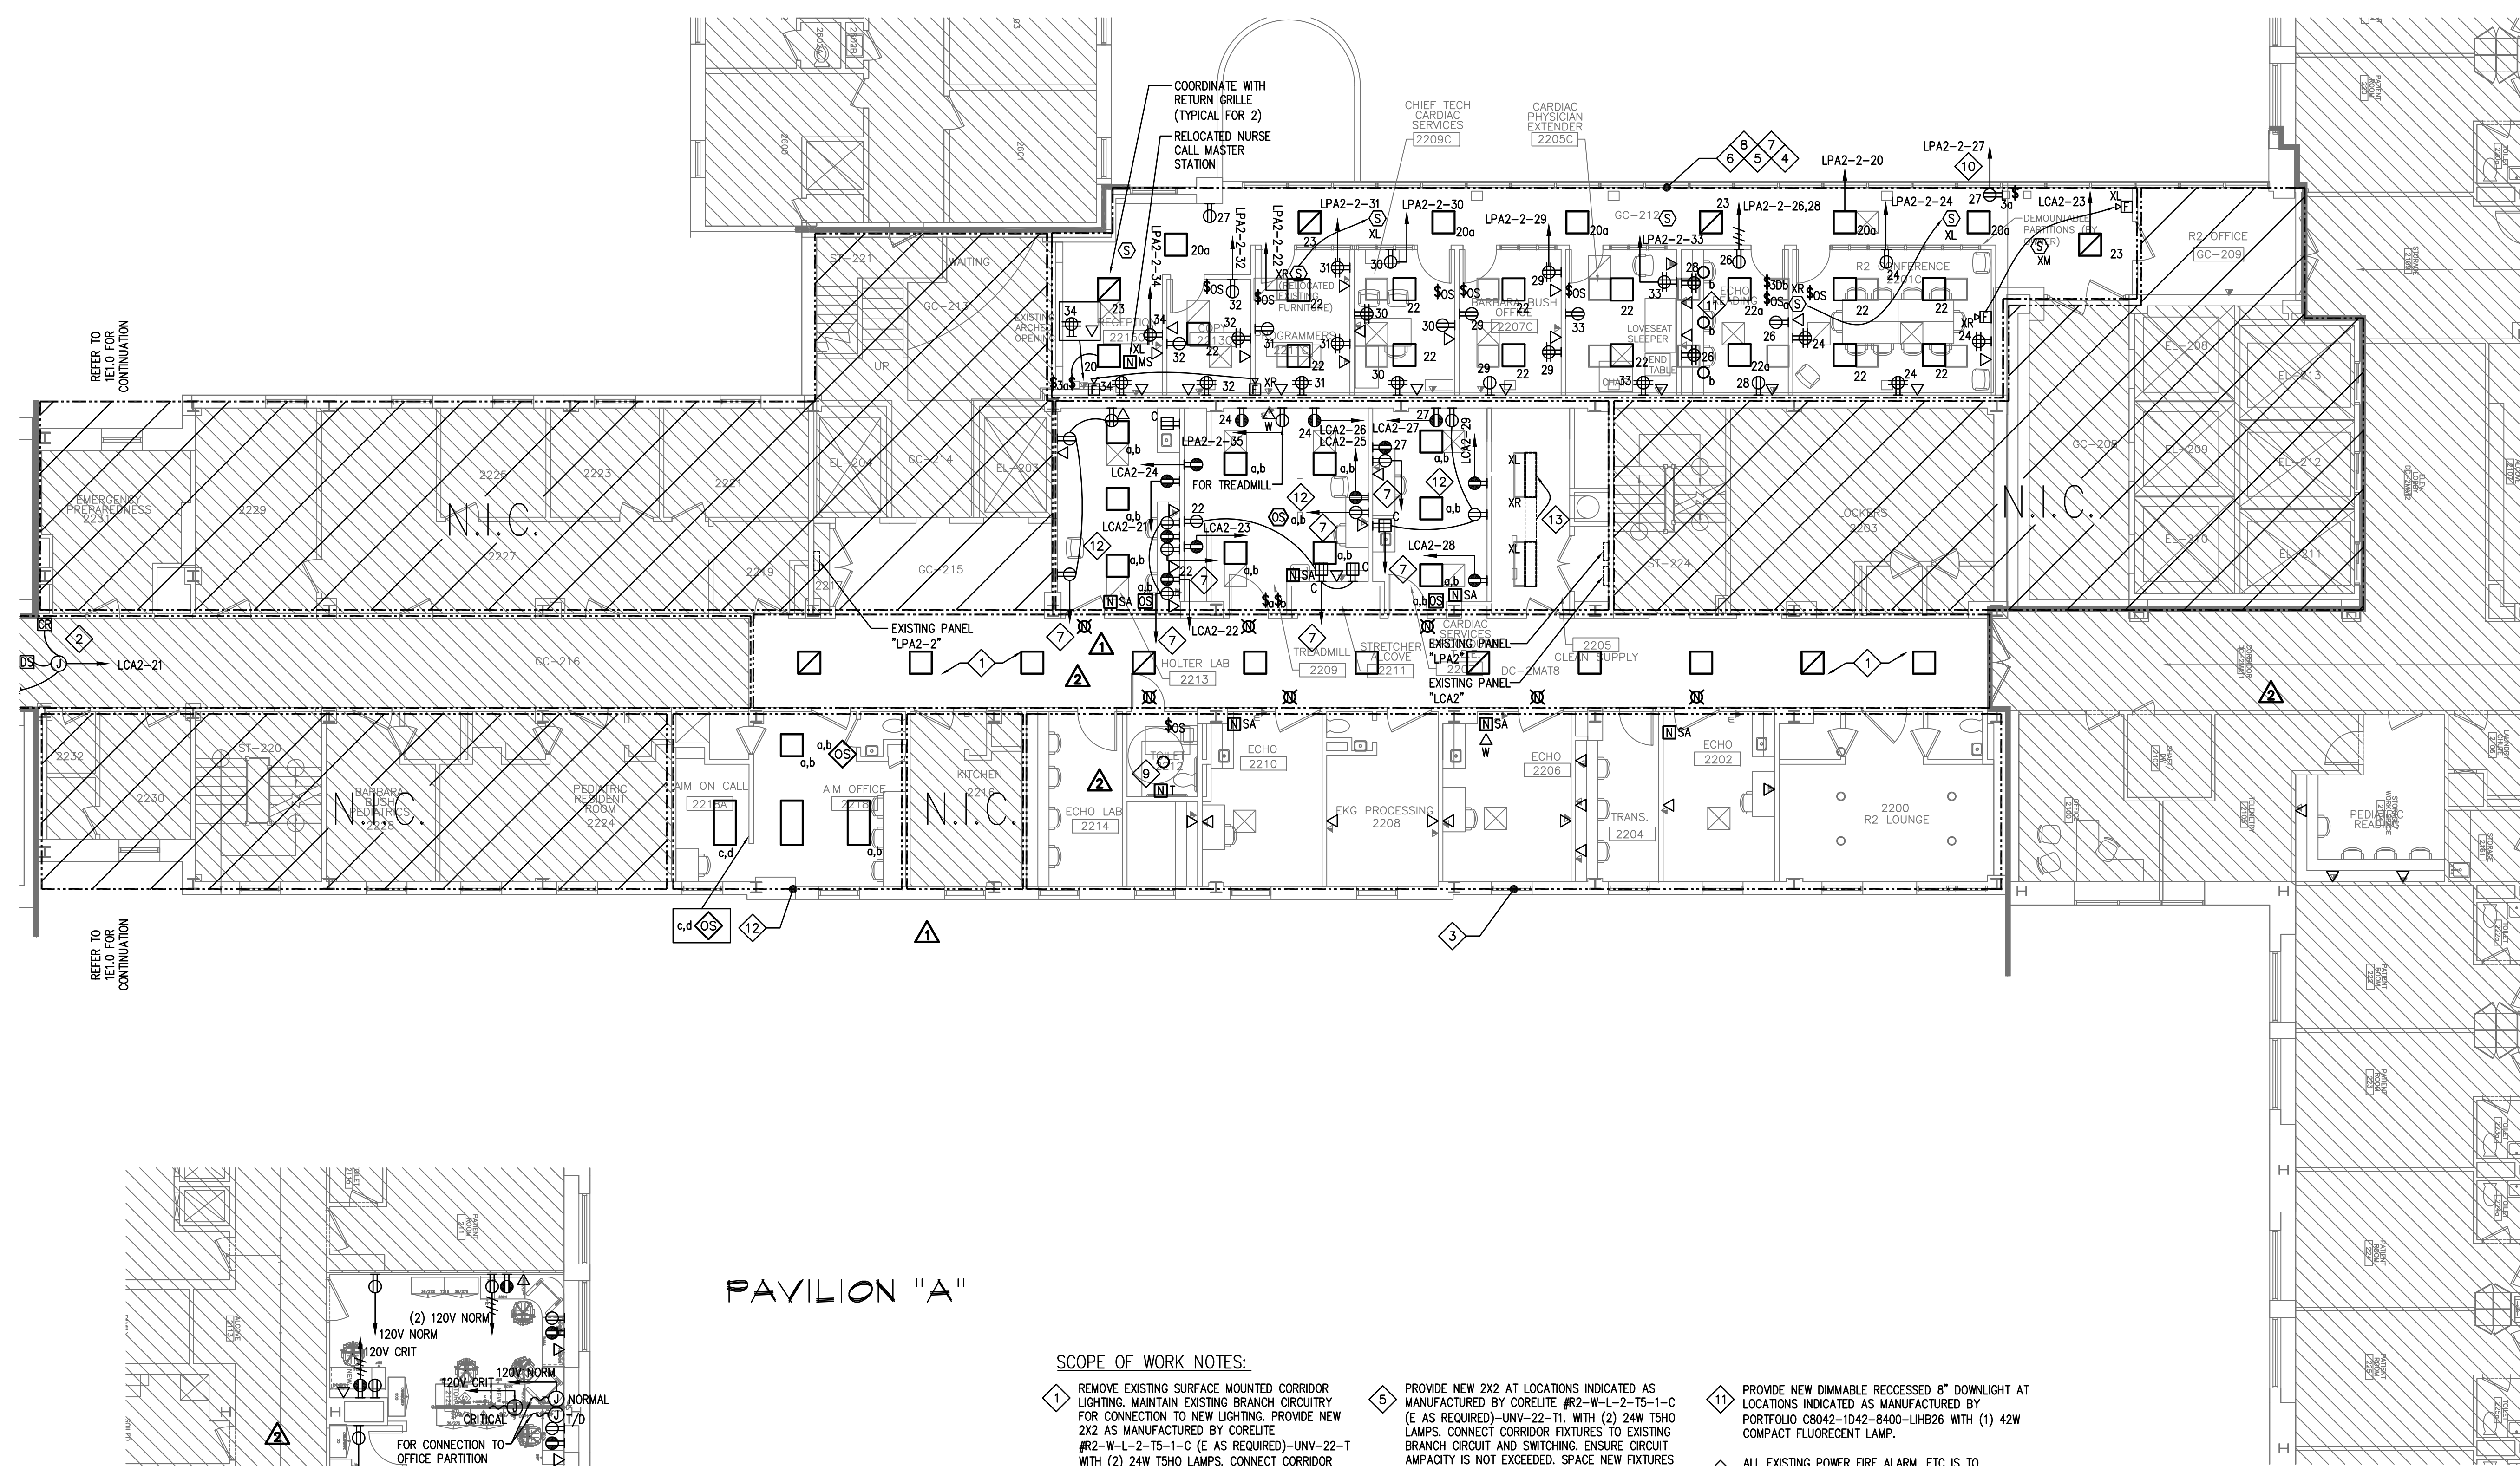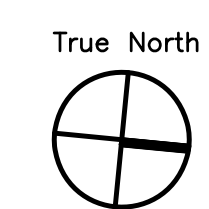


1 FIRST CALL PARTIAL PLAN
SCALE: 1/8" = 1'-0"

PAVILION "A"

SCOPE OF WORK NOTES:

- 1 REMOVE EXISTING SURFACE MOUNTED CORRIDOR LIGHTING. MAINTAIN EXISTING BRANCH CIRCUITRY FOR CONNECTION TO NEW LIGHTING. PROVIDE NEW 2X2 AS MANUFACTURED BY CORELITE #R2-W-L-2-T5-1-C (E AS REQUIRED)-UNV-22-T1. WITH (2) 24W TSHO LAMPS. CONNECT CORRIDOR FIXTURES TO EXISTING BRANCH CIRCUITRY AND SWITCHING. ENSURE CIRCUIT AMPACITY IS NOT EXCEEDED. SPACE NEW FIXTURES 10'-0" O.C.
- 2 PROVIDE NEW CARD READER, DOOR STRIKE AND JUNCTION BOX ABOVE CEILING FOR 120V WIRING. PROVIDE BRANCH CIRCUIT WIRING TO THE NEAREST 120/208, 3Ø, 4W EQUIPMENT PANEL SERVING THE AREA. CONNECT TO EXISTING 120V SPARE BREAKER OR PROVIDE NEW, MATCH EXISTING MANUFACTURER, MODEL AND A.I.C. RATING
- 3 ALL EXISTING LIGHTING, POWER, SWITCHING, FIRE ALARM, ETC IS TO REMAIN, EXCEPT AS INDICATED OTHERWISE.
- 4 REMOVE EXISTING LIGHTING, POWER AND TELEDATA DEVICES IN THIS AREA. MAINTAIN EXISTING BRANCH CIRCUITRY FOR CONNECTION TO NEW DEVICES. LIGHTING AND SWITCHING AS INDICATED
- 5 PROVIDE NEW 2X2 AT LOCATIONS INDICATED AS MANUFACTURED BY CORELITE #R2-W-L-2-T5-1-C (E AS REQUIRED)-UNV-22-T1. WITH (2) 24W TSHO LAMPS. CONNECT CORRIDOR FIXTURES TO EXISTING BRANCH CIRCUIT AND SWITCHING. ENSURE CIRCUIT AMPACITY IS NOT EXCEEDED. SPACE NEW FIXTURES 10'-0" O.C.
- 6 CONNECT NEW FIRE ALARM DEVICES TO EXISTING LOOP SERVING THE AREA. PROVIDE ALL NECESSARY WIRING AND APPURTENANCES FOR A COMPLETE INSTALLATION
- 7 CONNECT NEW POWER DEVICES TO EXISTING MAINTAINED BRANCH CIRCUITRY OR PROVIDE NEW WIRING CONNECTED TO EXISTING SPARE 20A-1P BREAKER IN EXISTING NORMAL PANEL SERVING THE AREA.
- 8 CONNECT NEW TELEDATA DEVICES TO EXISTING MAINTAINED BRANCH CIRCUITRY
- 9 REPLACE EXISTING PATIENT SHOWER LIGHTING FIXTURE WITH NEW 8" RECESSED FLUORESCENT LENSED SHOWER LIGHT AS MANUFACTURED BY KIRLIN #VRR-08013-94 (FINISH)-LE (42W) WITH (1) 42 WATT CFO42W LAMPS (48 INPUT WATTS)
- 10 CONNECT TO EXISTING 120V SPARE BREAKER OR PROVIDE NEW, MATCH EXISTING MANUFACTURER, MODEL AND A.I.C. RATING
- 11 PROVIDE NEW DIMMABLE RECESSED 8" DOWNLIGHT AT LOCATIONS INDICATED AS MANUFACTURED BY PORTFOLIO CB042-1042-8400-LHB26 WITH (1) 42W COMPACT FLUORESCENT LAMP.
- 12 ALL EXISTING POWER FIRE ALARM, ETC IS TO REMAIN, EXCEPT AS INDICATED OTHERWISE. REMOVE EXISTING LIGHTING AND STORE FOR RE-USE ELSEWHERE IN THIS SCOPE OF WORK. PROVIDE (1) NEW 2X2 AT LOCATION INDICATED AS MANUFACTURED BY CORELITE #R2-W-L-3-T5-1-C (E AS REQUIRED)-UNV-22-T1. WITH (3) 24W TSHO LAMPS AND (1) 1-LAMP AND (1) 2-LAMP BALLAST FOR DUAL LEVEL SWITCHING AND (3) NEW 2X4 AT LOCATION INDICATED AS MANUFACTURED BY CORELITE #R2-W-L-3-T5-1-C (E AS REQUIRED)-UNV-24-T1. WITH (3) 54W TSHO LAMPS AND (1) 1-LAMP AND (1) 2-LAMP BALLAST FOR DUAL LEVEL SWITCHING. CONNECT NEW FIXTURES TO EXISTING BRANCH CIRCUIT SERVING THE AREA AND NEW SWITCHING AS INDICATED. ENSURE CIRCUIT AMPACITY IS NOT EXCEEDED.
- 13 ALL EXISTING POWER FIRE ALARM, ETC IS TO REMAIN, EXCEPT AS INDICATED OTHERWISE. RELOCATE EXISTING LIGHTING AND PROVIDE A RELOCATED FIXTURE MAINTAINED FROM DEMOLITION PHASES. CLEAN, RE-LAMP AND RE-BALLAST AND MOUNT AS INDICATED CONNECT TO EXISTING CIRCUIT AND SWITCHING SERVING THE AREA. ENSURE CIRCUIT AMPACITY IS NOT EXCEEDED.

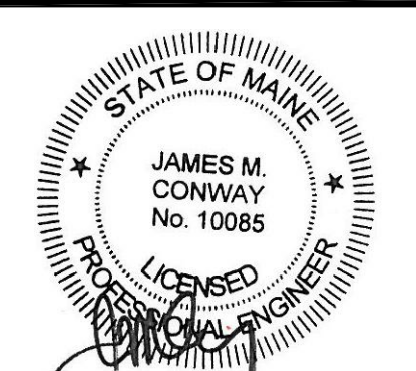


Seals

BECKER
structural engineers, inc.


75 York Street Portland, ME 04101-4701
Tel 207-879-1838 Fax 207-879-1822
info@beckerstructural.com www.beckerstructural.com

Consultant

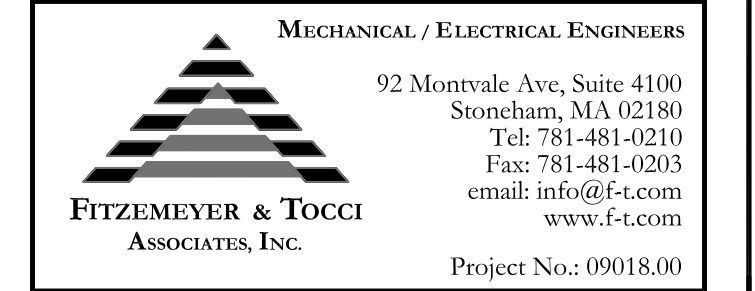

92 Montvale Ave, Suite 4100
Saco, ME 04158
Tel: 781-481-0210
Fax: 781-481-0203
email: info@f-t.com
www.f-t.com
Project No: 19018.00

Consultant

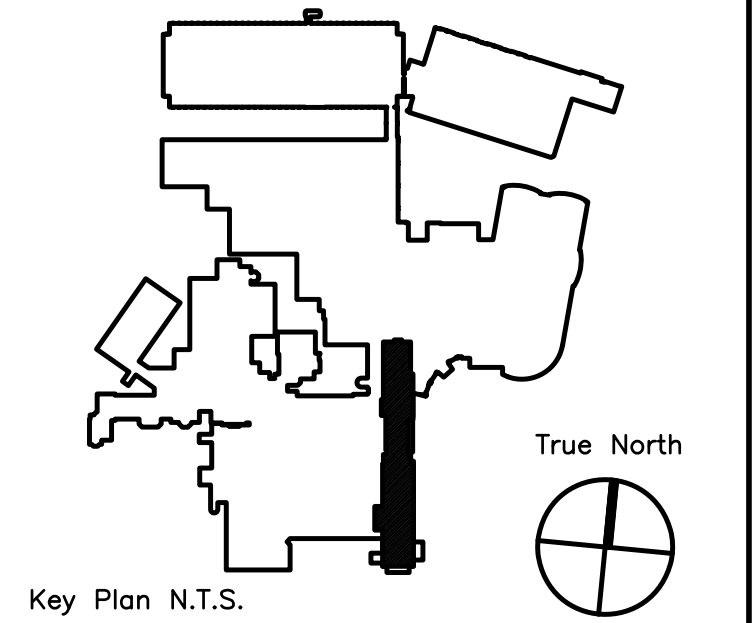

Key Plan N.T.S.

ADDENDUM#1	12/4/09	1
Revision	Date	No



MAINE MEDICAL CENTER
PAVILION 6 RENOVATIONS

MorrisSwitzer Project Number 28034
Date 11/19/09
Scale NOT TO SCALE
Sheet Title and Number

SIXTH FLOOR PAVILIONS
"A" & "C" ELECTRICAL
LEGEND AND NOTES

3E0.0



POWER PLAN LEGEND	
	FLUSH MOUNTED PANELBOARD
	SURFACE MOUNTED PANELBOARD
	DISCONNECT SWITCH - NEMA 1 ENCLOSURE - FUSED 30A-3 POLE UNLESS OTHERWISE NOTED
	60AS - DENOTES SWITCH AMPERAGE RATING *40AF* - DENOTES FUSE AMPERAGE RATING *3P* - DENOTES 3-POLE *3R* - DENOTES NEMA 3R ENCLOSURE
	DISCONNECT SWITCH - NEMA 1 ENCLOSURE - UNFUSED
	MAGNETIC MOTOR STARTER
	MANUAL MOTOR STARTER WITH INTEGRAL THERMAL PROTECTION
	VARIABLE FREQUENCY DRIVE - REFER TO "MECHANICAL/ELECTRICAL/PLUMBING" COORDINATION SCHEDULE.
	ENCLOSED CIRCUIT BREAKER - NEMA 1 ENCLOSURE - AMPERAGE AND NO. OF POLES AS INDICATED. 100AE - DENOTES CIRCUIT BREAKER FRAME 60AT - DENOTES CIRCUIT BREAKER TRIP
	MOTOR
	JUNCTION BOX "ATC" INDICATES CONNECTION FOR AUTOMATIC TEMPERATURE CONTROLS "B" INDICATES JUNCTION BOX WITH BLANK COVER "EWC" INDICATES CONNECTION TO ELECTRIC WATER COOLER "MGAP" - DENOTES MEDICAL GAS ALARM PANEL (LOCAL) "MGAP" - DENOTES MASTER MEDICAL GAS ALARM PANEL "PS" INDICATES CONNECTION TO MOTORIZED PROJECTION SCREEN "TD" INDICATES CONNECTION TO MOTORIZED DAMPER
	DRY TYPE TRANSFORMER
	PULL BOX
	EMERGENCY TRANSFER DEVICE

WIRING DEVICE LEGEND	
	DUPEX RECEPTACLE NEMA 5-20R NORMAL BRANCH CIRCUIT
	DOUBLE DUPEX RECEPTACLE NEMA 5-20R NORMAL BRANCH CIRCUIT
	DUPEX RECEPTACLE NEMA 5-20R EMERGENCY BRANCH CIRCUIT
	DOUBLE DUPEX RECEPTACLE NEMA 5-20R EMERGENCY CRITICAL BRANCH CIRCUIT
	DUPEX RECEPTACLE GF1 TYPE NEMA 5-20R NORMAL BRANCH CIRCUIT
	DUPEX RECEPTACLE GF1 TYPE NEMA 5-20R EMERGENCY BRANCH CIRCUIT
	SPECIAL PURPOSE RECEPTACLE NEMA TYPE AS INDICATED ON THE PLANS

WIRING METHODS LEGEND	
	FLEXIBLE RACEWAY
	HOMERUN TO PANELBOARD "LS43A"; BRANCH CIRCUIT No. 5; NO SLASH LINES INDICATE 2#12 & 1#12G, 3/4" C. UNLESS OTHERWISE NOTED; MINIMUM SIZE CONDUCTOR #12 AWG/ MINIMUM SIZE CONDUIT 3/4".
	HOMERUN TO PANELBOARD "LP1"; BRANCH CIRCUIT No. 1 AND 3; SLASH LINES INDICATE 4#12 & 1#12G, 3/4" C. UNLESS OTHERWISE NOTED; REQUIRED GROUND CONDUCTORS ARE NOT INDICATED; MINIMUM SIZE CONDUCTOR #12 AWG/ MINIMUM SIZE CONDUIT 3/4".

WIRING METHODS	
REFER TO SPECIFICATIONS FOR ADDITIONAL INFORMATION	
NORMAL SYSTEM FEEDERS	THHN/THWN/XHHW CONDUCTORS IN EMT
NORMAL BRANCH CIRCUITS	THHN/THWN/XHHW CONDUCTORS IN EMT OR HOSPITAL GRADE AC CABLE
EMERGENCY SYSTEM (LIFE SAFETY AND CRITICAL) BRANCH CIRCUITS	THHN/THWN/XHHW CONDUCTORS IN EMT
NURSE CALL SYSTEM WIRING	CONDUCTORS IN EMT
FIRE ALARM SYSTEM WIRING	CONDUCTORS IN EMT

LIGHTING PLAN LEGEND	
	LIGHTING FIXTURE AS DESIGNATED ON LIGHTING FIXTURE SCHEDULE
	"1" - DENOTES PANELBOARD BRANCH CIRCUIT NUMBER "o" - DENOTES FIXTURE CONTROLLED BY LOCAL SWITCH "o" "FR" - DENOTES FIXTURE TYPE AS NOTED ON FIXTURE SCHEDULE.
	- DENOTES LIGHT FIXTURE ON LIFE SAFETY BRANCH CIRCUIT, CONSTANT ON UN-SWITCHED (NIGHT LIGHT)
	- DENOTES LIGHT FIXTURE WITH BODINE EMERGENCY BALLAST
	- DENOTES LIGHT FIXTURE ON CRITICAL BRANCH CIRCUIT
	EXIT SIGN - SHADED AREA INDICATES LOCATION AND QUANTITY OF FACES; DIRECTIONAL ARROWS AS INDICATED

SWITCHES LEGEND	
	LOCAL SWITCH, SINGLE POLE "o" - DENOTES LIGHT FIXTURE CONTROL
	LOCAL SWITCH, 3-WAY, SINGLE POLE DOUBLE THROW
	LOCAL SWITCH, 4-WAY, DOUBLE POLE, DOUBLE THROW
	DIMMER SWITCH, SINGLE POLE (FLUORESCENT OR INCANDESCENT DIMMER AS REQUIRED REFER TO FLOOR PLANS FOR EXACT APPLICATION)
	OCCUPANCY SENSOR - WALL MOUNTED INTEGRAL, DUAL TECHNOLOGY, SINGLE POLE SWITCH, MOUNT 48" AFF UNLESS NOTED OTHERWISE. AS MANUFACTURED BY SENSOR SWITCH CATALOG # WSD-PDT OR WAITSTOPPER CATALOG # DW-100
	OCCUPANCY SENSOR - WALL MOUNTED INTEGRAL, DUAL TECHNOLOGY, DUAL RELAY SWITCH, MOUNT 48" AFF UNLESS NOTED OTHERWISE. AS MANUFACTURED BY SENSOR SWITCH CATALOG # WSD-PDT-2P
	OCCUPANCY SENSOR - WALL MOUNTED INTEGRAL, DUAL TECHNOLOGY, DUAL RELAY SWITCH, WITH INTEGRAL PHOTOCELL, MOUNT 48" AFF UNLESS NOTED OTHERWISE. AS MANUFACTURED BY SENSOR SWITCH CATALOG # WSD-PDT-2P-P
	OCCUPANCY SENSOR, CEILING MOUNTED, DUAL TECHNOLOGY, DUAL RELAY SWITCH, AS MANUFACTURED BY SENSOR SWITCH CATALOG # CMR-PDT(-2P 2-POLE AS REQUIRED)
	OCCUPANCY SENSOR, CEILING MOUNTED, DUAL TECHNOLOGY, DUAL RELAY SWITCH WITH INTEGRAL PHOTOCELL, AS MANUFACTURED BY SENSOR SWITCH CATALOG # CMR-10-PDT-2P-P
	BRACKET INDICATES GANGED SWITCHES AT LOCATION INDICATED
	TOGGLE SWITCH TYPE LOW VOLTAGE MOMENTARY CONTACT CONTROL SWITCH

FIRE ALARM SYSTEM LEGEND	
	FIRE ALARM CONTROL PANEL
	FIRE ALARM TERMINAL BOX
	FIRE ALARM ADA COMPATIBLE MANUAL PULL STATION
	TAMPERPROOF FIRE ALARM ADA COMPATIBLE, WALL MOUNTED SPEAKER/STROBE COMBINATION UNIT 900B OUTPUT, ADJUSTABLE CANDELA RATING, FACTORY SET AT 75cd, UNLESS NOTED OTHERWISE, AS MANUFACTURED BY COOPER-WHEELOCK "C" - DENOTES CEILING MOUNTED DEVICE WITH 360° LENS
	TAMPERPROOF FIRE ALARM ADA COMPATIBLE, WALL MOUNTED STROBE UNIT ADJUSTABLE CANDELA RATING, FACTORY SET AT 15cd, AS MANUFACTURED BY COOPER-WHEELOCK
	FIRE ALARM SMOKE DETECTOR, CEILING MOUNTED UNLESS NOTED OTHERWISE. "D" - DENOTES DUCT SMOKE DETECTOR "HT" - DENOTES SMOKE/ HEAT DETECTOR COMBINATION UNIT "S" - DENOTES SINGLE STATION SMOKE DETECTOR WITH INTEGRAL AUDIBLE SIGNALS
	FIRE ALARM REMOTE LED INDICATOR
	FIRE ALARM REMOTE TEST STATION
	FIRE ALARM HEAT DETECTOR; CEILING MOUNTED, 135° FIXED TEMPERATURE UNLESS NOTED OTHERWISE.
	FIRE ALARM CONTROL MODULE
	FIRE ALARM MONITORING MODULE
	FIRE ALARM ELECTRO-MAGNETIC DOOR HOLDER
	"TP" - DENOTES TAMPERPROOF DEVICE, SCREWS

ONE-LINE DIAGRAM LEGEND	
	PANELBOARD "CR43A1"
	DRY-TYPE TRANSFORMER "45KVA" - DENOTES TRANSFORMER RATING "K-13" - DENOTES K RATING OF TRANSFORMER
	GROUND CONNECTION

PROJECT GENERAL NOTES	
1. THIS IS A STANDARD SYMBOL LIST. ALL DEVICE SYMBOLS AND ABBREVIATIONS MAY NOT NECESSARILY APPEAR ON THE FLOOR PLANS OR DETAIL SHEET. ONLY THOSE SYMBOLS INDICATED ON THE FLOOR PLANS ARE USED AND OTHERS SHOULD BE DISREGARDED.	
2. THE CONTRACTOR SHALL FURNISH LABOR, MATERIALS, TOOLS AND OTHER EQUIPMENT REQUIRED TO INSTALL THE WORK SHOWN AND SPECIFIED. THE CONTRACTOR SHALL FURNISH AND INSTALL ITEMS NECESSARY FOR A COMPLETE ELECTRICAL SYSTEM. MATERIALS SHALL BE NEW AND SHALL BEAR THE REGISTERED UL MARK. WORK SHALL CONFORM WITH THE NATIONAL FIRE PROTECTION ASSOCIATION STANDARD 70 (NEC), THE NATIONAL ELECTRICAL CODE (NEC), AND APPLICABLE FEDERAL, STATE AND LOCAL CODES. CONTRACTOR SHALL SECURE PERMITS AND PAY THE FEES REQUIRED TO CARRY OUT HIS WORK. THE CONTRACTOR SHALL FURNISH COPIES OF CERTIFICATES AND PERMITS TO THE ARCHITECT.	
3. THE DRAWINGS AND SPECIFICATIONS INDICATE THE INTENT OF THE DESIGN AND SHALL BE CONSIDERED AS DIAGRAMMATIC ONLY. EXACT LOCATIONS FOR OUTLETS AND EQUIPMENT SHALL BE DETERMINED AT THE SITE AS WORK PROGRESSES. DIMENSIONS AND CONDITIONS SHALL BE CHECKED AND VERIFIED BY THE CONTRACTOR AT THE SITE. FINAL WORK SHALL BE DOCUMENTED ON AS BUILT RECORD DRAWINGS.	
4. PIPING, CONDUITS AND EQUIPMENT OF ALL TRADES SHALL BE PROPERLY COORDINATED AND SET TO MAINTAIN THE CLEARANCES REQUIRED BY APPLICABLE FEDERAL, STATE AND LOCAL CODES.	
5. CONDUIT RUNS CROSSING EXPANSION JOINTS SHALL HAVE EXPANSION OR EXPANSION DEFLECTION TYPE FITTINGS AS REQUIRED. VERIFY EXISTING JOINTS BY FIELD MEASUREMENTS.	
6. OUTDOOR ELECTRICAL EQUIPMENT SHALL BE NEMA 3R TYPE, UNLESS OTHERWISE NOTED. EXTERIOR RECEPTACLES SHALL BE MOUNTED AT 24" A.F.G. (MINIMUM) UNLESS OTHERWISE NOTED.	
7. RACEWAYS AND CABLE SHALL BE RUN CONCEALED IN FINISHED SPACES UNLESS OTHERWISE NOTED.	
8. PANELBOARDS AND SWITCHBOARDS SHALL BE PROVIDED WITH DEDICATED SPACE EXTENDING FROM FLOOR TO THE STRUCTURAL CEILING WITH A WIDTH AND DEPTH THAT OF THE EQUIPMENT, INCLUDING ANY ADDITIONAL SPACE DESCRIBED IN OF THE NEC. NO PIPING, DUCTS OR EQUIPMENT FORM TO THE ELECTRICAL EQUIPMENT OR ARCHITECTURAL APPURTENANCES SHALL BE PERMITTED TO BE INSTALLED IN, ENTER OR PASS THROUGH SUCH SPACE.	
9. WIRING DEVICES SHALL BE MOUNTED IN ACCORDANCE WITH THE LATEST REQUIREMENTS OF THE ARCHITECTURAL BARRIERS BOARD.	
10. PANELBOARD SHALL BE MOUNTED SO THAT THE DISTANCE FROM THE TOP CIRCUIT BREAKER OPERATING HANDLE TO THE FLOOR SHALL NOT EXCEED 6'-6".	
11. ALL RECEPTACLES INSTALLED IN UNFINISHED AREAS SHALL BE GF1 TYPE, MOUNTED 4'-0" ABOVE FINISHED FLOOR.	
12. EXIT SIGNS AND EMERGENCY LIGHTING UNITS SHALL BE UNSWITCHED.	
13. ALL BRANCH CIRCUITS (LIGHTING AND POWER) SHALL HAVE A DEDICATED NEUTRAL CONDUCTOR. COMMON NEUTRALS WILL NOT BE ALLOWED.	
14. RECEPTACLES, SWITCHES, LIGHTING FIXTURES, SMOKE DETECTORS, ETC. INDICATE QUANTITY, EXACT LOCATIONS OF DEVICES SHALL BE DETERMINED IN THE FIELD AND COORDINATE WITH ARCHITECTURAL DRAWINGS.	
15. MOUNTING HEIGHTS SHALL BE AS INDICATED ON MOUNTING HEIGHT DETAIL.	
16. CONTRACTOR SHALL VERIFY ALL DOORS SWINGS BEFORE INSTALLING SWITCH BOXES.	
17. FOR EXACT LOCATION OF LIGHTING FIXTURES SEE REFLECTED CEILING PLAN DRAWINGS. FOR MOUNTING HEIGHT OF UNDER-COUNTER LIGHTING FIXTURES AND OTHER TASK LIGHTING, REFER TO ARCHITECTURAL ELEVATION DRAWINGS.	
18. ELECTRICAL CONTRACTOR IS TO COORDINATE THE EXACT LOCATION OF LIGHTING FIXTURES IN MECHANICAL AND STORAGE AREAS WITH OTHER TRADES.	
19. FOR EXACT LOCATION OF MECHANICAL EQUIPMENT (AC UNITS, FANS, PUMPS, ETC.) REFER TO RESPECTIVE TRADES DRAWINGS. FOR ELECTRICAL INFORMATION, REFER TO EMT COORDINATION SCHEDULE.	
20. CURRENT CARRYING MATERIAL USED SHALL BE COPPER, INCLUDING PANELBOARD BUS MATERIALS AND TRANSFORMER WINDINGS.	
21. FURNISH GROUNDING/ BONDING BUSHINGS ONTO ALL CONDUIT ENTERING/ LEAVING BOXES.	
22. ALL GROUND CONDUCTORS SHALL BE GREEN, ISOLATED GROUND CONDUCTORS SHALL BE GREEN/ YELLOW STRIPPED, AND NEUTRAL CONDUCTORS SHALL BE WHITE.	
23. UNLESS NOTED OTHERWISE, ALL DATA AND TELEPHONE CABLING IS BY THIS CONTRACTOR. ELECTRICAL DRAWINGS INDICATE TEL/DATA OUTLET DEVICES AND WIRING. COORDINATE DEVICE COLOR AND LABELING WITH OWNER/HOSPITAL PRIOR TO INSTALLATION.	
24. UNLESS NOTED OTHERWISE, ALL SECURITY DEVICES AND CABLING IS BY OTHERS. ELECTRICAL DRAWINGS PROVIDE RACEWAY SYSTEMS ONLY AND INDICATE SECURITY OUTLET CONFIGURATIONS FOR REFERENCE ONLY. TERMINATE SECURITY RACEWAYS WITHIN 6" OF CABLE TRAY.	
25. NO HORIZONTAL RUNS OF CABLING ALLOWED IN WALLS.	

COMMUNICATIONS LEGEND	
	INFORMATION TECHNOLOGY (IT) OUTLET DEVICE WITH 4 PORT MODULAR FACE PLATE AND 4 CAT 5 CABLES - MOUNTED 18" AFF, UNLESS NOTED OTHERWISE. "C" - DENOTES MOUNTED 6" ABOVE WORK SURFACE "H" - DENOTES MOUNTED HIGH ON WALL COORDINATE HEIGHT WITH ARCHITECT "W" - DENOTES MOUNTED 5'-0" AFF
	CEILING MOUNTED INFORMATION TECHNOLOGY OUTLET DEVICE WITH 4 PORT MODULAR FACE PLATE AND 4 CAT6 CABLES
	FLOOR BOX - INFORMATION TECHNOLOGY (IT) OUTLET DEVICE WITH 4 PORT MODULAR FACE PLATE AND 4 CAT6 CABLES
	FLOOR MOUNTED TWO GANG DEVICE WITH NEMA 5-20R DUPEX RECEPTACLE WITH 4 PORT MODULAR FACE PLATE. BASE WORK FOR FLOOR BOXES ENTAILS A POKE-THRU WITH A CONDUIT AND WIRING EACH FOR POWER AND TELEDATA FROM THE POKE-THRU LOCATION ALONG THE UNDERSIDE OF SLAB ON THE FLOOR BELOW OVER TO THE CLOSEST WALL IN THIS SCOPE OF WORK CORE BACK UP THROUGH THE SLAB UP INTO THE WALL CAVITY AND TERMINATING WITH 90 DEGREE BEND POINTING TOWARDS THE TELEDATA RACK AND A BELL END BUSHING FOR THE TELEDATA WIRING AND THE CONDUIT FOR THE POWER SHALL CONTINUE ON TO THE ASSOCIATED PANEL'S LOCATION. "P1" - DENOTES 2 HOUR FIRE RATED POKE-THROUGH
	TYPICAL WIRING DESIGNATIONS: 1/3 - DENOTES 1 COAX CABLE AND 3 CAT6 CABLES
	3/4" THICK X 8'-0" HIGH X LENGTH AS INDICATED ON THE DRAWINGS PLYWOOD. PLYWOOD SHALL BE PAINTED GRAY AND MOUNTED TO WALL
	TELEVISION OUTLET - MOUNTED 18" AFF, UNLESS NOTED OTHERWISE REFER TO SPECIFICATION FOR ADDITIONAL WIRING INFORMATION.


DEMOLITION GENERAL NOTES	
1. REFER TO THE ARCHITECTURAL DRAWINGS FOR THE FULL EXTENT OF THE SCOPE OF DEMOLITION. DISCONNECT AND MAKE SAFE ALL ELECTRICAL EQUIPMENT IDENTIFIED FOR REMOVAL ON THE ARCHITECTURAL, HVAC, PLUMBING AND FIRE PROTECTION PLANS. THE ELECTRICAL SCOPE MAY EXTEND BEYOND THE AREA DEFINED BY THE ARCHITECTURAL DEMOLITION LIMITS TO FULLY COMPLY WITH THE VARIOUS REQUIREMENTS DEFINED BY THESE NOTES.	
2. THE ELECTRICAL DEMOLITION PLANS INDICATE THE GENERAL INTENT AND ARE NOT INTENDED TO SHOW ALL COMPONENTS AND ITEMS TO BE REMOVED OR RETAINED. THE ELECTRICAL CONTRACTOR SHALL VISIT THE SITE PRIOR TO SUBMISSION OF THEIR BID TO BECOME FAMILIAR WITH THE ACTUAL WORKING CONDITIONS AND EXTENT OF WORK. DEVICES AND EQUIPMENT LOCATED ON WALLS AND/OR CEILINGS DESIGNATED TO BE REMOVED SHALL BE DISCONNECTED AND MADE SAFE. THE ELECTRICAL CONTRACTOR SHALL IMMEDIATELY NOTIFY THE OWNER'S REPRESENTATIVE OF ANY UNANTICIPATED OR HIDDEN CONDITIONS ENCOUNTERED DURING DEMOLITION.	
3. THE ELECTRICAL CONTRACTOR SHALL BE RESPONSIBLE FOR THE REPAIR OF ALL SYSTEMS OR BUILDING COMPONENTS DAMAGED DURING THE EXECUTION OF THE WORK. DAMAGE SHALL INCLUDE, BUT NOT BE LIMITED TO, THE DESTRUCTION OR DISPOSAL OF ITEMS INTENDED TO REMAIN OR BE SALVAGED.	
4. THE ELECTRICAL CONTRACTOR SHALL CIRCUIT TRACE AND LABEL ALL EXISTING BRANCH CIRCUITS AND FEEDERS WITHIN OR ASSOCIATED WITH THE AREA OF DEMOLITION SCOPE PRIOR TO DE-ENERGIZING AND DISCONNECTION. ALL CIRCUITS WITHIN PANELBOARDS IDENTIFIED FOR REMOVAL SHALL BE TRACED AND LABELLED TO ENSURE THAT NO AREA OUTSIDE THE DEMOLITION SCOPE LIMIT IS AFFECTED.	
5. THE ELECTRICAL CONTRACTOR SHALL IDENTIFY ALL BRANCH CIRCUITS, FEEDERS AND SYSTEM COMPONENTS WHICH ARE TO REMAIN WITHIN THE AREA OF DEMOLITION SCOPE. THERE SHALL BE NO INTERRUPTION OF SERVICE TO ANY AREA OUTSIDE THE SCOPE LIMITS WITHOUT APPROVAL FROM THE OWNER'S REPRESENTATIVE. EXISTING EQUIPMENT TO REMAIN SHALL BE LEFT IN A CODE COMPLIANT CONDITION.	
6. THE ELECTRICAL CONTRACTOR SHALL DE-ENERGIZE AND REMOVE ALL CONDUCTORS AND RACEWAYS TO THEIR POINTS OF ORIGIN WITHIN THE AREA OF DEMOLITION SCOPE. ITEMS IDENTIFIED FOR DEMOLITION SHALL NOT BE ABANDONED IN PLACE. RACEWAYS THAT ENTER MASONRY WALLS AND FLOORS SHALL BE CUT FLUSH AT THE SURFACE FOR PATCHING BY OTHERS. ALL CIRCUIT BREAKERS ASSOCIATED WITH THE DEMOLITION SHALL BE DE-ENERGIZED AND LABELED SARE.	
7. THE ELECTRICAL CONTRACTOR SHALL TEMPORARILY SUPPORT ALL ITEMS TO REMAIN THAT ARE AFFECTED BY THE DEMOLITION OF BUILDING STRUCTURAL COMPONENTS (WALLS, CEILINGS, ETC.). TEMPORARILY SUPPORTED ITEMS SHALL BE PERMANENTLY SUPPORTED AND INSTALLED WHEN FINALIZED STRUCTURES ARE IN PLACE.	
8. ALL REMOVED ITEMS SHALL BE LEGALLY DISPOSED OF UNLESS IDENTIFIED FOR REUSE. THE OWNER'S REPRESENTATIVE SHALL INSPECT ALL RETAINED ITEMS PRIOR TO PLACEMENT IN THE IDENTIFIED STORAGE LOCATION BY THE ELECTRICAL CONTRACTOR.	
9. THE EXISTING FIRE ALARM SYSTEM SHALL REMAIN FULLY FUNCTIONAL DURING THE ENTIRE DEMOLITION AND CONSTRUCTION PERIOD. REUSE OF EXISTING FIRE ALARM RACEWAYS SHALL NOT BE ALLOWED. ALL REQUIRED SYSTEM SHUTDOWNS SHALL BE COORDINATED WITH AND APPROVED BY THE OWNER'S REPRESENTATIVE AND THE AUTHORITY HAVING JURISDICTION. DEMOLITION OF THE EXISTING SYSTEM SHALL NOT COMMENCE UNTIL THE NEW SYSTEM HAS BEEN COMPLETELY INSTALLED, TESTED AND APPROVED BY THE AUTHORITY HAVING JURISDICTION.	
10. ALL DEMOLITION SCOPE ASSOCIATED WITH LOW VOLTAGE SYSTEMS INCLUDING BUT NOT LIMITED TO TELEPHONE, DATA, SECURITY, PAGING, CCTV, ETC. SHALL BE INCLUDED IN THIS CONTRACT.	
11. REMOVED FLUORESCENT AND HID LAMPS AND BATTERIES SHALL BE RECYCLED BY A FACILITY APPROVED BY THE OWNER'S REPRESENTATIVE. A UNIFORM HAZARDOUS WASTE MANIFEST SHALL BE PREPARED FOR ALL DISPOSALS AND RETURNED WITH ALL APPLICABLE SIGNOFFS PRIOR TO APPLICATION FOR FINAL PAYMENT.	
12. ALL BALLASTS IN LIGHTING FIXTURES TO BE DISPOSED SHALL BE VERIFIED TO BE PCB FREE. ALL BALLASTS MANUFACTURED PRIOR TO 1979 AND NOT LABELED AS PCB FREE SHALL BE CONSIDERED TO CONTAIN PCBs. PROVIDE WRITTEN REPRESENTATION TO THE OWNER'S REPRESENTATIVE THAT CONFIRMS PCB FREE WASTE. WHERE PCB FREE WASTE CANNOT BE VERIFIED, BALLASTS SHALL BE RECYCLED BY A FACILITY APPROVED BY THE OWNER'S REPRESENTATIVE. WITH PCB COMPONENTS ELIMINATED BY A HIGH TEMPERATURE INCINERATION. A UNIFORM HAZARDOUS WASTE MANIFEST SHALL BE PREPARED FOR ALL DISPOSALS AND RETURNED WITH ALL APPLICABLE SIGNOFFS PRIOR TO APPLICATION FOR FINAL PAYMENT. ALL HANDLING SHALL CONFORM TO EPA REQUIREMENTS. PROVIDE BREAKOUT COST FOR THIS SCOPE.	

NURSE CALL SYSTEM LEGEND	
	NURSE CALL "T" - DENOTES TOILET/ DRESSING ROOM STATION LOCATION, WALL MOUNTED DEVICE WITH PULLCORD. "S" - DENOTES SHOWER STATION LOCATION, WALL MOUNTED DEVICE WITH PULLCORD. "PB" - DENOTES PATIENT BED STATION LOCATION "DS" - DENOTES DUTY STATION LOCATION "SA" - DENOTES NURSE CALL STAFF ASSIST STATION LOCATION "CB" - DENOTES CODE BLUE STATION LOCATION "EC" - DENOTES NURSE CALL EQUIPMENT CABINET "MSM" - DENOTES NURSE CALL MASTER STATION MASTER HEAD END LOCATION WITH HAND-SET FOR PAGING CAPABILITY "MSS" - DENOTES NURSE CALL MASTER STATION SLAVE LOCATION WITH "A" - DENOTES NURSE CALL ANNUNCIATOR STATION LOCATION "CBA" - DENOTES CODE BLUE ANNUNCIATOR LOCATION
	DOME LIGHT LOCATION - CEILING OR WALL AS DIRECTED BY ARCHITECT OR HOSPITAL PERSONNEL "CB" - DENOTES CODE BLUE DOME LIGHT "Z" - DENOTES ZONE DOME LIGHT "TP" - DENOTES TAMPERPROOF DEVICE, SCREWS

PROVIDE 3-GANG BOX WITH PLASTER RING AND AN EMPTY 3/4" C WITH PULLSTRING TO ABOVE FINISHED CEILING. TERMINATE WITH END OF CONDUIT BUSHING. NURSECALL DEVICES AND WIRING BY ELECTRICAL CONTRACTOR, COORDINATE EXACT REQUIREMENTS WITH HOSPITAL PERSONNEL.

DRAWING NOTES & DESIGNATIONS	
	KEYED DRAWING NOTE MARKER
	FEEDER AND/ OR BRANCH CIRCUIT NUMBER
	DETAIL MARKER "1" - DENOTES DETAIL NUMBER "E-1" - DENOTES DRAWING NUMBER
	HVAC EQUIPMENT MARKER "AC" - DENOTES EQUIPMENT TYPE "1" - DENOTES EQUIPMENT NUMBER
	PARTIAL PLAN TITLE MARKER
	DRAWING REVISION MARKER
	SECTION MARKER "A" - DENOTES SECTION REFERENCE

ABBREVIATIONS			
A	AMPERES	JB	JUNCTION BOX
ACT	ACOUSTICAL CEILING TILE	KAC	THOUSAND AMPERES
AF	AMPERE FRAME	KMIL	INTERRUPTING CAPACITY
AFCI	ARC-FAULT CIRCUIT INTERRUPTER	KEC	THOUSAND CIRCUIT MILS
AFF	ABOVE FINISHED FLOOR	KV	KILOVOLT
AFG	ABOVE FINISHED GRADE	KVAR	KILOVOLT AMPERES REACTIVE
AIC	AMPERE INTERRUPTING CAPACITY	KW	KILOWATT
AL	ALUMINUM	KWH	KILOWATT HOURS
ANN	ANNUNCIATOR	LTG	LIGHTING
ANSI	AMERICAN NATIONAL STANDARDS INSTITUTE	MAX	MAXIMUM
ARCH	ARCHITECT	MC	METAL CLAD CABLE
AT	AMPERE TRIP	MCB	MAIN CIRCUIT BREAKER
ATC	AUTOMATIC TEMPERATURE CONTROL	MCC	MOTOR CONTROL CENTER
ATS	AUTOMATIC TRANSFER SWITCH	MCP	MOTOR CIRCUIT PROTECTOR
AWG	AMERICAN WIRE GAUGE	MCSW	MOLDED CASE SWITCH
BLDG	BUILDING	MDP	MAIN DISTRIBUTION PANEL
BOND	BONDING JUMPER	MEC	MASSACHUSETTS ELECTRICAL CODE
BR	BRANCH	MECH	MECHANICAL
C	CONDUIT - RACEWAY	MIN	MINIMUM
CAT	CATALOG	MISC	MISCELLANEOUS
CB	CIRCUIT BREAKER	MOUNT	MOUNTED
cd	CANDELA	MV	MEDIUM VOLTAGE
CIRCUIT	CIRCUIT	MLO	MAIN LUGS ONLY
CMS	CABLE MANAGEMENT SYSTEM	N	NEUTRAL (GROUNDED CONDUCTOR)
CLG	CEILING	NA	NOT APPLICABLE
COL	COLUMN	NC	NORMALLY CLOSED
CMU	CONCRETE MASONRY UNIT	NEC	NATIONAL ELECTRICAL CODE
CT	CURRENT TRANSFORMER OR CABLE TRAY	NEMA	NATIONAL ELECTRICAL MANUFACTURERS ASSOCIATION
CJ	COPPER	NFPA	NATIONAL FIRE PROTECTION ASSOCIATION
CWS	CONDUIT WALL SEAL	NIC	NOT IN CONTRACT
DETD	DUAL ELEMENT TIME DELAY	NL	NIGHT LIGHT
DIA	DIAMETER	NO	NORMALLY OPEN
DP	DISTRIBUTION PANEL	NTS	NOT TO SCALE
DWG	DRAWING	OPDP	OVER CURRENT PROTECTION DEVICE
EA	EACH	PH	PHASE
EC	ELECTRICAL CONTRACTOR EQUIPMENT GROUND CONDUCTOR	PNL	PANEL BOARD
ECC	ELECTRICAL CONTRACTOR EQUIPMENT GROUND CONDUCTOR	PNLBD	PANEL BOARD PROVIDED UNDER OTHER SECTIONS
ELEC	ELECTRICAL	PT	POTENTIAL TRANSFORMER
ELEV	ELEVATOR	PVC	POLYVINYL CHLORIDE, SCHED 40 RNC RACEWAY UNO
EM	EMERGENCY	PWR	POWER
EMS	ENERGY MANAGEMENT SYSTEM	RSP	GALVANIZED RIGID STEEL CONDUIT
EMT	ELECTRICAL METALLIC TUBING	RMC	RIGID METAL CONDUIT
EO	ELECTRICALLY OPERATED EQUIPMENT	RNC	RIGID NON-METAL CONDUIT
EQUIP	EQUIPMENT	RSC	RIGID STEEL CONDUIT
EW	ELECTRIC WATER COOLER	SATS	STANDBY AUTOMATIC TRANSFER SWITCH
EXP	EXPLOSION PROOF	SE	SERVICE ENTRANCE
FA	FIRE ALARM	SP	SPARE
FAA	FIRE ALARM ANNUNCIATOR	SW	SWITCH
FLUOR	FLUORESCENT	SWBD	SWITCHBOARD
FMS	FACILITIES MANAGEMENT SYSTEM	SWGR	SWITCH GEAR
FT	FEET	TEL	TELEPHONE
FU	FUSE	TL	TWIST LOCK
G	GROUND	TP	TWISTED PAIR</

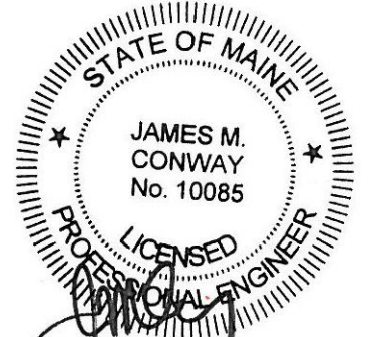


Seals

BECKER
structural engineers, inc.


75 York Street
Portland, ME 04101-4701
info@beckerstructural.com

Tel 207-879-1838
Fax 207-879-1822
www.beckerstructural.com

Consultant

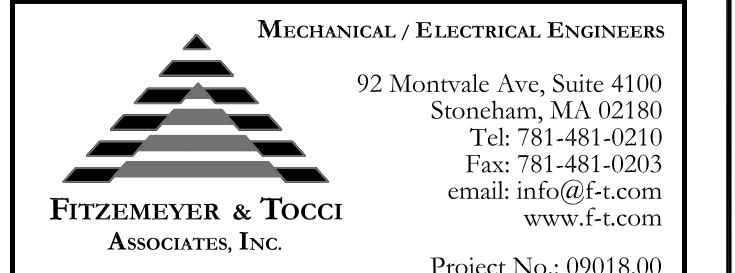

Consultant

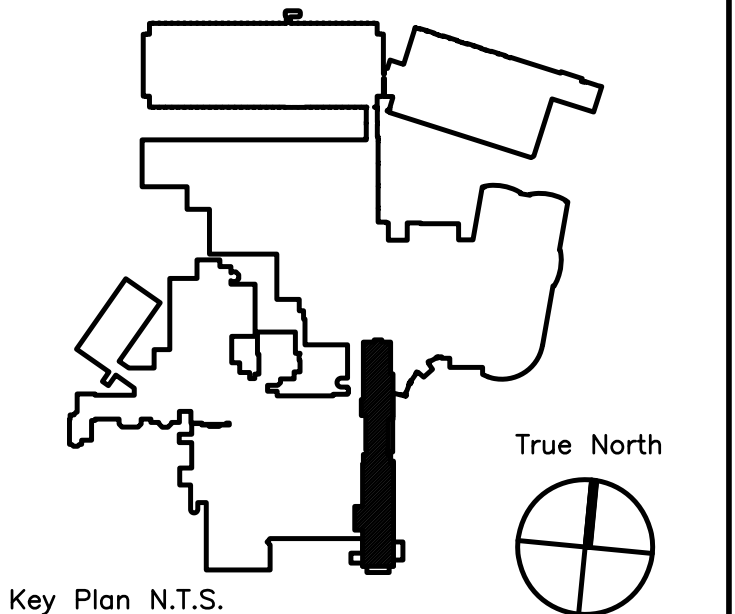

Key Plan N.T.S.

ADDENDUM#	Date	No
ADDENDUM# 1	12/4/09	1
Revision	Date	No




Maine Medical Center
Portland, Maine

MAINE MEDICAL CENTER
PAVILION 6 RENOVATIONS

MorrisSwitzer Project Number 28034
Date 11/19/09
Scale 1/8" = 1'-0"
Sheet Title and Number


SIXTH FLOOR PAVILIONS "A" & "C" ELECTRICAL DEMOLITION PLAN

3E1.0

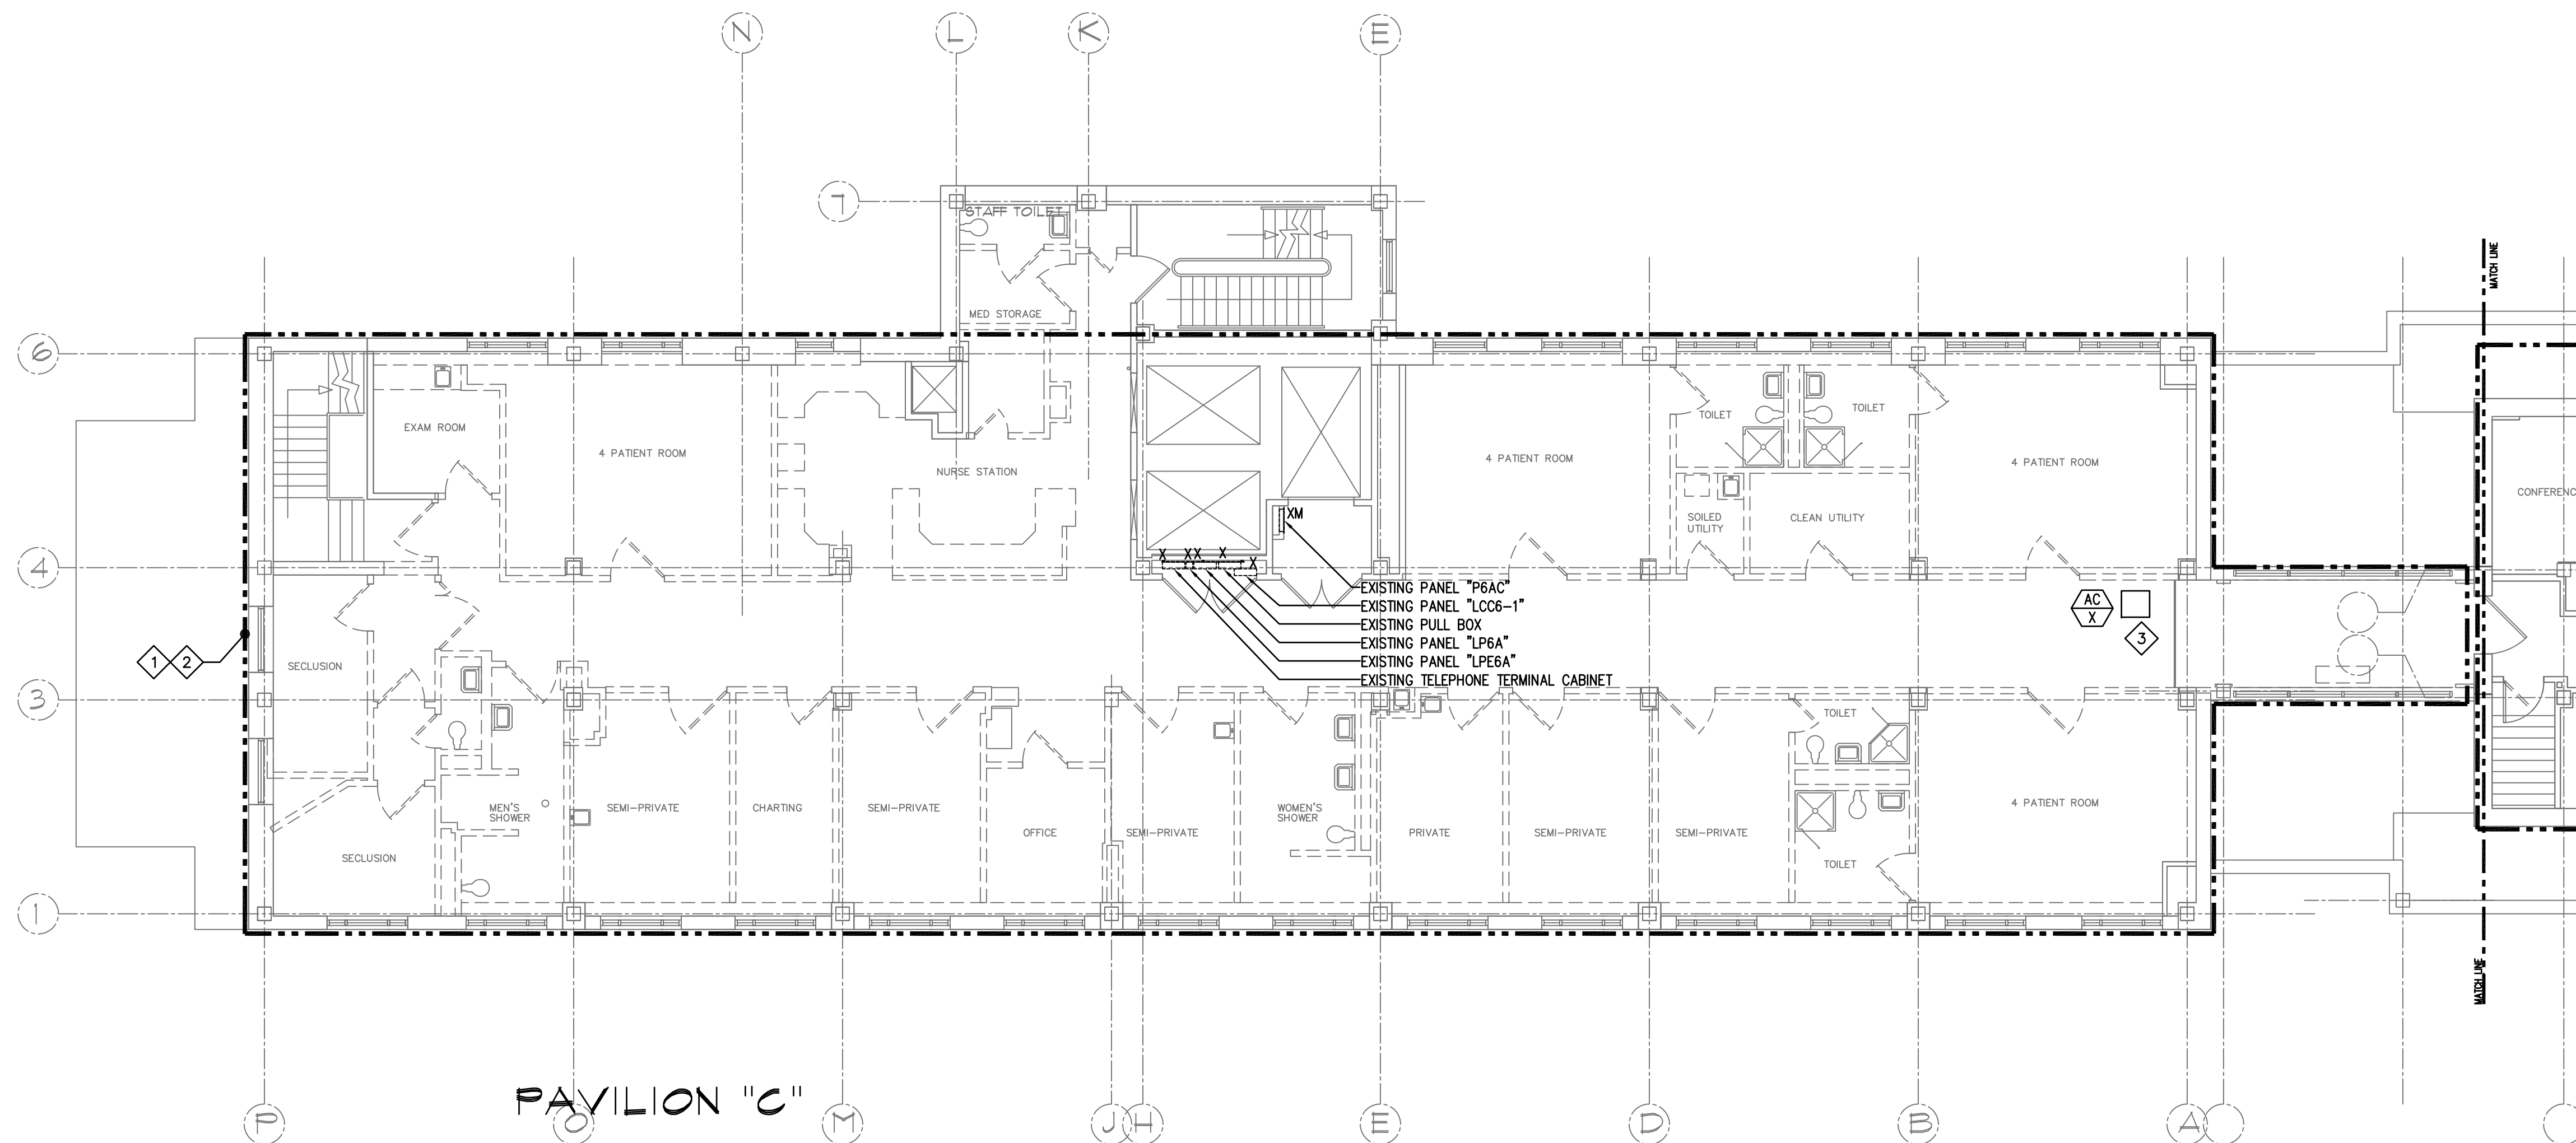



NOTES:

- 1 ALL EXISTING DEVICES, LIGHTING SWITCHING AND ASSOCIATED BRANCH CIRCUITRY IN THIS AREA ARE TO BE REMOVED AND PULLED BACK TO ITS SOURCE.
- 2 MAINTAIN EXISTING PATIENT ROOM HEAD WALL LIGHT FIXTURES FOR RE-USE IN THIS SCOPE OF WORK. (SECOND FLOOR PAVILIONS C & D INTERIM OCCUPANCY) REFER TO DRAWING 2E1.0 FOR ADDITIONAL INFORMATION.
- 3 ALL EXISTING HVAC UNIT AND ASSOCIATED BRANCH CIRCUITRY IN THIS AREA ARE TO BE REMOVED AND PULLED BACK TO ITS SOURCE.

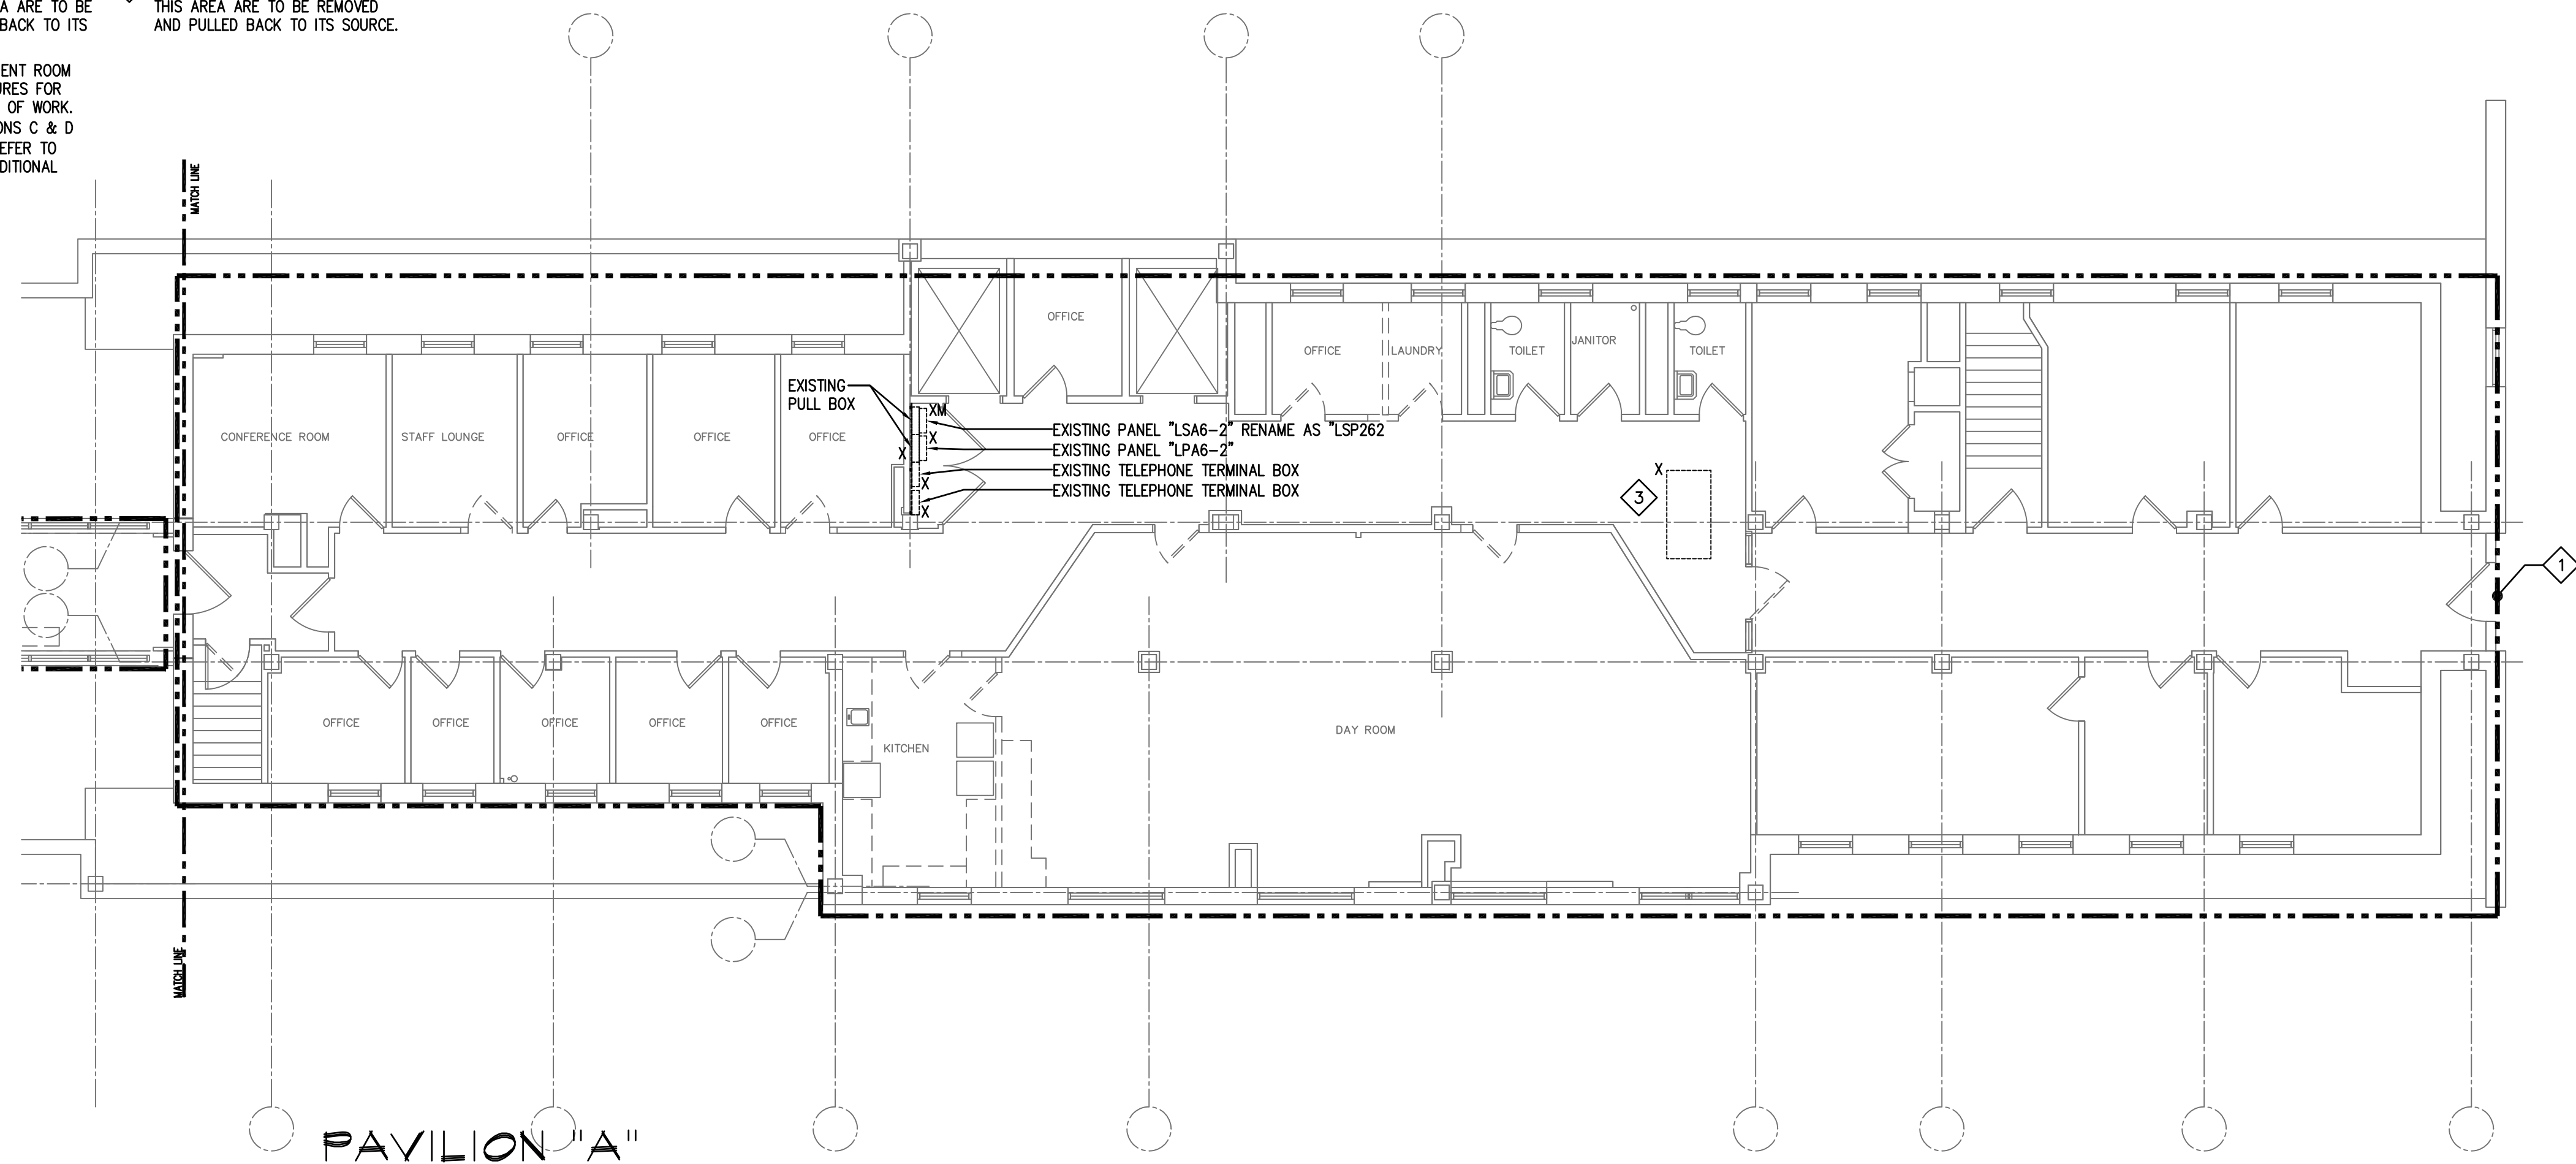

True North

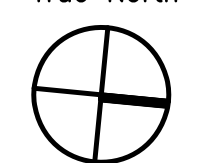

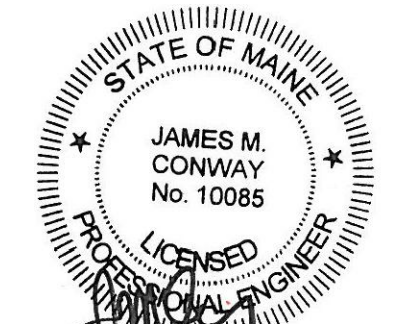


Seals


BECKER
structural engineers, inc.

75 York Street Tel 207-879-1838
Portland, ME 04101-4701 Fax 207-879-1822
info@beckerstructural.com www.beckerstructural.com

Consultant

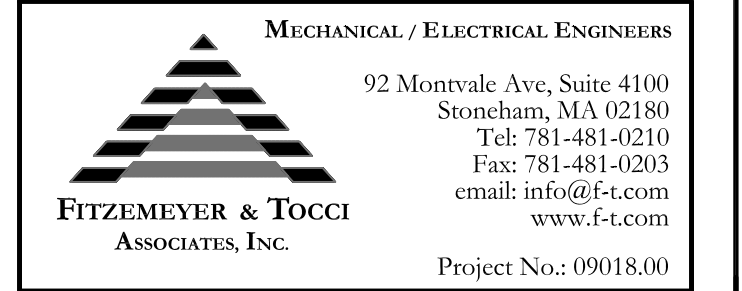

Consultant

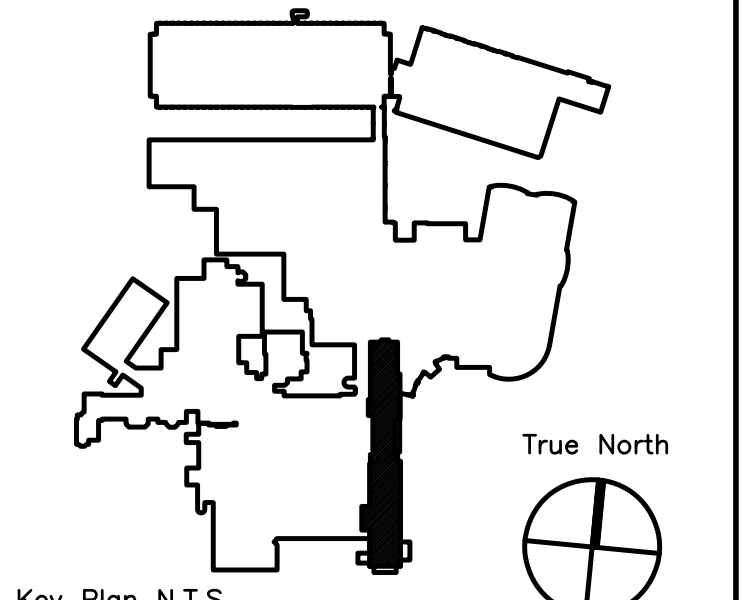

Key Plan N.T.S.

ADDENDUM#1	12/4/09	1
Revision	Date	No





MAINE MEDICAL CENTER
PAVILION 6 RENOVATIONS


MorrisSwitzer Project Number 28034
Date 11/19/09
Scale 1/8" = 1'-0"
Sheet Title and Number

SIXTH FLOOR PAVILIONS "A" & "C" ELECTRICAL LIGHTING PLAN
3E2.0


RELAY NUMBER	LOW VOLTAGE SWITCH LEG	LOAD	PANEL	BREAKER
1	a	PATIENT ROOM 670 NORMAL RECEPTACLES	PP261	26
2	b	PATIENT ROOM 670 EMERGENCY RECEPTACLES	CP261	34
3	c	PATIENT ROOM 671 NORMAL RECEPTACLES	PP261	24
4	d	PATIENT ROOM 671 EMERGENCY RECEPTACLES	CP261	32
5	e	PATIENT ROOM 672 NORMAL RECEPTACLES	PP261	22
6	f	PATIENT ROOM 672 EMERGENCY RECEPTACLES	CP261	30
7	g	PATIENT ROOM 673 NORMAL RECEPTACLES	PP261	20
8	h	PATIENT ROOM 673 EMERGENCY RECEPTACLES	CP261	28
9	i	PATIENT ROOM 674 NORMAL RECEPTACLES	PP261	18
10	k	PATIENT ROOM 674 EMERGENCY RECEPTACLES	CP261	33
11	l	PATIENT ROOM 675 NORMAL RECEPTACLES	PP261	16
12	m	PATIENT ROOM 675 EMERGENCY RECEPTACLES	CP261	31
13	n	PATIENT ROOM 676 NORMAL RECEPTACLES	PP261	14
14	p	PATIENT ROOM 676 EMERGENCY RECEPTACLES	CP261	29
15	q	PATIENT ROOM 677 NORMAL RECEPTACLES	PP261	12
16	r	PATIENT ROOM 677 EMERGENCY RECEPTACLES	CP261	27
17	u	PATIENT ROOM 681 NORMAL RECEPTACLES	PP261	8
18	u	PATIENT ROOM 681 EMERGENCY RECEPTACLES	CP261	7
19	v	PATIENT ROOM 682 NORMAL RECEPTACLES	PP261	10
20	w	PATIENT ROOM 682 EMERGENCY RECEPTACLES	CP261	9
21	x	PATIENT ROOM 683 NORMAL RECEPTACLES	PP261	4
22	y	PATIENT ROOM 683 EMERGENCY RECEPTACLES	CP261	3
23	z	PATIENT ROOM 684 NORMAL RECEPTACLES	PP261	6
24	aa	PATIENT ROOM 684 EMERGENCY RECEPTACLES	PP261	5
25	bb	PATIENT ROOM 686 NORMAL RECEPTACLES	PP261	2
26	cc	PATIENT ROOM 686 EMERGENCY RECEPTACLES	CP261	1
27	dd	1929 CORRIDOR LIGHTING	PP262	44
28	ee	1929 CORRIDOR LIGHTING	PP262	44
29	ff	1929 CORRIDOR LIGHTING	PP262	44
30	gg	1929 CORRIDOR LIGHTING	PP262	44
31	hh	SPARE		
32	jj	SPARE		
33	kk	SPARE		
34	ll	SPARE		
35	mm	SPARE		
36	nn	SPARE		
37	pp	SPARE		
38	qq	SPARE		
39	rr	SPARE		
40	tt	SPARE		
41	uu	SPARE		
42	vv	SPARE		

- DRAWING NOTES:**
- REFER TO ARCHITECTURAL REFLECTED CEILING PLANS, FLOOR PLANS AND ELEVATIONS FOR EXACT LOCATION, QUANTITIES AND MOUNTING OF ALL LIGHTING AND DEVICES
 - LIGHTING MOUNTED ON MILLWORK. COORDINATE EXACT MOUNTING WITH MILLWORK VENDOR PRIOR TO INSTALLATION. REFER TO ARCHITECTURAL FLOOR PLANS AND ELEVATIONS FOR ADDITIONAL INFORMATION
 - PROVIDE CEILING MOUNTED OCCUPANCY SENSORS WITH POWER PACK AS REQUIRED. REFER TO VENDOR WIRING DIAGRAMS FOR ADDITIONAL INFORMATION
 - ALL DEVICES, LIGHTING AND SWITCHING WITHIN PATIENT ROOMS, PATIENT ROOM TOILETS, PUBLIC TOILETS, ETC SHALL BE TAMPER PROOF

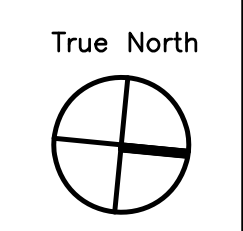
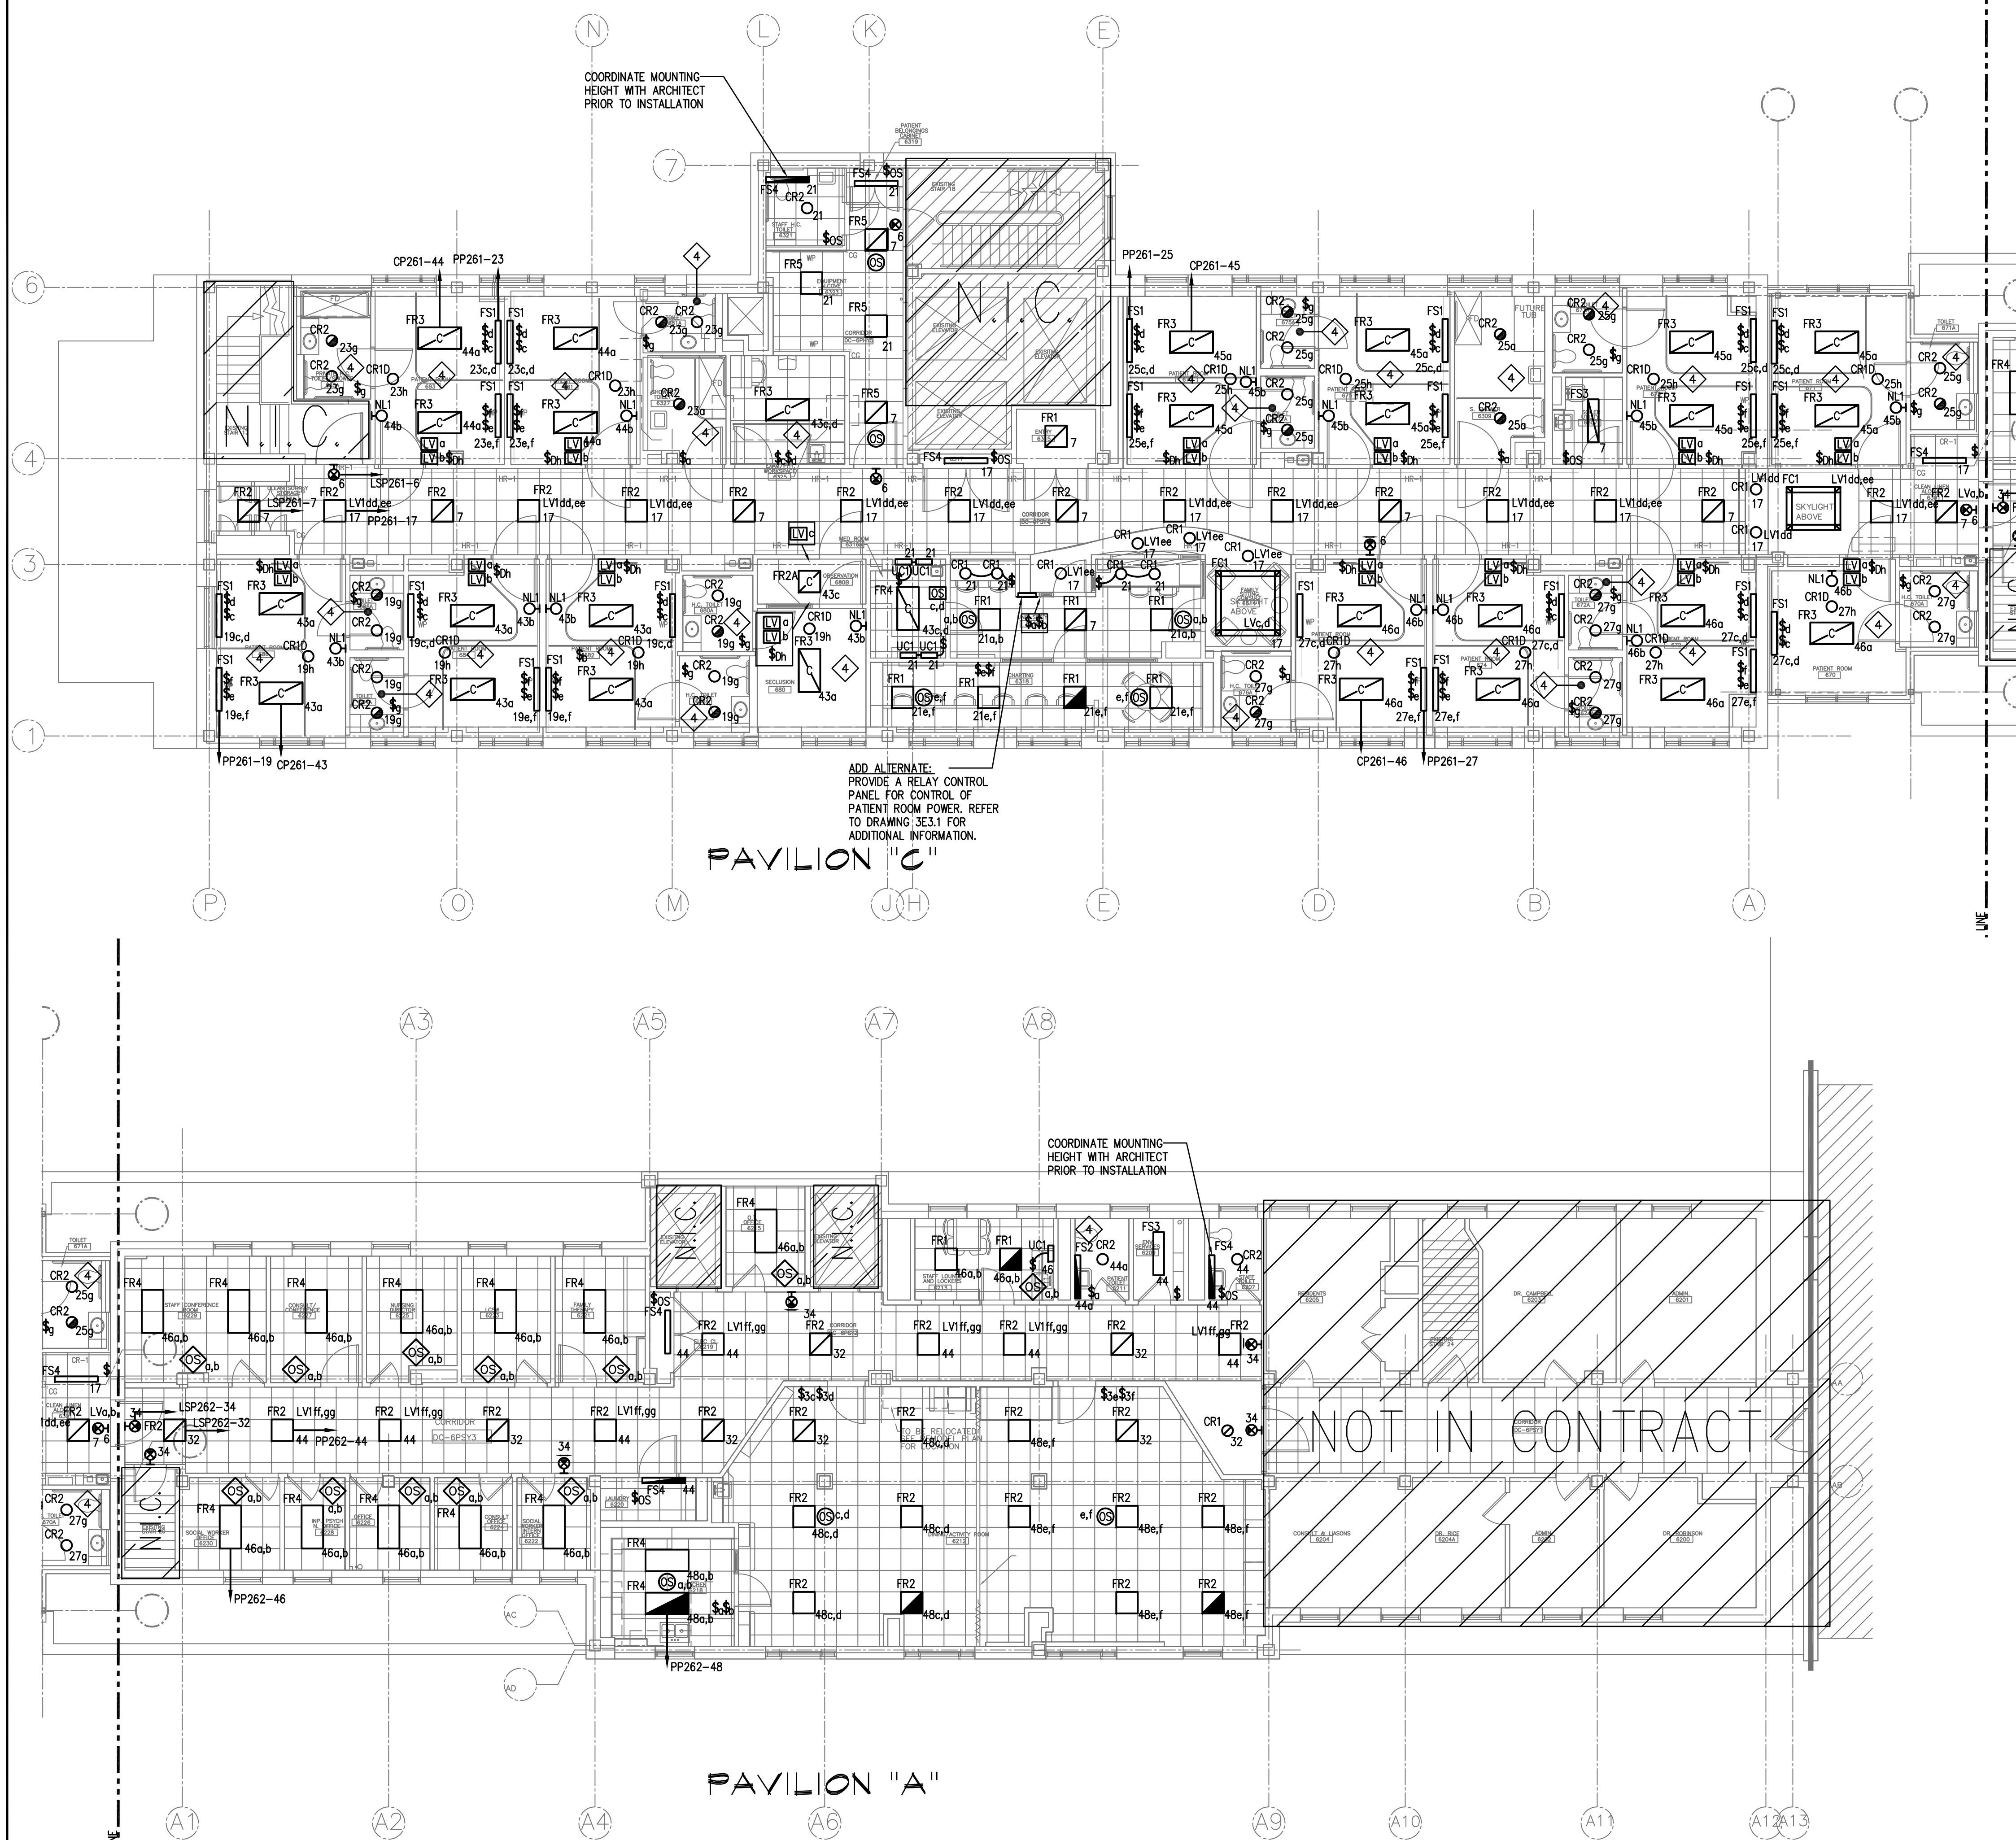


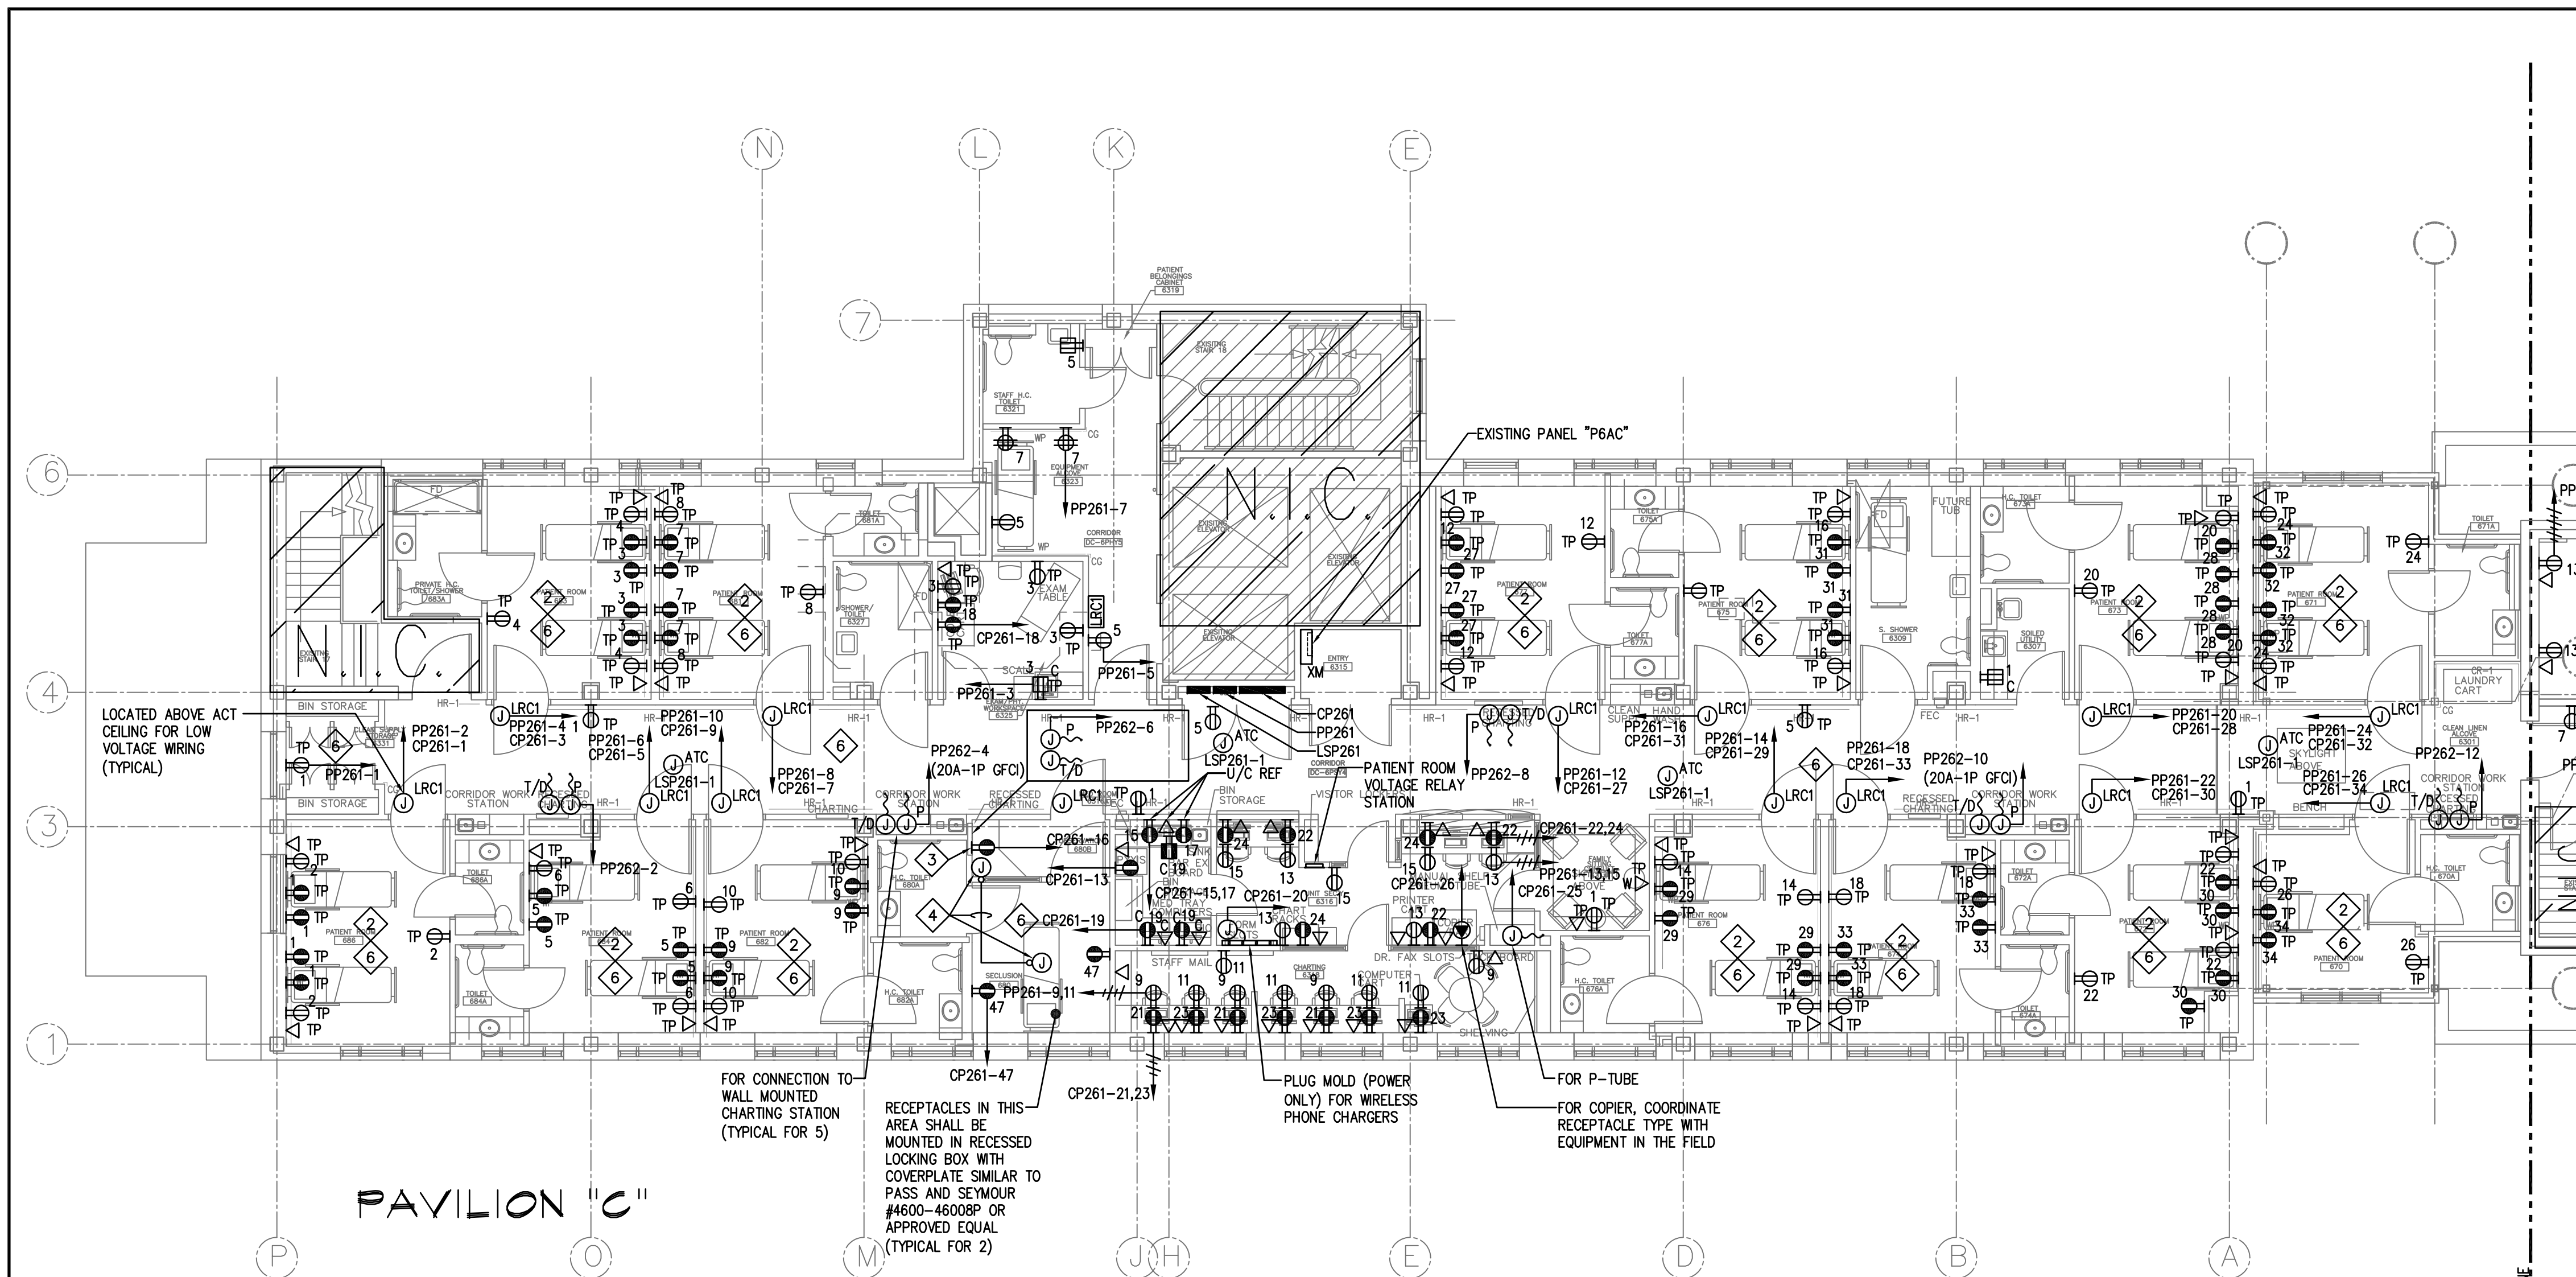

LOW VOLTAGE RELAY CONTROL PANEL "LRC1"				
RELAY NUMBER	LOW VOLTAGE SWITCH LEG	LOAD	PANEL	BREAKER
1	a	PATIENT ROOM 670 NORMAL RECEPTACLES	PP261	26
2	b	PATIENT ROOM 670 EMERGENCY RECEPTACLES	CP261	34
3	c	PATIENT ROOM 671 NORMAL RECEPTACLES	PP261	24
4	d	PATIENT ROOM 671 EMERGENCY RECEPTACLES	CP261	32
5	e	PATIENT ROOM 672 NORMAL RECEPTACLES	PP261	22
6	f	PATIENT ROOM 672 EMERGENCY RECEPTACLES	CP261	30
7	g	PATIENT ROOM 673 NORMAL RECEPTACLES	PP261	20
8	h	PATIENT ROOM 673 EMERGENCY RECEPTACLES	CP261	28
9	i	PATIENT ROOM 674 NORMAL RECEPTACLES	PP261	18
10	k	PATIENT ROOM 674 EMERGENCY RECEPTACLES	CP261	33
11	l	PATIENT ROOM 675 NORMAL RECEPTACLES	PP261	16
12	m	PATIENT ROOM 675 EMERGENCY RECEPTACLES	CP261	31
13	n	PATIENT ROOM 676 NORMAL RECEPTACLES	PP261	14
14	p	PATIENT ROOM 676 EMERGENCY RECEPTACLES	CP261	29
15	q	PATIENT ROOM 677 NORMAL RECEPTACLES	PP261	12
16	r	PATIENT ROOM 677 EMERGENCY RECEPTACLES	CP261	27
17	t	PATIENT ROOM 681 NORMAL RECEPTACLES	PP261	8
18	u	PATIENT ROOM 681 EMERGENCY RECEPTACLES	CP261	7
19	v	PATIENT ROOM 682 NORMAL RECEPTACLES	PP261	10
20	w	PATIENT ROOM 682 EMERGENCY RECEPTACLES	CP261	9
21	x	PATIENT ROOM 683 NORMAL RECEPTACLES	PP261	4
22	y	PATIENT ROOM 683 EMERGENCY RECEPTACLES	CP261	3
23	z	PATIENT ROOM 684 NORMAL RECEPTACLES	PP261	6
24	aa	PATIENT ROOM 684 EMERGENCY RECEPTACLES	CP261	5
25	bb	PATIENT ROOM 686 NORMAL RECEPTACLES	PP261	2
26	cc	PATIENT ROOM 686 EMERGENCY RECEPTACLES	CP261	1
27	dd	1996 CORRIDOR LIGHTING	PP261	17
28	ee	1996 CORRIDOR LIGHTING	PP261	17
29	ff	1999 CORRIDOR LIGHTING	PP262	44
30	gg	1999 CORRIDOR LIGHTING	PP262	44
31	hh	SPARE		
32	ii	SPARE		
33	kk	SPARE		
34	ll	SPARE		
35	mm	SPARE		
36	nn	SPARE		
37	oo	SPARE		
38	pp	SPARE		
39	qq	SPARE		
40	rr	SPARE		
41	uu	SPARE		
42	ww	SPARE		

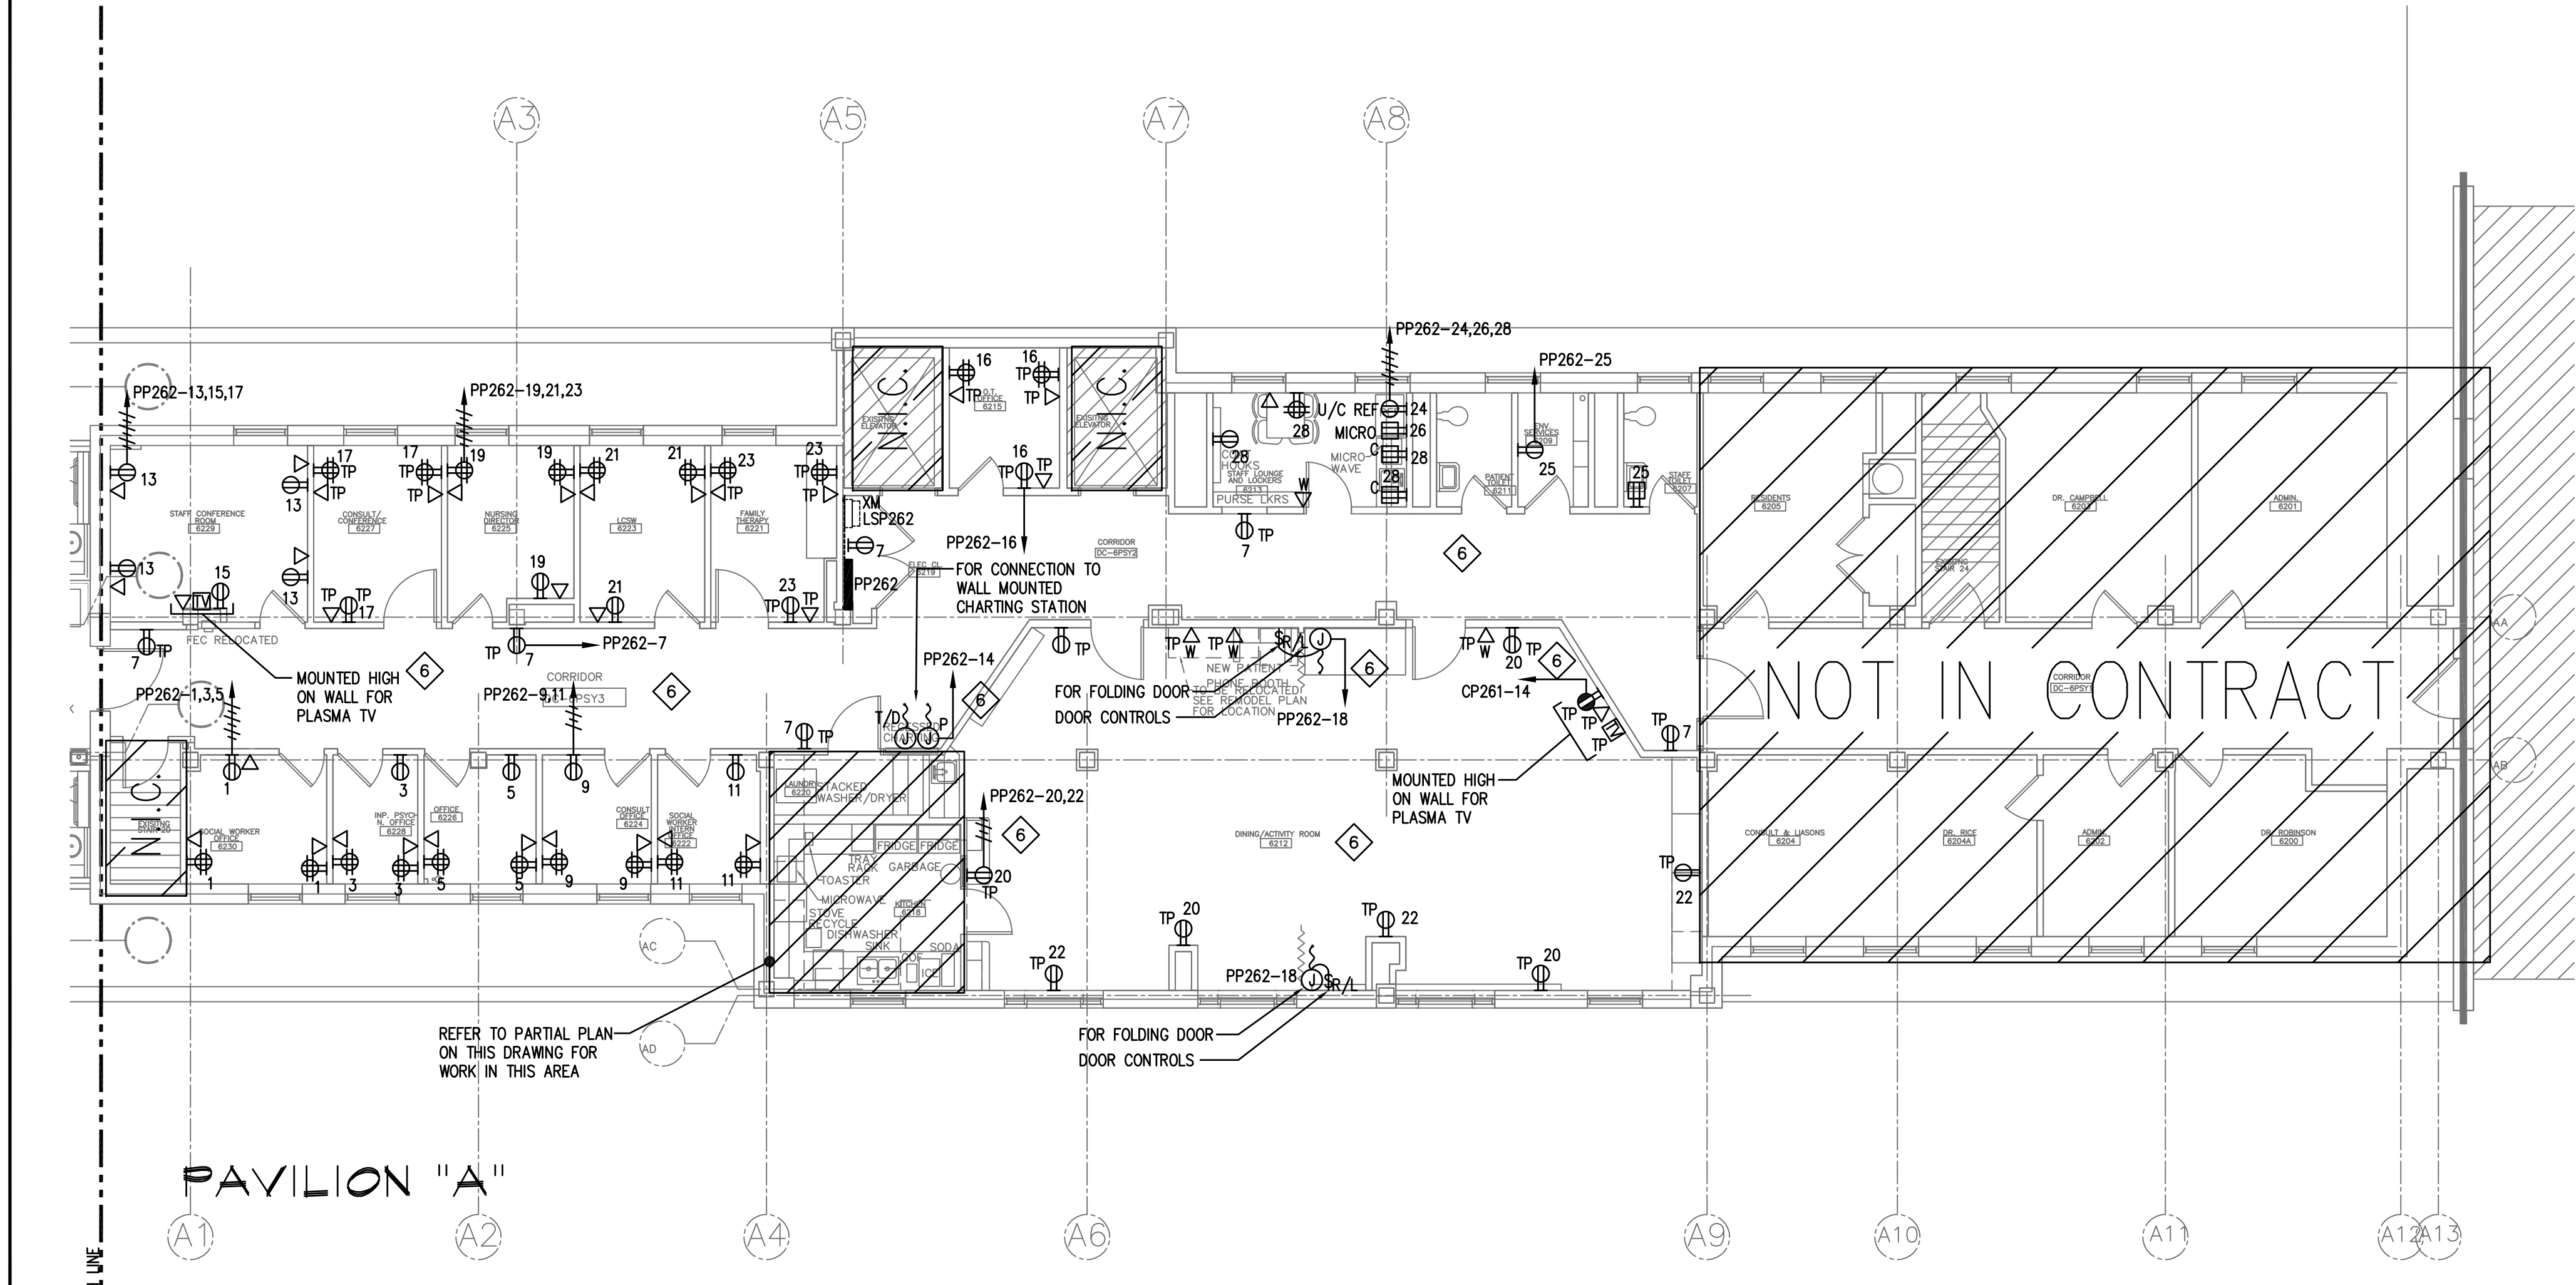

- NOTES:**
- 1 CIRCUIT NUMBERS ARE FOR INFORMATION ONLY. CONNECT TO EXISTING SPARE BREAKER IN PANEL INDICATED.
 - 2 REFER ARCHITECTURAL FLOOR PLAN AND ELEVATIONS FOR EXACT LOCATION, QUANTITIES AND MOUNTING HEIGHTS.
 - 3 LOCATED ABOVE THE CEILING FOR CONNECTION TO MONITORING SYSTEM. COORDINATE EXACT REQUIREMENTS WITH THE SECURITY VENDOR PRIOR TO INSTALLATION.
 - 4 2-GANG BACKBOX FOR SPEAKER/MICROPHONE WIRING WITH 3/4" (EMPTY) RUN CONCEALED WITHIN WALL INTO CEILING ABOVE TO MICROPHONE LOCATION. TERMINATE IN SECOND 2-GANG BACKBOX. COORDINATE AND LOCATE ALL EQUIPMENT AS DIRECTED BY SECURITY VENDOR.
 - 5 PROVIDE NEW 4" CONDUIT TO BE INSTALLED FROM P6 DOWN TO THE TELECOM ROOM ON P4CD (ROOM 4317). LOCATE NEXT TO THE EXISTING PATHWAY DOWN. FIRESTOPPING AND ANY SOFFIT WORK WILL BE PROVIDED BY THE GC.
 - 6 ALL PATIENT ROOMS, CORRIDORS AND DINING AND ACTIVITY AREAS SHALL BE PROTECTED VIA GFCI BREAKER IN PANEL INDICATED. REFER TO 3E4.1 FOR ADDITIONAL INFORMATION.

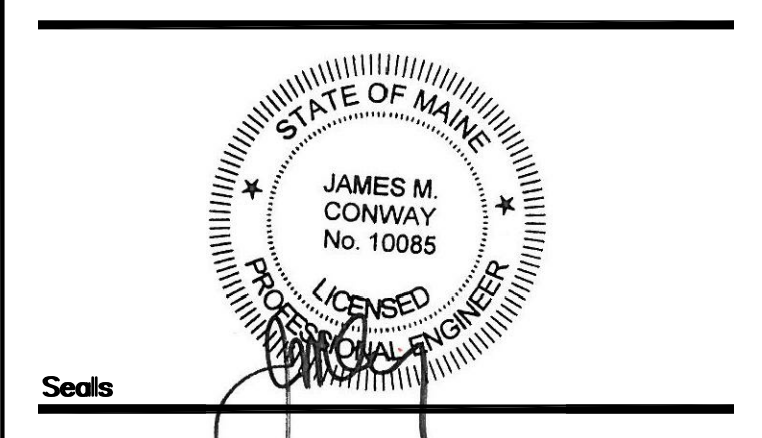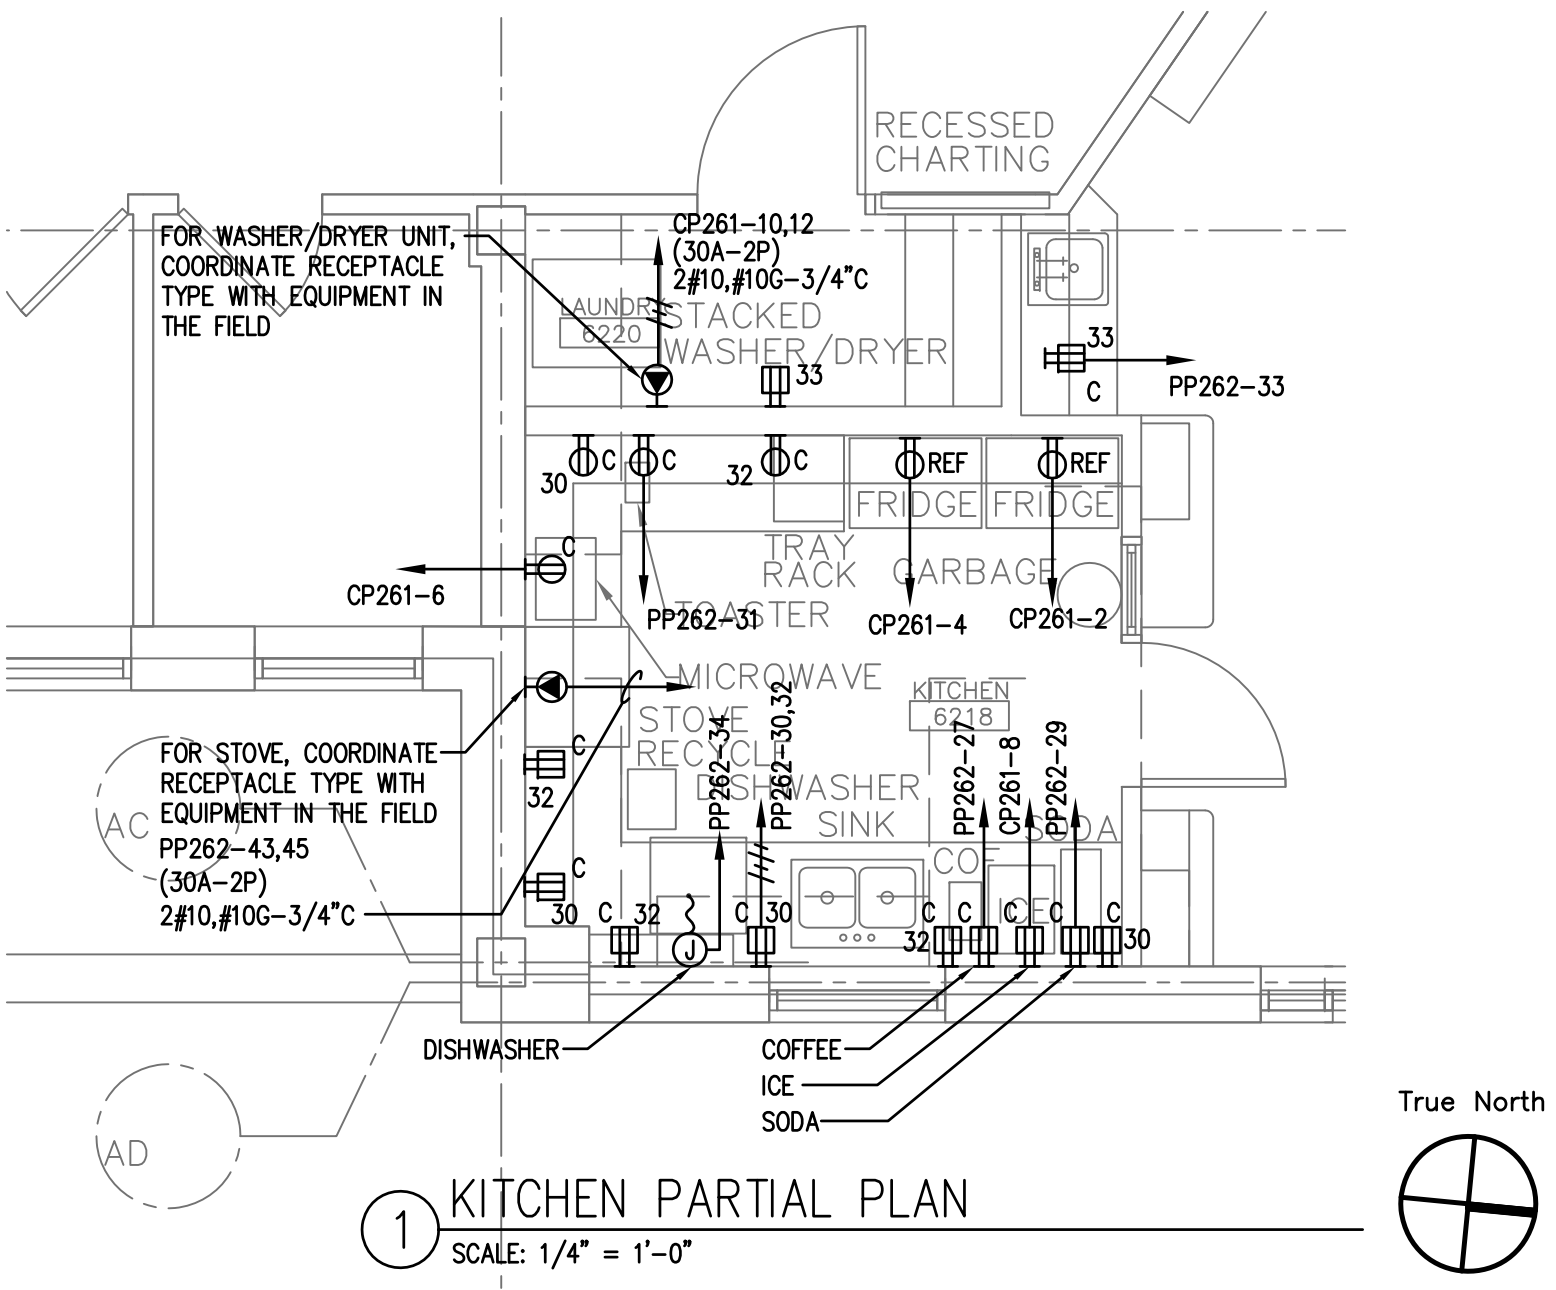

BECKER
structural engineers, inc.

75 York Street
Portland, ME 04101-4701
info@beckerstructural.com


Tel 207-879-1838
Fax 207-879-1822
www.beckerstructural.com

Consultant

Mechanical / Electrical Engineers

92 Montvale Ave, Suite 4100
Snohomish, WA 02160
Tel: 781-481-0210
Fax: 781-481-0203
email: info@f-t.com
www.f-t.com

Project No: 09018.00

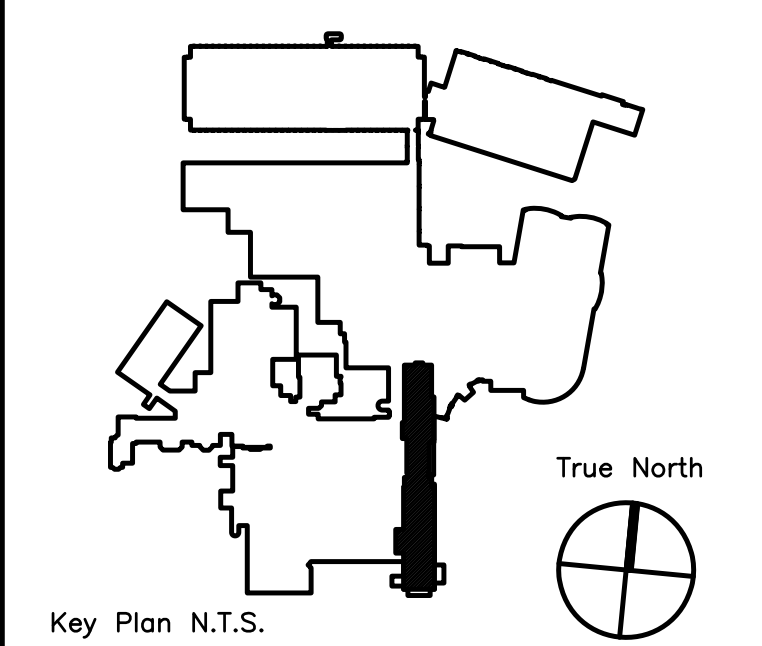


ADDENDUM#1	12/4/09	1
Revision	Date	No

Maine Medical Center
Portland, Maine

MAINE MEDICAL CENTER
PAVILION 6 RENOVATIONS

MorrisSwitzer Project Number 28034
Date 11/19/09
Scale 1/8" = 1'-0"
Sheet Title and Number

SIXTH FLOOR PAVILIONS "A" & "C" ELECTRICAL POWER PLAN
3E2.1

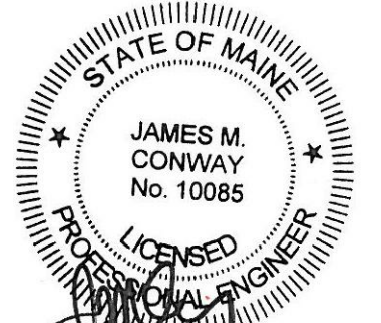

Seals

BECKER
structural engineers, inc.

75 York Street
Portland, ME 04101-4701
info@beckerstructural.com

Tel 207-879-1838
Fax 207-879-1822
www.beckerstructural.com

Consultant


MECHANICAL / ELECTRICAL ENGINEERS

92 Montvale Ave, Suite 4100
Snohomish, WA 98290
Tel: 781-481-0210
Fax: 781-481-0203
email: info@f-t.com
www.f-t.com

FITZMEYER & TOCCI
ASSOCIATES, INC.


Project No.: 09018.00

Consultant

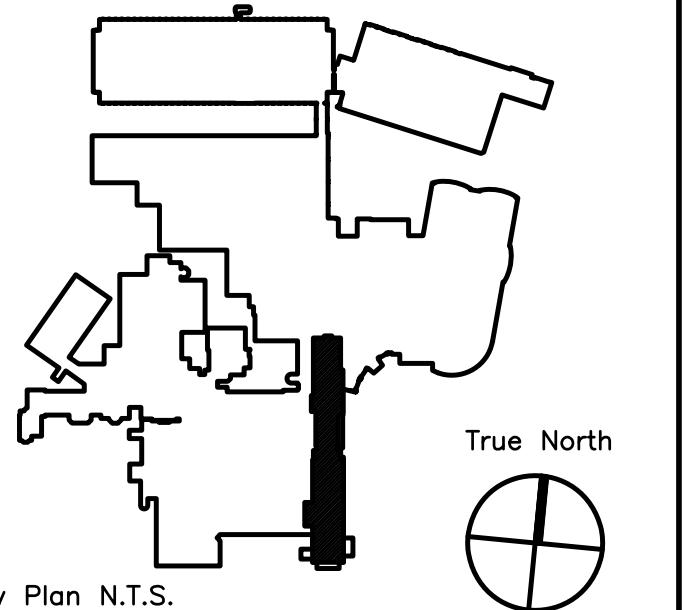

Key Plan N.T.S.

ADDENDUM#	Date	No
1	12/4/09	1
Revision		

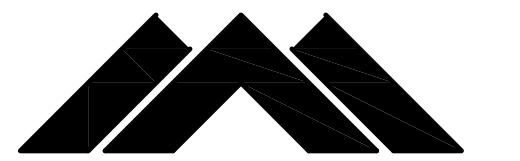


Maine Medical Center
Portland, Maine

MAINE MEDICAL CENTER
PAVILION 6 RENOVATIONS

MorrisSwitzer Project Number 28034
Date 11/19/09
Scale 1/8" = 1'-0"
Sheet Title and Number


SIXTH FLOOR PAVILIONS "A" & "C" ELECTRICAL LOW TENSION PLAN

3E2.2

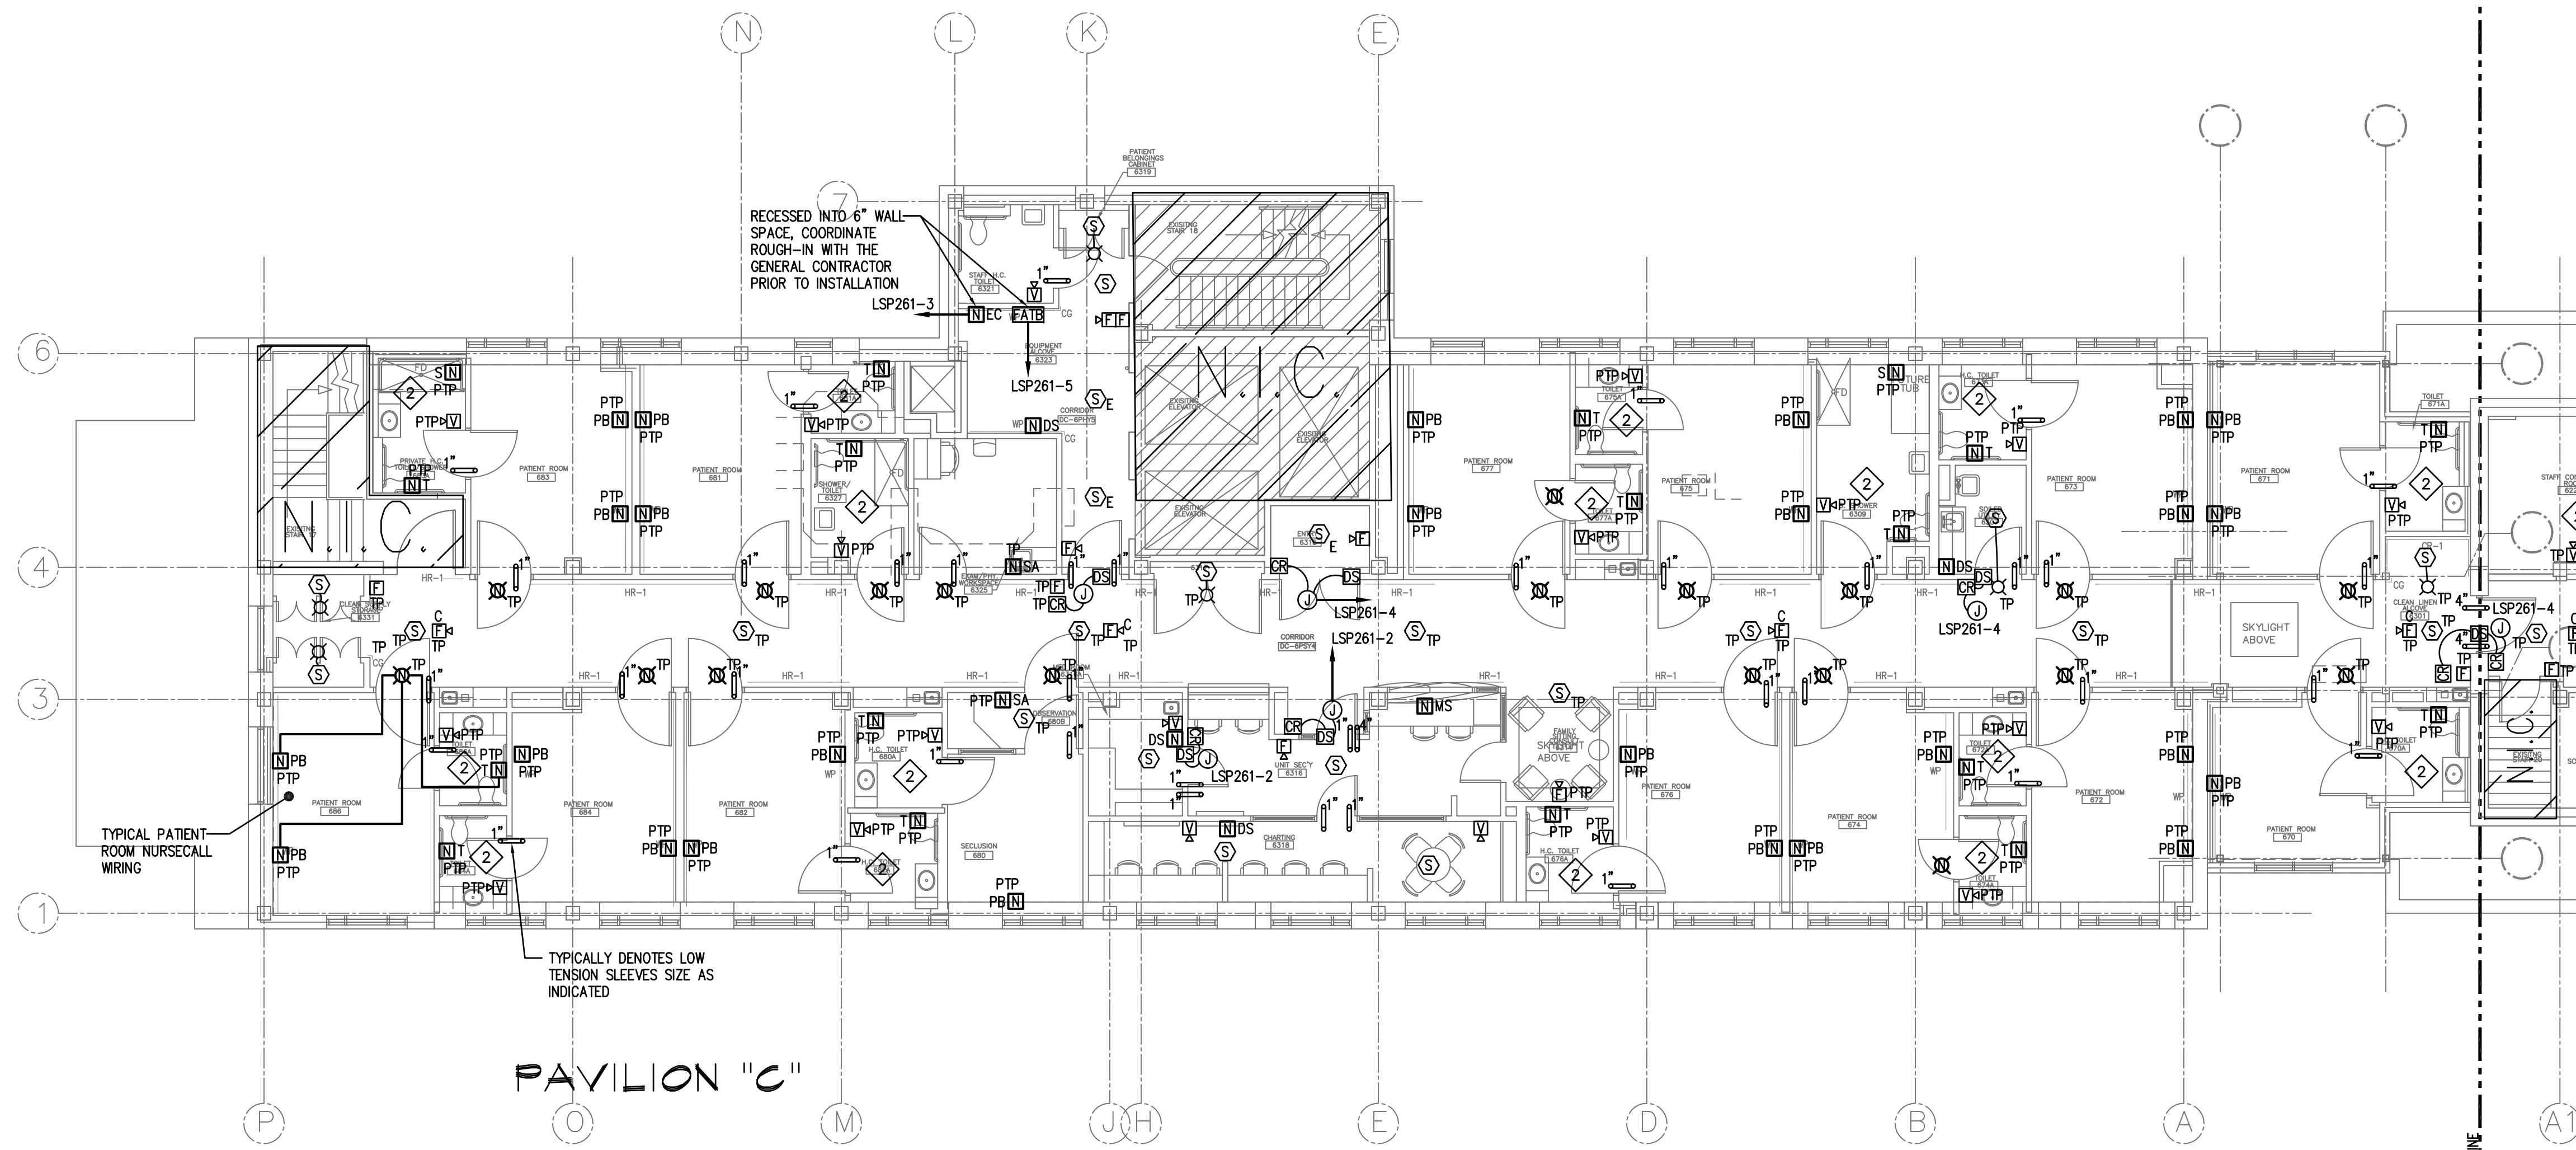


PAVILION "C"


- DRAWING NOTES:**
- 1 REFER ARCHITECTURAL FLOOR PLAN AND ELEVATIONS FOR EXACT LOCATION, QUANTITIES AND MOUNTING HEIGHTS
 - 2 ALL TOILET ROOM, CONFERENCE ROOMS, ETC. FIRE ALARM STROBE ONLY DEVICES SHALL BE ENCASED IN A PROTECTIVE COVER SIMILAR TO SAFETY TECHNOLOGY INTERNATIONAL CATALOG #ST-1221E OR APPROVED EQUAL.

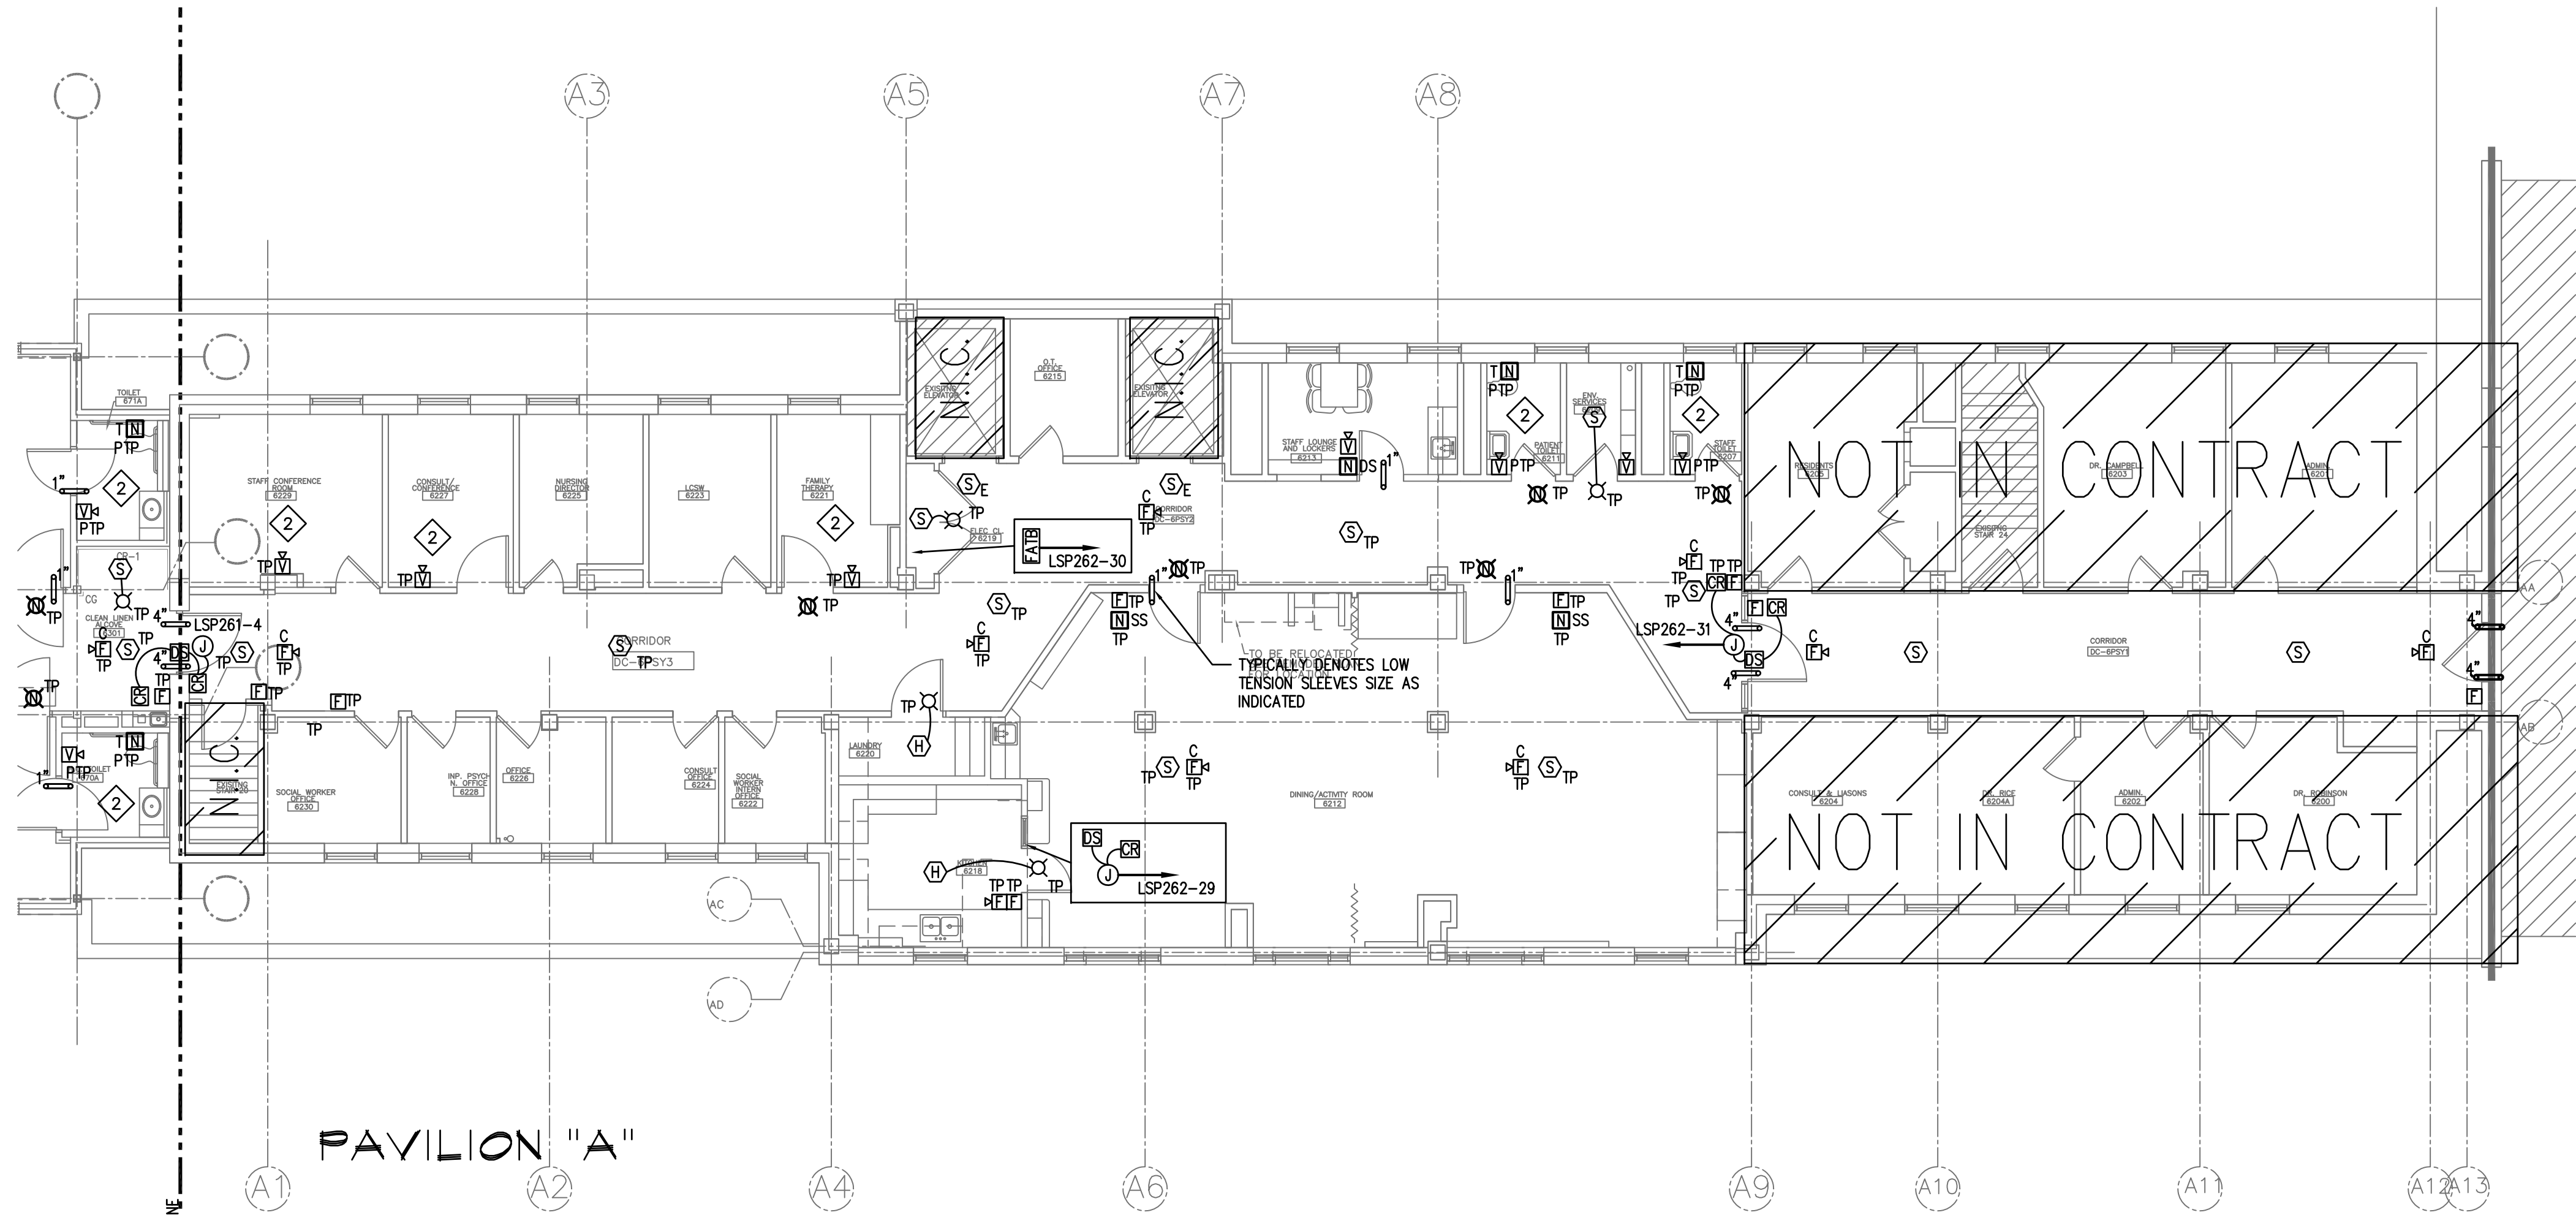

PAVILION "A"

True North

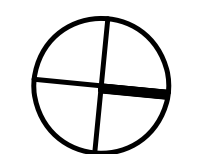

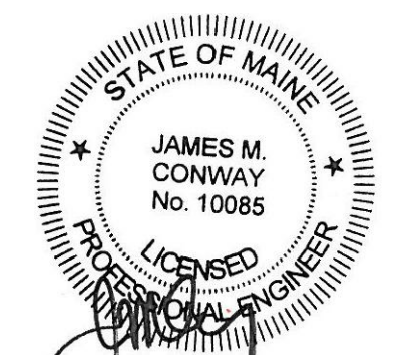

BECKER
structural engineers, inc.

75 York Street
Portland, ME 04101-4701
info@beckerstructural.com

Tel 207-879-1838
Fax 207-879-1822
www.beckerstructural.com

Consultant


MECHANICAL / ELECTRICAL ENGINEERS

92 Montvale Ave, Suite 4100
Saco, ME 04158
Tel: 781-481-0210
Fax: 781-481-0203
email: info@f-t.com
www.f-t.com

FITZMEYER & TOCCI
ASSOCIATES, INC.

Project No.: 09018.00

Consultant

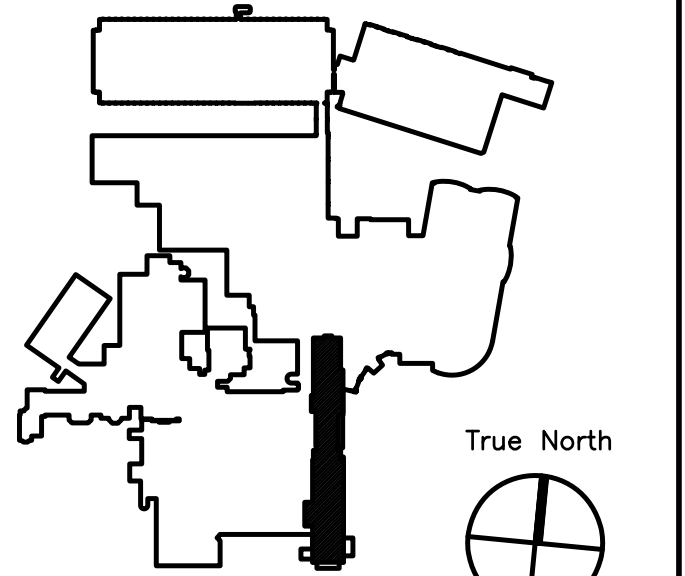

Key Plan N.T.S.

ADDENDUM#1	12/4/09	1
Revision	Date	No






Maine Medical Center
Portland, Maine

MAINE MEDICAL CENTER
PAVILION 6 RENOVATIONS

MorrisSwitzer Project Number 28034
Date 11/19/09
Scale NOT TO SCALE
Sheet Title and Number


**SIXTH FLOOR PAVILIONS
"A" & "C" ELECTRICAL
RISER DIAGRAM AND
DETAILS
3E3.0**

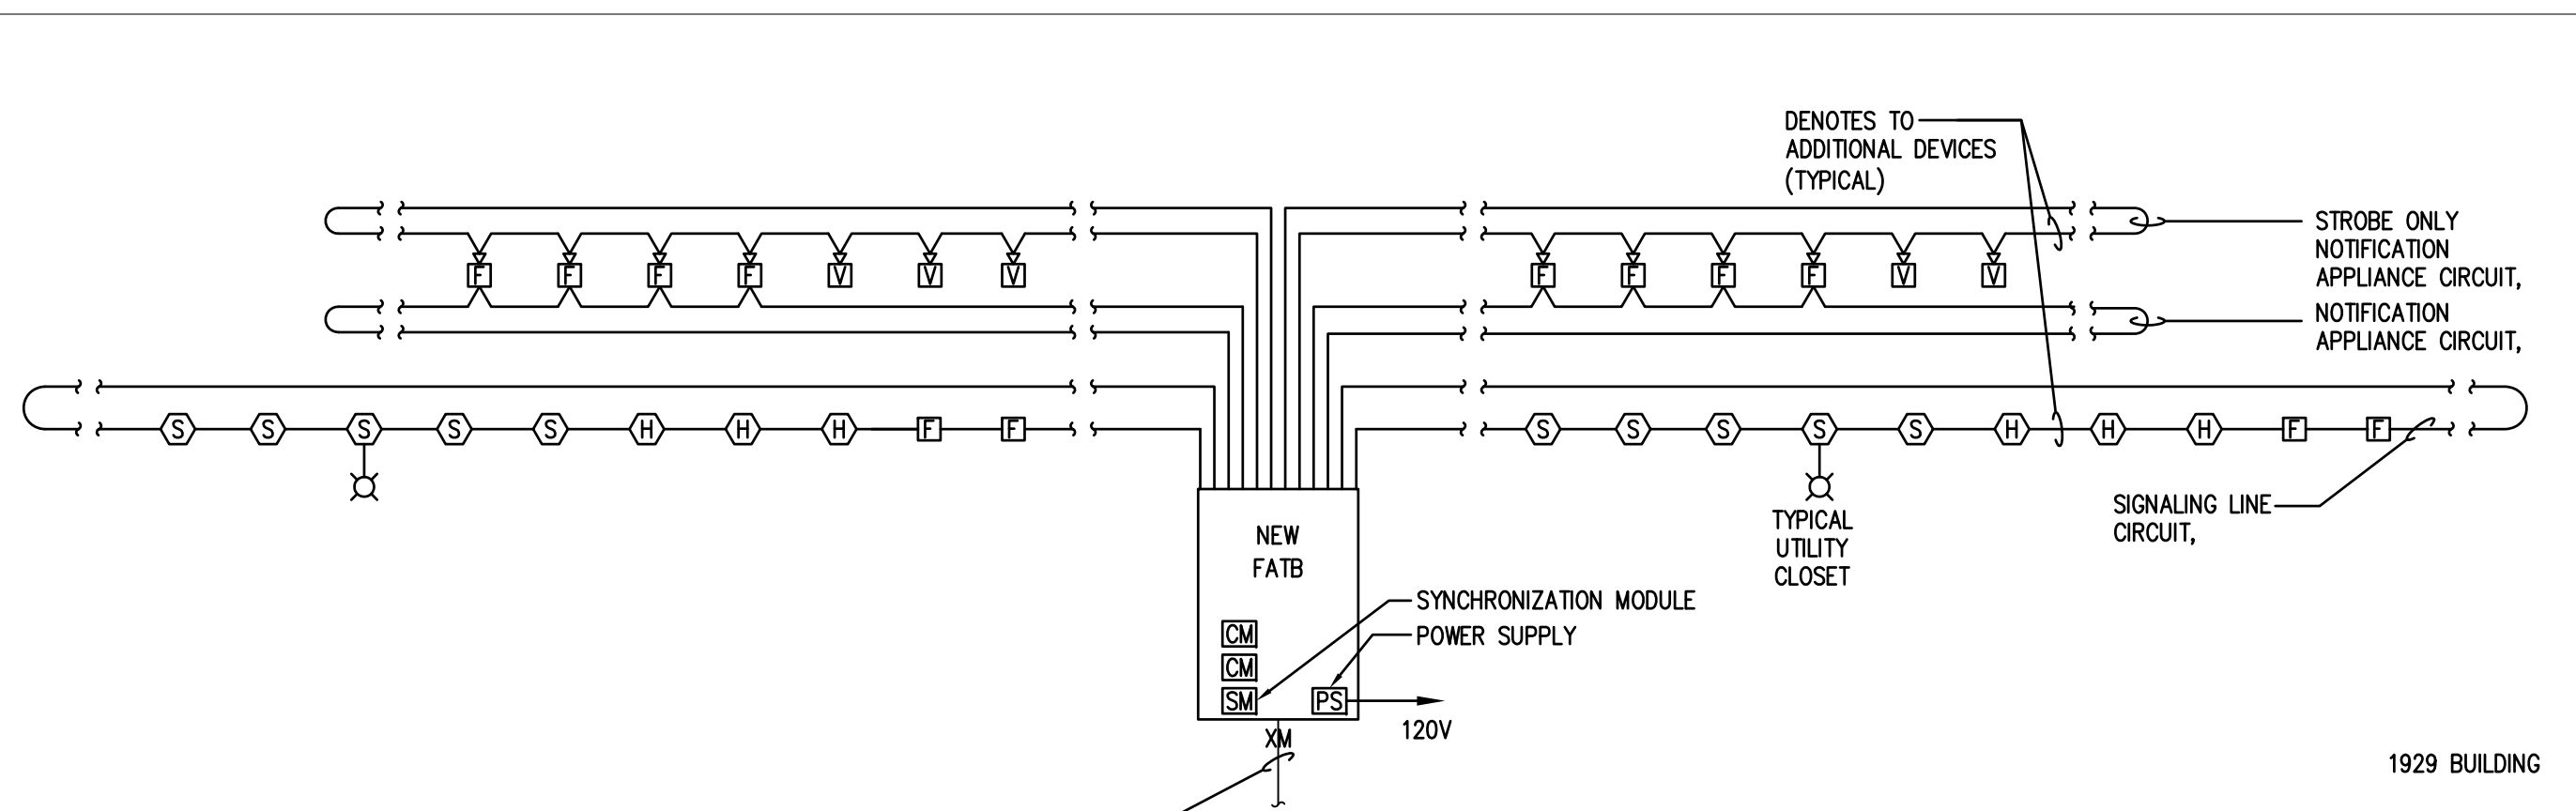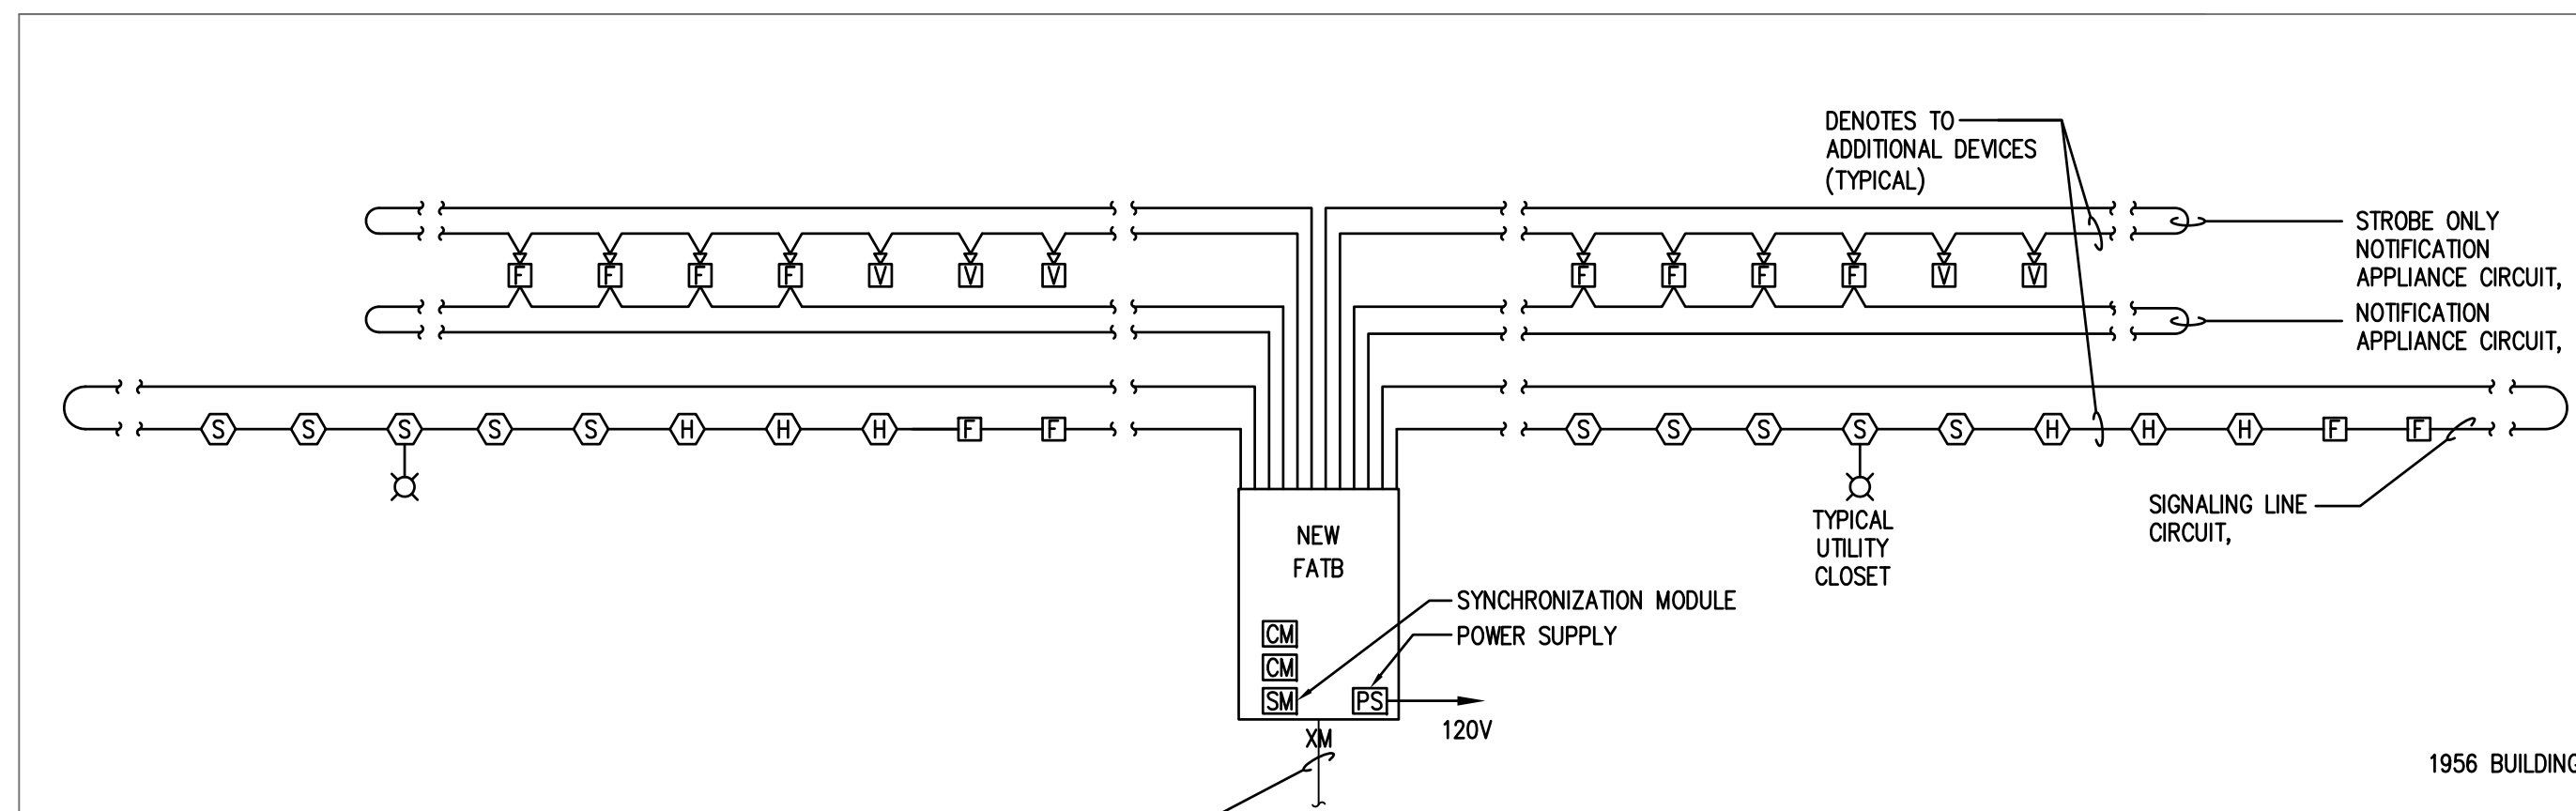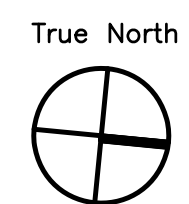


1 PARTIAL FIRE ALARM RISER DIAGRAM
SCALE: NOT TO SCALE

FIRE ALARM NOTES:


- FA1. REFER TO ELECTRICAL DRAWINGS FOR EXACT QUANTITIES OF FIRE ALARM DEVICES.
- FA2. ELECTRICAL CONTRACTOR SHALL PROGRAM, TEST AND CERTIFY FIRE ALARM SYSTEM UPON COMPLETION WORK.
- FA3. FIRE ALARM SYSTEM AND INSTALLATION SHALL COMPLY WITH APPLICABLE REGULATIONS OF NFPA #72, LIFE-SAFETY CODE #101, NATIONAL ELECTRIC CODE AND LOCAL FIRE DEPARTMENT.
- FA4. FIRE ALARM WIRING TERMINATIONS SHALL BE MADE ON TERMINAL BLOCKS, NO SPLICES WILL BE ALLOWED.
- FA5. ELECTRICAL CONTRACTOR SHALL FIELD CONFORM THAT ENOUGH BATTERY CAPACITY EXISTS FOR THE FIRE ALARM SYSTEM TO OPERATE FOR 60 HOURS IN NON-ALARM CONDITION AND CAPABLE OF OPERATING IN ALARM FOR 15 MINUTES AT THE END OF THE 60 HOUR PERIOD. PROVIDE BATTERY AMP-HOUR CALCULATIONS, RISERS AND WIRING SCHEMATICS WITH SUBMISSION.
- FA6. SYSTEM MANUFACTURER SHALL PROVIDE INSTALLATION WIRING DIAGRAM OF THE FIRE ALARM SYSTEM, AND VERIFICATION CERTIFICATE OF SYSTEM OPERATING PRIOR TO FINAL ACCEPTANCE.
- FA7. ALL FIELD WIRING AND EQUIPMENT SHALL BE AS REQUIRED PER MANUFACTURERS WIRING DIAGRAMS.
- FA8. ALL FIRE ALARM WIRING SHALL BE CLASS A (OUTGOING AND RETURNING CIRCUITS SHALL NOT BE PHYSICALLY INSTALLED IN THE SAME RACEWAY), FAULT ISOLATOR MODULES SHALL BE INSTALLED IN THE FACP. ALSO, FAULT ISOLATOR MODULES WILL BE PROVIDED FOR EVERY 18 ADDRESSABLE FIRE ALARM DEVICES.
- FA9. CEILING MOUNTED SMOKE DETECTORS SHALL NOT BE LOCATED CLOSER THAN 3 FT. FROM AIR SUPPLY FROM AIR SUPPLY DIFFUSERS.
- FA10. PROVIDE A REMOTE TEST STATION FOR ALL DUCT MOUNTED SMOKE DETECTORS.

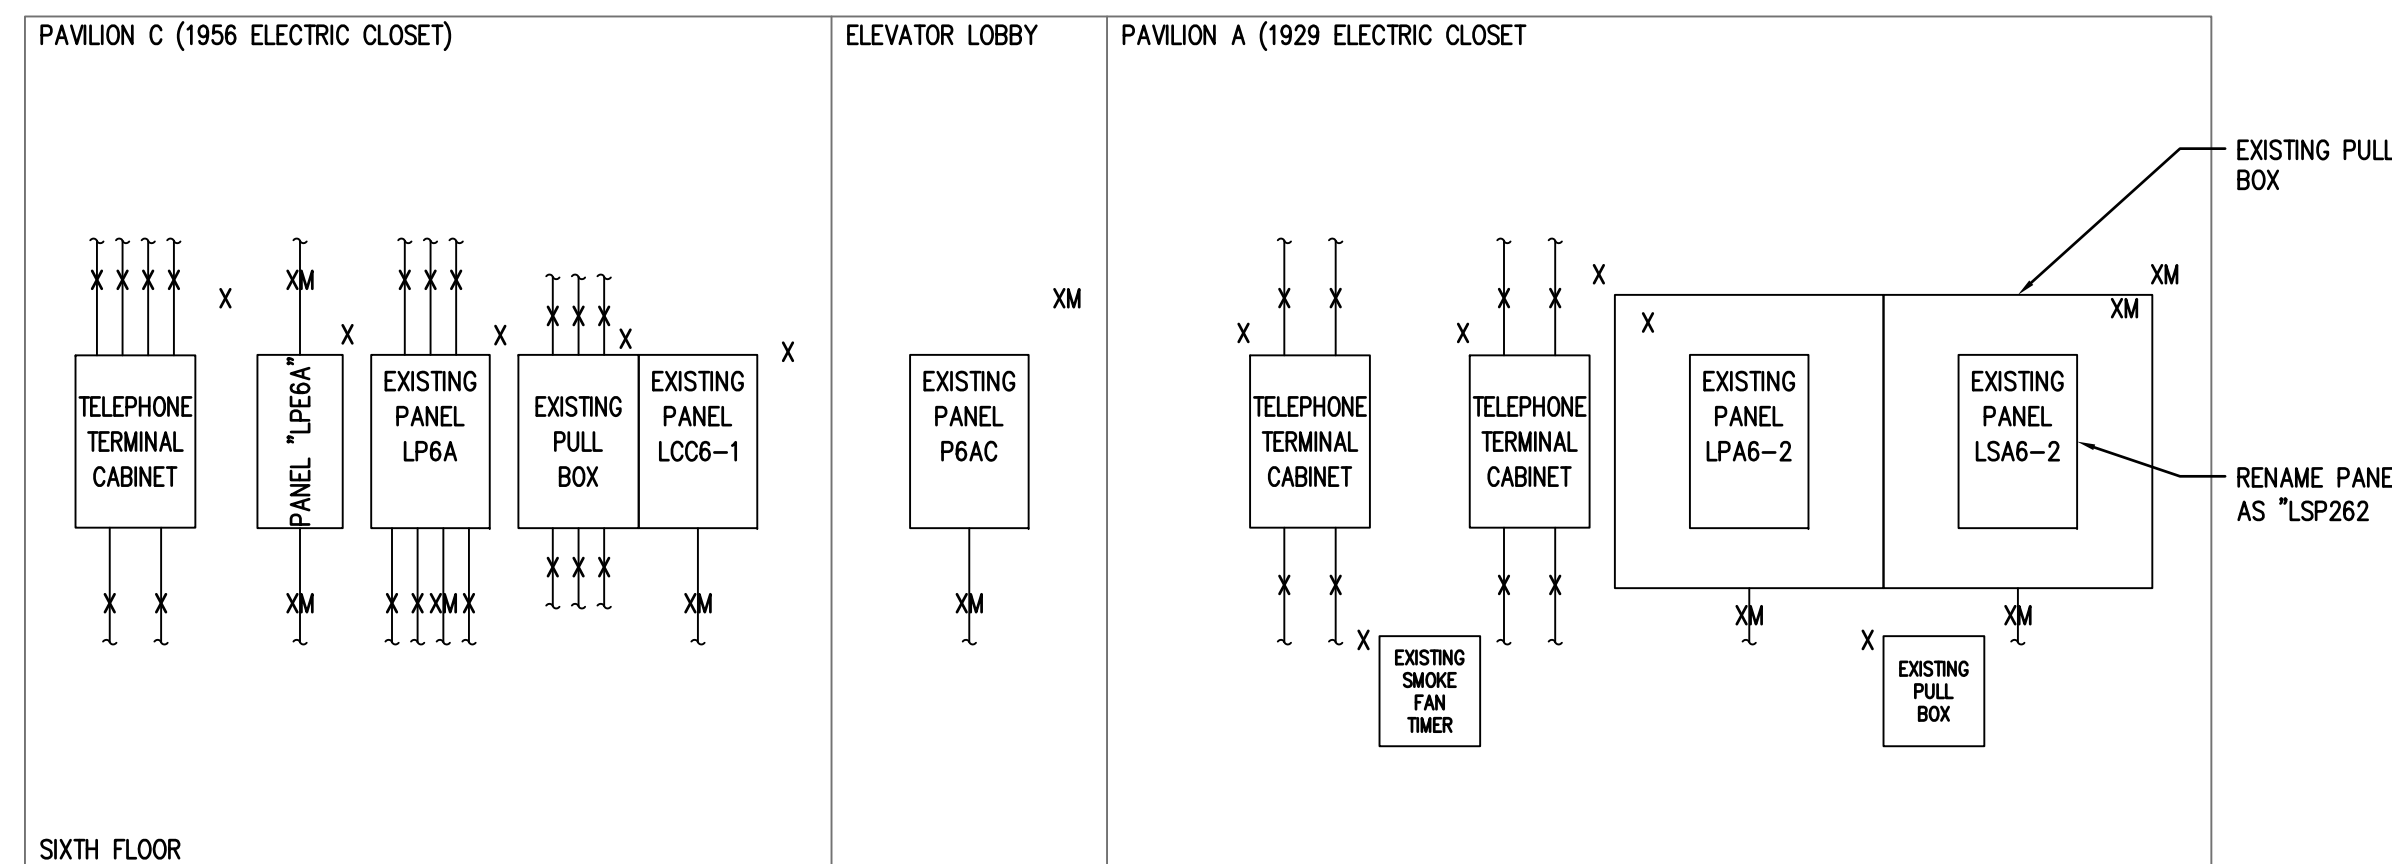

2 EXISTING PARTIAL POWER RISER DIAGRAM
SCALE: NOT TO SCALE

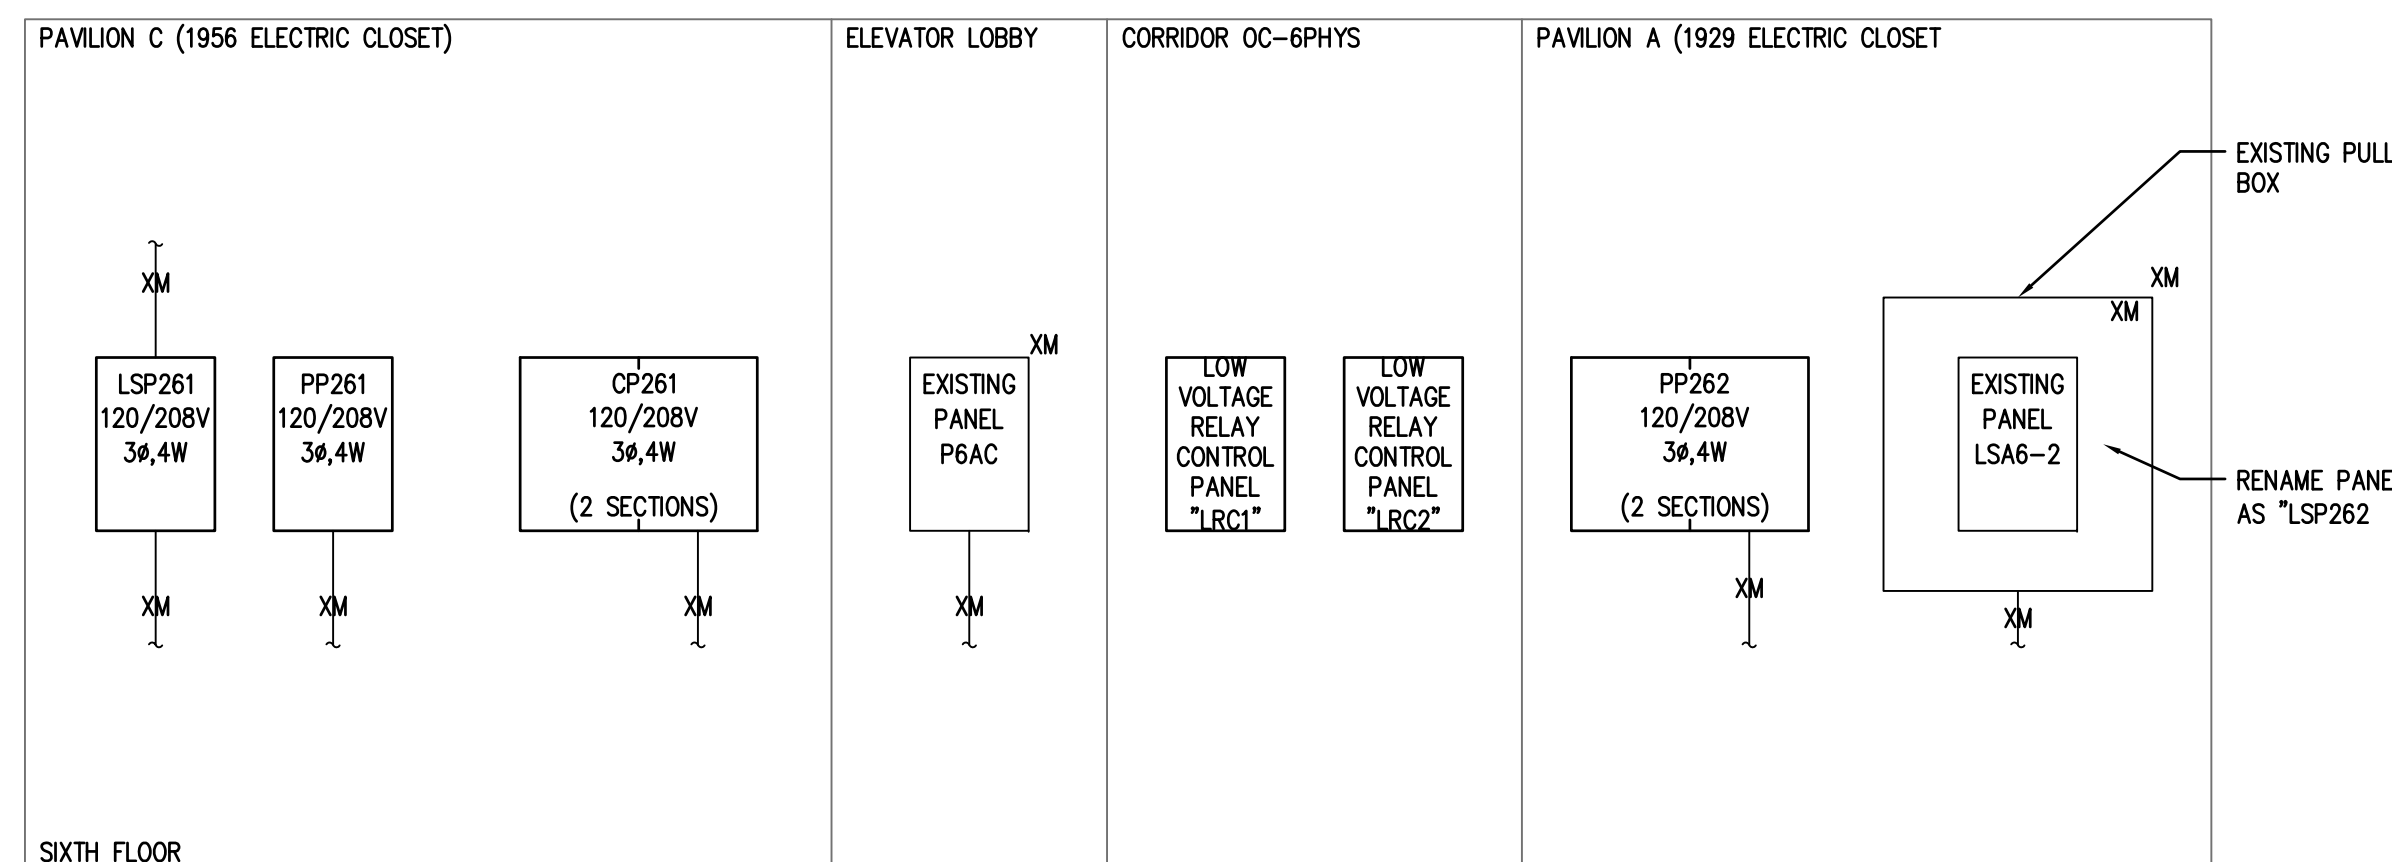

3 PROPOSED PARTIAL POWER RISER DIAGRAM
SCALE: NOT TO SCALE

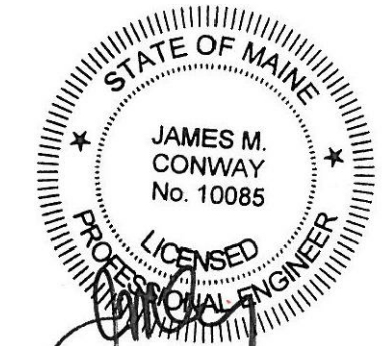


Seals

BECKER
structural engineers, inc.


75 York Street
Portland, ME 04101-4701
info@beckerstructural.com

Tel 207-879-1838
Fax 207-879-1822
www.beckerstructural.com

Consultant

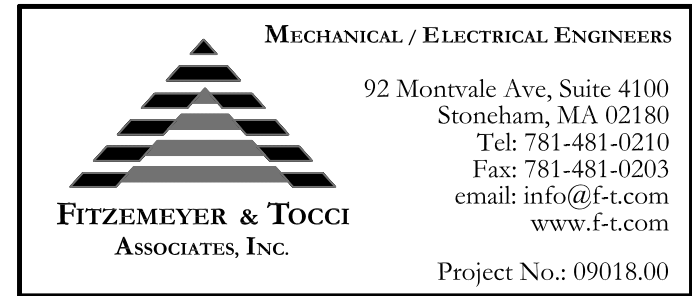

Consultant

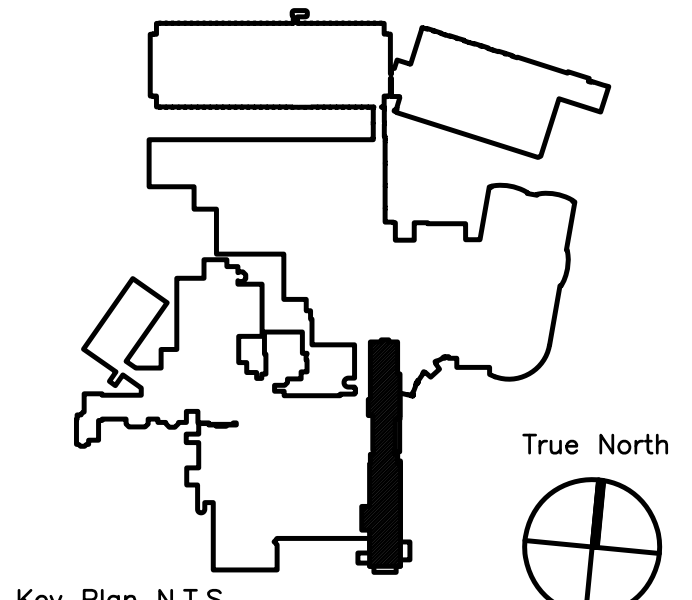

Key Plan N.T.S.

ADDENDUM#1	12/4/09	1
Revision	Date	No





Maine Medical Center
Portland, Maine

MAINE MEDICAL CENTER
PAVILION 6 RENOVATIONS


MorrisSwitzer Project Number 28034
Date 11/19/09
Scale NOT TO SCALE

Sheet Title and Number
SIXTH FLOOR PAVILIONS
"A" & "C" ELECTRICAL
RISER DIAGRAM AND
DETAILS
3E3.1

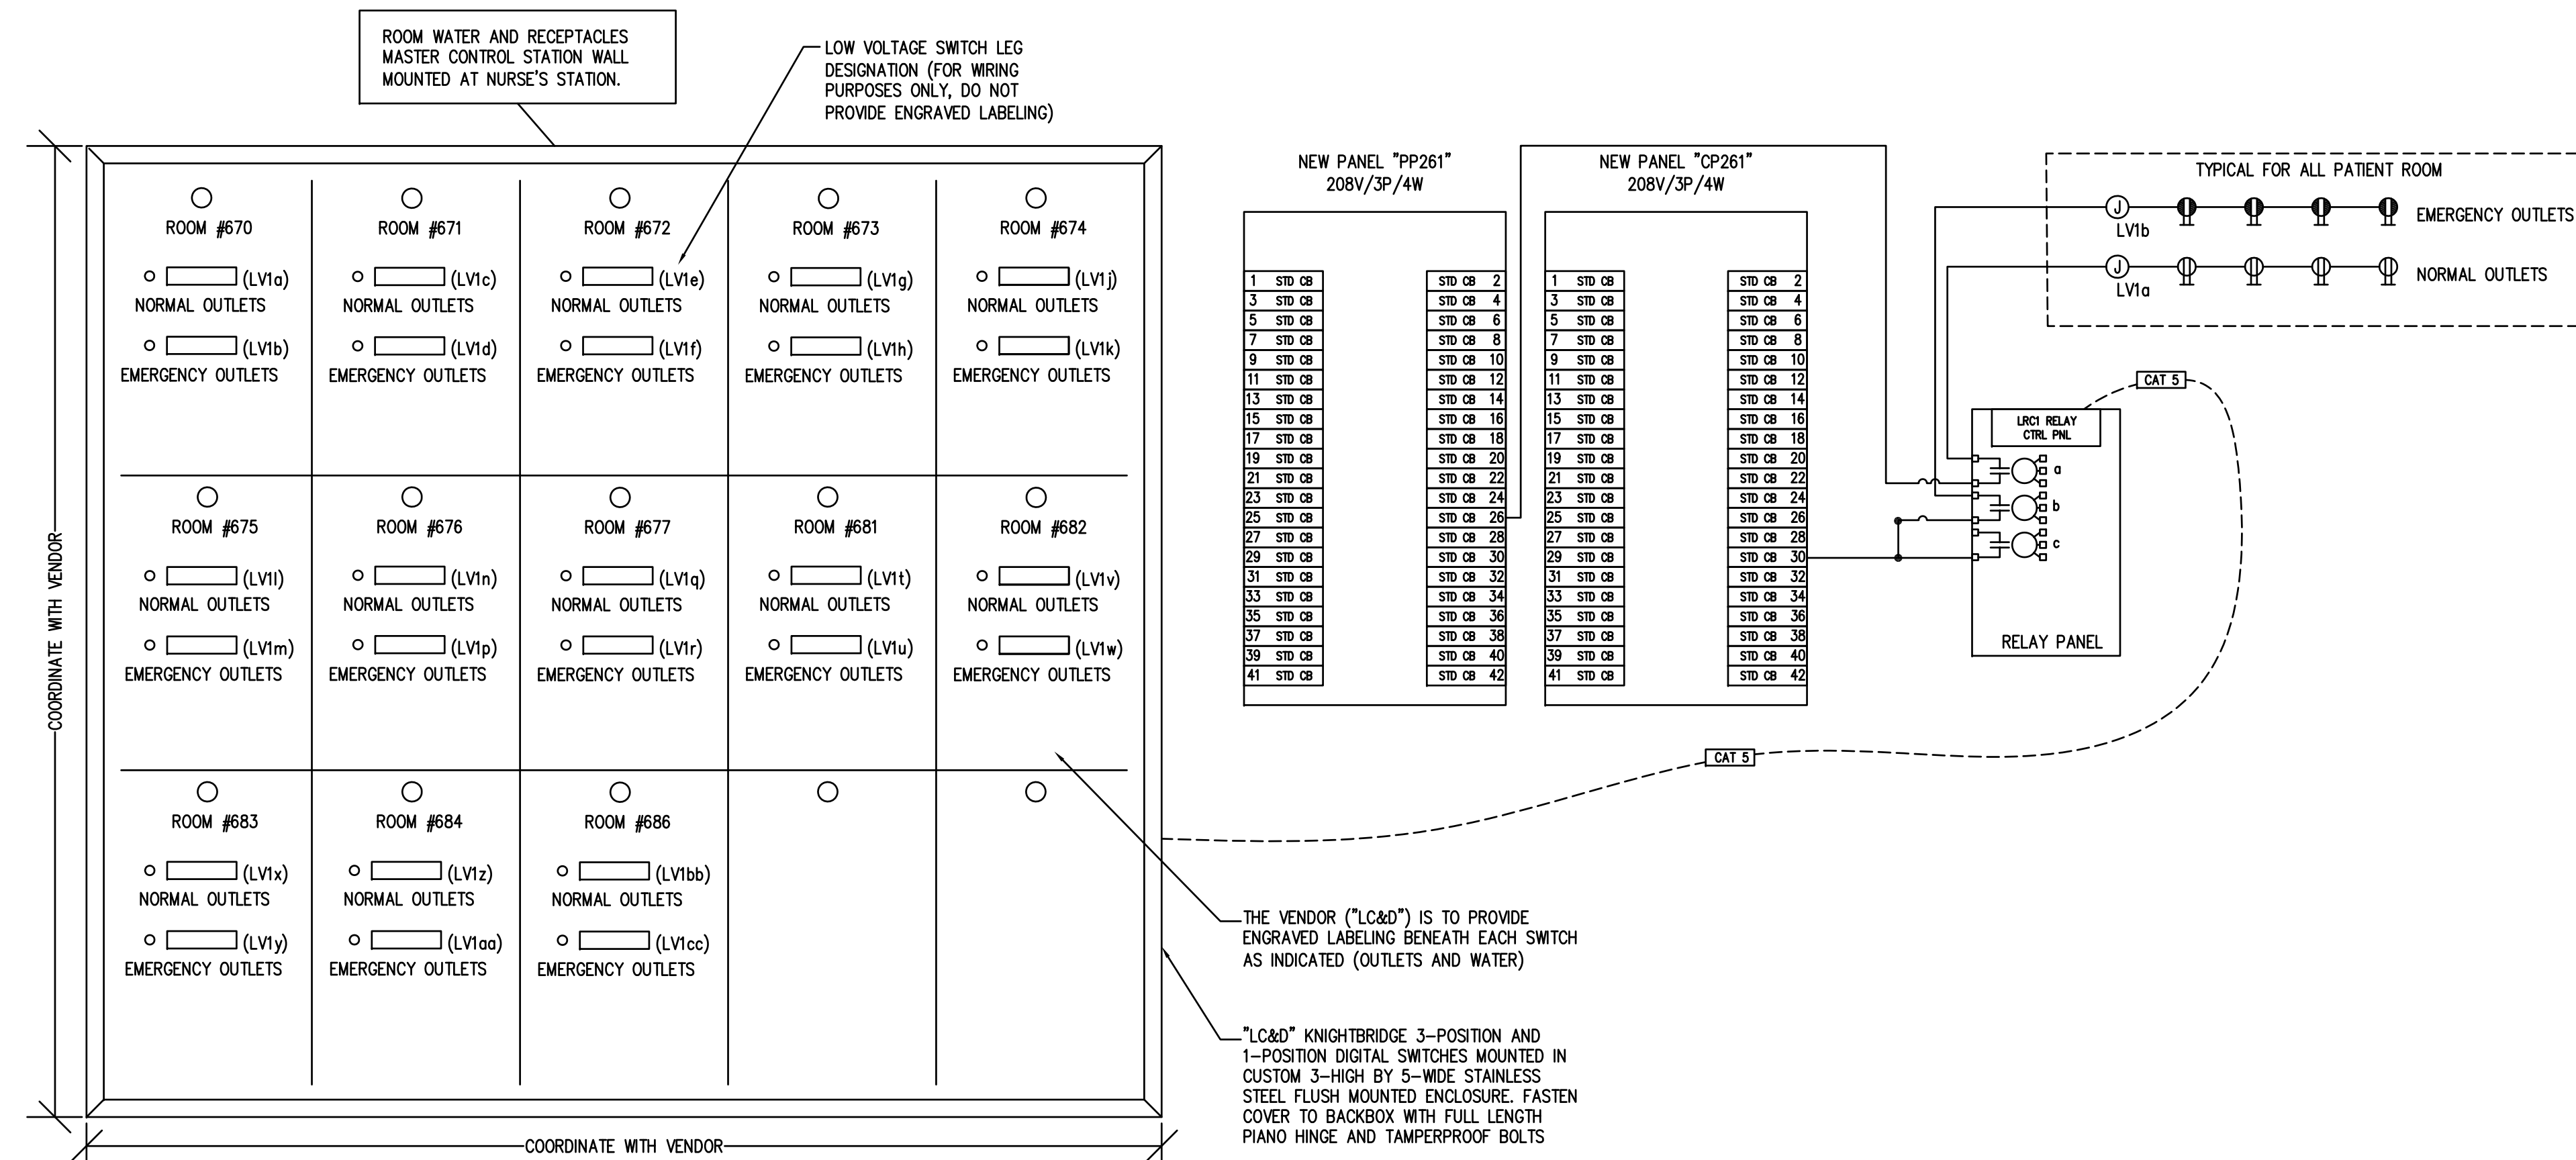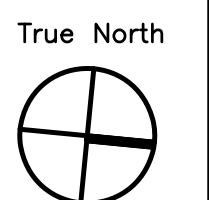

CONTROL PANEL IS ALTERNATE ONLY

1 LOW VOLTAGE RELAY WIRING DETAIL
SCALE: NOT TO SCALE

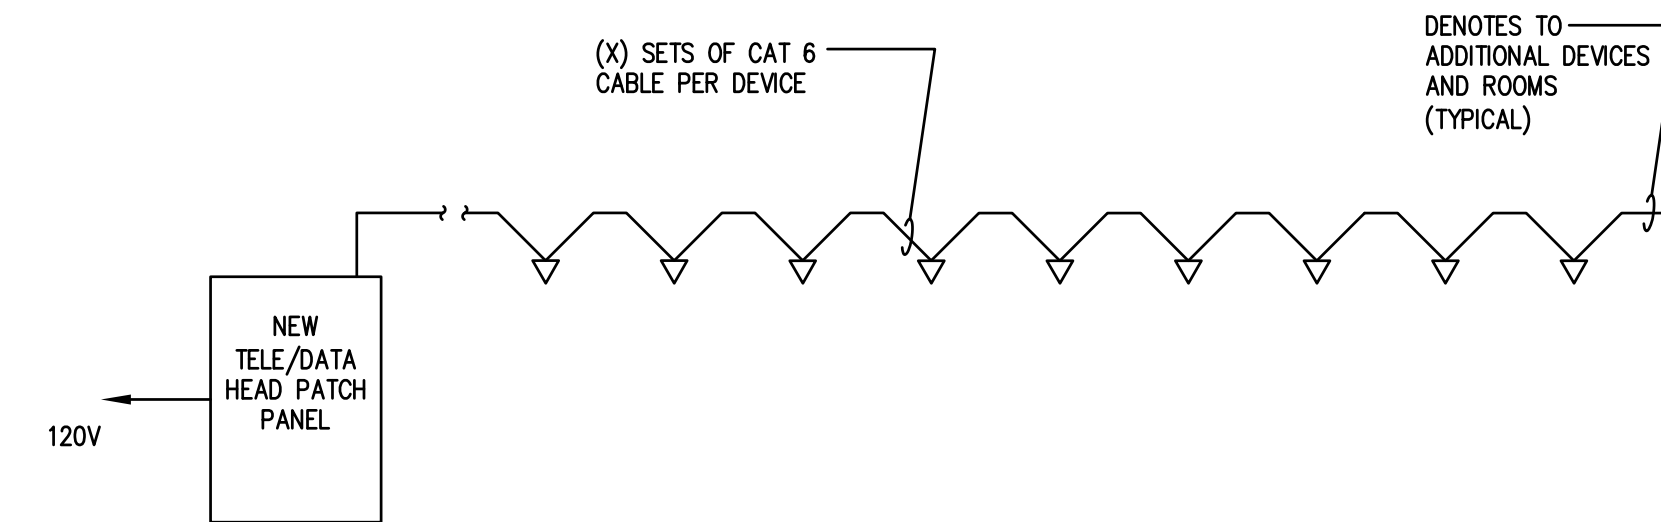

2 PARTIAL TELE/DATA DIAGRAM
SCALE: NOT TO SCALE


208/120 VOLT, 3-PHASE, 4-WIRE PANELBOARD SCHEDULE												
SECTION 1										CP261		
PROJECT: Maine Medical Center Pavilion 6 Renovation		BY: JDA		DATE: 9/10/2009		PANEL NAME: CP261		PANEL LOCATION: *56* 6th elec. Clos.		FED FROM: XXXXXXXX VIA: XXXXXX		
PANELBOARD DATA												
VOLTS-PHASE	MAINS	BUS AMPS	AIC	# OF POLES	MOUNTING	NEMA TYPE						
208/120 V, 3-PH, 4-W	MLO	225A	FEDTRHU	22,000A	84 (1-42)	SURFACE	NEMA 1					
Codes: R=Receptacle, L=Lighting, M=Motor, T=Transformer, H=Heater, A=AC, C=Computer, E=Equipment, O=Other, SPR=Spares, SPC=Space												
CKT #	DESCRIPTION	KW LOAD	CKT BREAKER	PHASE A	PHASE B	PHASE C	CKT BREAKER	KW LOAD	DESCRIPTION	CKT #		
1	r patient room 686	0.800	GF-20A / 1P	1.40			20A / 1P	0.600	ref	e 2		
3	r patient room 683	0.800	GF-20A / 1P		1.40		20A / 1P	0.600	ref	e 4		
5	r patient room 684	0.800	GF-20A / 1P			1.40	20A / 1P	0.600	micro	e 6		
7	r patient room 681	0.800	GF-20A / 1P	1.40			20A / 1P	0.600	ice	e 8		
9	r patient room 682	0.800	GF-20A / 1P		2.80		30A	2.000	stacked washer/dryer	e 10		
11	e seclusion 680 shower/toile	0.600	20A / 1P			2.60	/2P	2.000	(30a-2p)	e 12		
13	e pyxk	1.000	20A / 1P	2.00			GF-20A / 1P	1.000	plasma screen	e 14		
15	e ulc ref	1.000	20A / 1P		2.00		20A / 1P	1.000	observation monitor system	e 16		
17	e ulc ref	1.000	20A / 1P		2.00		20A / 1P	1.000	crash cart/cup	r 18		
19	r med computers	0.540	20A / 1P	1.54			20A / 1P	1.000	plugmold	r 20		
21	r charting recept	0.540	20A / 1P		1.26		20A / 1P	0.720	unit secretary recept	r 22		
23	r charting recept	0.540	20A / 1P			1.26	20A / 1P	0.720	unit secretary recept	r 24		
25	e p-tube	1.000	20A / 1P	1.60			20A / 1P	0.600	copier	e 26		
27	r patient room 677	0.800	GF-20A / 1P		1.40		GF-20A / 1P	0.600	patient room 673	SPR 28		
29	r patient room 676	0.800	GF-20A / 1P			1.40	GF-20A / 1P	0.600	patient room 672	SPR 30		
31	r patient room 675	0.800	GF-20A / 1P	1.40			GF-20A / 1P	0.600	patient room 671	SPR 32		
33	r patient room 674	0.800	GF-20A / 1P		1.40		GF-20A / 1P	0.600	patient room 670	SPR 34		
35	SPR spare	0.600	20A / 1P			1.20	20A / 1P	0.600	SPR spare	SPR 36		
37	SPR spare	0.600	20A / 1P		1.20		20A / 1P	0.600	SPR spare	SPR 38		
39	SPR spare	0.600	20A / 1P		1.20		20A / 1P	0.600	SPR spare	SPR 40		
41	SPR spare	0.600	20A / 1P		1.20		20A / 1P	0.600	SPR spare	SPR 42		

208/120 VOLT, 3-PHASE, 4-WIRE PANELBOARD SCHEDULE											
SECTION 1										LSP261	
PROJECT: Maine Medical Center Pavilion 6 Renovation		BY: JDA		DATE: 9/10/2009		PANEL NAME: LSP261		PANEL LOCATION: *56* 6th elec. Clos.		FED FROM: XXXXXXXX VIA: XXXXXX	
PANELBOARD DATA											
VOLTS-PHASE	MAINS	BUS AMPS	AIC	# OF POLES	MOUNTING	NEMA TYPE					
208/120 V, 3-PH, 4-W	MLO	100A	10,000A	12	SURFACE	NEMA 1					
Codes: R=Receptacle, L=Lighting, M=Motor, T=Transformer, H=Heater, A=AC, C=Computer, E=Equipment, O=Other, SPR=Spares, SPC=Space											
CKT #	DESCRIPTION	KW LOAD	CKT BREAKER	PHASE A	PHASE B	PHASE C	CKT BREAKER	KW LOAD	DESCRIPTION	CKT #	
1	E abc	1.000	20A / 1P	1.60			20A / 1P	0.600	security/door access	e 2	
3	e nursecall	1.000	20A / 1P		1.60		20A / 1P	0.600	security/door access	e 4	
5	e fatb	1.000	20A / 1P			1.10	20A / 1P	0.100	corridor exts	I 6	
7	I corridor lights	1.000	20A / 1P	1.60			20A / 1P	0.600	SPR spare	SPR 8	
9	SPR spare	0.600	20A / 1P		1.20		20A / 1P	0.600	SPR spare	SPR 10	
11	SPR spare	0.600	20A / 1P		1.20		20A / 1P	0.600	SPR spare	SPR 12	


208/120 VOLT, 3-PHASE, 4-WIRE PANELBOARD SCHEDULE											
SECTION 1										PP262	
PROJECT: Maine Medical Center Pavilion 6 Renovation		BY: JDA		DATE: 9/10/2009		PANEL NAME: PP262		PANEL LOCATION: *29* 6th elec. Clos.		FED FROM: XXXXXXXX VIA: XXXXXX	
PANELBOARD DATA											
VOLTS-PHASE	MAINS	BUS AMPS	AIC	# OF POLES	MOUNTING	NEMA TYPE					
208/120 V, 3-PH, 4-W	SELECT	SELECT	SELECT	SELECT	SELECT	SELECT					
Codes: R=Receptacle, L=Lighting, M=Motor, T=Transformer, H=Heater, A=AC, C=Computer, E=Equipment, O=Other, SPR=Spares, SPC=Space											
CKT #	DESCRIPTION	KW LOAD	CKT BREAKER	PHASE A	PHASE B	PHASE C	CKT BREAKER	KW LOAD	DESCRIPTION	CKT #	
1	r office 6230	0.900	20A / 1P	1.90			20A / 1P	1.000	charting station	e 2	
3	r office 6228	0.900	20A / 1P		1.90		20A / 1P	1.000	charting station (gfci brkr)	e 4	
5	r office 6226	0.900	20A / 1P			1.90	GF-20A / 1P	1.000	charting station	e 6	
7	r corridor receptacles	1.080	GF-20A / 1P	2.08			20A / 1P	1.000	charting station	e 8	
9	r office 6224	0.900	20A / 1P		1.90		20A / 1P	1.000	charting station (gfci brkr)	e 10	
11	r office 6222	0.900	20A / 1P			1.90	20A / 1P	1.000	charting station	e 12	
13	r office 6229	0.720	20A / 1P	1.72			20A / 1P	1.000	charting station	e 14	
15	r office 6229	0.600	20A / 1P		1.50		20A / 1P	0.900	office 6215	r 16	
17	r office 6227	0.900	20A / 1P			1.90	GF-20A / 1P	1.000	door closer	e 18	
19	r office 6225	0.900	20A / 1P	1.62			GF-20A / 1P	0.720	dining area	r 20	
21	r office 6223	0.900	20A / 1P		1.62		GF-20A / 1P	0.720	dining area	r 22	
23	r office 6221	0.900	20A / 1P			1.90	20A / 1P	1.000	break room ref	r 24	
25	r general recept	0.600	20A / 1P	1.60			20A / 1P	1.000	break room micro	r 26	
27	r coffee	1.000	20A / 1P		2.00		20A / 1P	1.000	break room	r 28	
29	r soda	1.000	20A / 1P			2.08	20A / 1P	1.080	kitchen recept	r 30	
31	r toaster	1.000	20A / 1P	2.08			20A / 1P	1.080	kitchen recept	r 32	
33	r counter	0.600	20A / 1P		1.60		20A / 1P	1.000	dishwasher	SPR 34	
35	SPR spare	0.600	20A / 1P			1.20	20A / 1P	0.600	SPR spare	SPR 36	
37	SPR spare	0.600	20A / 1P		1.20		20A / 1P	0.600	SPR spare	SPR 38	
39	SPR spare	0.600	20A / 1P		1.20		20A / 1P	0.600	SPR spare	SPR 40	
41	SPR spare	0.600	20A / 1P		1.20		20A / 1P	0.600	SPR spare	SPR 42	

208/120 VOLT, 3-PHASE, 4-WIRE PANELBOARD SCHEDULE											
SECTION 2										CP261	
PROJECT: Maine Medical Center Pavilion 6 Renovation		BY: JDA		DATE: 9/10/2009		PANEL NAME: CP261		PANEL LOCATION: *56* 6th elec. Clos.		FED FROM: XXXXXXXX VIA: XXXXXX	
PANELBOARD DATA											
VOLTS-PHASE	MAINS	BUS AMPS	AIC	# OF POLES	MOUNTING	NEMA TYPE					
208/120 V, 3-PH, 4-W	MLO	225A	22,000A	84 (14-84)	SELECT	SELECT					
Codes: R=Receptacle, L=Lighting, M=Motor, T=Transformer, H=Heater, A=AC, C=Computer, E=Equipment, O=Other, SPR=Spares, SPC=Space											
CKT #	DESCRIPTION	KW LOAD	CKT BREAKER	PHASE A	PHASE B	PHASE C	CKT BREAKER	KW LOAD	DESCRIPTION	CKT #	
43	I patient room lighting	0.900	20A / 1P	1.35			20A / 1P	0.450	patient room lighting	I 44	
45	I patient room lighting	0.900	20A / 1P		1.90		20A / 1P	1.000	patient room lighting	SPR 46	
47	r seclusion room recept	0.540	20A / 1P			1.14	20A / 1P	0.600	SPR spare	SPR 48	
49	SPR spare	0.600	20A / 1P		1.20		20A / 1P	0.600	SPR spare	SPR 50	
51	SPR spare	0.600	20A / 1P		1.20		20A / 1P	0.600	SPR spare	SPR 52	
53	SPR spare	0.600	20A / 1P		1.20		20A / 1P	0.600	SPR spare	SPR 54	
55	SPR spare	0.600	20A / 1P		1.20		20A / 1P	0.600	SPR spare	SPR 56	
57	SPR spare	0.600	20A / 1P		1.20		20A / 1P	0.600	SPR spare	SPR 58	
59	SPR spare	0.600	20A / 1P		1.20		20A / 1P	0.600	SPR spare	SPR 60	
61	SPR spare	0.600	20A / 1P		1.20		20A / 1P	0.600	SPR spare	SPR 62	
63	SPR spare	0.600	20A / 1P		1.20		20A / 1P	0.600	SPR spare	SPR 64	
65	SPR spare	0.600	20A / 1P		1.20		20A / 1P	0.600	SPR spare	SPR 66	
67	SPR spare	0.600	20A / 1P		1.20		20A / 1P	0.600	SPR spare	SPR 68	
69	SPR spare	0.600	20A / 1P		1.20		20A / 1P	0.600	SPR spare	SPR 70	
71	SPR spare	0.600	20A / 1P		1.20		20A / 1P	0.600	SPR spare	SPR 72	
73	SPR spare	0.600	20A / 1P		1.20		20A / 1P	0.600	SPR spare	SPR 74	
75	SPR spare	0.600	20A / 1P		1.20		20A / 1P	0.600	SPR spare	SPR 76	
77	SPR spare	0.600	20A / 1P		1.20		20A / 1P	0.600	SPR spare	SPR 78	
79	SPR spare	0.600	20A / 1P		1.20		20A / 1P	0.600	SPR spare	SPR 80	
81	SPR spare	0.600	20A / 1P		1.20		20A / 1P	0.600	SPR spare	SPR 82	
83	SPR spare	0.600	20A / 1P		1.20		20A / 1P	0.600	SPR spare	SPR 84	


208/120 VOLT, 3-PHASE, 4-WIRE PANELBOARD SCHEDULE											
SECTION 1										PP261	
PROJECT: Maine Medical Center Pavilion 6 Renovation		BY: JDA		DATE: 9/10/2009		PANEL NAME: PP261		PANEL LOCATION: *56* 6th elec. Clos.		FED FROM: XXXXXXXX VIA: XXXXXX	
PANELBOARD DATA											
VOLTS-PHASE	MAINS	BUS AMPS	AIC	# OF POLES	MOUNTING	NEMA TYPE					
208/120 V, 3-PH, 4-W	SELECT	SELECT	SELECT	SELECT	SELECT	SELECT					
Codes: R=Receptacle, L=Lighting, M=Motor, T=Transformer, H=Heater, A=AC, C=Computer, E=Equipment, O=Other, SPR=Spares, SPC=Space											
CKT #	DESCRIPTION	KW LOAD	CKT BREAKER	PHASE A	PHASE B	PHASE C	CKT BREAKER	KW LOAD	DESCRIPTION	CKT #	
1	r corridor recept	1.260	20A / 1P	1.98			GF-20A / 1P	0.720	patient room 686	r 2	
3	r exam room	0.720	20A / 1P		1.44		GF-20A / 1P	0.720	patient room 683	r 4	
5	r back of house	0.600	20A / 1P			1.32	GF-20A / 1P	0.720	patient room 684	r 6	
7	r tel back board	0.720	20A / 1P	1.44			GF-20A / 1P	0.720	patient room 681	r 8	
9	r charting recept	0.720	20A / 1P		1.44		GF-20A / 1P	0.720	patient room 682	r 10	
11	r charting recept	0.900	20A / 1P			1.62	GF-20A / 1P	0.720	patient room 677	r 12	
13	r unit secretary recept	0.720	20A / 1P	1.44			GF-20A / 1P	0.720	patient room 676	r 14	
15	r unit secretary recept	0.720	20A / 1P		1.44		GF-20A / 1P	0.720	patient room 675	r 16	
17	L corridor lighting	1.000	20A / 1P			1.72	GF-20A / 1P	0.720	patient room 674	r 18	
19	I patient room lighting	1.100	20A / 1P		1.82		GF-20A / 1P	0.720	patient room 673	r 20	
21	I core area lighting	1.000	20A / 1P		1.72		GF-20A / 1P	0.720	patient room 672	r 22	
23	I patient room lighting	0.600	20A / 1P		1.32		GF-20A / 1P	0.720	patient room 671	r 24	
25	I patient room lighting	1.100	20A / 1P		1.82		GF-20A / 1P	0.720	patient room 670	r 26	
27	I patient room lighting	1.100	20A / 1P		1.70		20A / 1P	0.600	SPR spare	SPR 28	
29	SPR spare	0.600									

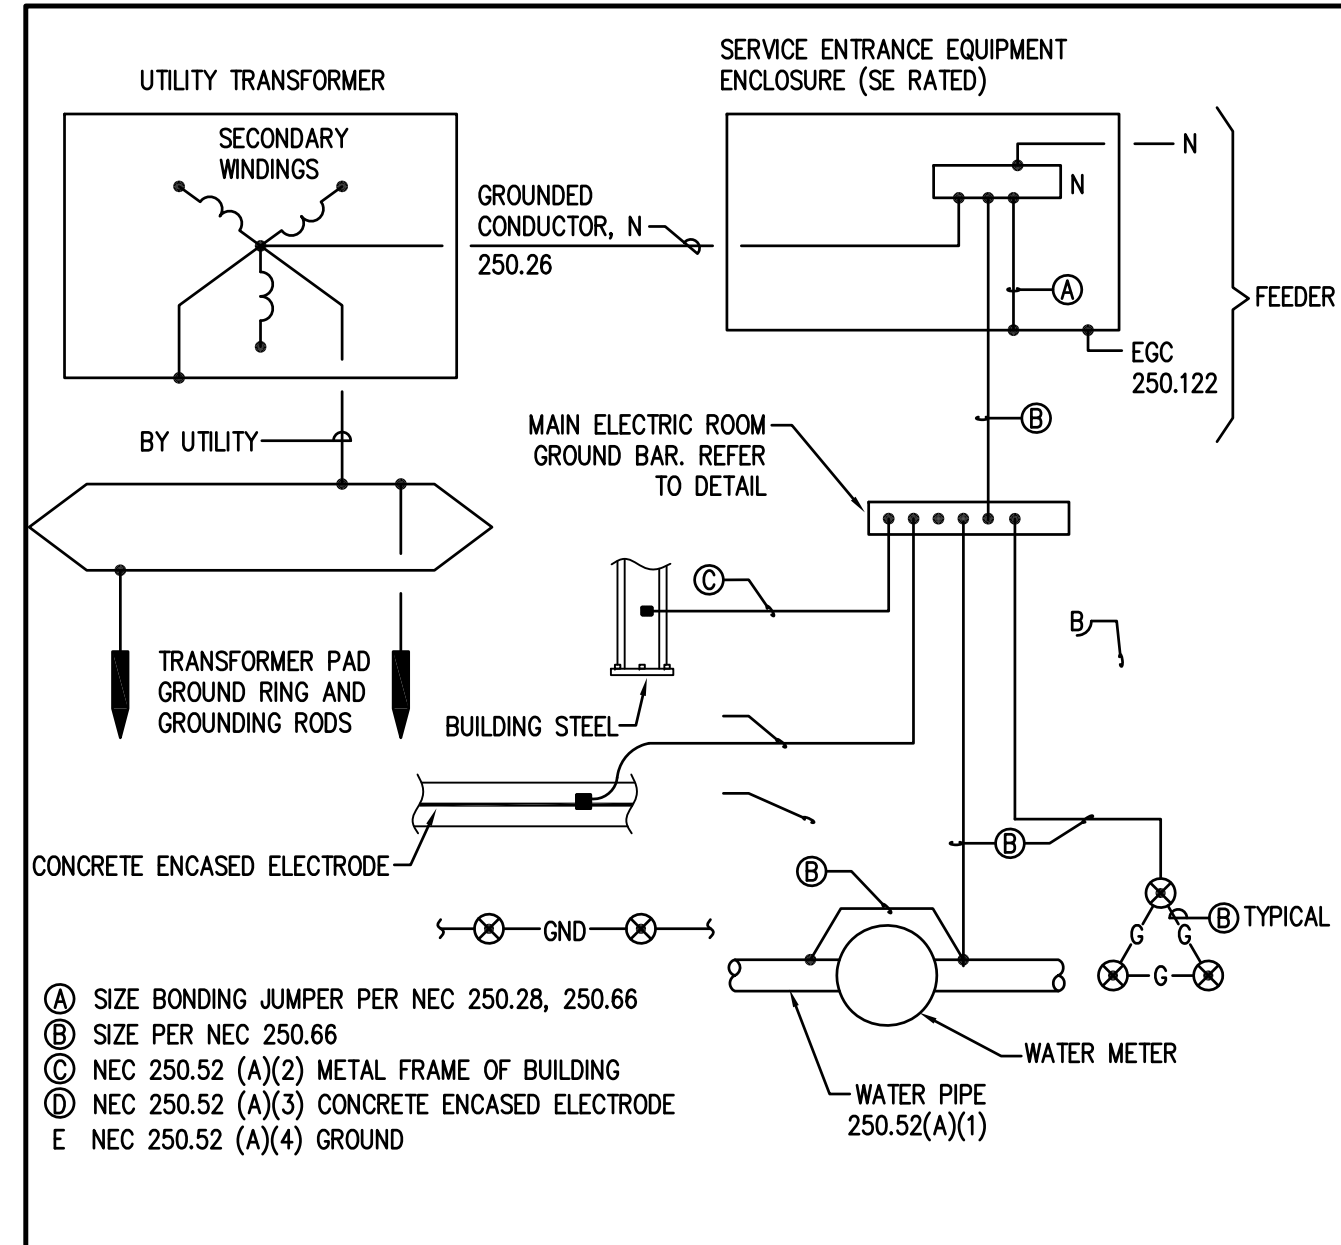


NEC UTILITY SERVICE ENTRANCE GROUNDING DETAIL ED-1
NONE

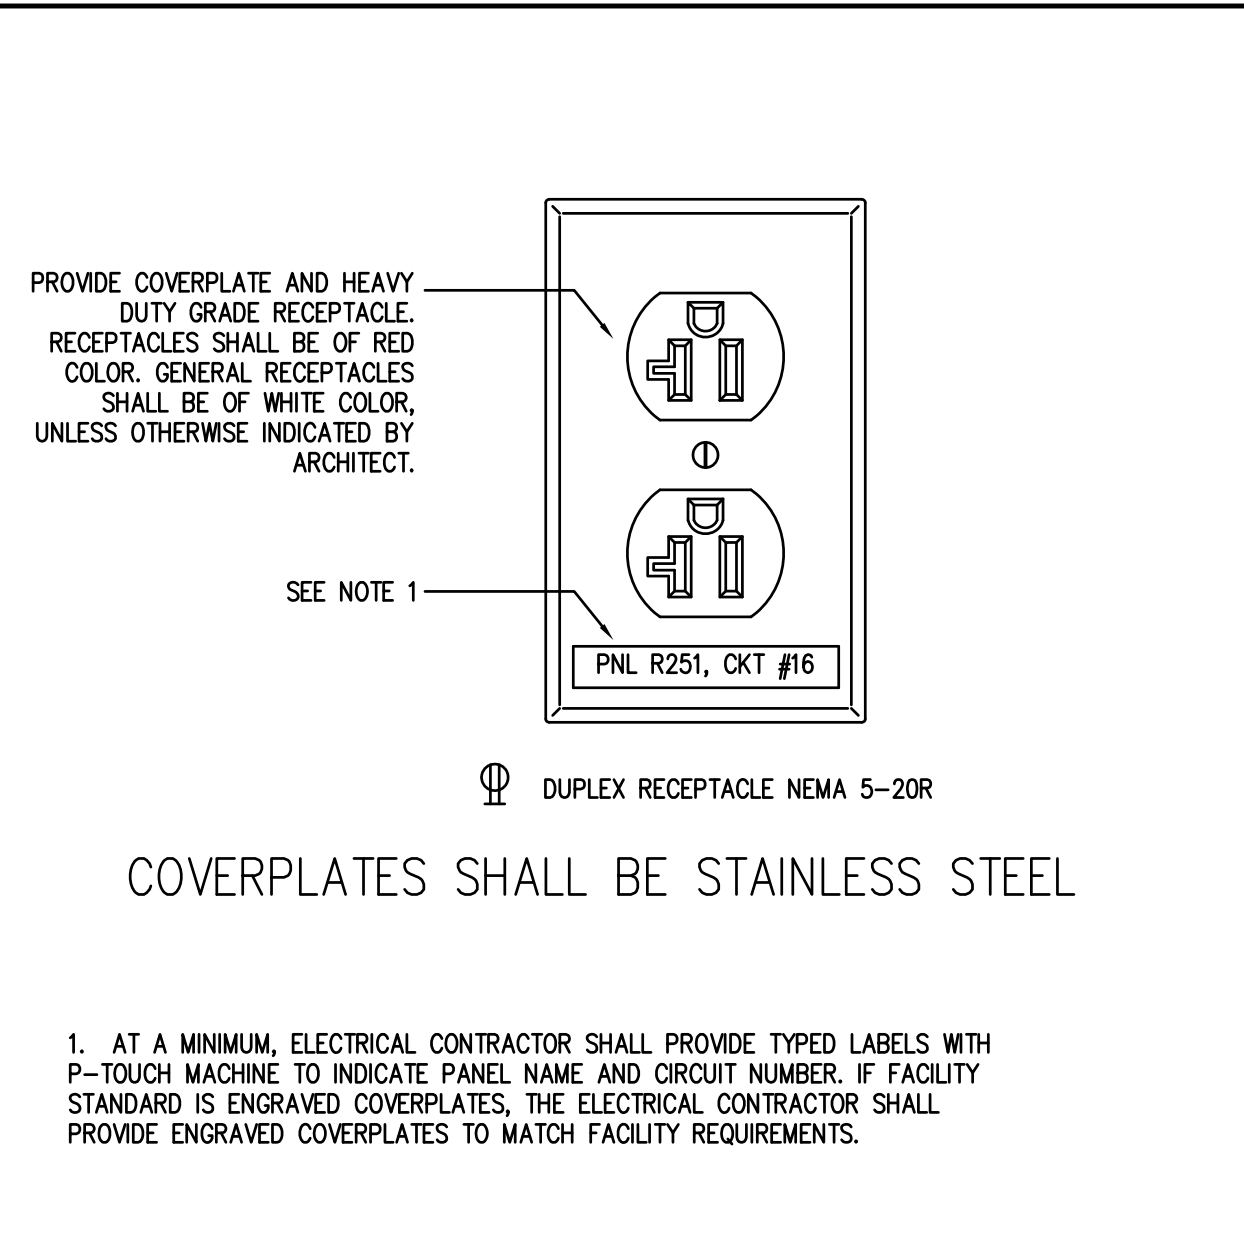


TYPICAL RECEPTACLE LABELING DETAIL ED-4
NONE

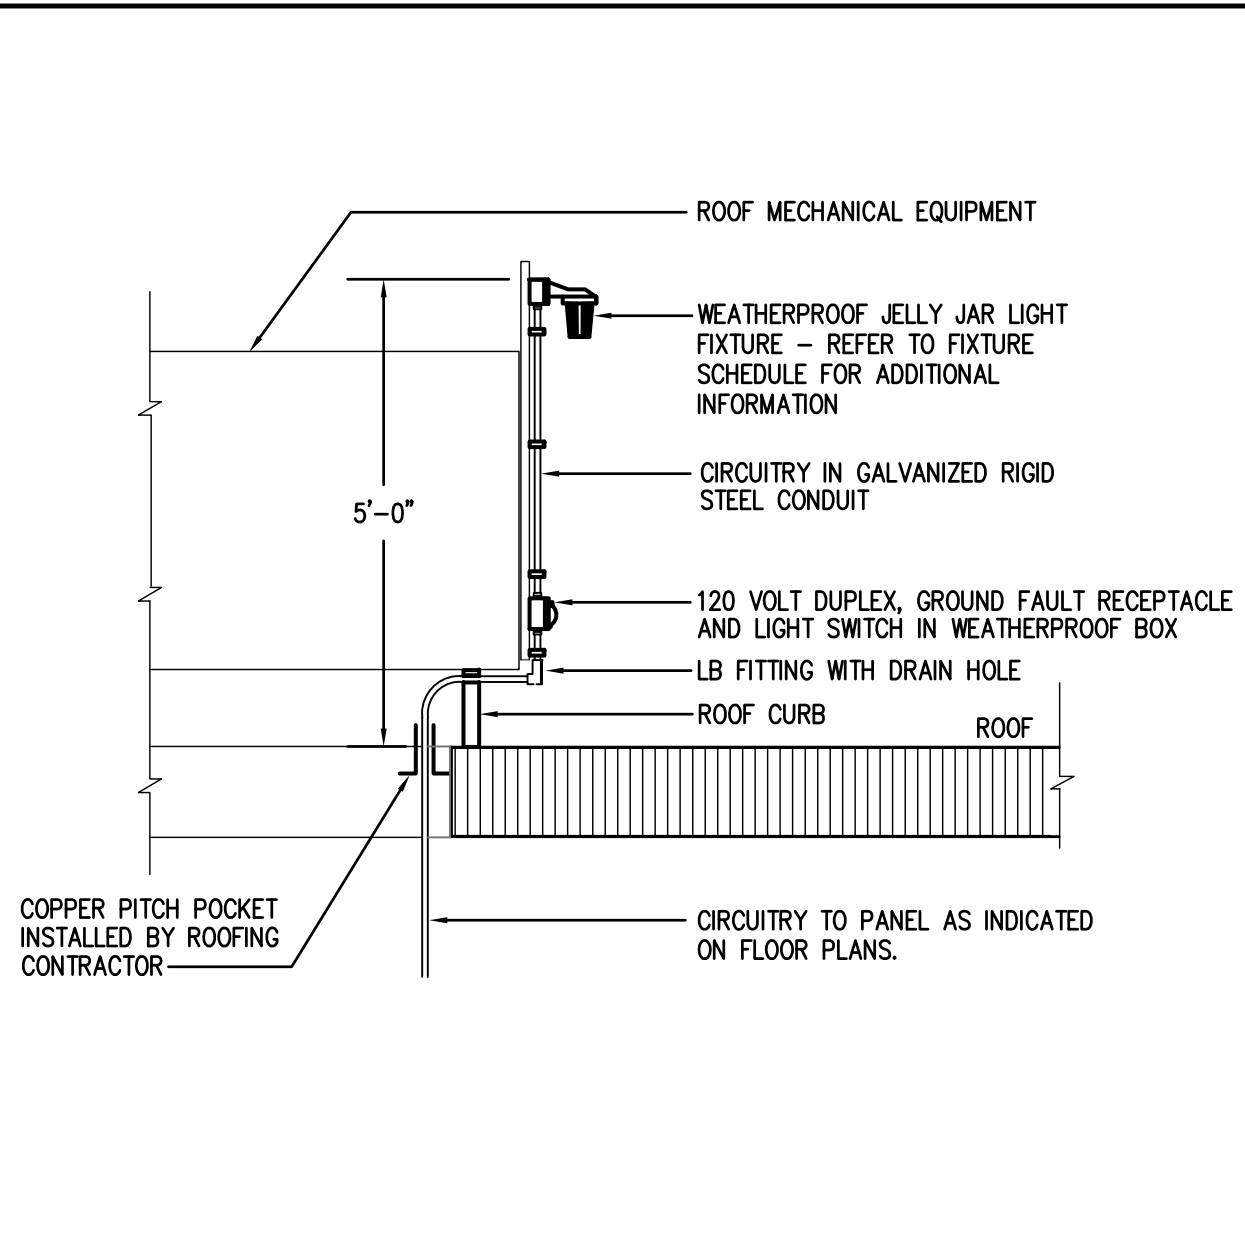


LIGHTING AND RECEPTACLE MOUNTING AT ROOFTOP EQUIPMENT ED-7
NONE

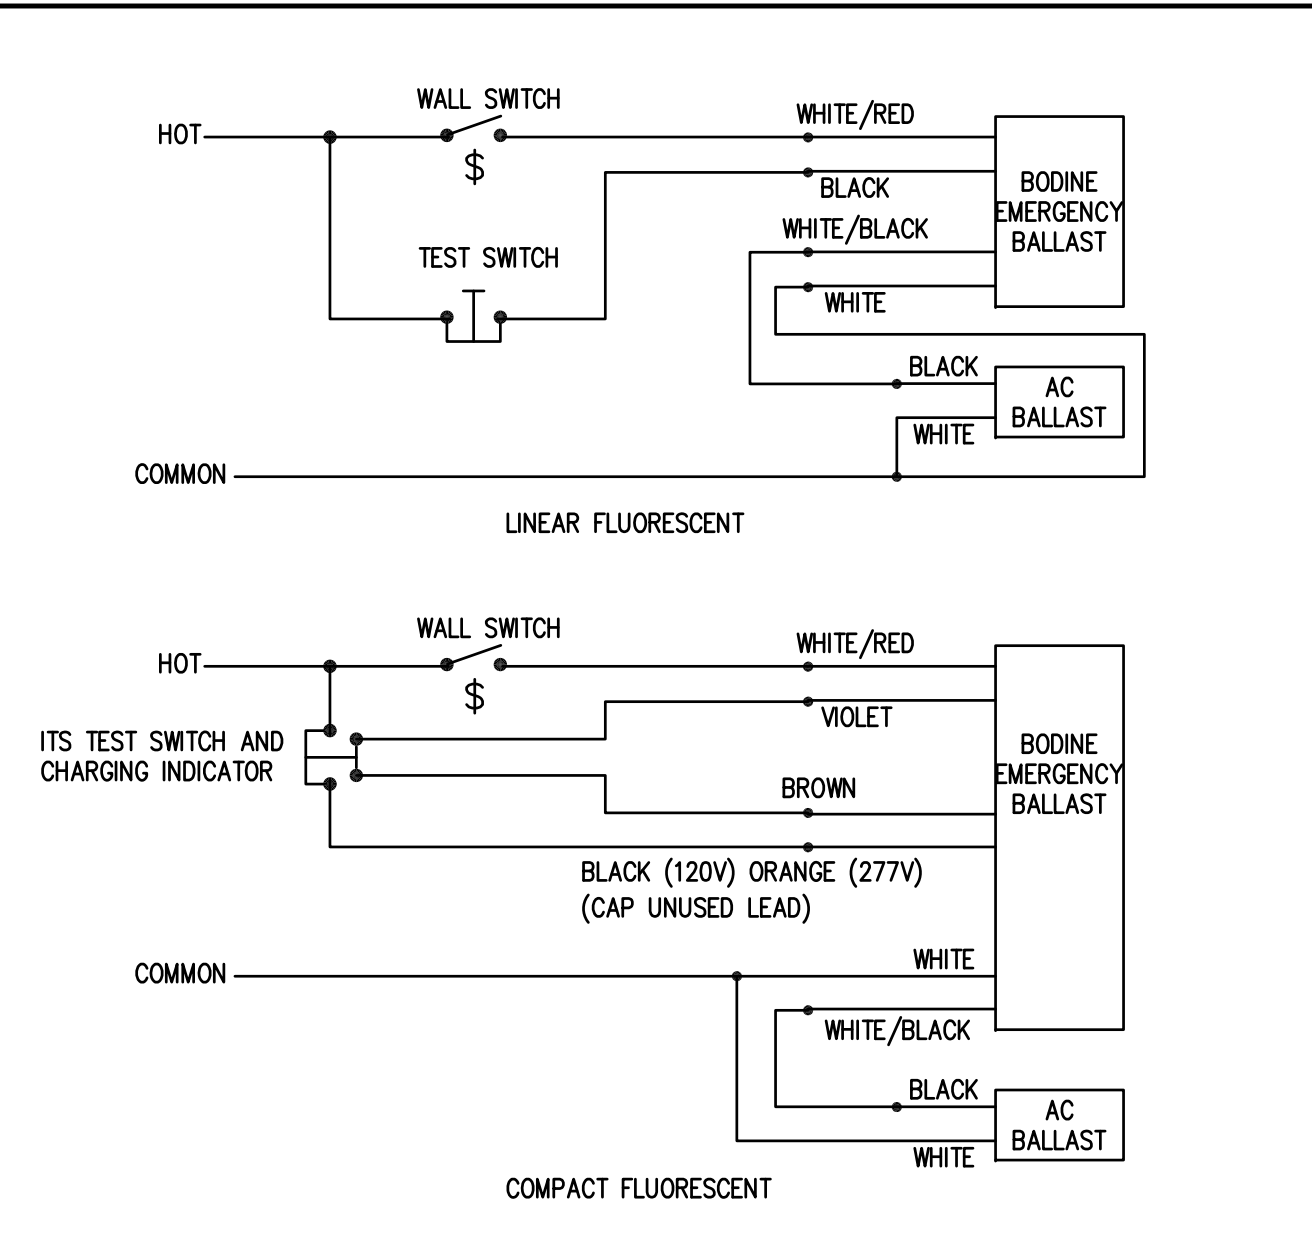


EMERGENCY BALLAST WIRING DIAGRAMS ED-10
NONE

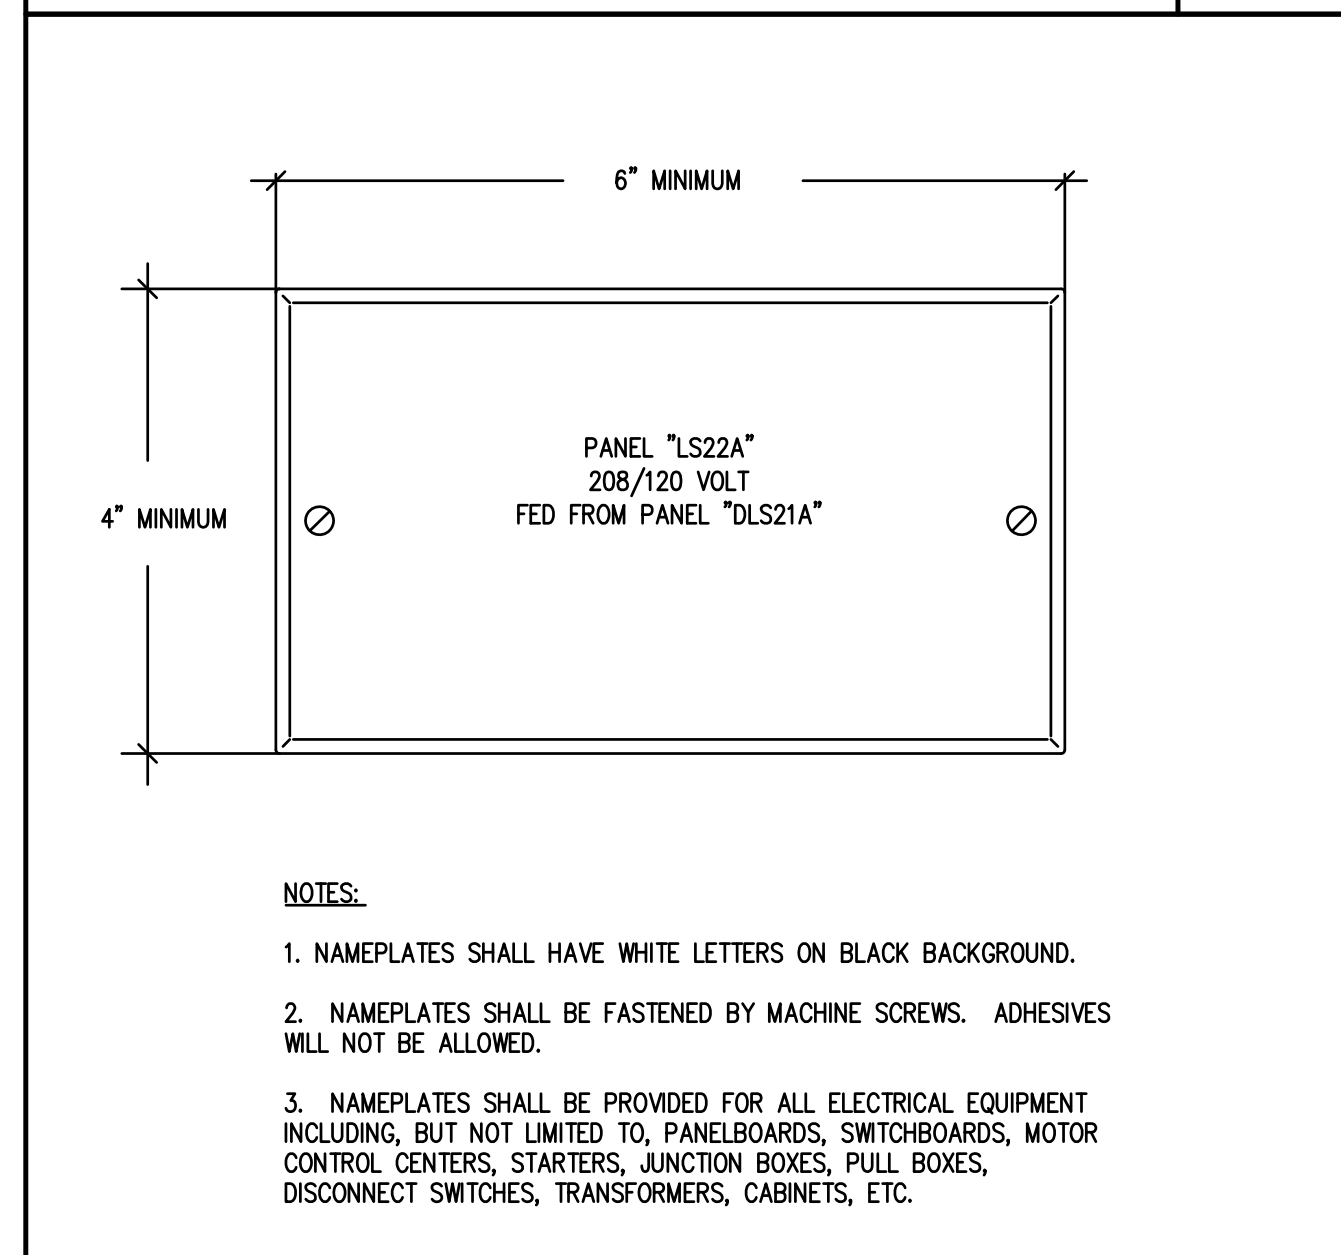


TYPICAL NAMEPLATE DETAIL ED-2
NONE

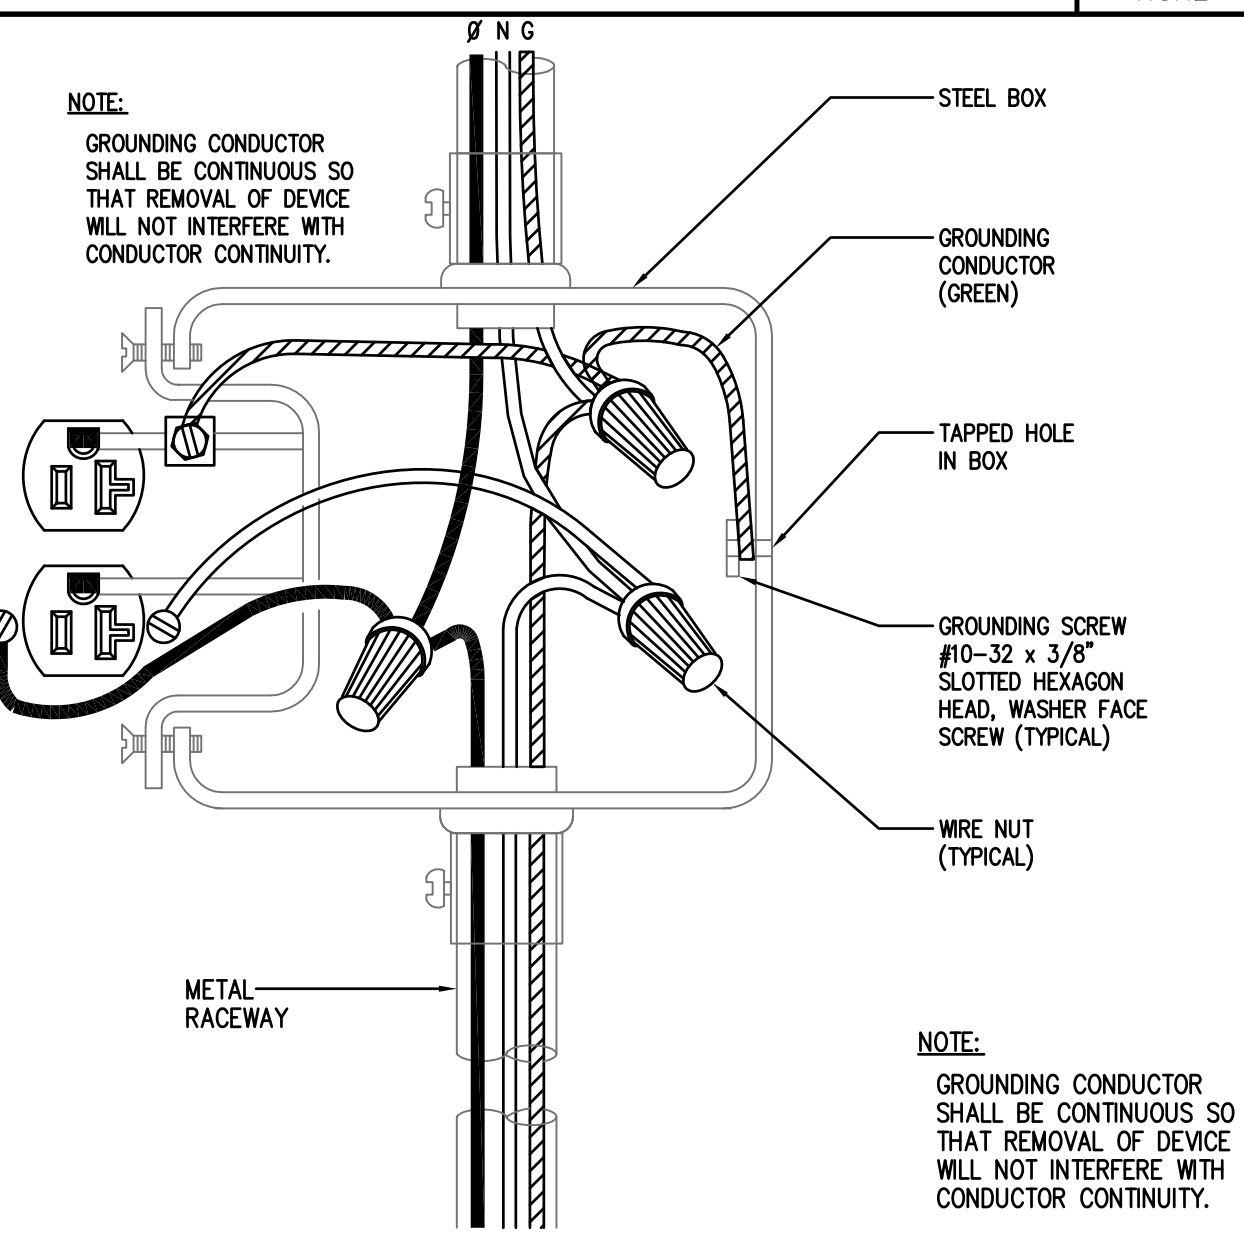


TYPICAL RECEPTACLE WIRING DETAIL ED-5
NONE

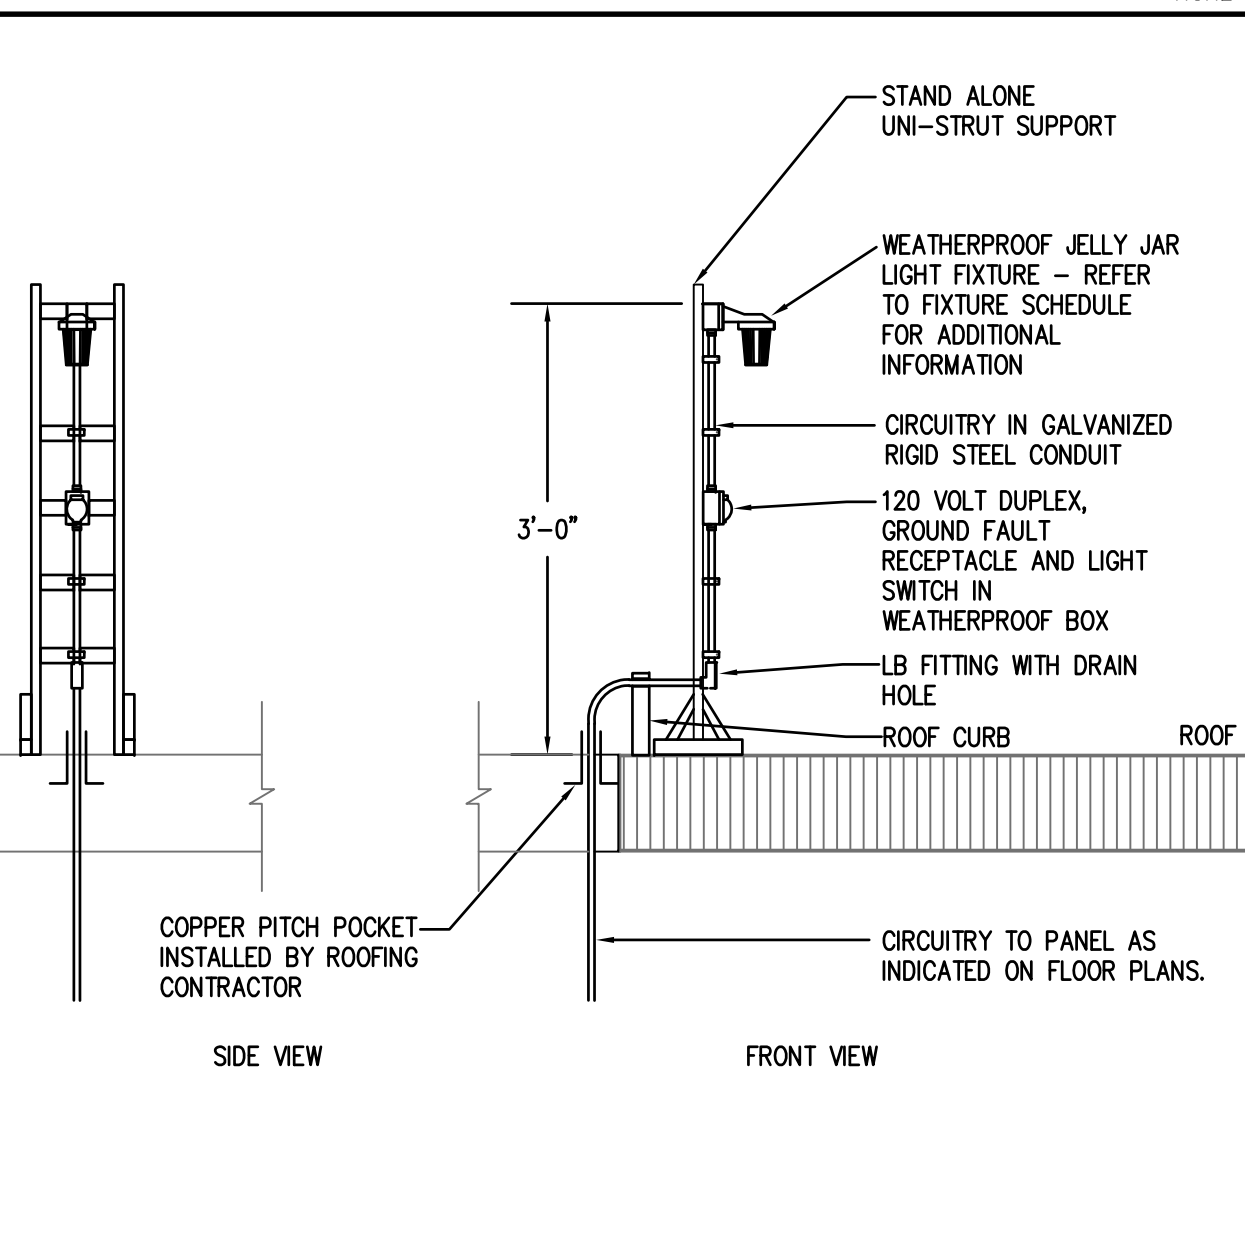


TYPICAL ROOFTOP EQUIPMENT RECEPTACLE AND LIGHTING DETAIL ED-8
NONE

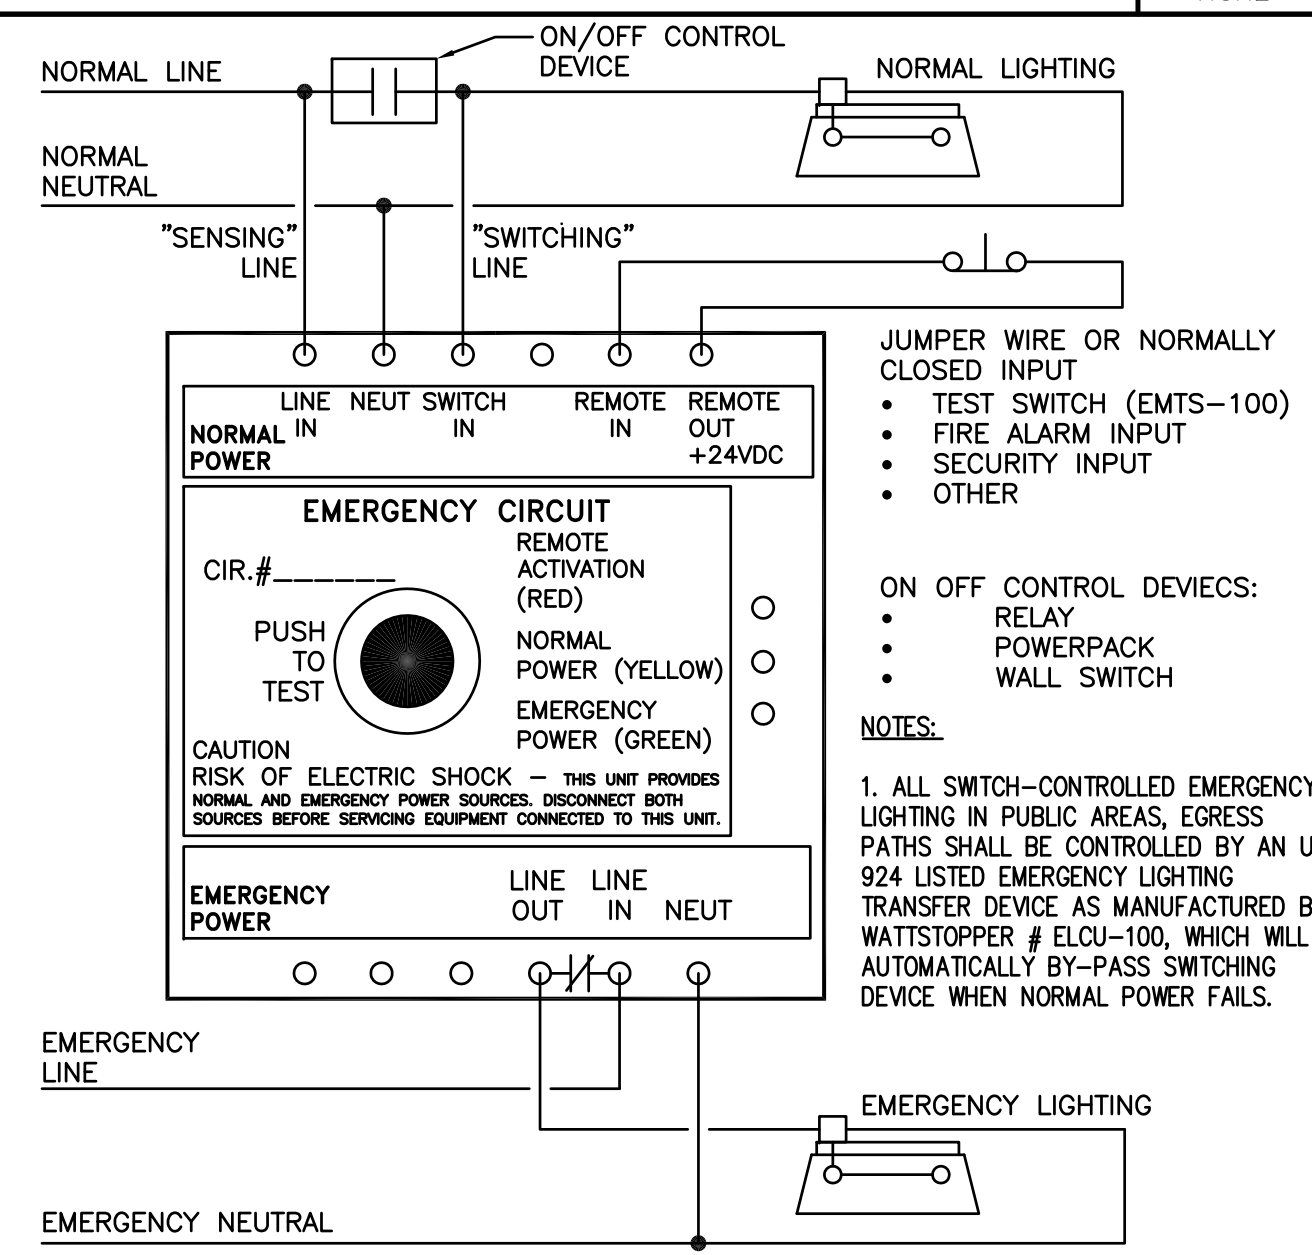


EMERGENCY LIGHTING TRANSFER DEVICE ED-11
NONE

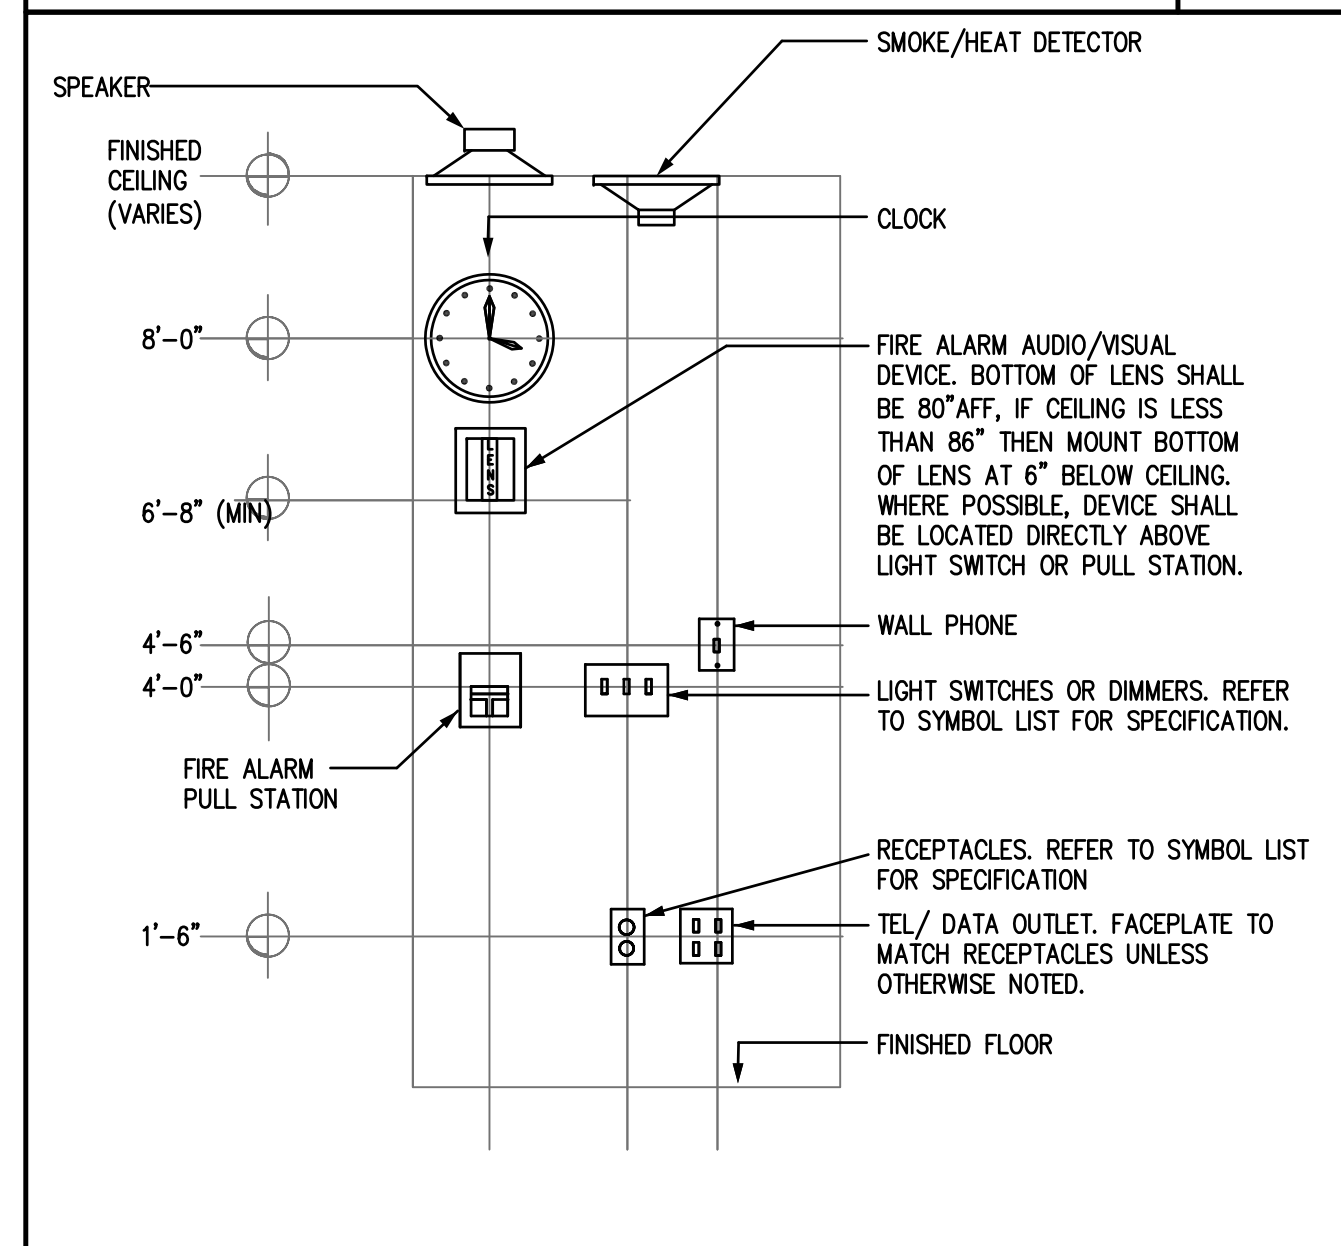


TYPICAL WALL DEVICE MOUNTING DETAIL ED-3
NONE

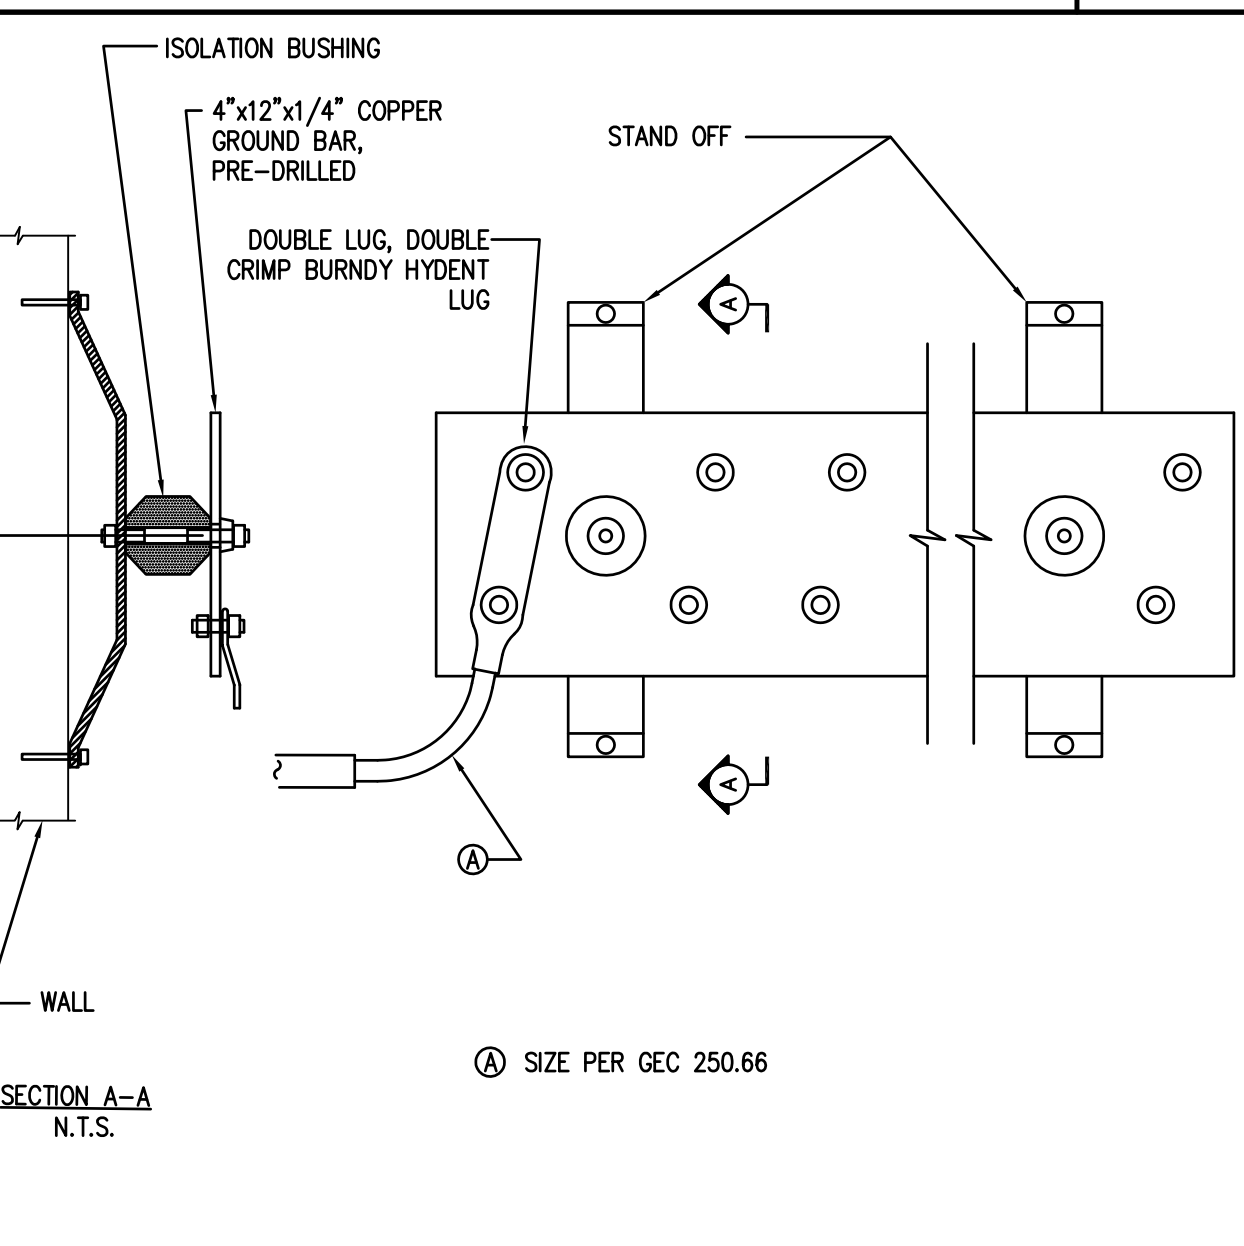


TYPICAL GROUND BAR DETAIL ED-6
NONE

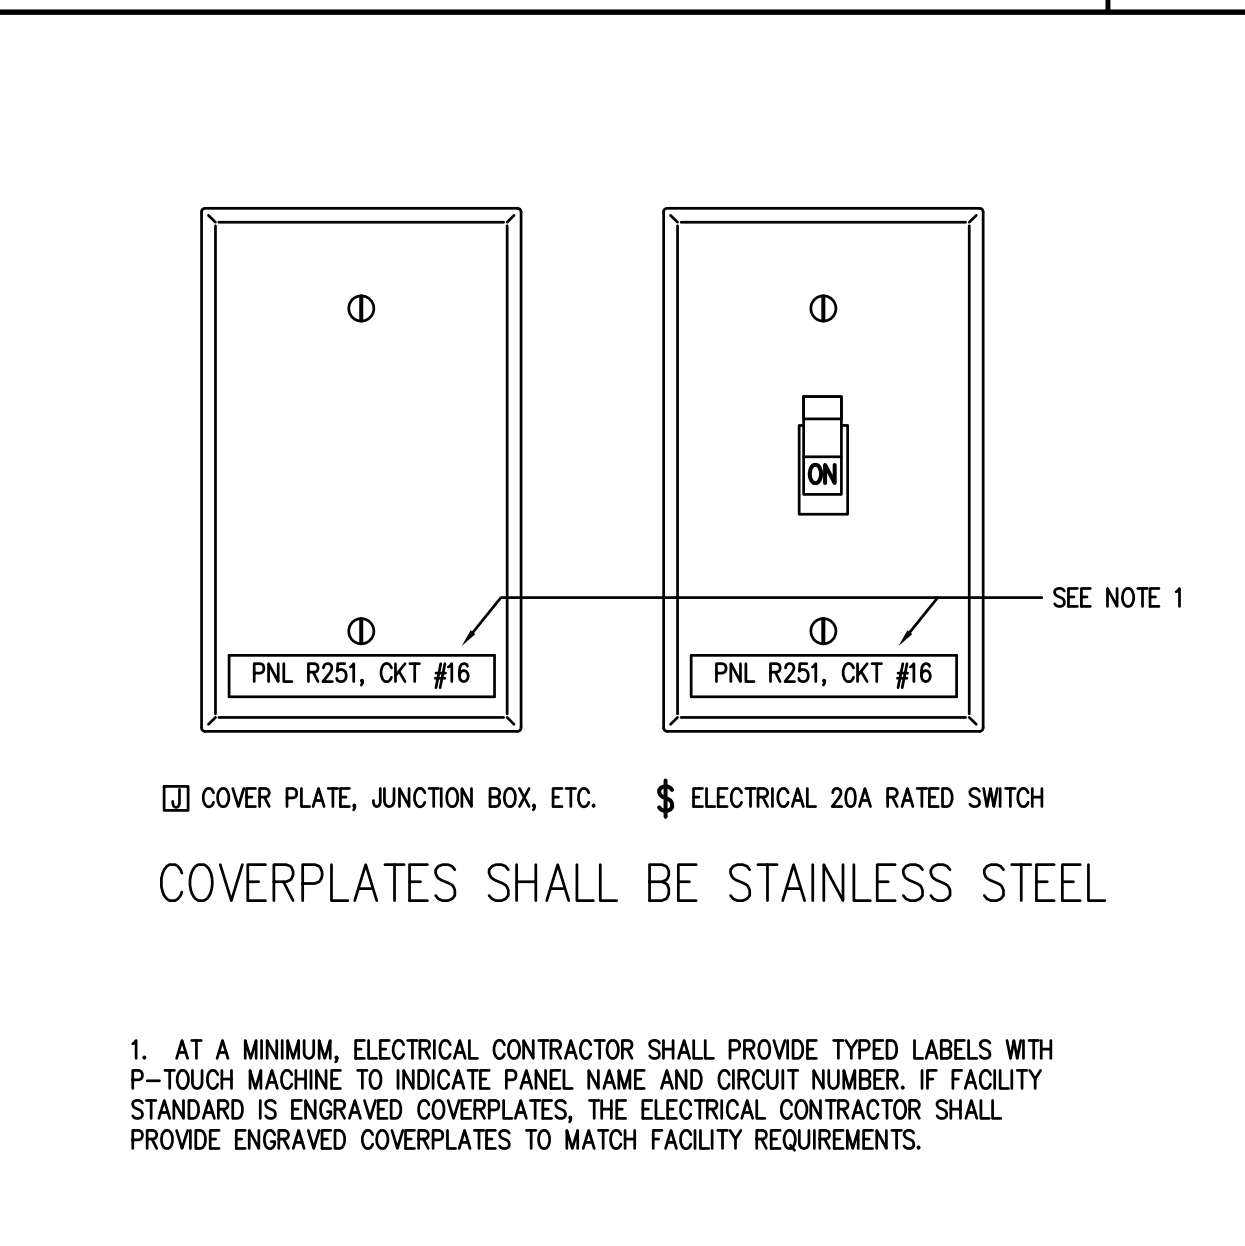

TYPICAL COVERPLATE AND SWITCH LABEL DETAIL ED-9
NONE

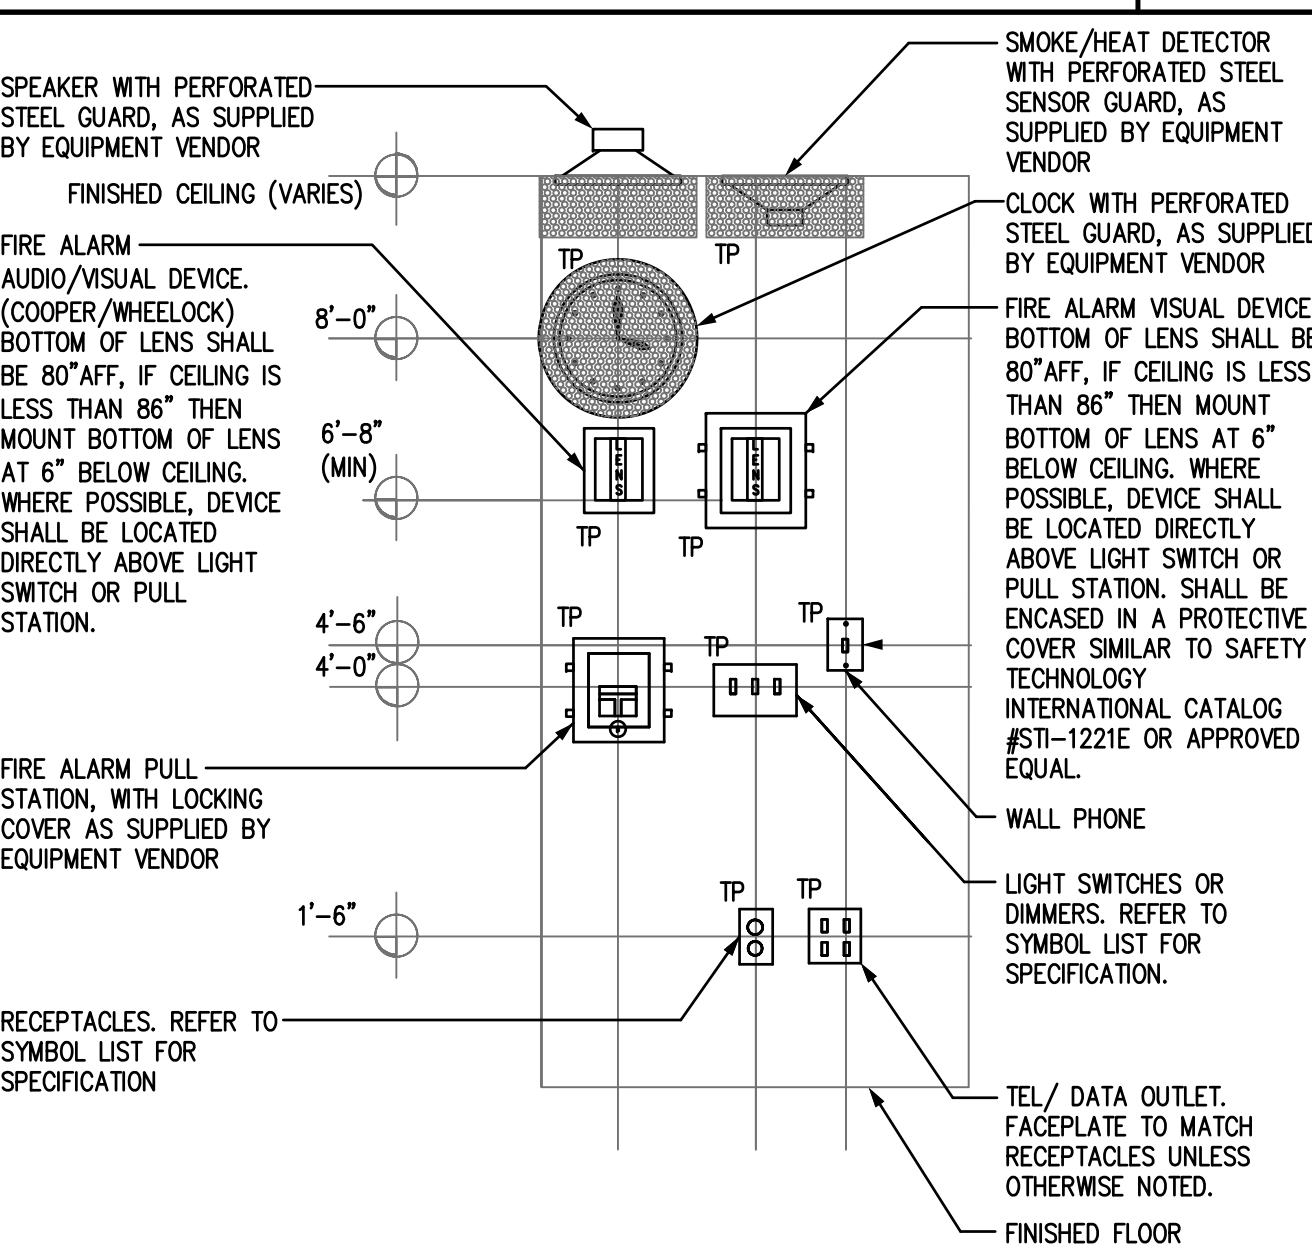

TYPICAL TAMPER-PROOF WALL MOUNTING DETAIL ED-12
NONE

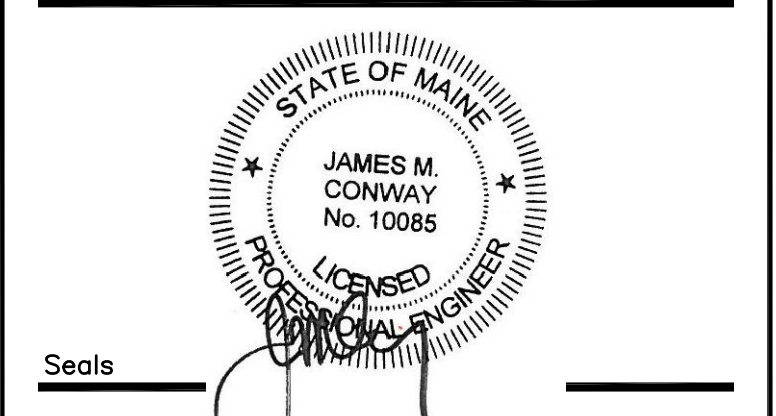

B structural engineers, **R** inc.
75 York Street
Portland, ME 04101-4701
info@beckerstructural.com


Tel 207-879-1838
Fax 207-879-1822
www.beckerstructural.com

Consultant

MECHANICAL / ELECTRICAL ENGINEERS
92 Montvale Ave, Suite 4100
Saco, ME 04158
Tel: 781-481-0210
Fax: 781-481-0203
email: info@f-t.com
www.f-t.com
Project No.: 09018.00

FITZMEYER & TOCCI ASSOCIATES, INC.

Consultant

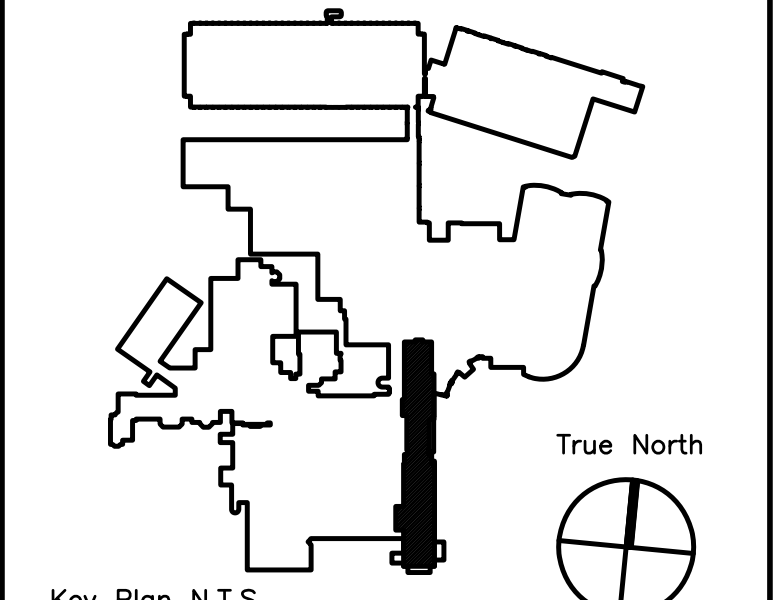


ADDENDUM#1	12/4/09	1
Revision	Date	No

Maine Medical Center
Portland, Maine

MAINE MEDICAL CENTER
PAVILION 6 RENOVATIONS

MorrisSwitzer Project Number 28034
Date 11/19/09
Scale NOT TO SCALE
Sheet Title and Number

SIXTH FLOOR PAVILIONS
"A" & "C" ELECTRICAL
DETAILS
3E5.0

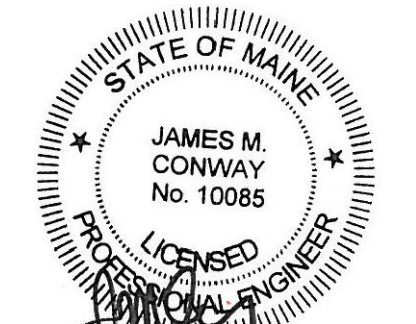

BECKER
structural engineers, inc.

75 York Street Portland, ME 04101-4701
info@beckerstructural.com

Tel: 207-879-1838
Fax: 207-879-1822
www.beckerstructural.com

Consultant

MECHANICAL / ELECTRICAL ENGINEERS

92 Montvale Ave, Suite 4100
Saco, MA 02180
Tel: 781-481-0210
Fax: 781-481-0203
email: info@f-t.com
www.f-t.com

FITZMEYER & TOCCI
ASSOCIATES, INC.

Project No.: 09018.00

Consultant

Key Plan N.T.S.


ADDENDUM#1	12/4/09	1
Revision	Date	No

Maine Medical Center
Portland, Maine

MAINE MEDICAL CENTER
PAVILION 6 RENOVATIONS

MorrisSwitzer Project Number 28034
Date 11/19/09
Scale NOT TO SCALE
Sheet Title and Number

SIXTH FLOOR PAVILIONS
"A" & "C" ELECTRICAL
DETAILS
3E5.1

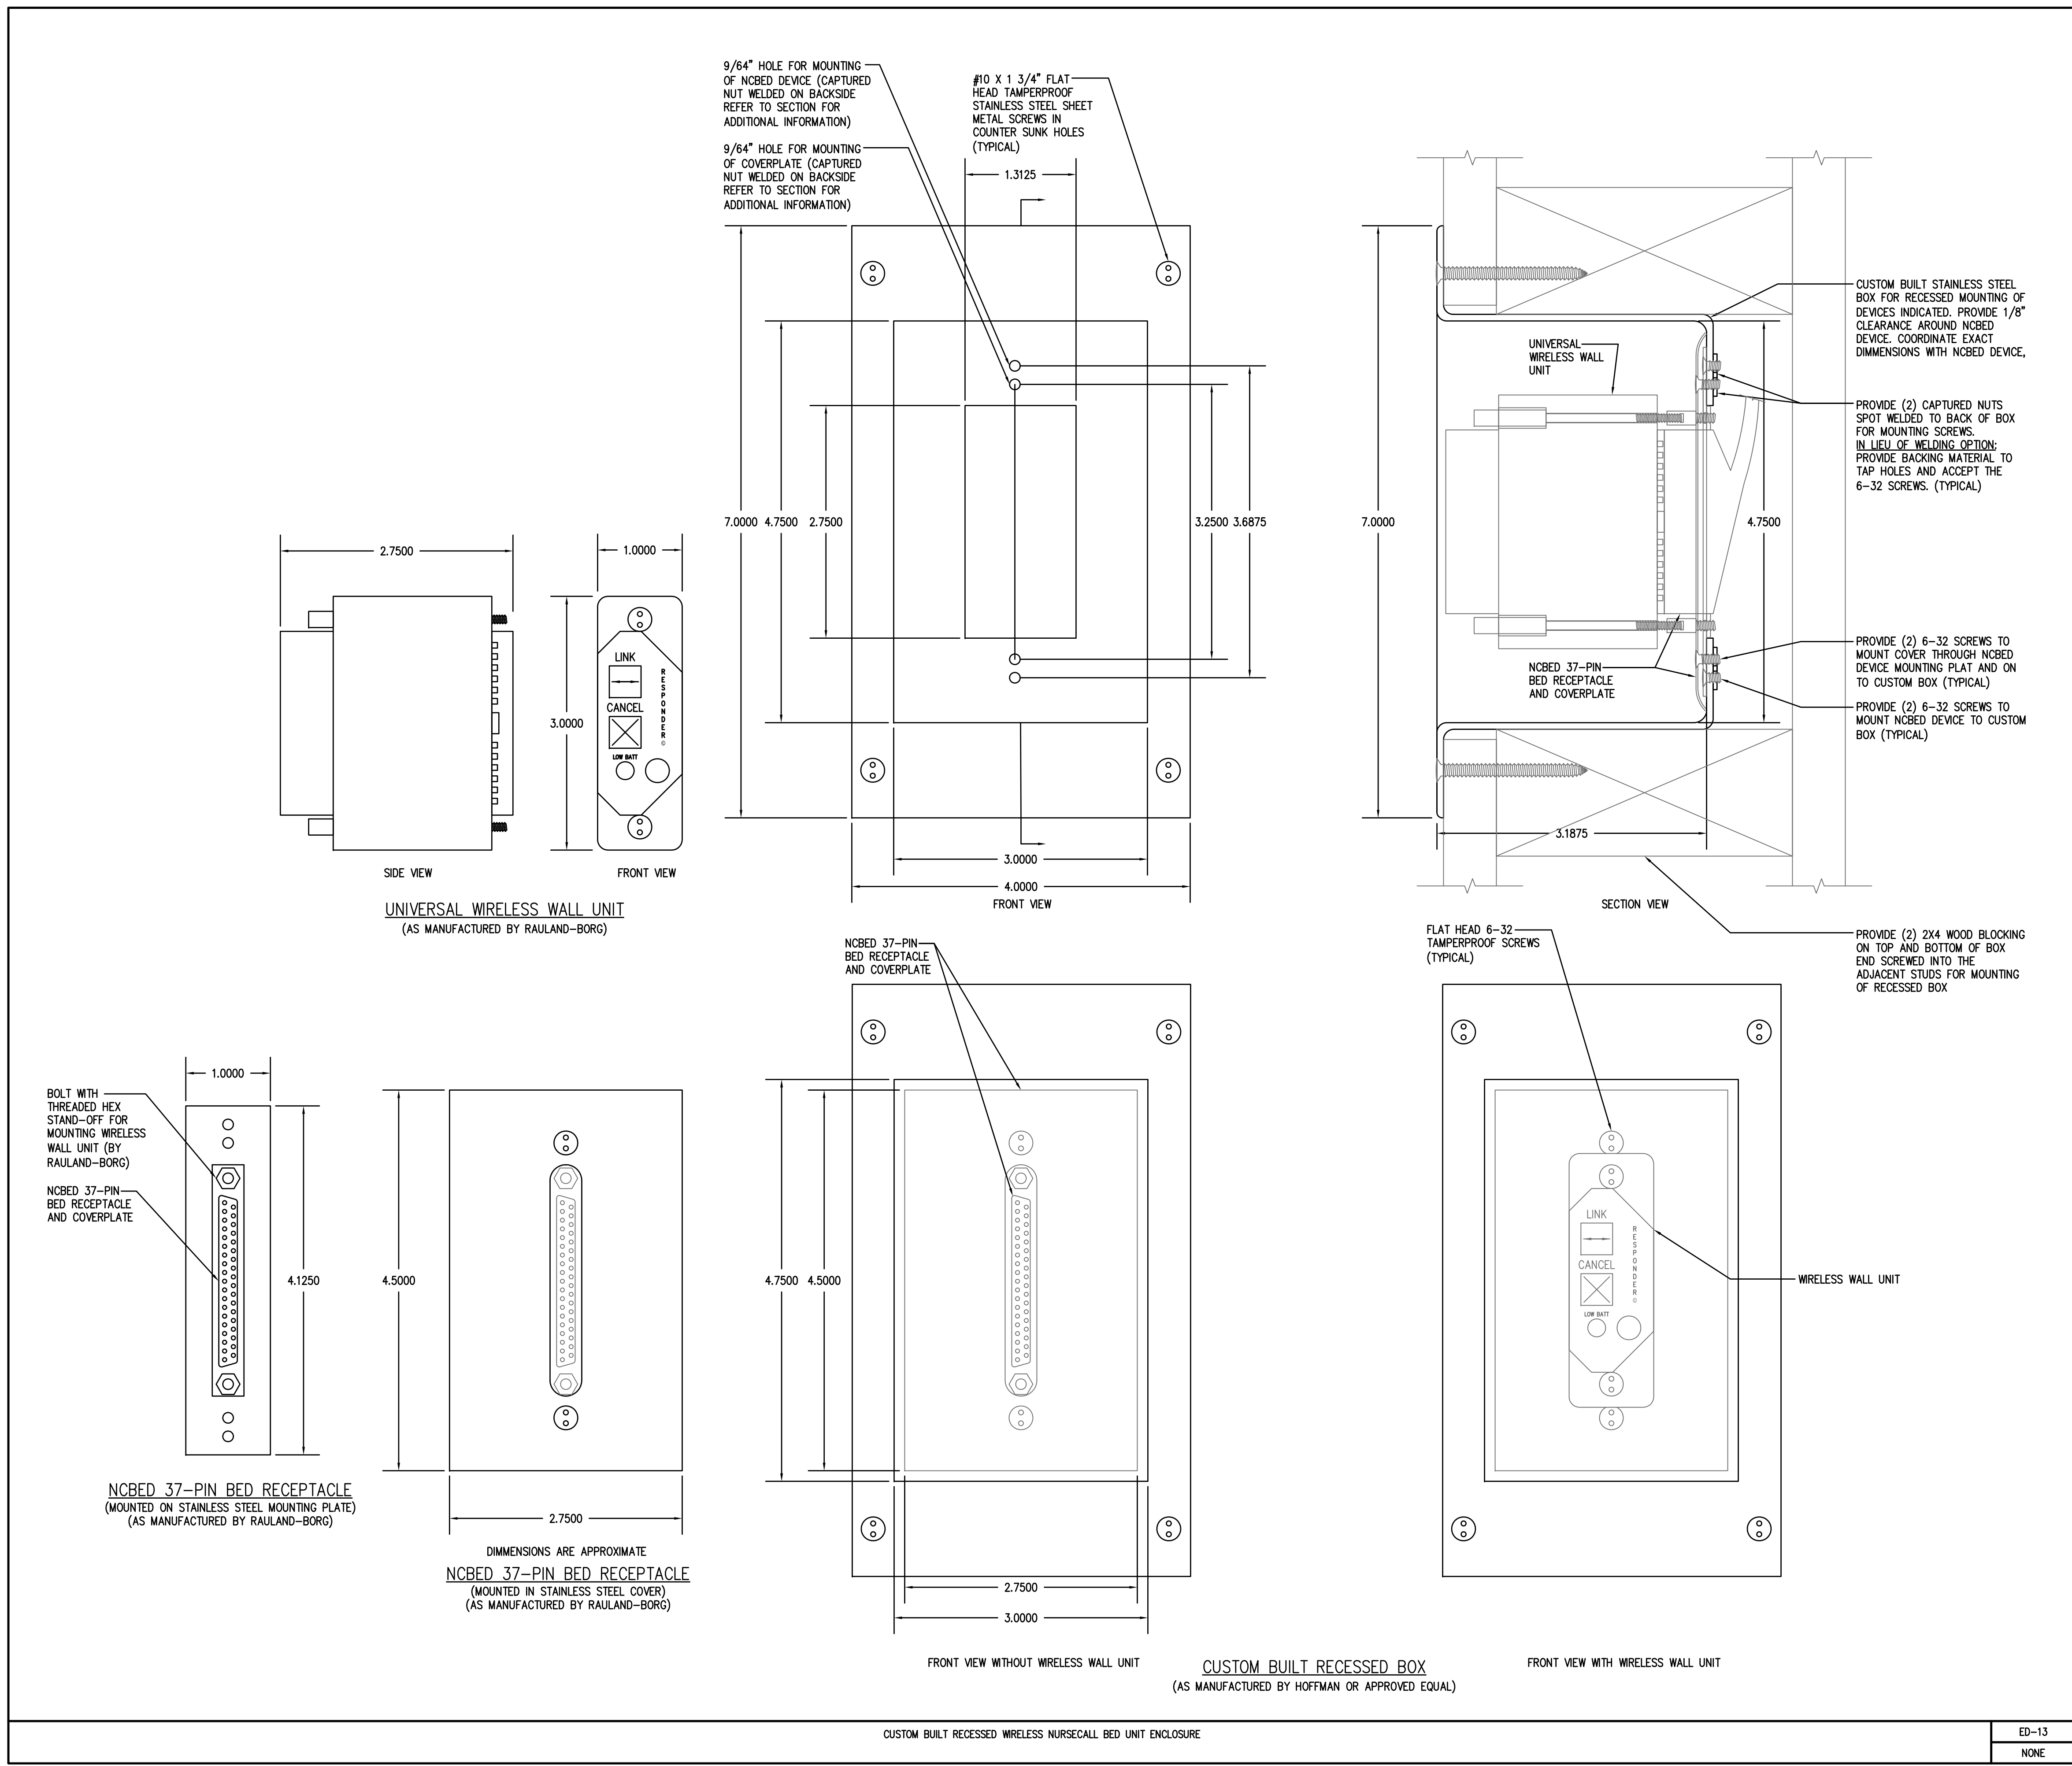

ED-13
NONE

