
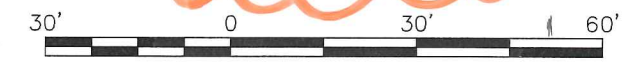


LEGEND

- ▣ SIGNAL CONTROLLER CABINET
- FOUNDATION
- MAST ARM
- ⊥ PEDESTRIAN HEAD
- SIGNAL HEAD
- THERMAL VEHICLE DETECTION

*BAA/PTUD
8/20/18*

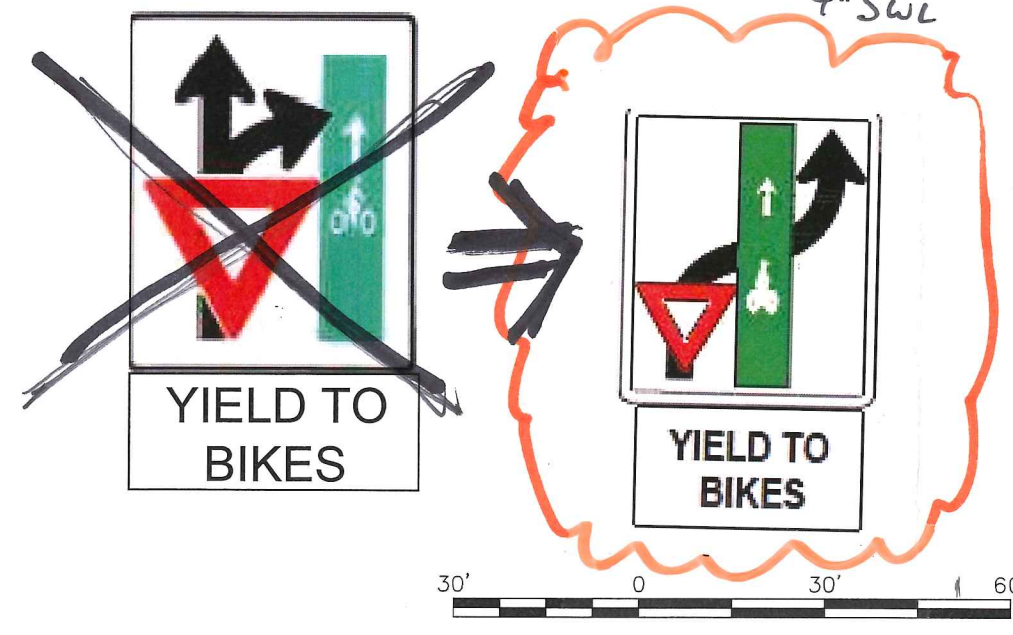

BAR SCALE
1" = 30'
CHECK GRAPHIC SCALE BEFORE USING

41 Hutchins Drive
Portland, Maine 04102
800.926.4262 | www.woodardcurran.com



**GARAGE ENTRANCE ST.
JOHN RIGHT TURNING LANE**

MAINE MEDICAL CENTER
22 BRAMHALL STREET
PORTLAND, MAINE 04102

MVC ST. JOHN STREET
EMPLOYEE PARKING GARAGE

DESIGNED BY: BCM
CHECKED BY: DAS
DRAWN BY: BCM

COMMITMENT & INTEGRITY DRIVE RESULTS

JOB NO: 0231158.00
DATE: AUGUST 2018
SCALE: 1"=30'

FIG. 1