


	SANITA	SANITARY SEWER STRUCTURE DAT				
Ì	STRUCTURE	RIM	INV. IN	INV. OUT:	DIAM.	
	SMH 13932	52.64	43.42 (15" RCP) 44.44 (12" PVC) 41.64 (18" RCP) 44.64 (8" PVC)	40.64 (18" RCP)	48"	
	SMH 13952	52.64	45.89 (12" PVC) 45.98 (18" RCP)	44.61 (18" RCP)	48"	


SANITARY SEWER STRUCT			TURE DATA			
STRUCTURE	RIM	INV. IN	INV. OUT:	DIAM.		
SMH-1	55.09	44.71 (SS-2 ) 46.85 (SS-1.1) 45.63 (SD-1)	44.61 (SS-13952)	48"		
SMH-1.1	54.07	47.04 (SS-1.2)	46.94 (SS-1.1)	48"		
SMH-2	60.23	51.21 (SS-3 ) 51.41 (SS-16008 RECONNECT)	50.77 (SS-2 )	48"		
SMH-3	60.50	52.24 (SS-4 )	52.14 (SS-3 )	48"		
SMH-4	64.11	57.95 (SS-11065)	54.00 (SS-4 )	48"		


## SANITARY SEWER PIPE DATA

NAME	SIZE	LENGTH	SLOPE
SS-1.1	8"	15'	0.58%
SS-1.2	8"	88'	0.52%
SS-2	18"	92'	6.60%
SS-3	15"	62'	1.51%
SS-4	15"	44'	4.02%

TA	CTURE DAT	AIN STRUC	l DR	STORM
DIAM	INV. OUT:	INV. IN	RIM	STRUCTURE
48"	55.52 (SD-1.1 )	55.62 (SD-3 )	60.00	CB-1
48"	55.39 (SD-2.1)	55.49 (SD-1.1 ) 55.49 (SD-3.1)	59.89	CB-2
48"	55.66 (SD-3.1)		59.89	CB-3
48"	52.00 (SD-10 )	54.27 (SD-15960)	58.05	CB-4
48"	53.83 (SD-5.4) 51.33 (SD-5.1)		60.25	CB-5
48"	38.69 (SD-13)		42.28	CB-8
48"	45.66 (SD-1 )	49.35 (SD-2 ) 45.76 (SD-5 )	54.96	DMH-1
48"	50.04 (SD-2 )	50.14 (SD-10 )	58.21	DMH-2
48"	55.67 (SD-3 )	61.93 (SD-68)	60.70	DMH-3
48"	54.46 (SD-4 )		64.63	DMH-4
60"	51.43 (SD-5.2) 51.43 (SD-5.5) 55.33 (SD-5.3)	55.33 (SD-2.1)	60.12	DMH-5
60"	51.43 (SD-6.1) 54.16 (SD-6.3) 54.16 (SD-6.2)	54.16 (SD-4 )	60.00	DMH-7

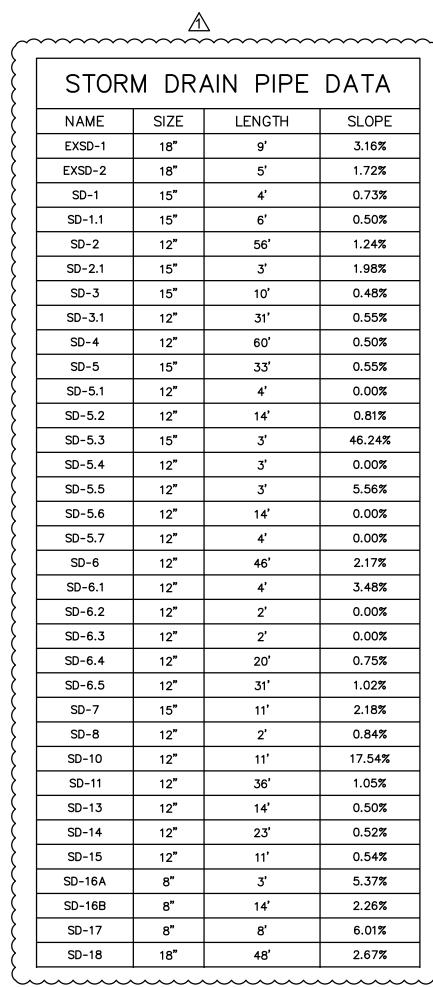

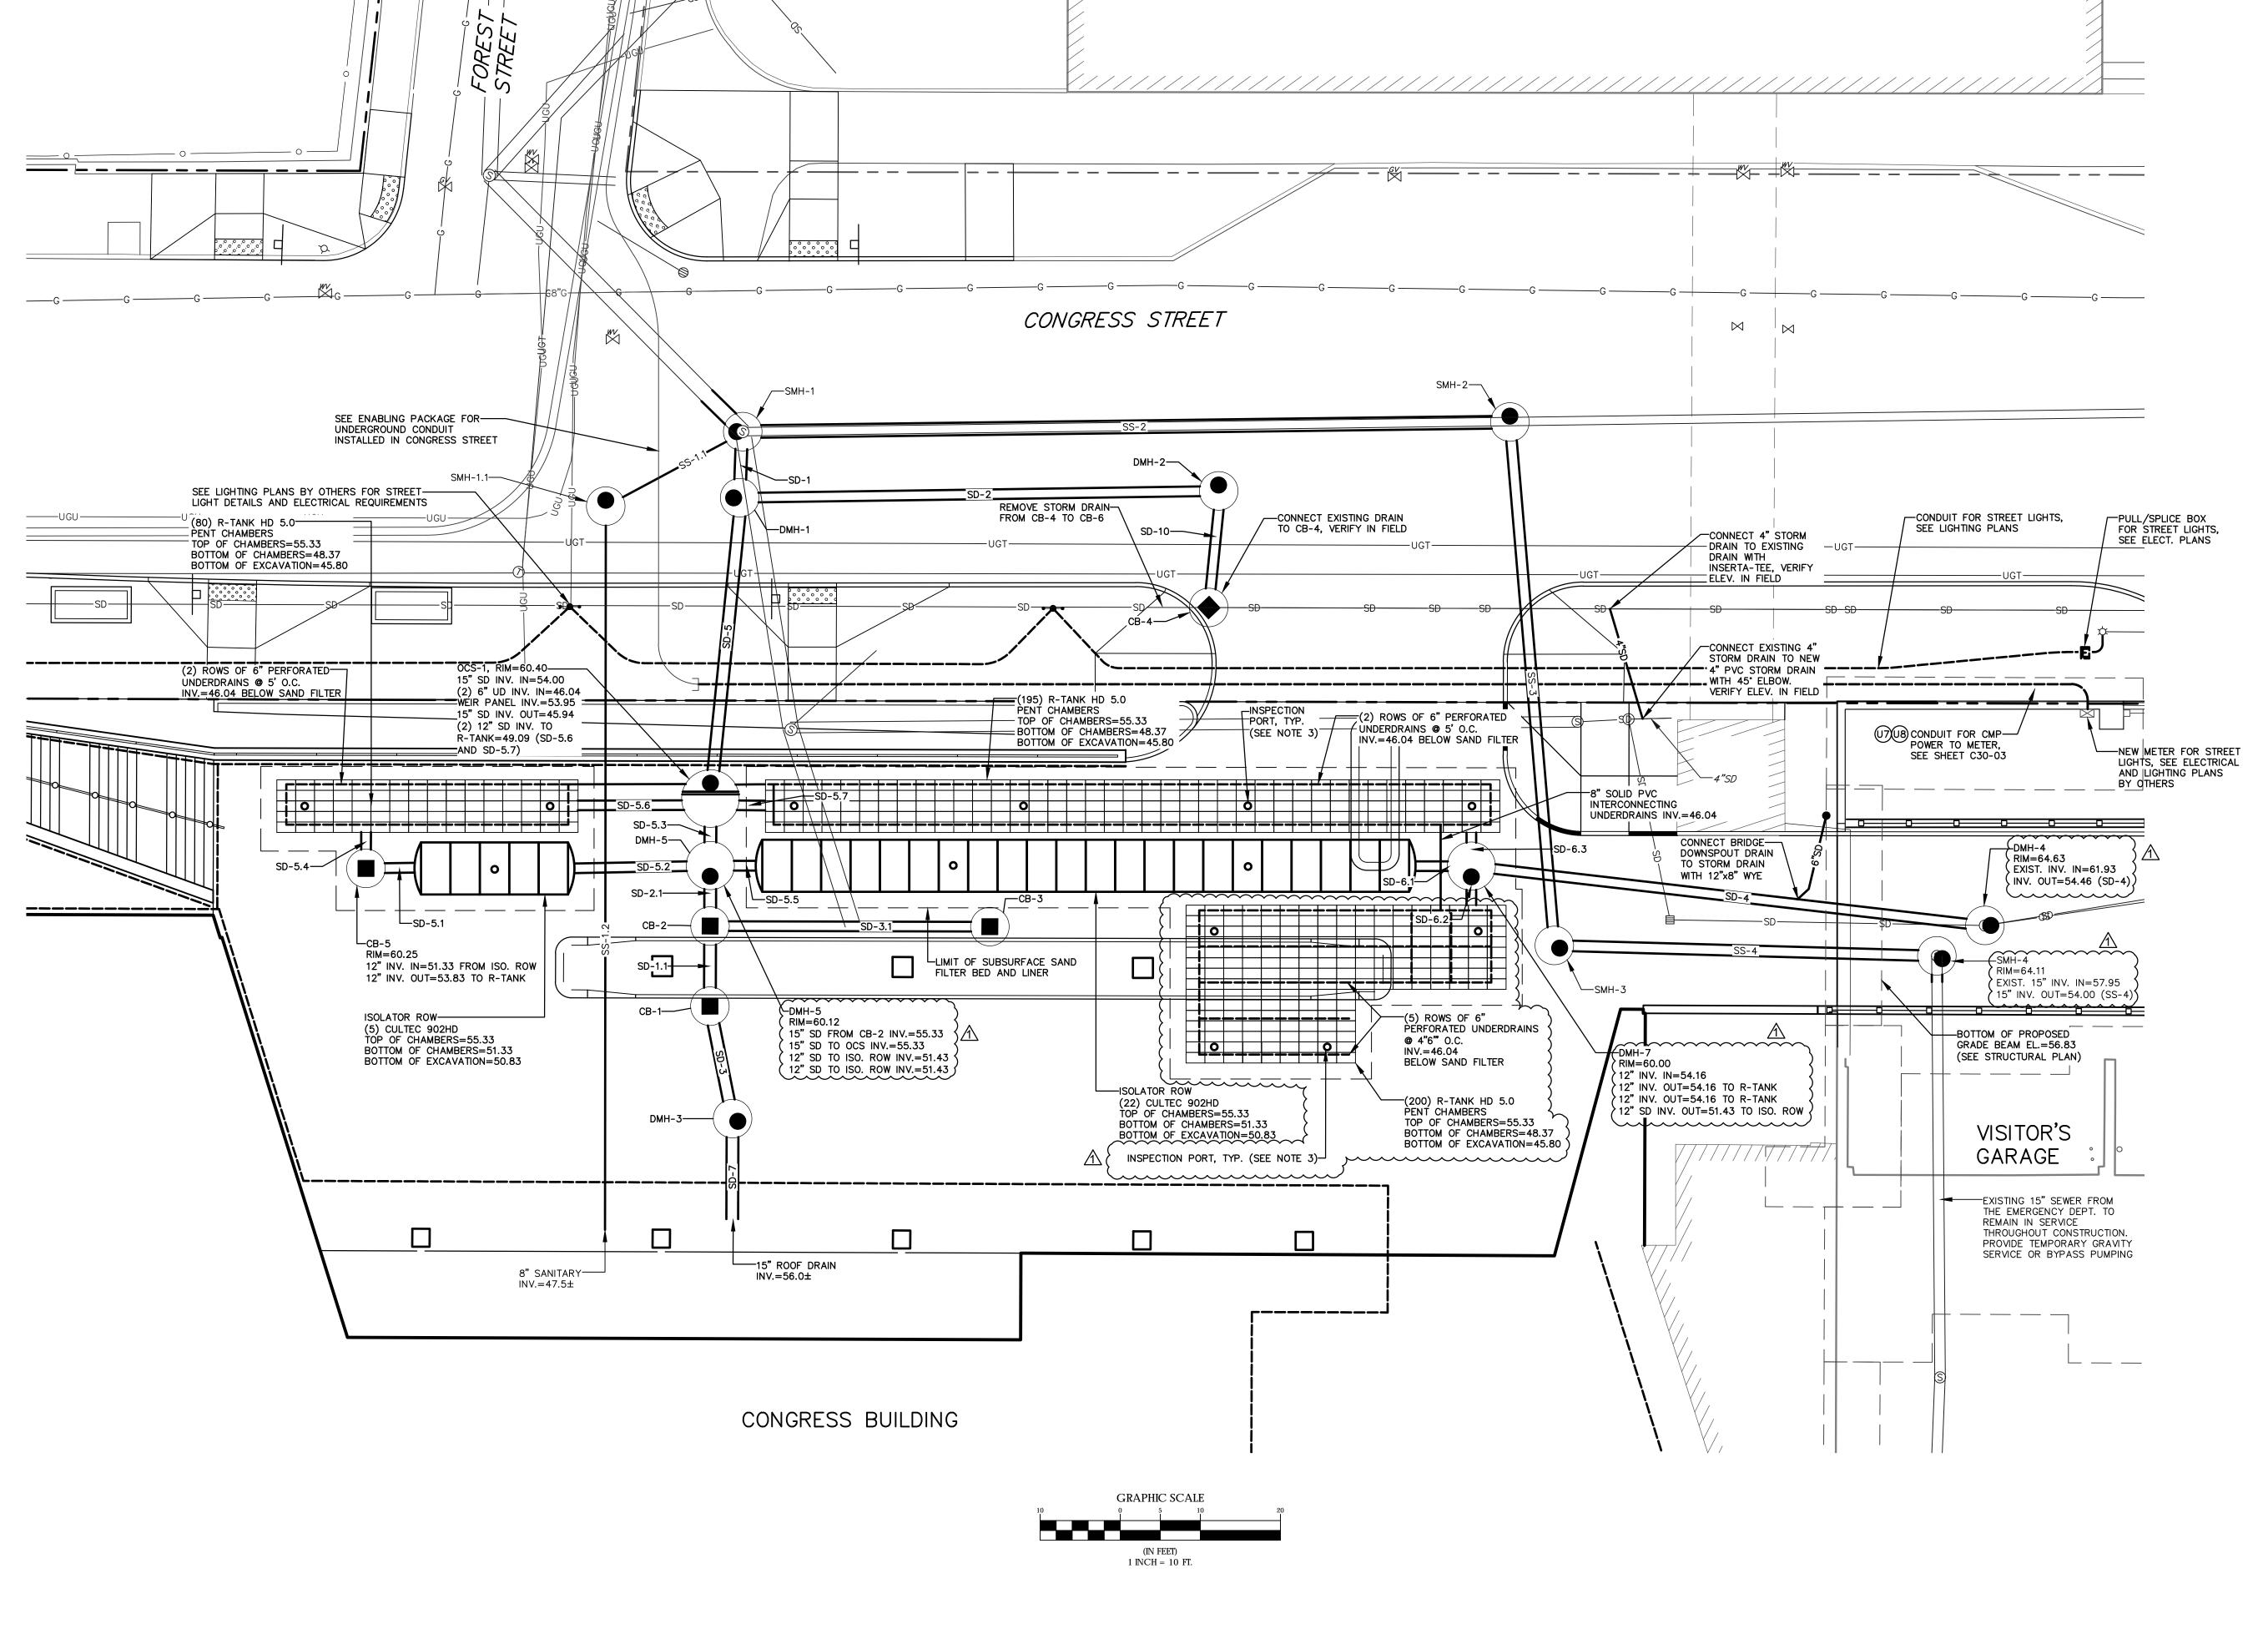

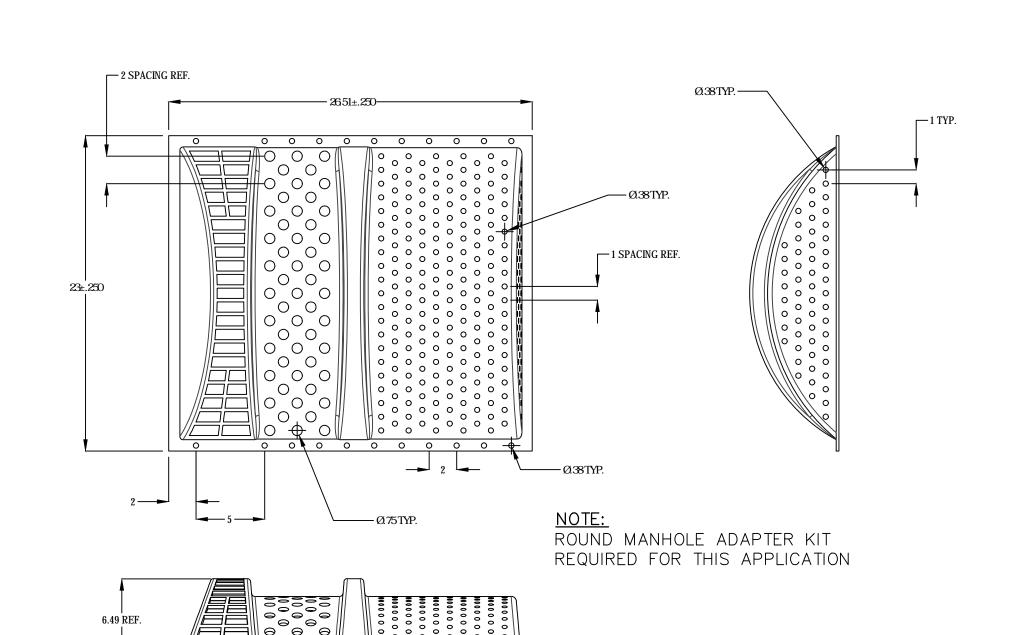

TRASHGUARD PLUS 23" TGRD23X24 (12" DIA. PIPE)
NOT TO SCALE

NC	OTES:
1.	CATCH BASINS AND MANHOLES CONNECTED TO THE R-TANK CHAMBER
	SYSTEM ARE TO INCLUDE TRASH GUARD INLET FILTER HOODS. THE INLI
	FILTER HOODS ARE TO BE "TRASH GUARD PLUS" WITH ROUND MANHOLI
	ADAPTORS BY:
	TRASH GUARD, INC.
	P.O BOX 10

	P.O BOX 10
	ROSEBORO, NC 28382
	OR ENGINEER APPROVED EQUAL. TRASH GUARDS ARE TO BE INSTALLED
	AS INDICATED IN TRASH GUARD TABLE BELOW.
2.	THE PROPOSED SUBSURFACE R-TANK STORM DRAINAGE SYSTEM HAS
	CONSTRUCTION SPECIFIC LOAD LIMITATIONS. REFER TO THE
	SPECIFICATIONS AND THE R-TANK SYSTEM INSTALLATION MANUAL FOR
	GUIDANCE RELATED TO IMPOSED CONSTRUCTION LOADS. THE CONTRACTOR
	SHALL BE RESPONSIBLE FOR PROTECTING THE PROPOSED SYSTEM
	THROUGHOUT THE CONSTRUCTION PERIOD. THE CONTRACTOR'S SHOP
	DRAWING SUBMITTAL FOR THE SYSTEM SHALL INCLUDE A PROPOSED
	CONSTRUCTION SCHEDULE. COORDINATE WITH THE CONSTRUCTION
	MANAGER'S BUILDING CONSTRUCTION SEQUENCE. A PLAN FOR MARKING
	THE LOCATION OF THE SYSTEM DURING CONSTRUCTION AND PROTECTING
	THE SYSTEM FROM TRAFFIC LOADS SHALL BE INCLUDED.

IHL SYSTEM FROM TRAFFIC LOADS SHALL BE INCLUDED.

3. INDICATE INSPECTION PORT LAYOUT IN SHOP DRAWING SUBMITTAL.
INSPECTION PORT LOCATION IS TO BE COORDINATED WITH THE GRANITE
BANDS ABOVE. LAYOUT IS TO BE REVIEWED AND APPROVED BY THE
LANDSCAPE ARCHITECT.

TRASH GUARD TABLE						
STRUCTURE	PIPE I.D.	PIPE SIZE	TRASH GUARD MODEL			
CB-5	SD-5.4	12"	TGRD-23x24			
DMH-7	SD-6.2	12"	TGRD-23x24			
DMH-7	SD-6.3	12"	TGRD-23x24			
OCS-1	SD-5.6	12"	TGRD-23x24			
OCS-1	SD-5.7	12"	TGRD-23x24			

PERKINS + WILL

225 Franklin Street, Suite 1100 Boston, MA 02110 t 617.478.0300 f 617.478.0321 www.perkinswill.com CLIENT

Maine Medical Center

**Maine Medical** Center 22 Bramhall Street

CONSULTANTS

Portland, ME 04102

CIVIL/ LANDSCAPE ARCHITECT Sebago Technics Inc. 75 John Roberts Road, Suite 1A, South Portland, ME 04106

STRUCTURAL ENG/ BUILDING ENVELOPE CONSULTANT Simpson Gumpertz & Heger Inc. 41 Seyon Street, Building 1, Suite 500, Waltham, MA 02453

MEPFP ENGINEER/CODE/LOW VOLTAGE AKF Group LLC 99 Bedford Street, 2nd Floor, Boston, MA 02111 CONSTRUCTION MANAGER TURNER CONSTRUCTION

2 Seaport Lane, Suite 200, Boston, MA 02210 ELEVATOR CONSULTANT VDA (Van Deusen & Associates) 101 Summer Street, 4th Floor, Boston, MA 02110

COST ESTIMATOR

D.G. Jones International 3 Baldwin Green Common, Suite 202, Woburn, MA 01801 MEDICAL EQUIPMENT PLANNING Mitchell Planning 630 Dundee Road, Suite 340, Northbrook IL 60062

> PROJECT TITLE **Congress Street** 22 Bramhall Street

> > Portland ME 04102



**KEY PLANS** PROJECT KEY PLAN

-----OVERALL KEY PLAN 1 - NOT USED 2 - CONGRESS STREET 3 - VISITOR GARAGE 4 - EAST TOWER 5 - CENTRAL UTILITY PLANT 6 - BEAN BUILDING 7 - RICHARDS BUILDING 8 - MAINE GENERAL BUILDING

> **ISSUED FOR** CONSTRUCTION

> > November 15, 2019


Draw	'n	MAL/MAN
Job	Number	152189.000
NO	ISSUE	DATE
1	ADDENDUM NO. 2	01 MAY 20


UTILITY PLAN, **MAIN ENTRANCE** 

SHEET NUMBER

Copyright 2019 @ Perkins + Will

C30-01

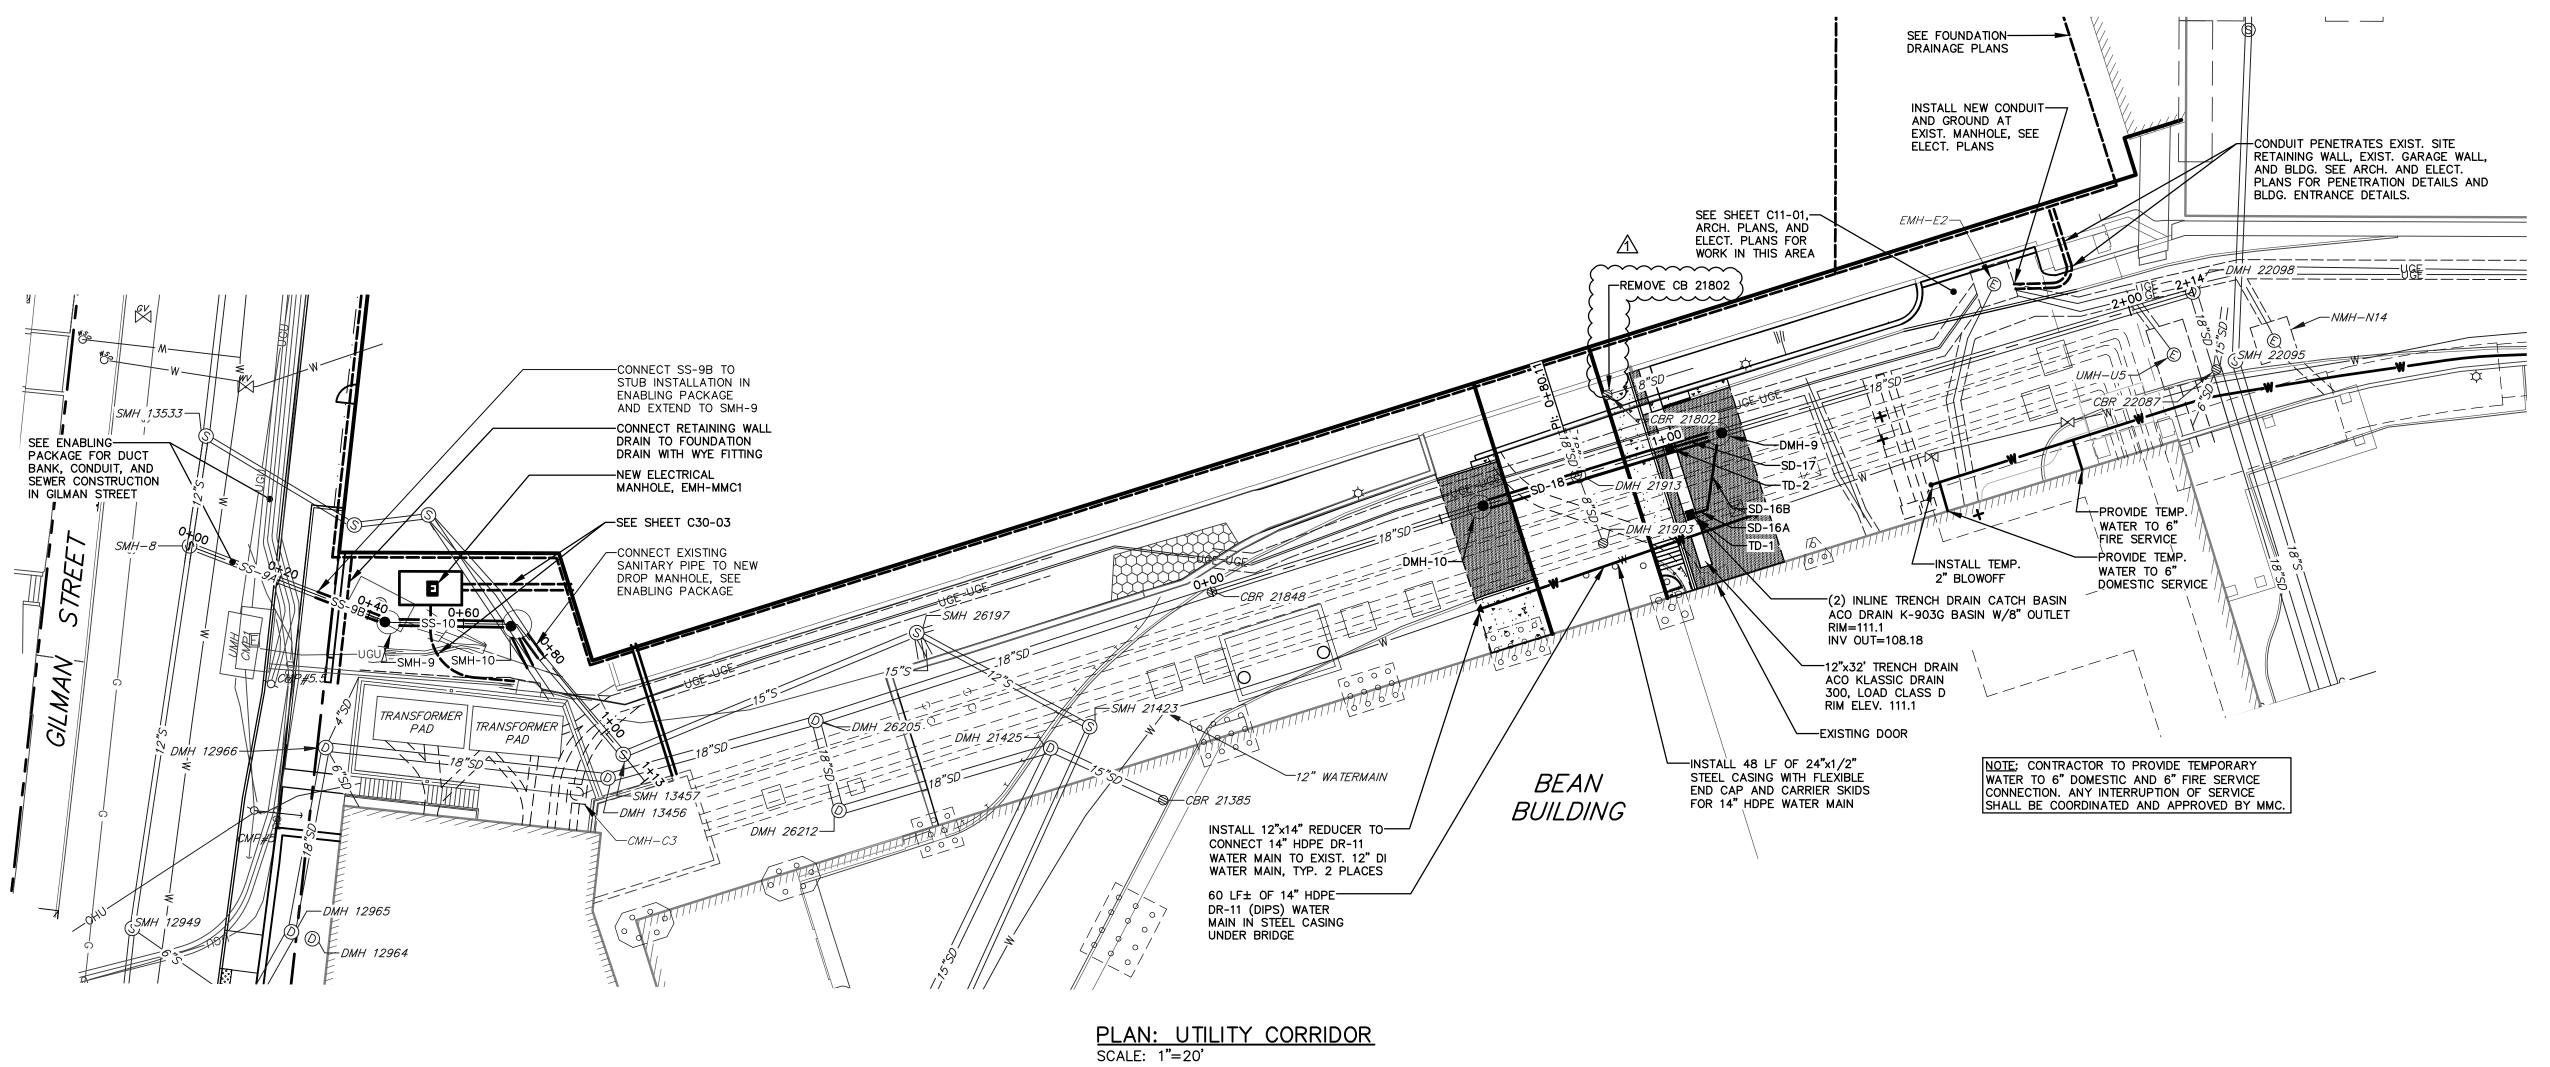

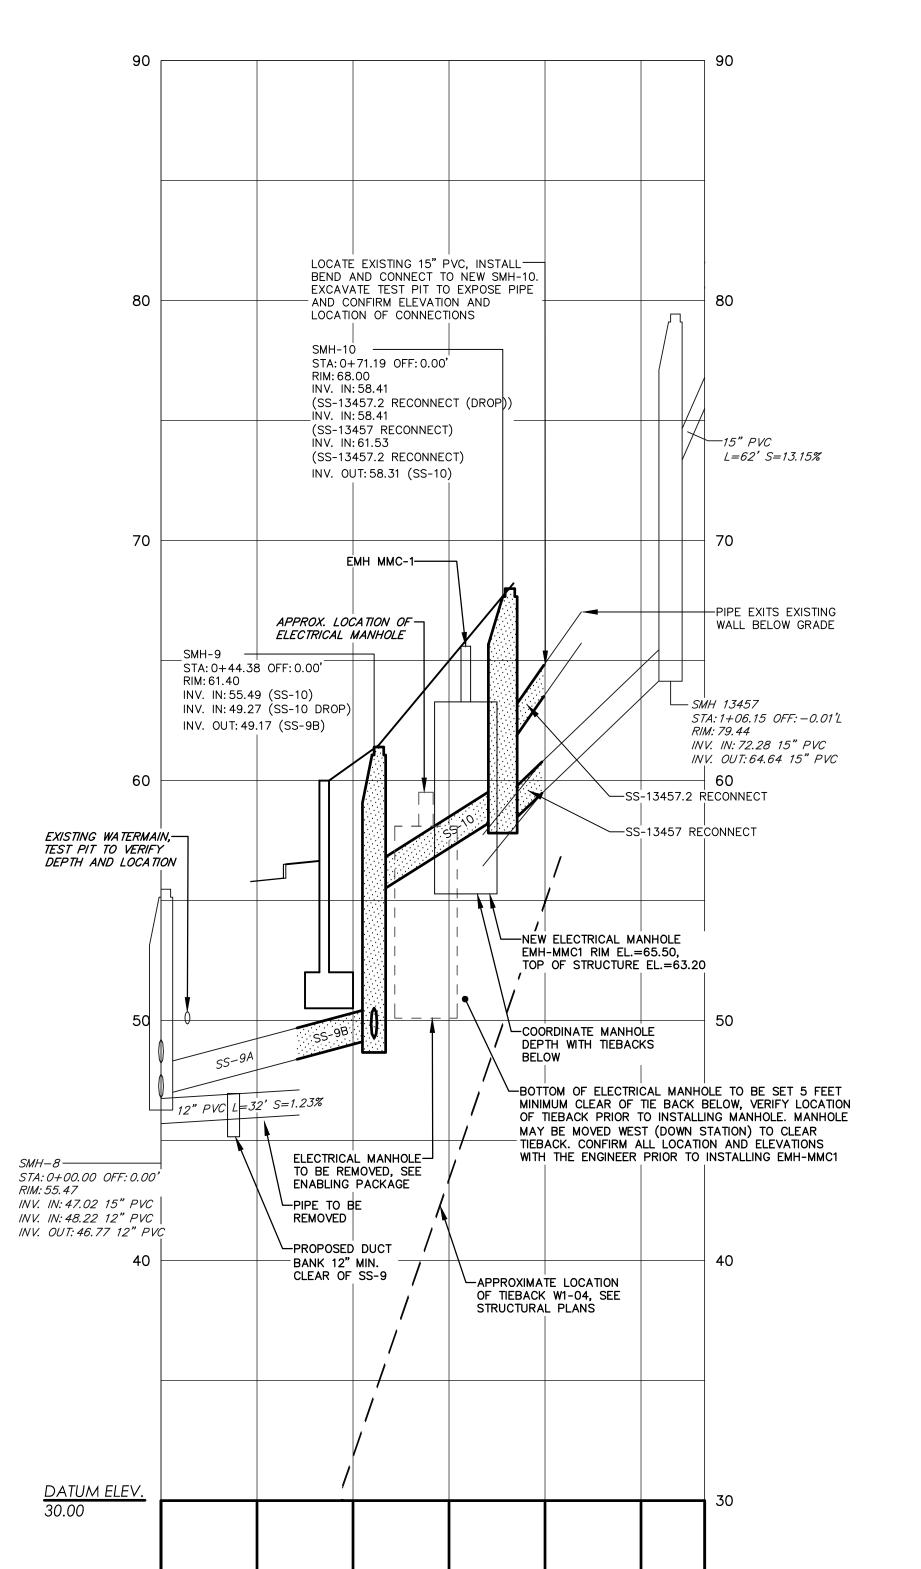

0+20 0+40 0+60 0+80 1+00 1+13

PROFILE: UTILITY CORRIDOR
STA. 0+00 TO STA. 2+68
SCALE: 1"=20' HORIZ.
1"=4' VERT.

0+00

SANITARY SEWER PIPE DATA

LENGTH

14'

22'

SLOPE

5.37%

12.64%

SIZE

15"

NAME

SS-9B

SS-10

\$0.16A 8 8" 16" 12255 \$0.17 8" 8" 0.018 \$0.16 19" 48' 2.67%  120  Date 25515 Set 16 19" 48' 2.67%  Date 25515 Set 16 19" 48' 2.67%  Date 25515 Set 16 19" 100 100 100 100 100 100 100 100 100 10					NAME	SIZE	LENGTH	SLOPE					
120    So-17   9"   9'   9'   5.018   18"   2.073													
100    STAND SEED OF LOCATION AND PARTY SEED OF LOCATION AND AND LOCATION AND PARTY SEED OF LOCATION AND LOCA				_				_	-				
100    Solida   Solid													
100    Solida   Solid						-		<b>'</b>					
100    100													
DMH-10  SD-18  DMH-9  SN (8:07.33 8" PKC NN (8:07.3													
110    Solid													
100    Solida   Solid													
100    Solida   Solid	120												<u> </u>
MV. N. 107.30 8" PIC MV. N. 107.50 18" PIC	120												'
110    Mart   110													
110  100  100  100  100  100  100  100						/N <i>V.</i> /N	l:102.65 18" PVC	•					
100    100						/N <i>V.</i> /N	l:101.78 18" CPP						
SD-16A-1  SD-16A-1  SD-16B-1  STA: 0+0-56.52 OFF: 0.00° RM: 115.18 RM: 115.10 RM:						STA: 07	+80.11 OFF:0.00'					/	
100    18"   PVC   L = 77"   S = 1.72%   Sp-18						7/7//		SD-17					
SD-16A— SD-16B— STA: 24-35.70 OFF:0.00' RM: 15.16 STA: 1+10.52 OFF:0.02'R RM: 15.16 STA: 1+10.52 OFF:0.02'													
SD-16A— SD-16B— STA: 24-35.70 OFF:0.00' RM: 15.16 STA: 1+10.52 OFF:0.02'R RM: 15.16 STA: 1+10.52 OFF:0.02'							🚹 🖊						
100    SD-16B   DMH-19   STA: 24-13.70 OFF: 0.00'   STA: 24-13.70 OFF: 0.00'   STA: 24-13.70 OFF: 0.00'   STA: 24-13.70 OFF: 0.00'   STA: 14-10.52 OFF: 0.02R   RM: 111.70   RM: 113.18   RM: 111.70   RM: 113.70 (SD-16B)   RM: 111.10   RM: 111.70 (SD-16B)   RM: 111.10   RM: 111.00   RM: 110.70 (SD-16B)   RM: 111.10   RM: 111.10   RM: 111.10   RM: 110.70 (SD-16B)   RM: 110.70 (SD	110			1	<u></u>								1
100    SD-16B   SD-16B   SD-16B   SD-16B   STA: 24-13.70 GFE: 0.00' STA: 24-13.70 GFE: 0.00' STA: 24-13.70 GFE: 0.00' STA: 24-13.70 GFE: 0.00' STA: 14-10.52 OFF: 0.02R RM: 111.70 RM: 111.70 RM: 111.70 RM: 111.70 (SD-16B) RM: 111.10 RM: 111.70 (SD-16B) RM: 111.10 R				[									
100    SD-16B   DMH-19   STA: 24-13.70 OFF: 0.00'   STA: 24-13.70 OFF: 0.00'   STA: 24-13.70 OFF: 0.00'   STA: 24-13.70 OFF: 0.00'   STA: 14-10.52 OFF: 0.02R   RM: 111.70   RM: 113.18   RM: 111.70   RM: 113.70 (SD-16B)   RM: 111.10   RM: 111.70 (SD-16B)   RM: 111.10   RM: 111.00   RM: 110.70 (SD-16B)   RM: 111.10   RM: 111.10   RM: 111.10   RM: 110.70 (SD-16B)   RM: 110.70 (SD						W							
100    18" PVC L=77" S=1.72%		r <del>/</del> f_										V	
100    18" PVC L=77' S=1.72%   DMH-10							SD-16B—						H
100    18" PVC L=77' S=1.72%   DMH-10													
DMH-10 STA: 0+58.52 OFF: 0.00' RM: 119.35 INV. IN: 101.42 (SD-18) INV. IN: 101.32 (EXSD-2) INV. OUT: 100.35 18" PVC INV. OUT: 100.16 18" HDPE  DMH-9 STA: 1+10.52 OFF: 0.02'R RM: 111.70 INV. IN: 107.70 (SD-17) INV. IN: 107.70 (SD-17) INV. IN: 107.70 (SD-16B) INV. IN: 107.			77'	C-1 72%		VSD-18							
DMH-10 STA: 0+58.52 OFF: 0.00' RIM: 109.35 INV. IN: 101.42 (SD-18) INV. IN: 101.32 (EXSD-2)			18" PVC L=//	3=1.727									
DMH-10 STA: 0+58.52 OFF: 0.00' RIN: 109.35 INV. IN: 101.32 (EXSD-2)	100	V				<del>-</del>					DMH 2209	28	1
DMH-10 STA: 0+58.52 OFF: 0.00' RIM: 109.35 INV. IN: 101.42 (SD-18) INV. OUT: 101.32 (EXSD-2)  CBR 21848 STA: 0+00.00 OFF: 0.00' RIM: 106.49 INV. IN: 100.35 18" PVC INV. OUT: 100.16 18" HDPE  NV. IN: 108.18 (SD-17)  TD-1 STA: 1+10.52 OFF: 0.02'R RIM: 111.70 INV. IN: 107.70 (SD-17) INV. IN: 107.70 (SD-16B) INV. IN: 102.80 (EXSD-1) INV. OUT: 102.70 (SD-18)  TD-2 STA: 1+10.52 OFF: 0.02'R RIM: 111.70 INV. IN: 107.70 (SD-17) INV. IN: 107.70 (SD-16B) INV. IN: 107.70 (SD-16B) INV. IN: 107.70 (SD-16B) INV. IN: 102.80 (EXSD-1) INV. OUT: 102.70 (SD-18)  TD-2 STA: 1+00.12 OFF: 14.49'R RIM: 111.10 INV. OUT: 102.70 (SD-18)  TD-2 STA: 1+00.12 OFF: 14.49'R RIM: 111.10 INV. OUT: 102.70 (SD-18)  TD-1 INV. OUT: 102.70 (SD-18) INV. OUT: 102.70 (SD-18)  TD-1 INV. OUT: 105.99 18" CPP INV. OUT: 105.99 18" CP								DMH_0			STA: 2+13.	70 OFF: 0.00'	
STA: 0+58.52 OFF: 0.00' RIM: 109.35 INV. IN: 101.42 (SD-18) INV. OUT: 101.32 (EXSD-2)		Ш						STA: 1+10.52 OF	F: 0.02'R		INV. IN: 10	6.03 18" CPP	
INV. OUT: 101.32 (EXSD-2) INV. OUT: 108.18 (SD-16A) INV. OUT: 102.70 (SD-18)			STA: 0+5	8.52 OFF: 0.00'				INV. IN: 107.70 (	SD-17) SD-16B)				
TD-2 STA: 0+00.00 OFF: 0.00' RIM: 106.49 INV. IN: 100.35 18" PVC INV. OUT: 100.16 18" HDPE  TD-1 STA: 0+99.91 OFF: -0.01'L RIM: 111.10 INV. OUT: 108.18 (SD-17)			INV. IN: 1	01.42 (SD-18)_	RIM:	111.10		INV. IN:102.80 (	EXSD-1)				
STA: 0+00.00 OFF: 0.00' RIM: 106.49 INV. IN: 100.35 18" PVC INV. OUT: 100.16 18" HDPE  STA: 0+99.91 OFF: -0.01'L RIM: 111.10 INV. OUT: 108.18 (SD-17)		CBR 21	848	: 101.32 (EXSD-:	<b>-</b> /								
ATUM ELEV. .00		STA: 0+ RIM: 106	.00.00 OFF: 0.00' 5.49		STA:	0+99.91 OFF	:-0.01'L						
.00			· 100.35 18" PVC JT: 100.16 18" HDPE		INV.	OUT: 108.18	(SD-17)						
	TUM ELEV.												9
	.00	~ <b> </b>	0	<b>ග</b>			0	ر ا			<b>4</b>		$\  \ ^{\cdot}$
		106.4 1 <b>06.4</b>	4.701.4 4.801	108.3	109.4 4.	110.32 110.32	7777.3 111.23	112.1 112.1	113.10	113.8 11 <b>3.8</b> 1	114.2. 114.2.	114.6	
		ľ	_	-				ſ					

<u>N</u>	OTES:
1.	SEE ENABLING PACKAGE FOR SEWER AND DUCT BANK CONSTRUCTION SHOWN ON THIS SHEET FOR REFERENCE.
2.	SEE PERMANENT SUPPORT OF EXCAVATION PLANS FOR TIEBACKS ALONG SOUTH AND WEST WALL OF THE
	EXISTING GARAGE.
3.	A TEMPORARY EXCAVATION SUPPORT SYSTEM DESIGNED BY OTHERS WILL BE INSTALLED IN GILMAN STREET
	AND ADJACENT TO THE PROPOSED ADJACENT TO SMH-9 AND SMH-10. COORDINATE THE INSTALLATION OF
	EMH-MMC-1 WITH THE REMOVAL OF TEMPORARY EXCAVATION SUPPORT AND BACKFILLING OF THE BUILDING.
4.	INSTALL MANHOLE EMH-MMC-1 A MINIMUM 5' CLEAR ABOVE THE TIEBACKS SUPPORTING THE WEST WALL OF
	THE BUILDING, SEE THE PERMANENT SUPPORT OF EXCAVATION PACKAGE AND ASBUILT DOCUMENTATION OF
	THE TIEBACKS. ELECTRICAL MANHOLE EMH-MMC-1 MAY BE MOVED WEST (DOWN SLOPE TOWARD GILMAN
	STREET) TO PROVIDE ADDITIONAL CLEARANCE. COORDINATE ANY RELOCATION OF THE MANHOLE WITH THE
	ARCHITÉCT, ELECTRICAL ENGINEER, AND CIVIL ENGINEER.

EXISTING	DESCRIPTION	PROPOSED
	PROPERTY LINE/R.O.W.	
	- ABUTTER LINE/R.O.W.	
	✓ BUILDING =	
	— EDGE PAVEMENT	
	PAVEMENT SAWCUT -	
	- EDGE CONCRETE	
	= CURB LINE =	
- <b></b> 120 <b></b> 118-	- CONTOURS -	120
×120.00	SPOT GRADE	<del> </del> 120.00
	= RETAINING WALL =	
	DECIDUOUS TREE	
£43	CONIFEROUS TREE	
<del>-                                    </del>	SIGN	• •
G	— GAS —	
$\overset{\mathcal{GV}}{\bowtie}$	GAS GATE VALVE	GV.
GM	GAS METER	
©	GAS MANHOLE	
	— WATER —	
	WATER GATE VALVE	WV
<b>%</b> 50	WATER SHUT OFF	450
<del>-</del> \$-	HYDRANT	<del>•</del>
W	WATER MANHOLE	
s	— SANITARY SEWER —	s
S	SANITARY MANHOLE	(ullet)
SD	— STORM DRAIN —	<b></b>
UD	— UNDER DRAIN —	UD
<b>(D)</b>	DRAINAGE MANHOLE	
	CATCH BASIN	
OHU	— OVERHEAD UTILITY 🕳	OHU
———UGU ———	— UNDERGROUND UTILITY <del>—</del>	·UGU·
ΕT	TRANSFORMER PAD	T
E	ELECTRICAL MANHOLE	
$\bigcirc$	TELEPHONE MANHOLE	
⋫	LIGHT POLE	<b>★ ←= /</b>
-0-	UTILITY POLE	<b>-</b>
$\leftarrow$	GUY WIRE	
<del>2</del> 22225	RIPRAP	
, , , , , , , , , , , , , , , , , , , ,	INLET PROTECTION	

PAVEMENT RECONSTRUCTION

-----**OVERALL KEY PLAN** 1 - NOT USED 2 - CONGRESS STREET 3 - VISITOR GARAGE 4 - EAST TOWER 5 - CENTRAL UTILITY PLANT 6 - BEAN BUILDING 7 - RICHARDS BUILDING 8 - MAINE GENERAL BUILDING

PERKINS

Maine Medical Center

**Maine Medical** 

22 Bramhall Street

Portland, ME 04102

Center

CONSULTANTS

CIVIL/ LANDSCAPE ARCHITECT

Sebago Technics Inc. 75 John Roberts Road, Suite 1A,

South Portland, ME 04106

Waltham, MA 02453

AKF Group LLC

CONSTRUCTION MANAGER TURNER CONSTRUCTION

ELEVATOR CONSULTANT

COST ESTIMATOR

Mitchell Planning

PROJECT TITLE

**KEY PLANS** 

PROJECT KEY PLAN

**Congress Street** 

22 Bramhall Street Portland ME 04102

D.G. Jones International

MEDICAL EQUIPMENT PLANNING

Simpson Gumpertz & Heger Inc.

41 Seyon Street, Building 1, Suite 500,

MEPFP ENGINEER/CODE/LOW VOLTAGE

99 Bedford Street, 2nd Floor, Boston, MA 02111

2 Seaport Lane, Suite 200, Boston, MA 02210

101 Summer Street, 4th Floor, Boston, MA 02110

3 Baldwin Green Common, Suite 202, Woburn, MA 01801

VDA (Van Deusen & Associates)

STRUCTURAL ENG/ BUILDING ENVELOPE CONSULTANT

+ WILL

225 Franklin Street, Suite 1100

Boston, MA 02110 t 617.478.0300 f 617.478.0321 www.perkinswill.com

CLIENT

**ISSUED FOR** CONSTRUCTION November 15, 2019


	1	ADDENDUM NO. 2	01 MAY 20
	NO	ISSUE	DATE
	Job N	lumber	152189.000
	Drawr	า	MAL/MAM
A	Checl	ked	DLR
	Appro	oved	DLR


**PLAN & PROFILE, UTILITY CORRIDOR** 

SHEET NUMBER

C30-02

Copyright 2019 @ Perkins + Will

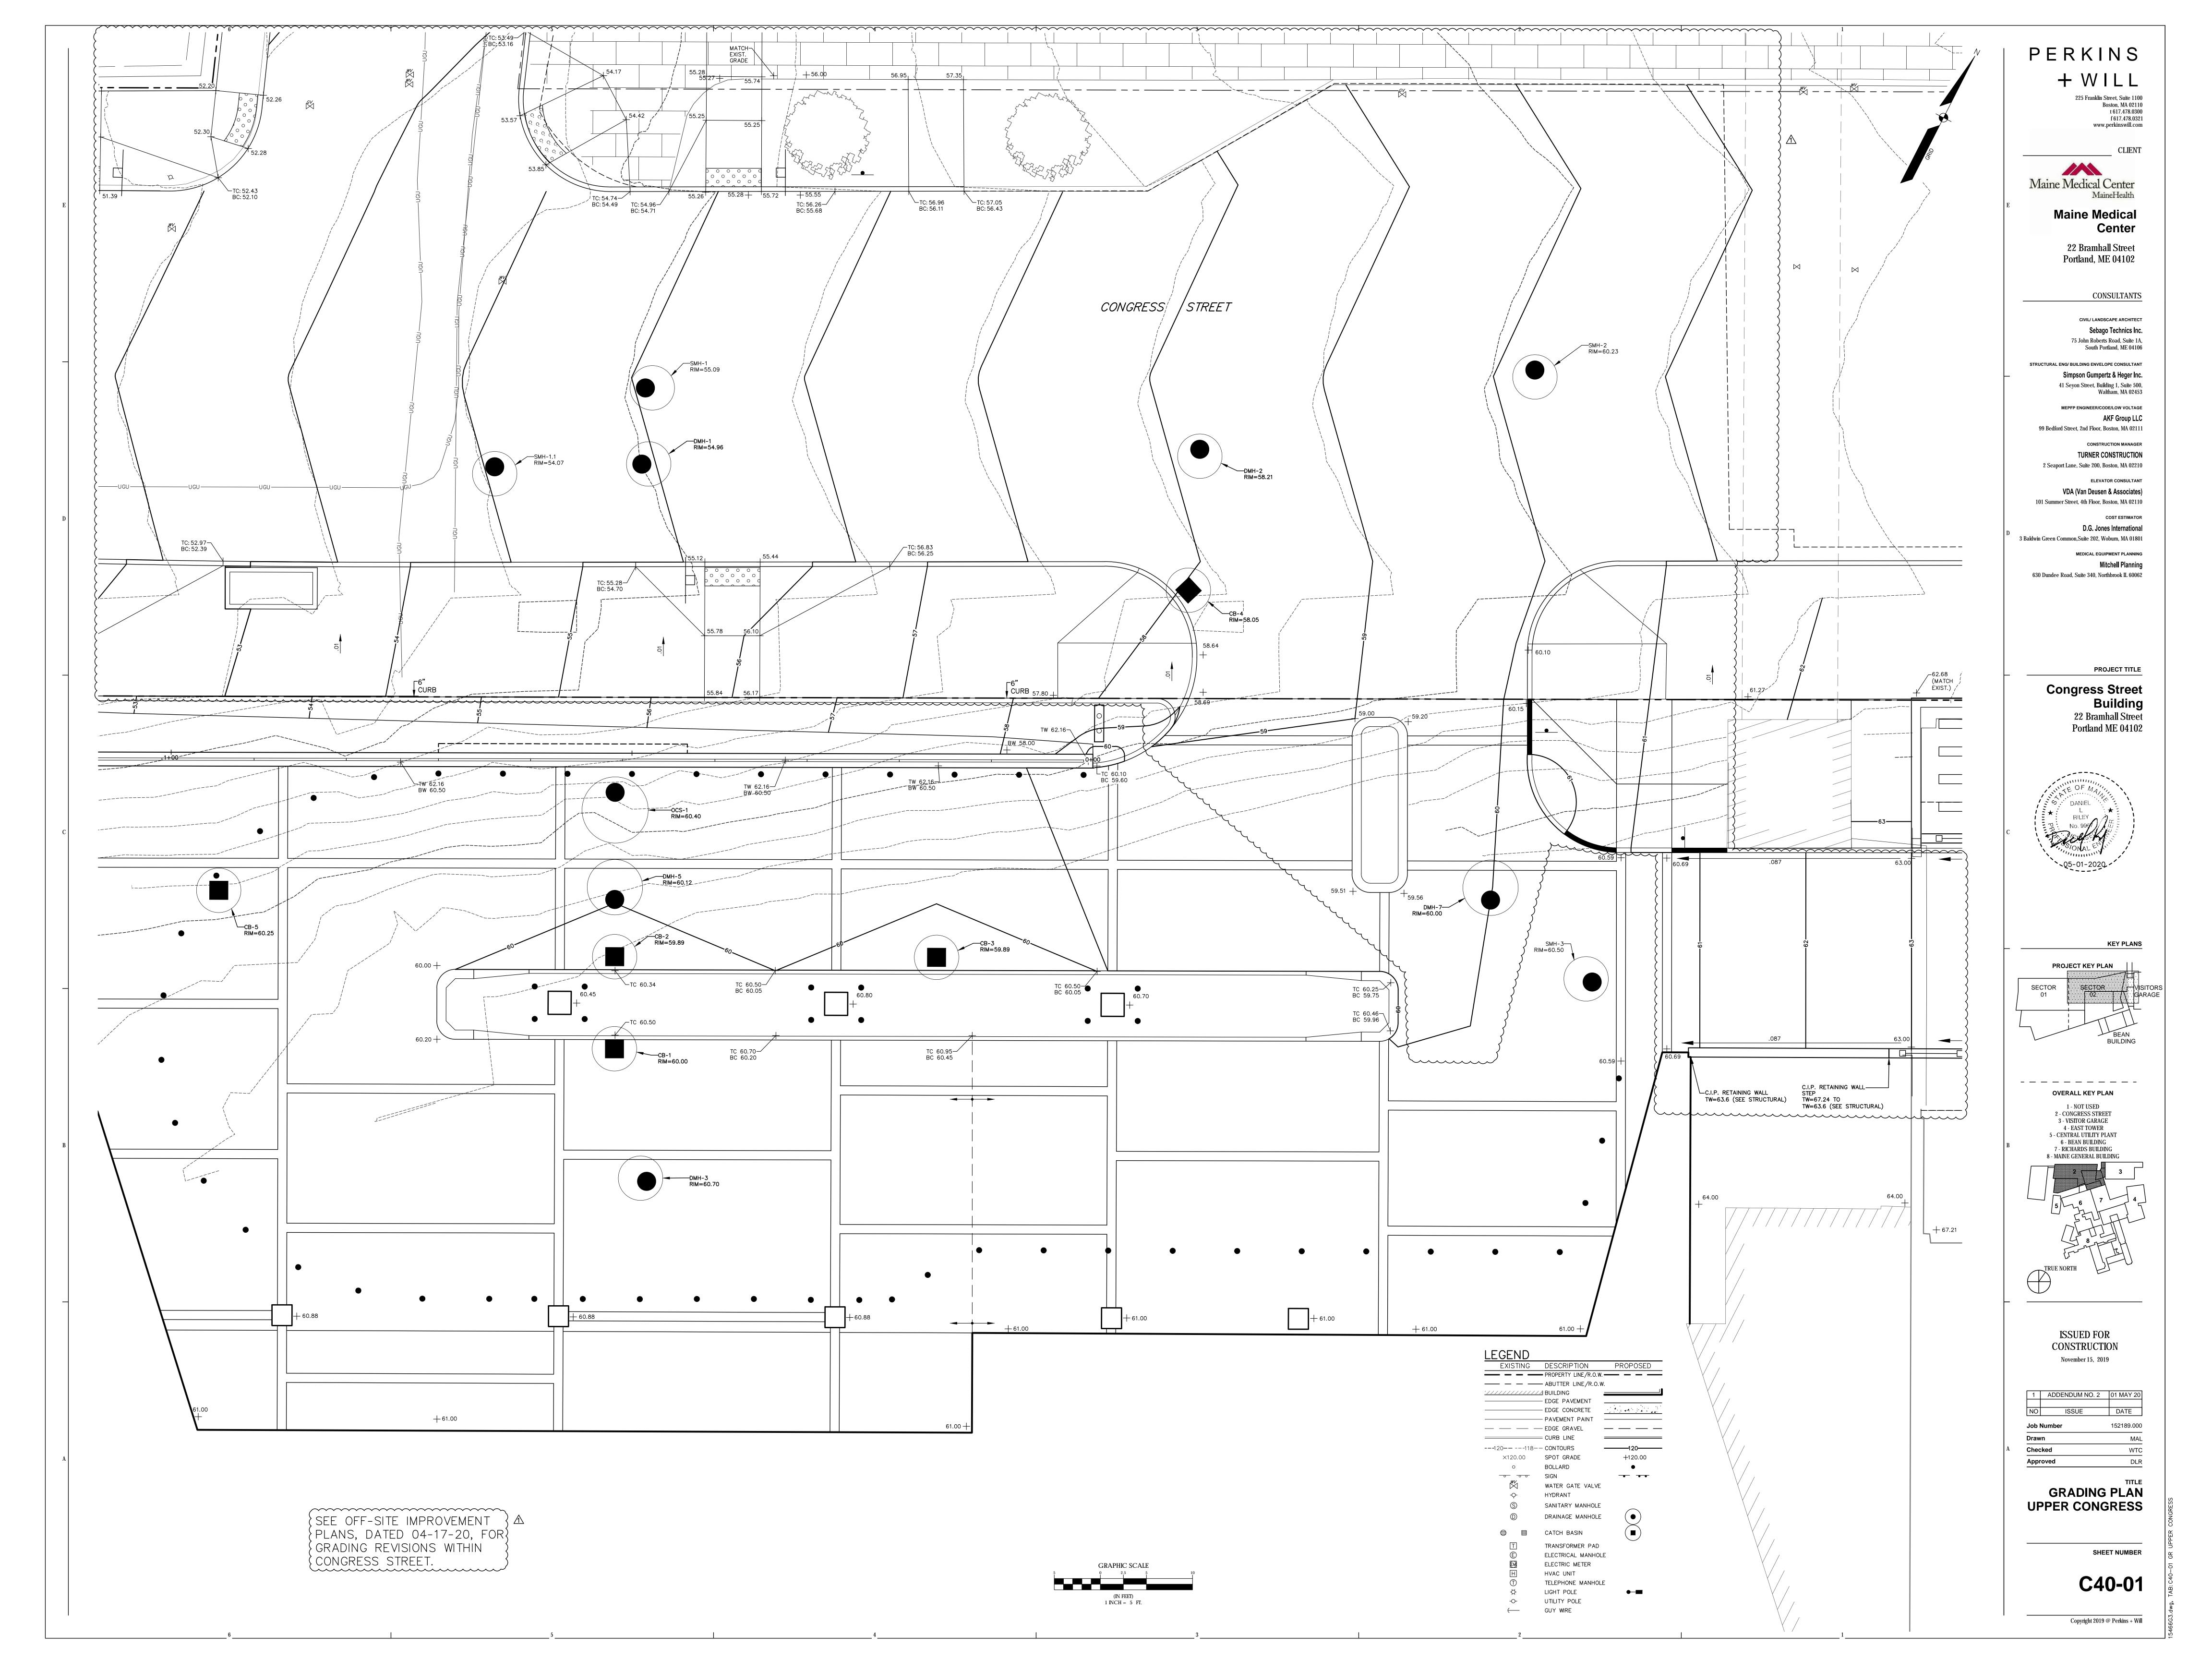

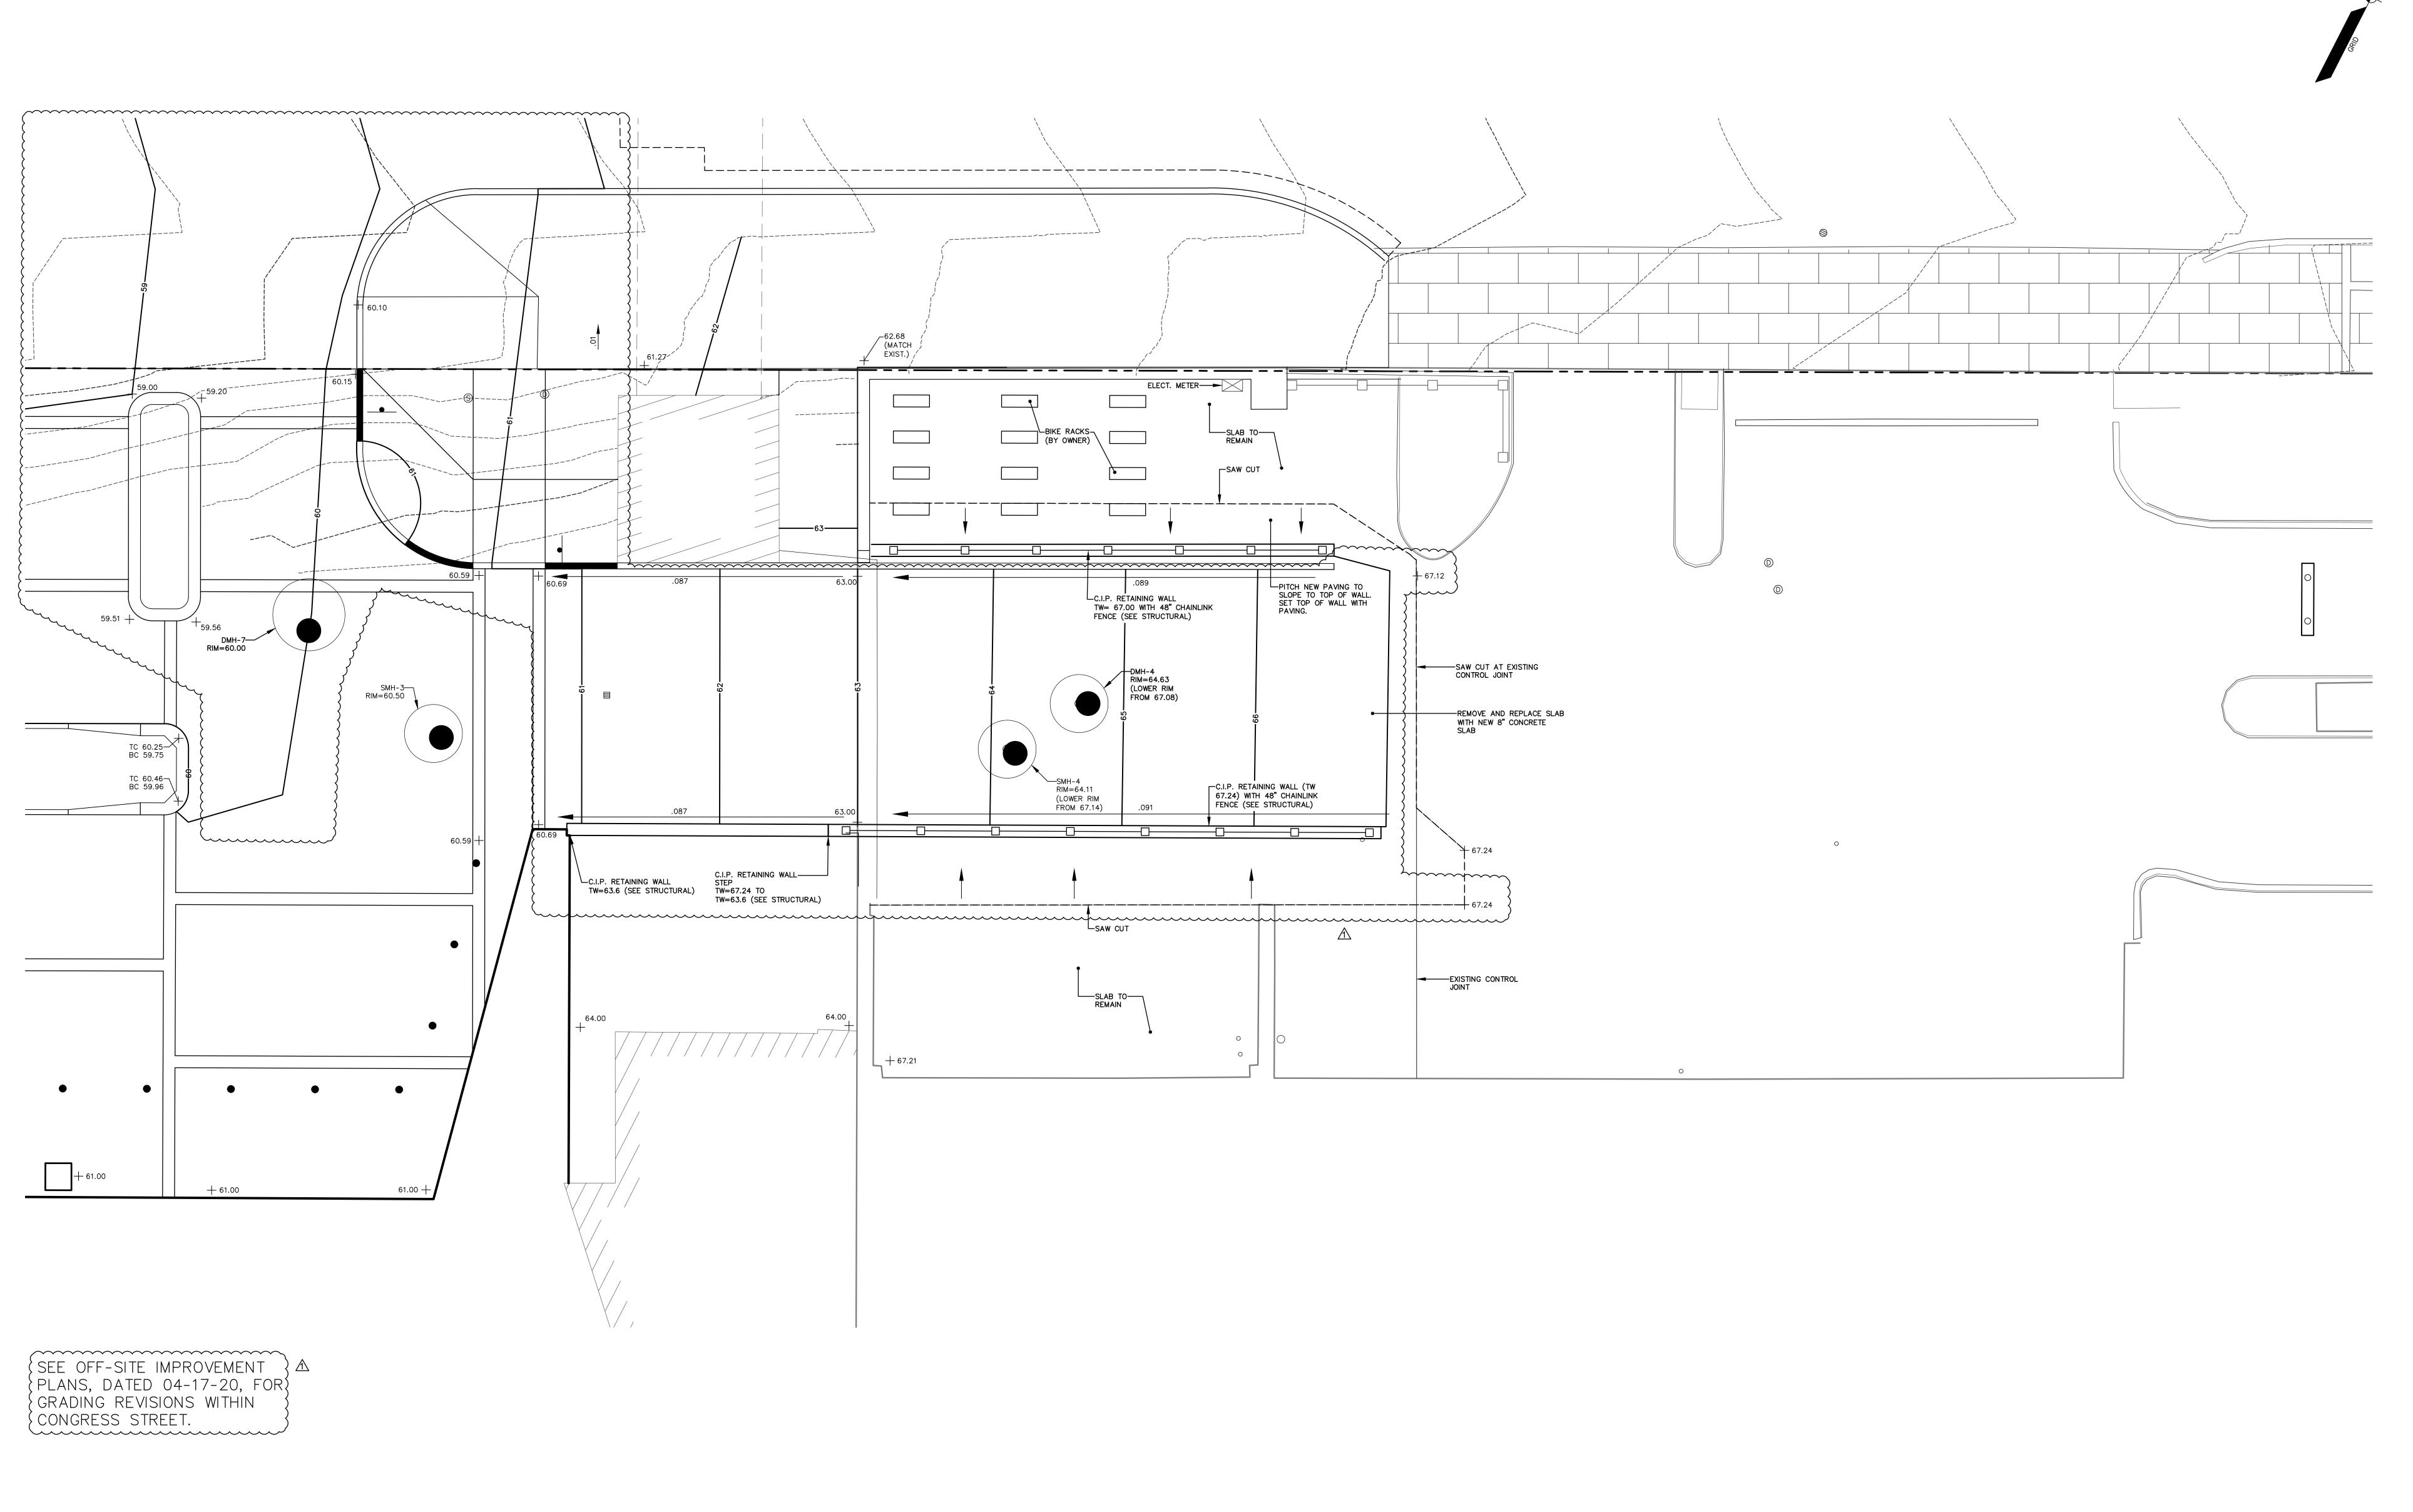

LEGEND

EXISTING DESCRIPTION PROPOSED — — PROPERTY LINE/R.O.W. — — — —— — — ABUTTER LINE/R.O.W. '///////// BUILDING ----- EDGE PAVEMENT EDGE CONCRETE ------PAVEMENT PAINT ------— — EDGE GRAVEL — — — — ---120-- ---118-- CONTOURS 120-----+120.00 • BOLLARD ── ── SIGN - -WATER GATE VALVE HYDRANT SANITARY MANHOLE DRAINAGE MANHOLE TRANSFORMER PAD ELECTRICAL MANHOLE ELECTRIC METER HVAC UNIT TELEPHONE MANHOLE LIGHT POLE UTILITY POLE GUY WIRE

PERKINS + WILL

225 Franklin Street, Suite 1100

Boston, MA 02110 t 617.478.0300

f 617.478.0321
www.perkinswill.com

CLIENT

Maine Medical Center

Maine Health

Maine Medical Center 22 Bramhall Street

CONSULTANTS

Portland, ME 04102

CIVIL/ LANDSCAPE ARCHITECT

Sebago Technics Inc.

75 John Roberts Road, Suite 1A,
South Portland, ME 04106

South Portland, ME 04106

STRUCTURAL ENG/ BUILDING ENVELOPE CONSULTANT

Simpson Gumpertz & Heger Inc.

Simpson Gumpertz & Heger Inc.
41 Seyon Street, Building 1, Suite 500,
Waltham, MA 02453

MEPFP ENGINEER/CODE/LOW VOLTAGE

AKF Group LLC
99 Bedford Street, 2nd Floor, Boston, MA 02111

CONSTRUCTION MANAGER

TURNER CONSTRUCTION

2 Seaport Lane, Suite 200, Boston, MA 02210

ELEVATOR CONSULTANT

VDA (Van Deusen & Associates)

101 Summer Street, 4th Floor, Boston, MA 02110

COST ESTIMATOR

D.G. Jones International

3 Baldwin Green Common, Suite 202, Woburn, MA 01801

MEDICAL EQUIPMENT PLANNING

Mitchell Planning
630 Dundee Road, Suite 340, Northbrook IL 60062

Congress Street

Building 22 Bramhall Street Portland ME 04102



KEY PLANS

SECTOR SECTOR VISITORS
01 02 GARAGE

BEAN
BUILDING

OVERALL KEY PLAN

1 - NOT USED

2 - CONGRESS STREET

3 - VISITOR GARAGE


4 - EAST TOWER

5 - CENTRAL UTILITY PLANT

6 - BEAN BUILDING

7 - RICHARDS BUILDING

8 - MAINE GENERAL BUILDING

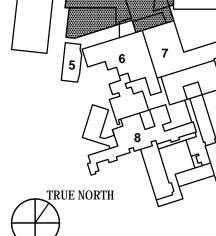

ISSUED FOR CONSTRUCTION November 15, 2019

 1
 ADDENDUM NO. 2
 01 MAY 20

 NO
 ISSUE
 DATE

 Job Number
 152189.000

 Drawn
 MAL

GRADING PLAN, VISITOR GARAGE

SHEET NUMBER

C40-01A


Copyright 2019 @ Perkins + Will


GRAPHIC SCALE

0 2.5 5 10

(IN FEET)

1 INCH = 5 FT.

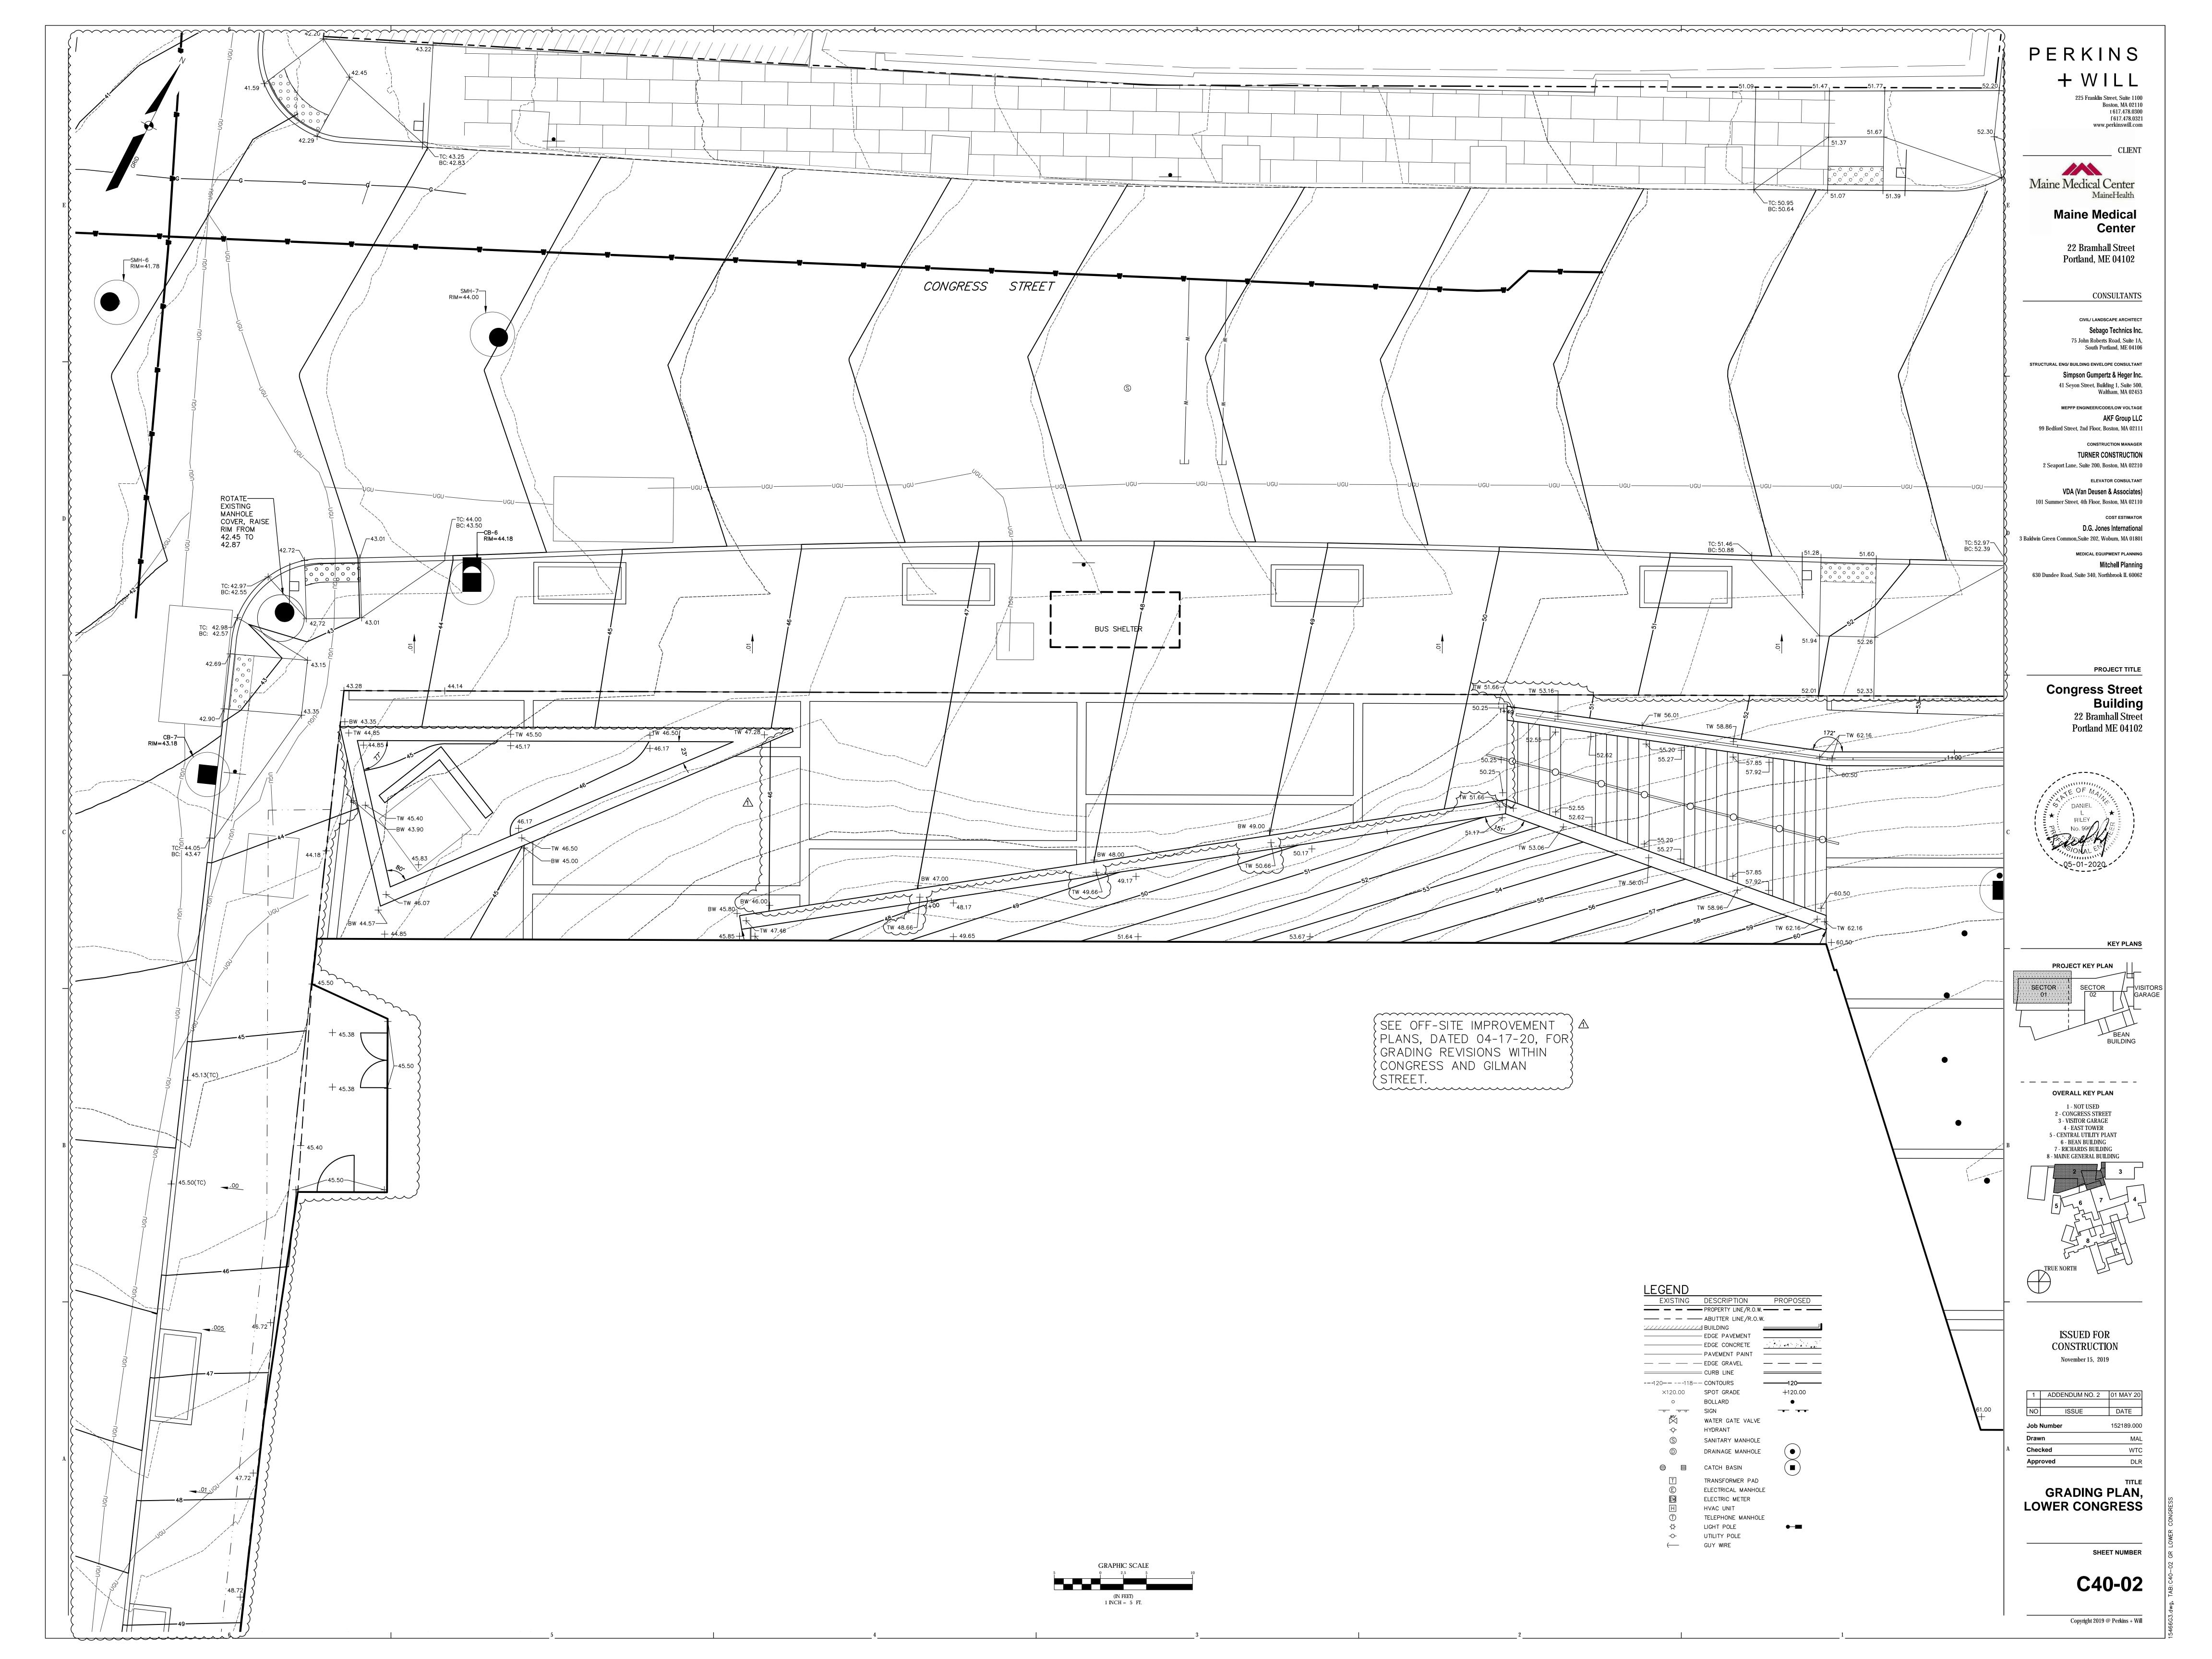

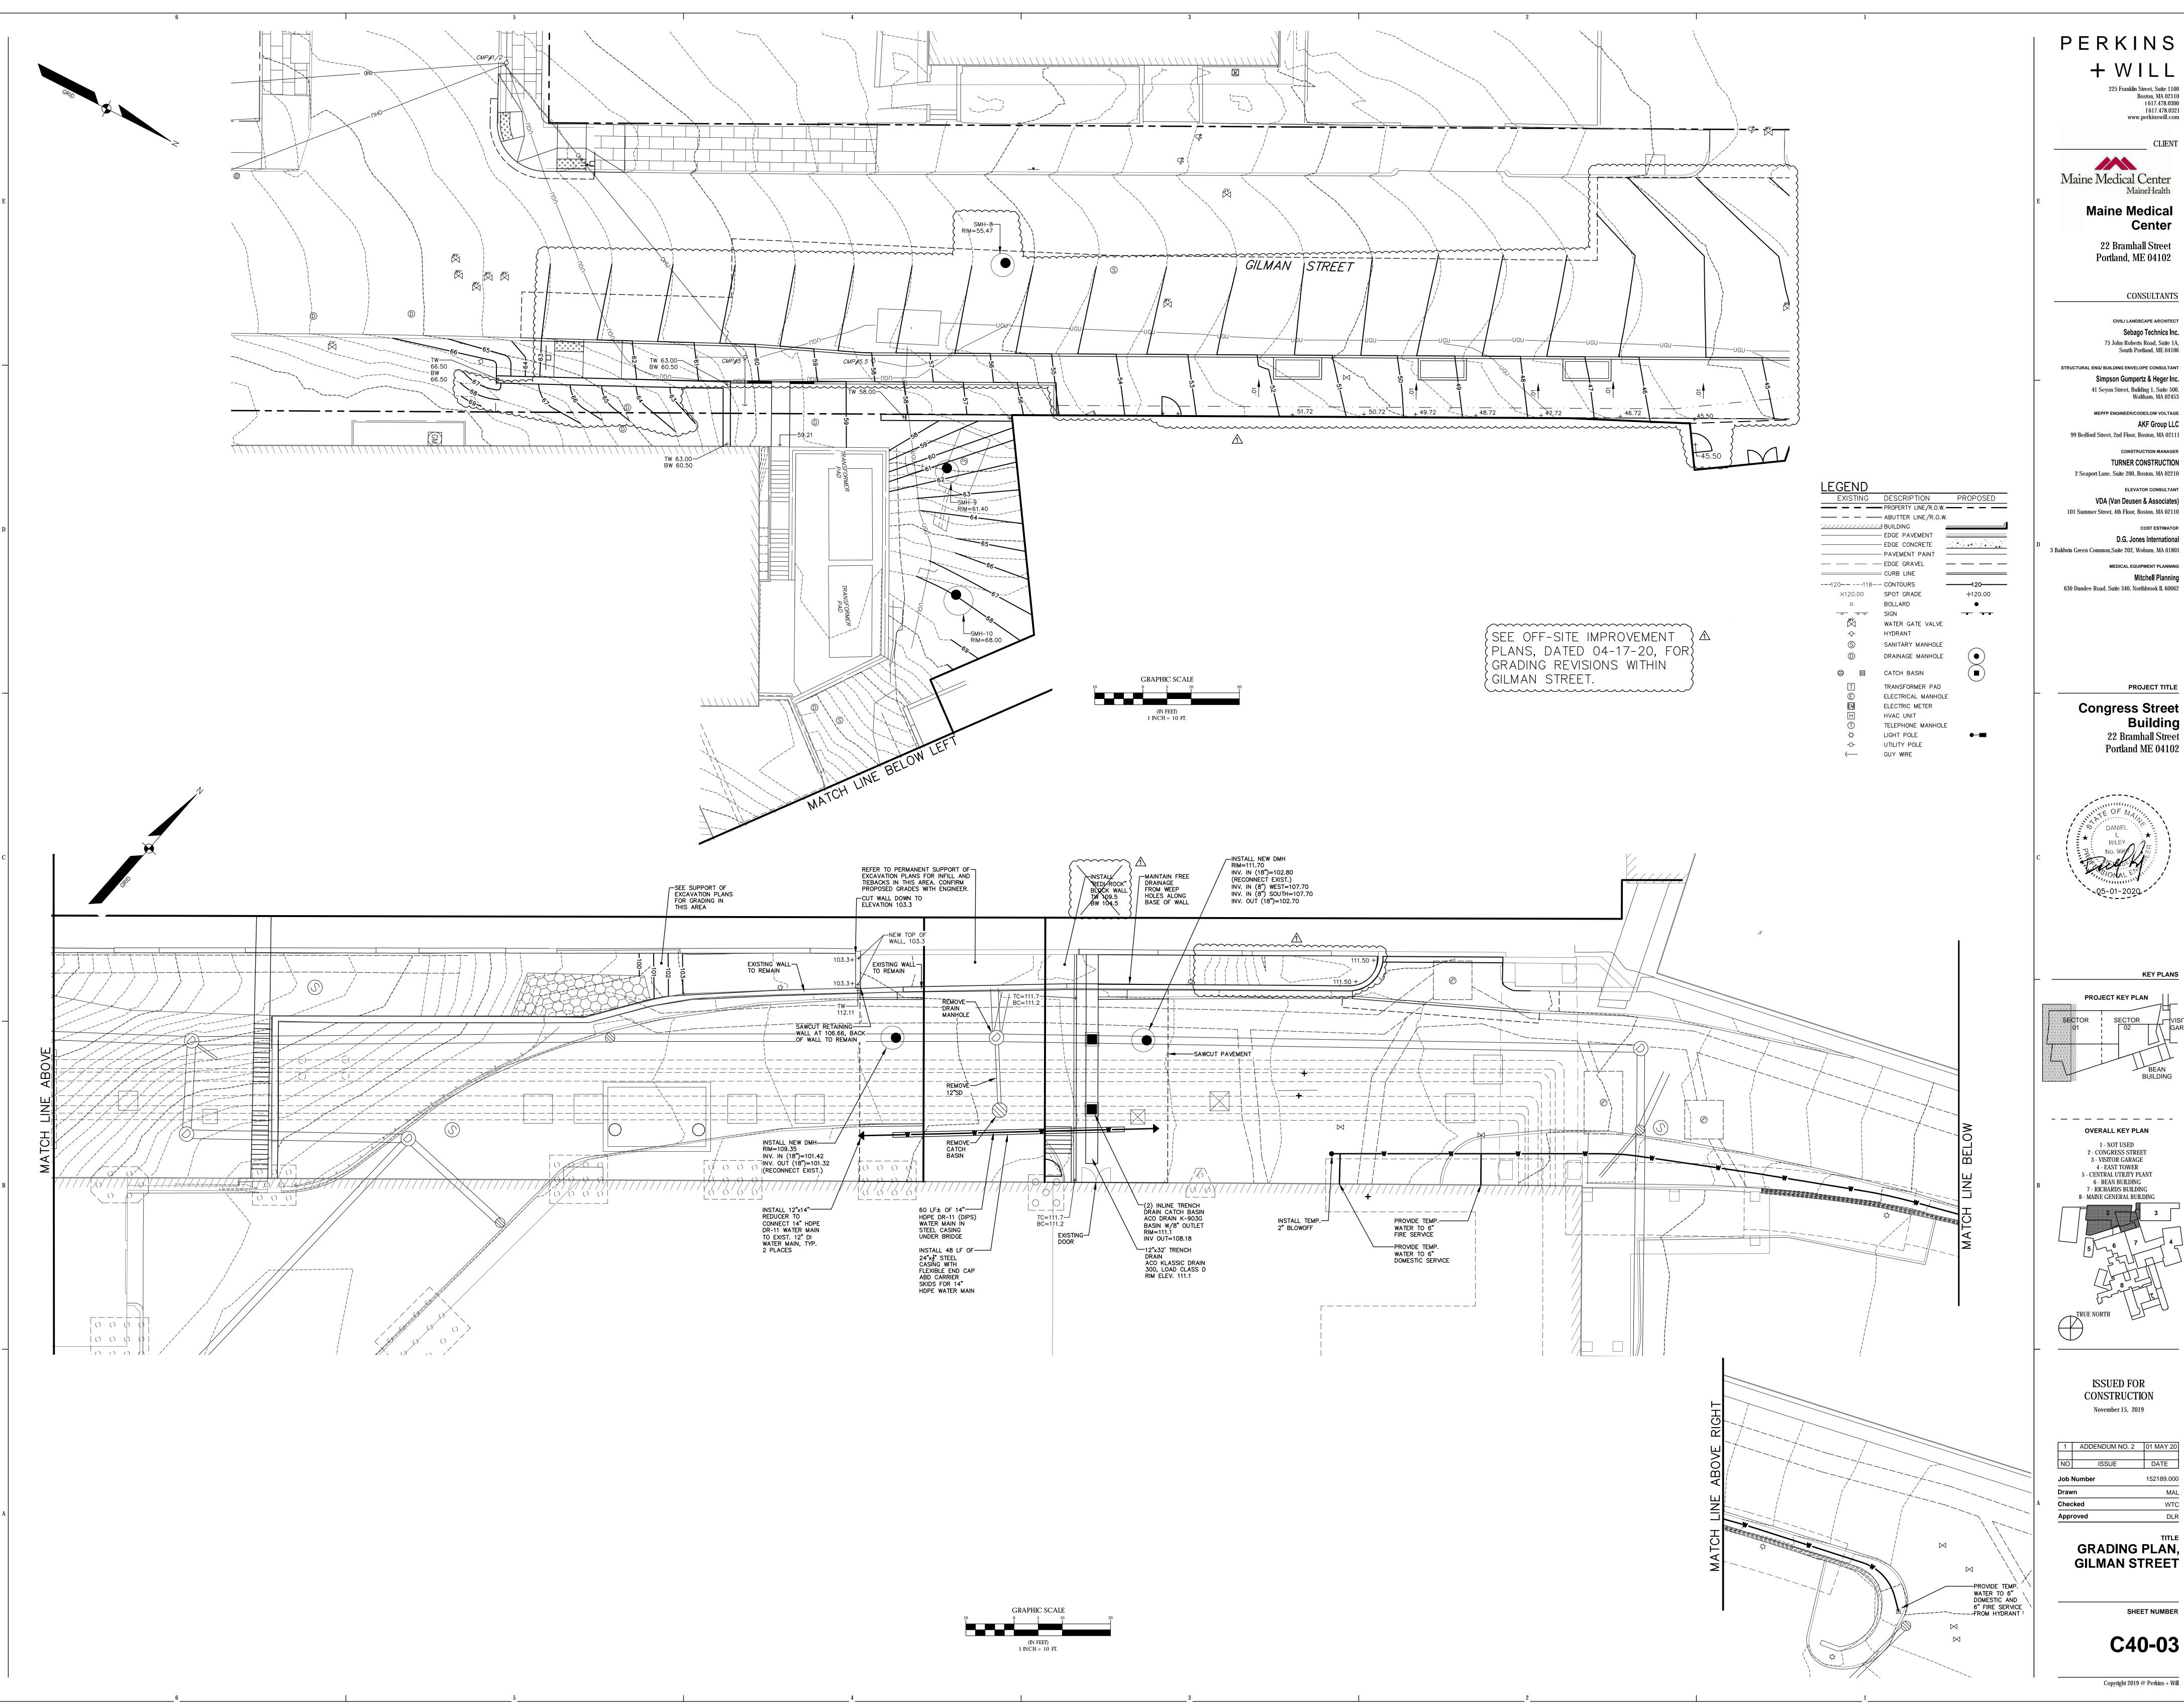

PERKINS + WILL

> www.perkinswill.com CLIENT

**Maine Medical** Center

CONSULTANTS

CIVIL/ LANDSCAPE ARCHITECT Sebago Technics Inc. 75 John Roberts Road, Suite 1A,

Simpson Gumpertz & Heger Inc.

Waltham, MA 02453 MEPFP ENGINEER/CODE/LOW VOLTAGE AKF Group LLC

TURNER CONSTRUCTION 2 Seaport Lane, Suite 200, Boston, MA 02210

VDA (Van Deusen & Associates) 101 Summer Street, 4th Floor, Boston, MA 02110

> D.G. Jones International MEDICAL EQUIPMENT PLANNING

Mitchell Planning

PROJECT TITLE **Congress Street** 


**KEY PLANS** 

-----

ADDENDUM NO. 2 01 MAY 20 152189.000 MAL

**GRADING PLAN,** 

C40-03

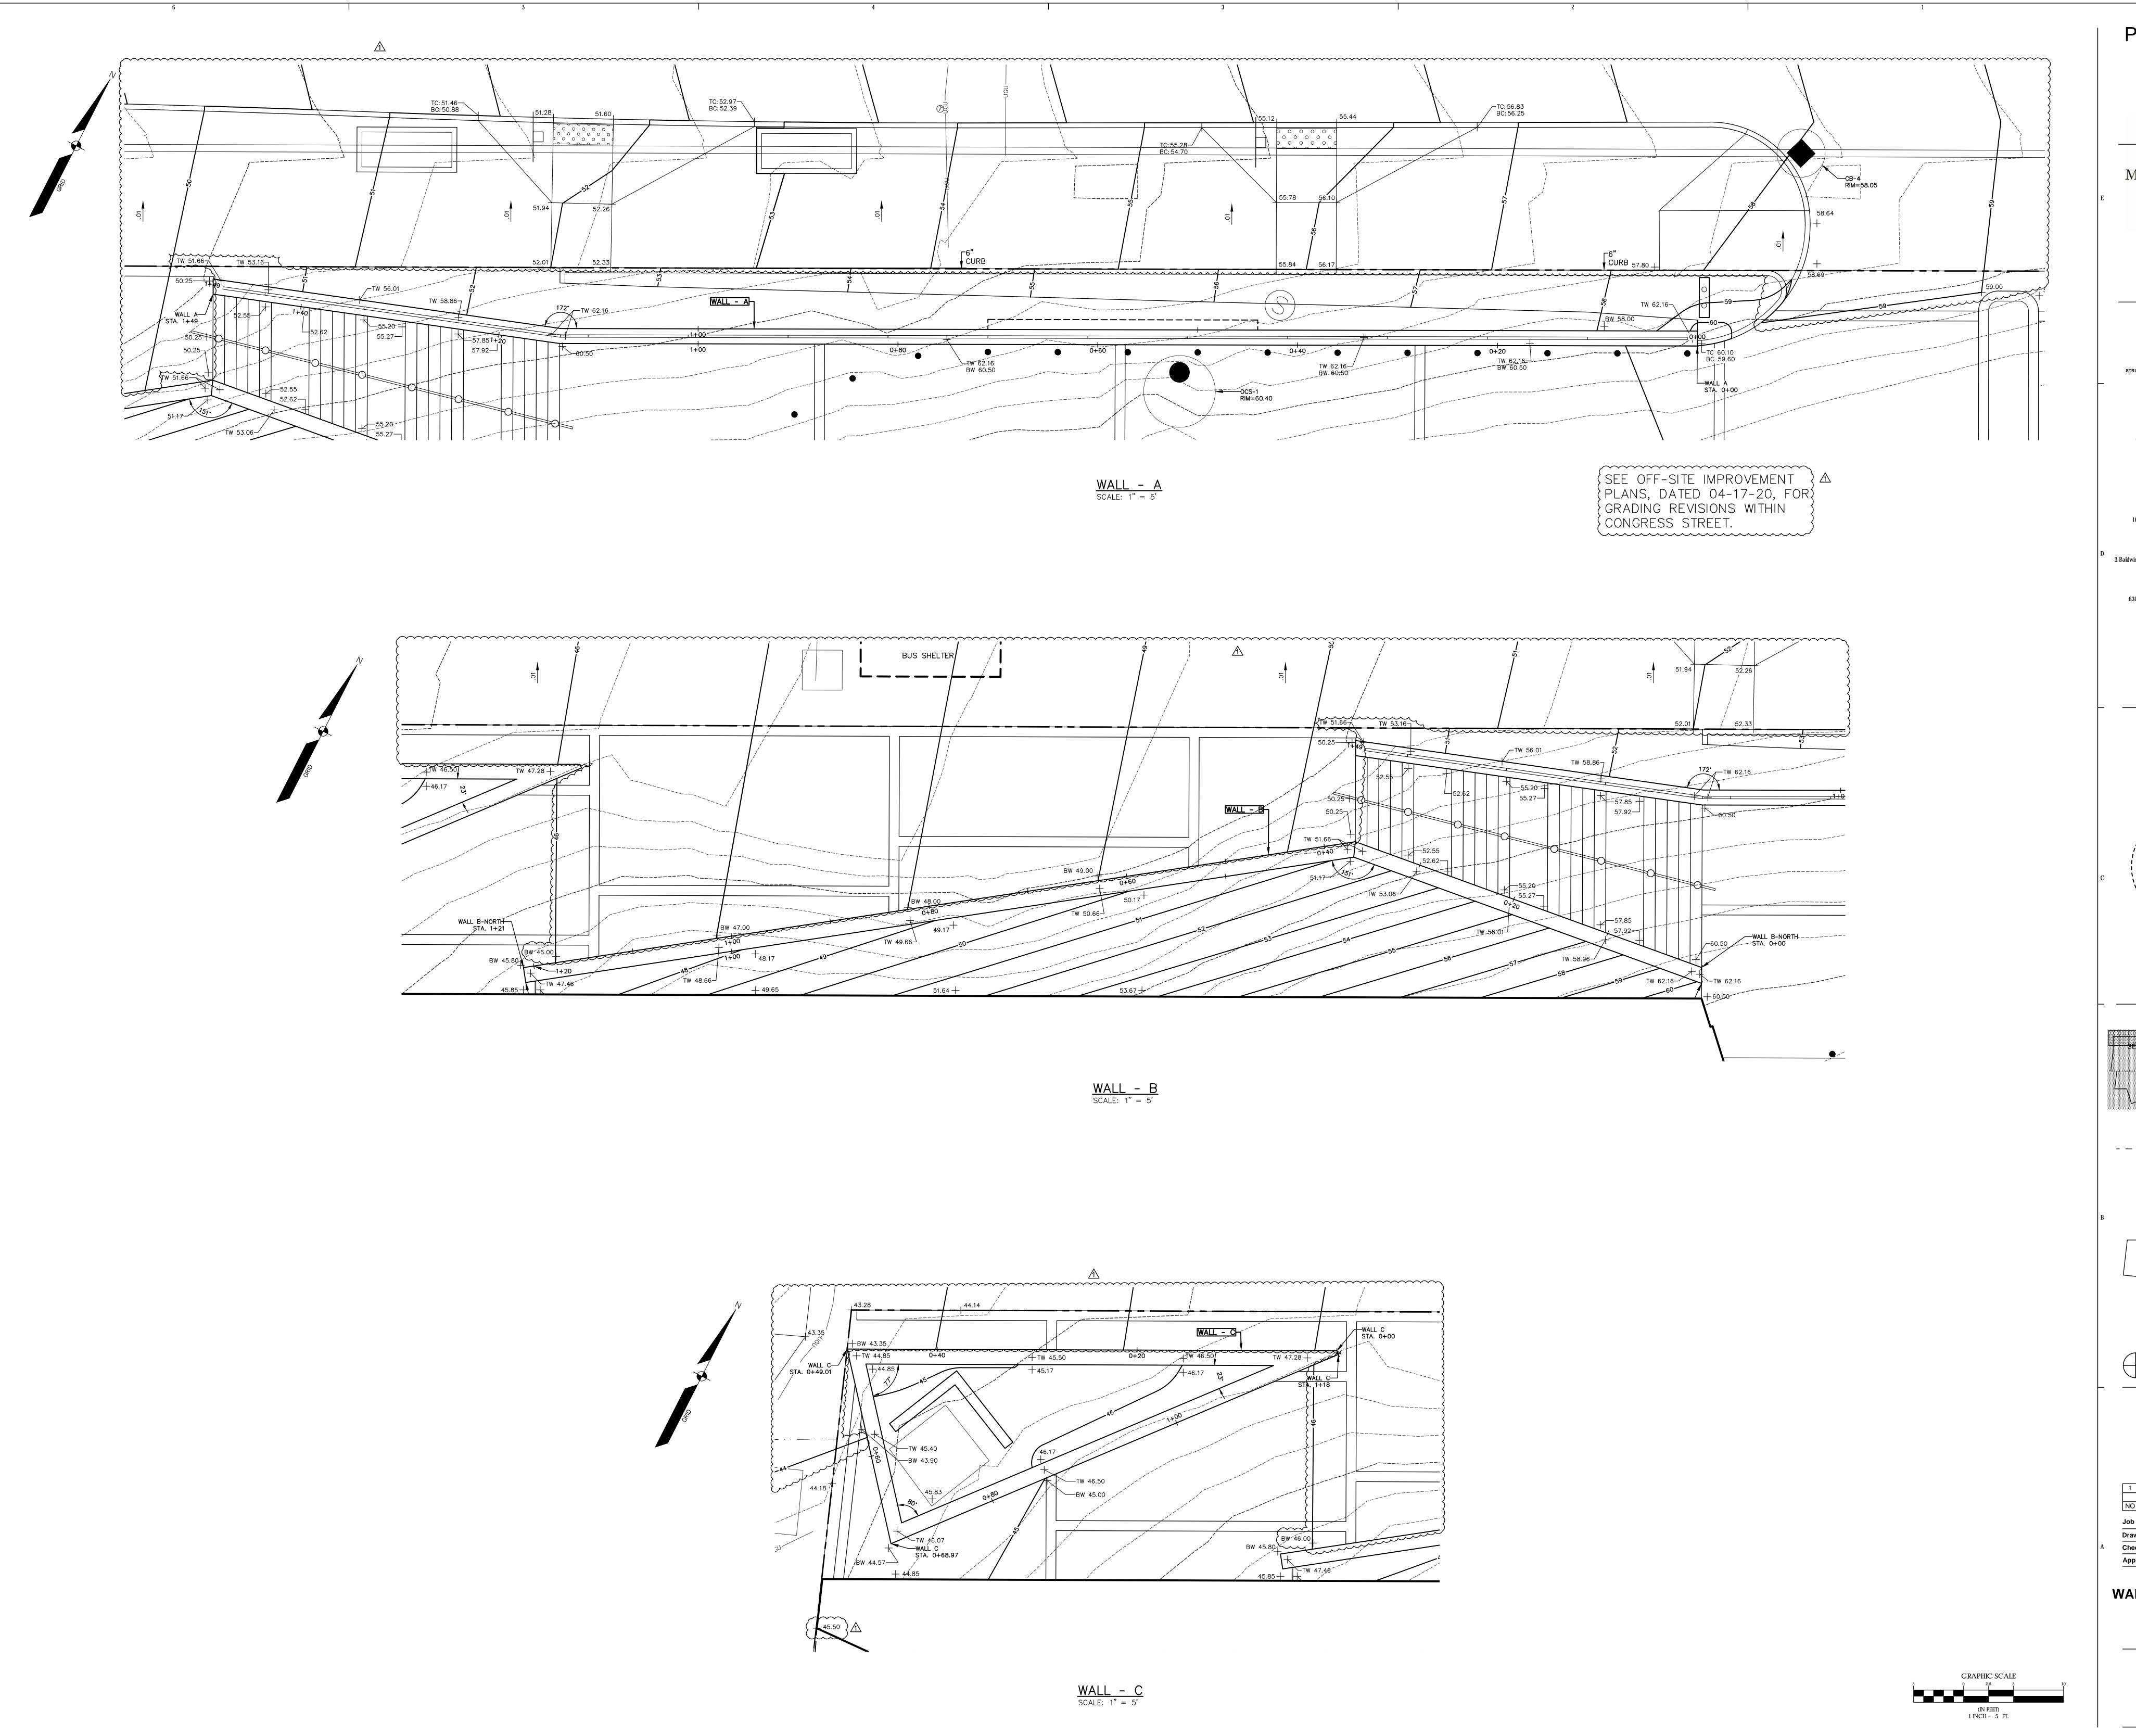

PERKINS

+ W I L L

225 Franklin Street, Suite 1100
Boston, MA 02110
t 617.478.0300

f 617.478.0321 www.perkinswill.com

Maine Medical Center

Maine Medical Center

Maine Medical Center 22 Bramhall Street Portland, ME 04102

CONSULTANTS

Sebago Technics Inc.
75 John Roberts Road, Suite 1A,
South Portland, ME 04106

STRUCTURAL ENG/ BUILDING ENVELOPE CONSULTANT

Simpson Gumpertz & Heger Inc.

41 Seyon Street, Building 1, Suite 500,

Waltham, MA 02453

MEPFP ENGINEER/CODE/LOW VOLTAGE

AKF Group LLC

99 Bedford Street, 2nd Floor, Boston, MA 02111

CONSTRUCTION MANAGER
TURNER CONSTRUCTION
2 Seaport Lane, Suite 200, Boston, MA 02210
ELEVATOR CONSULTANT

VDA (Van Deusen & Associates)
101 Summer Street, 4th Floor, Boston, MA 02110

COST ESTIMATOR


D.G. Jones International
3 Baldwin Green Common, Suite 202, Woburn, MA 01801

MEDICAL EQUIPMENT PLANNING

Mitchell Planning

PROJECT TITLE

Congress Street
Building
22 Bramhall Street
Portland ME 04102

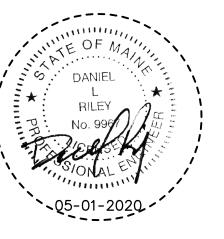

PROJECT KEY PLAN

SECTOR SECTOR VISITOR GARAGI

01 02 GARAGI

BEAN
BUILDING

OVERALL KEY PLAN

1 - NOT USED
2 - CONGRESS STREET
3 - VISITOR GARAGE
4 - EAST TOWER
5 - CENTRAL UTILITY PLANT
6 - BEAN BUILDING
7 - RICHARDS BUILDING
8 - MAINE GENERAL BUILDING

TRUE NORTH

ISSUED FOR CONSTRUCTION November 15, 2019

 1
 ADDENDUM NO. 2
 01 MAY 20

 NO
 ISSUE
 DATE

 Job Number
 152189.000

 Drawn
 MAL


 Checked
 WTC


WALLS - PLAN VIEW, GILMAN STREET


SHEET NUMBER


C40-04

Copyright 2019 @ Perkins + Will

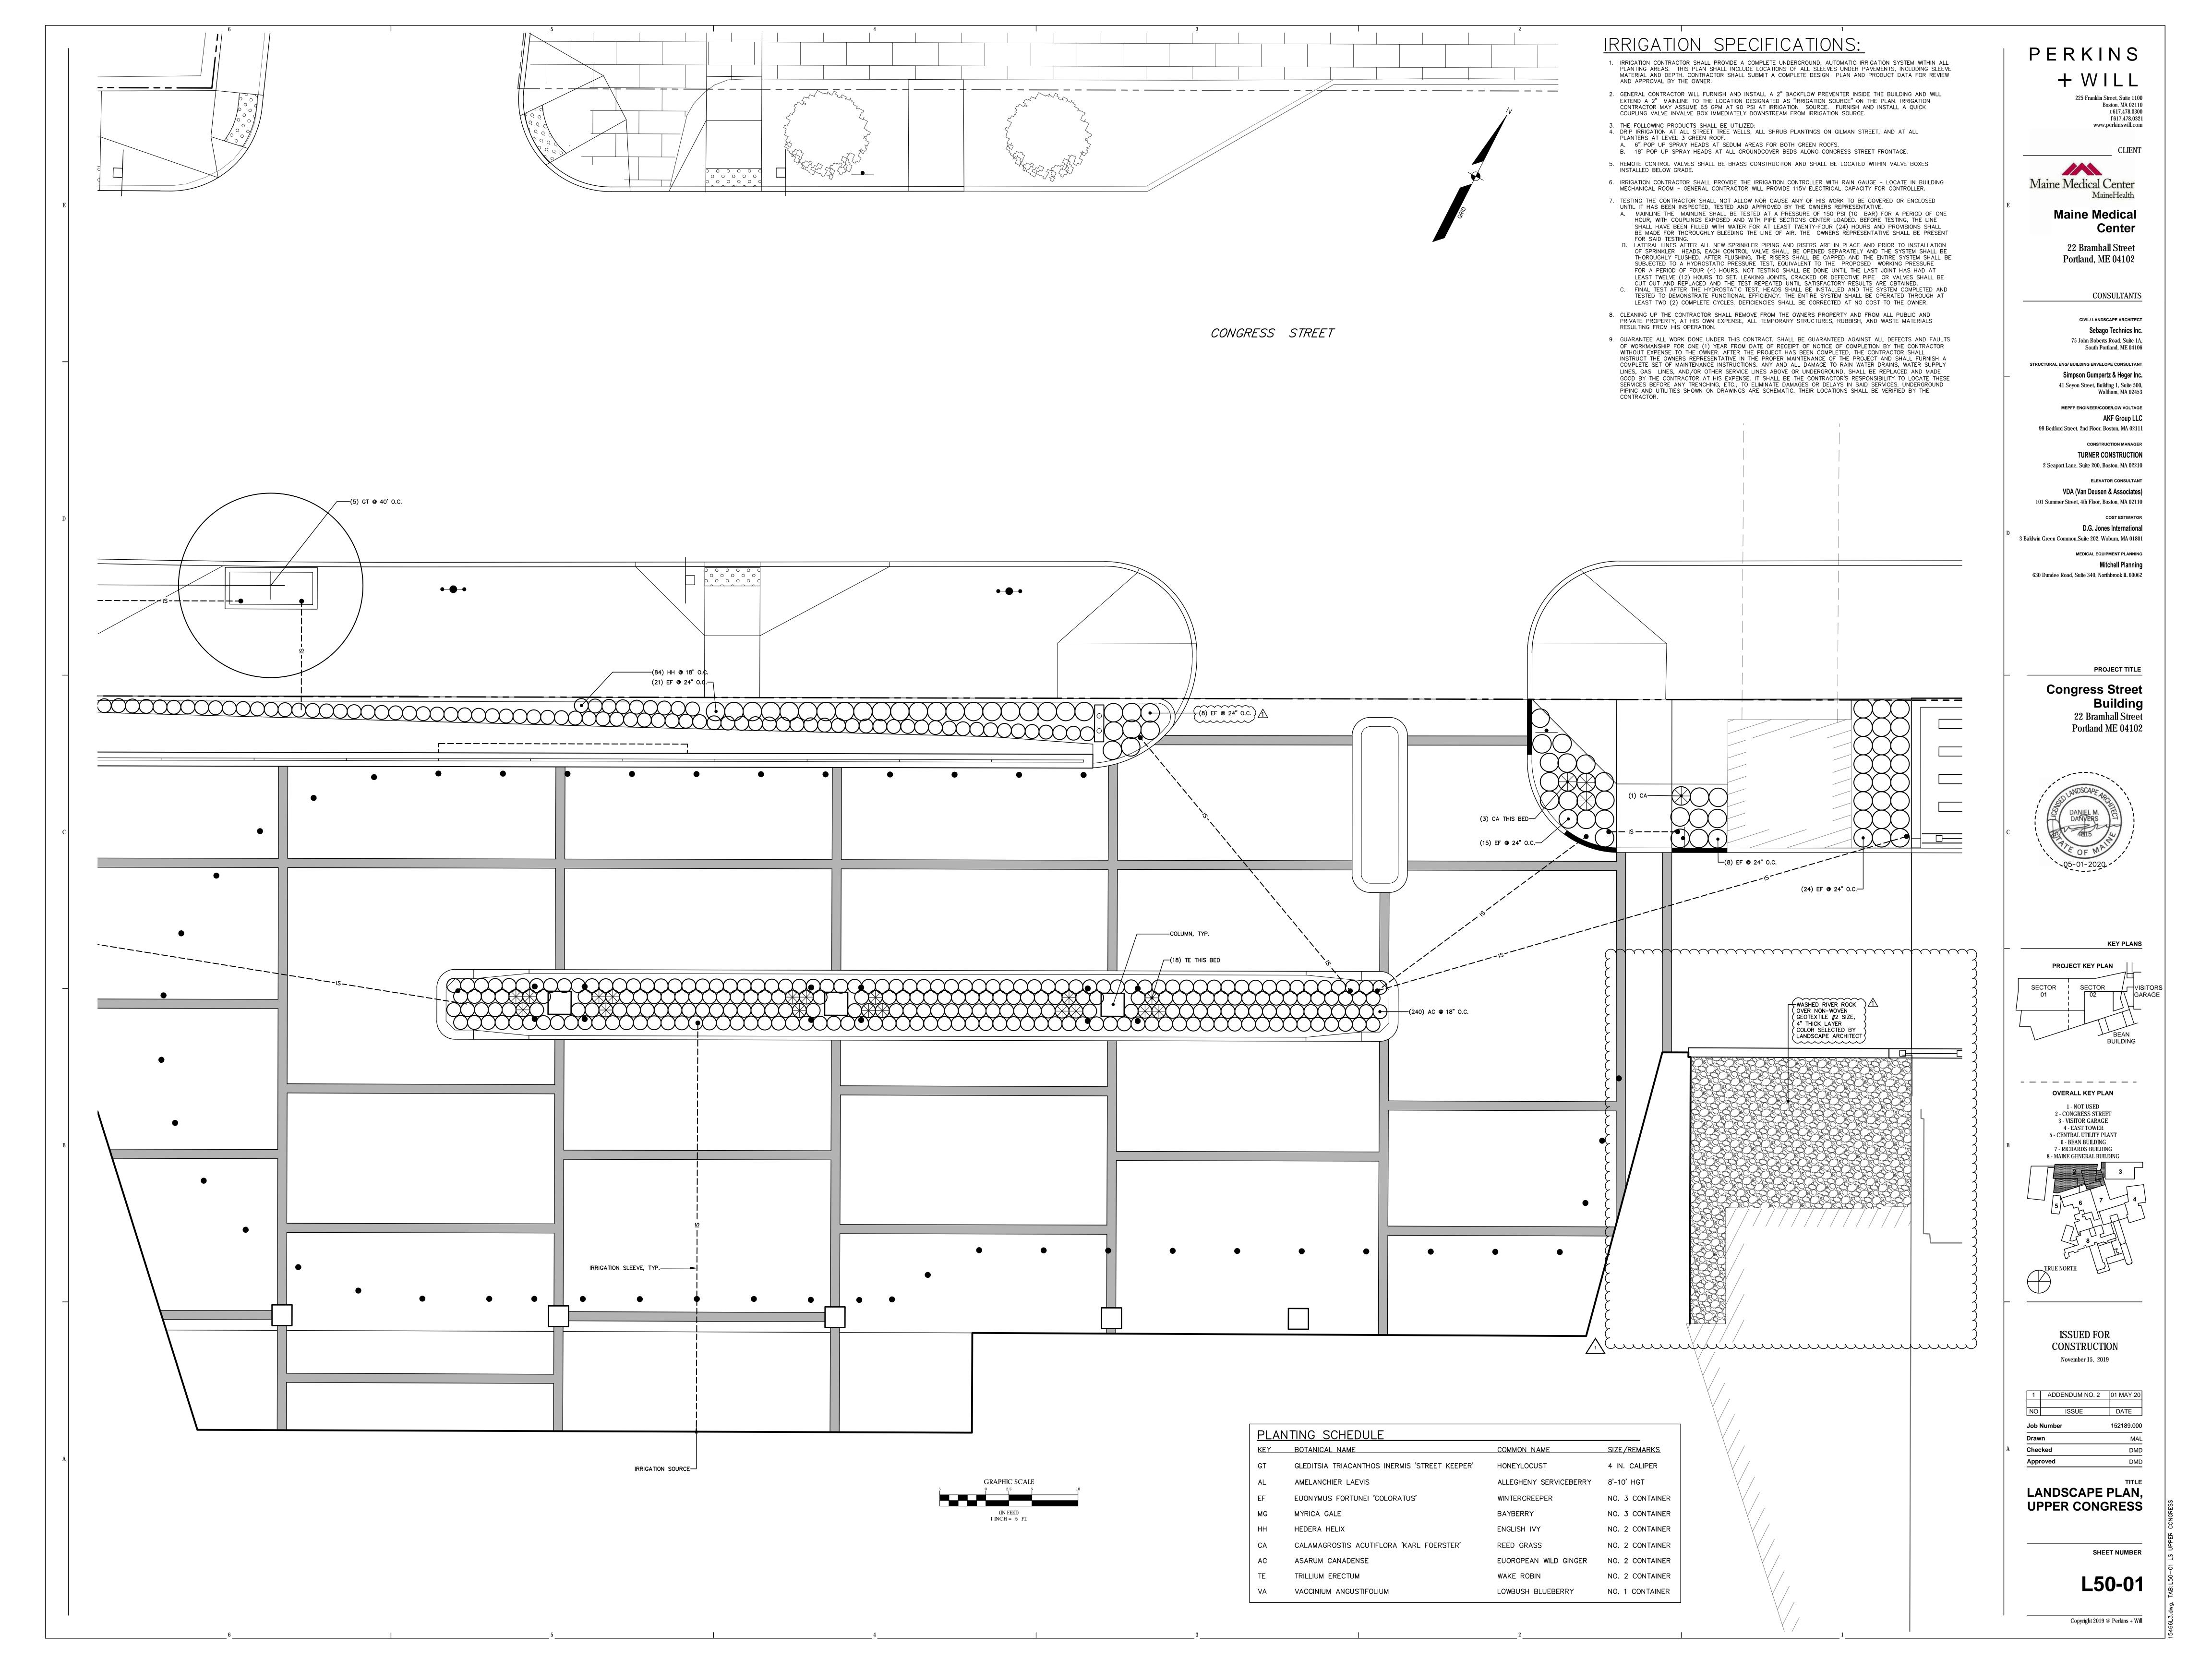

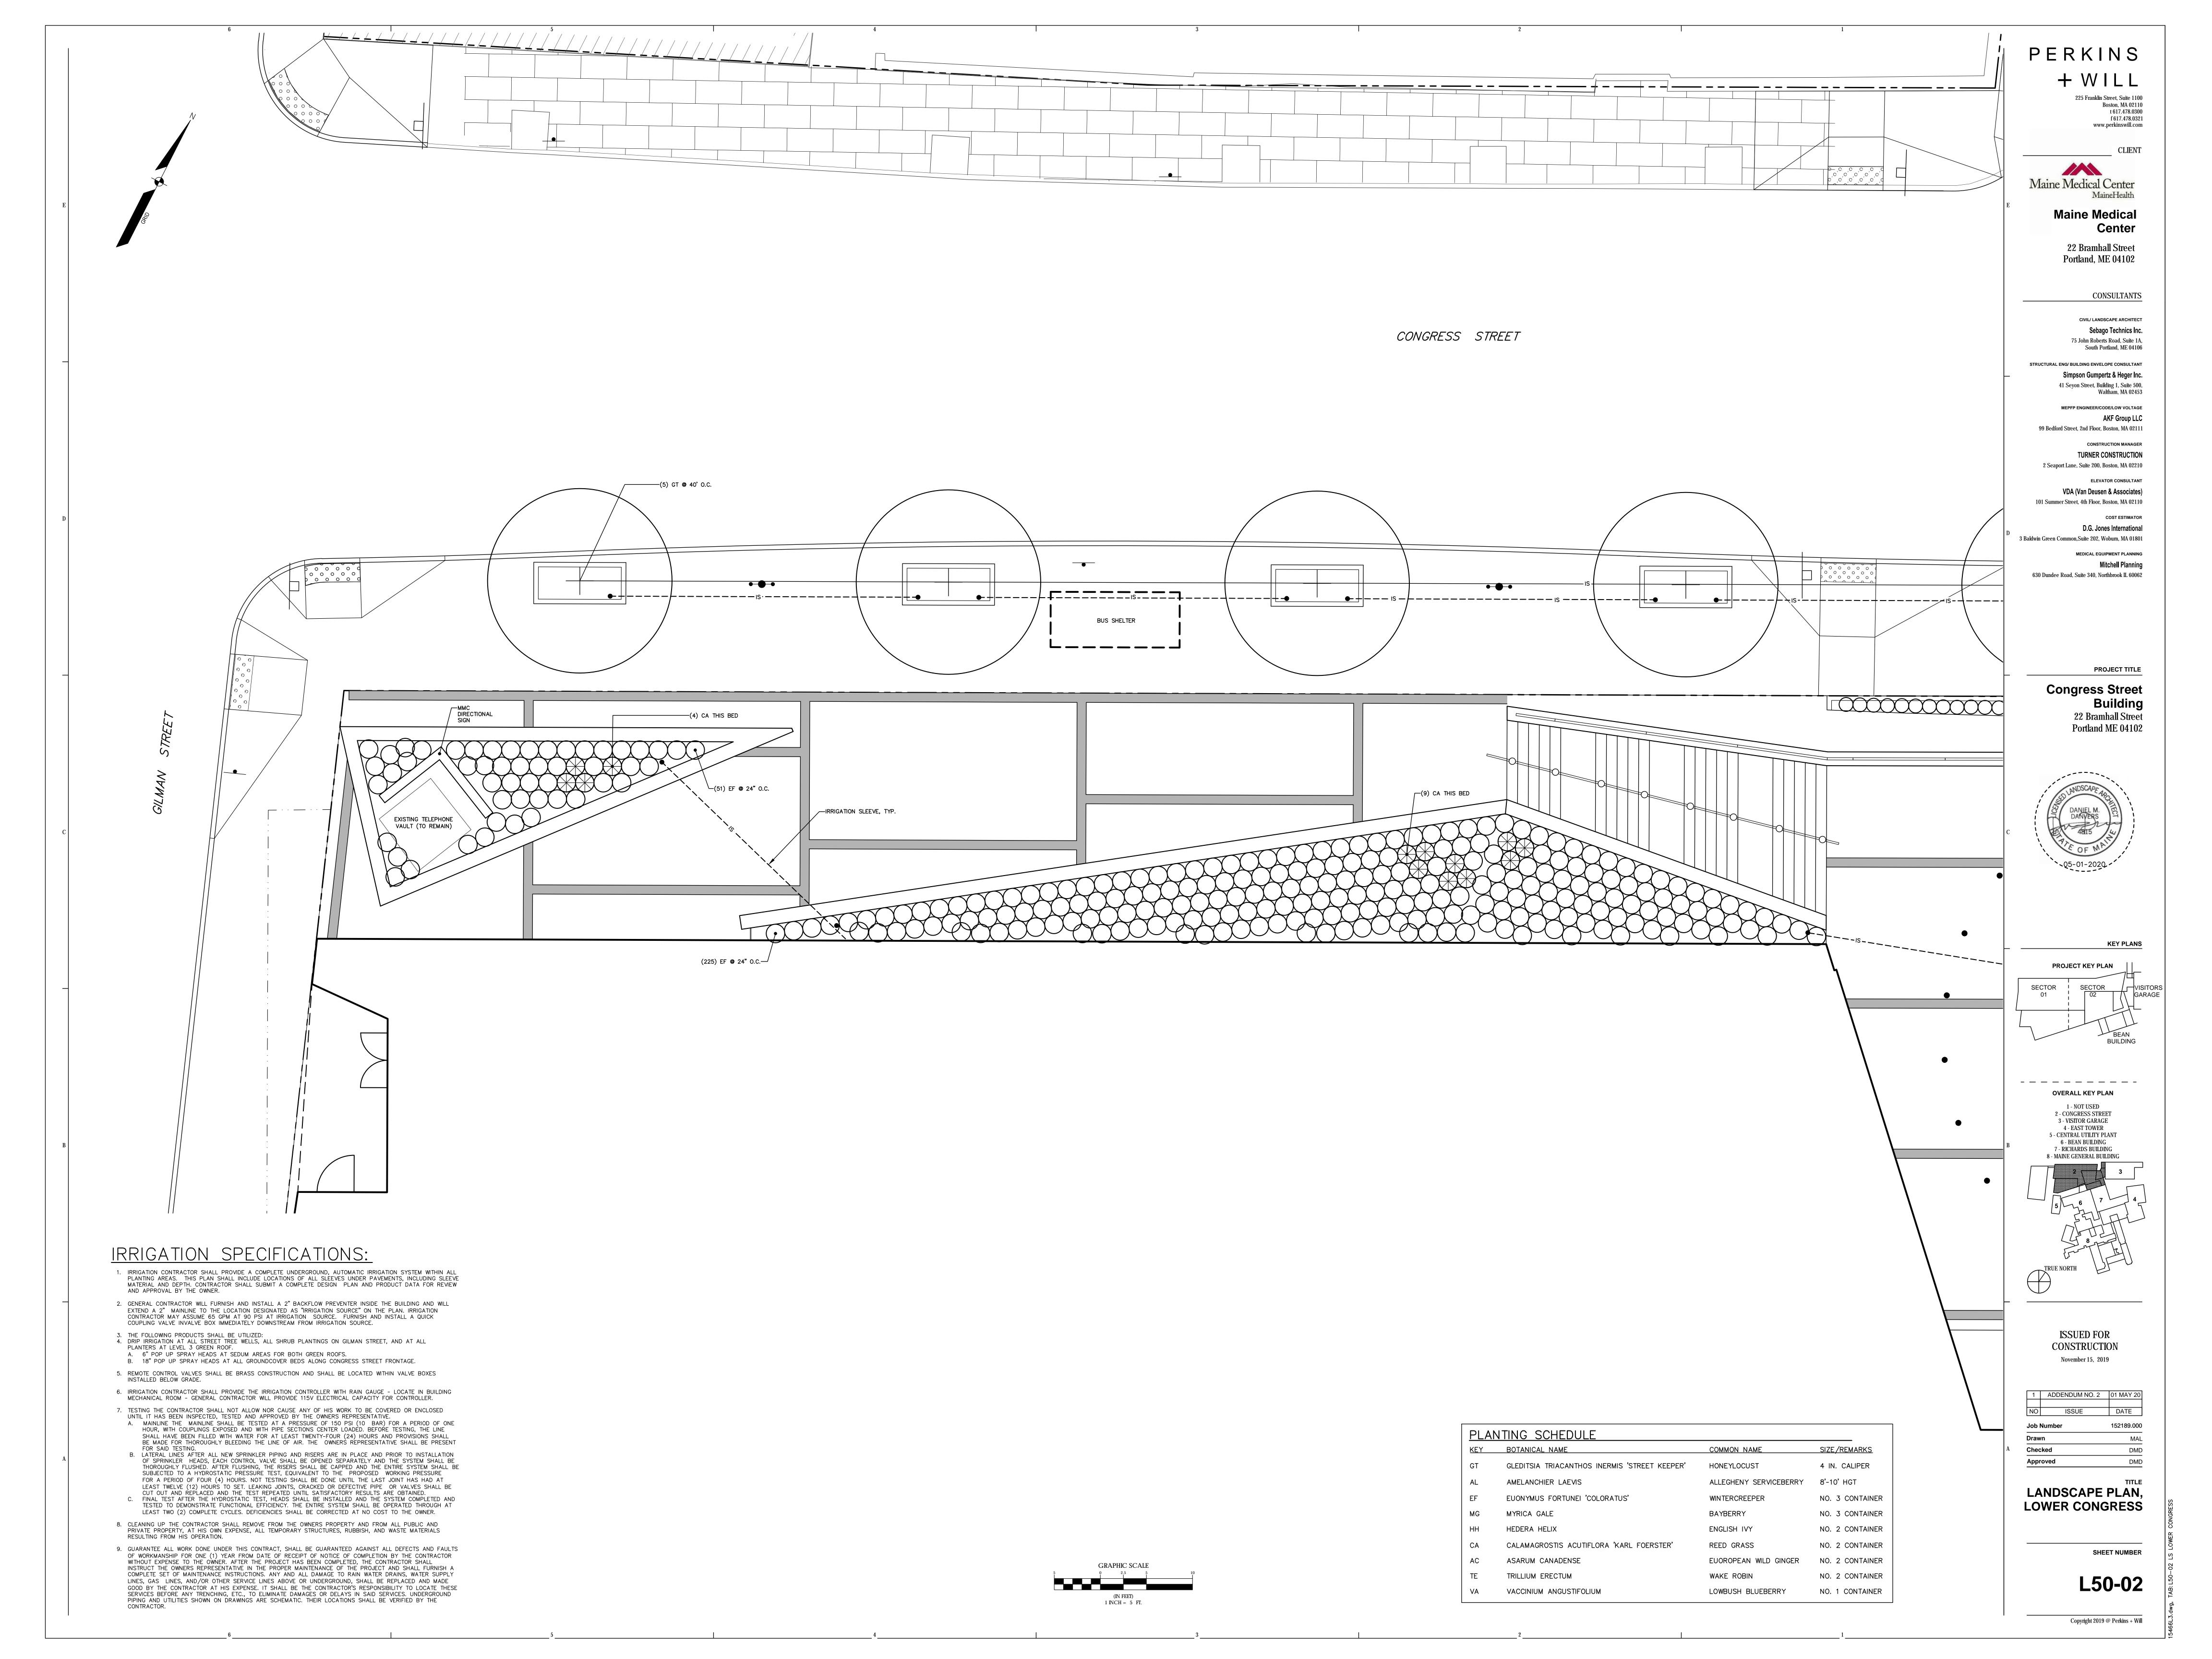

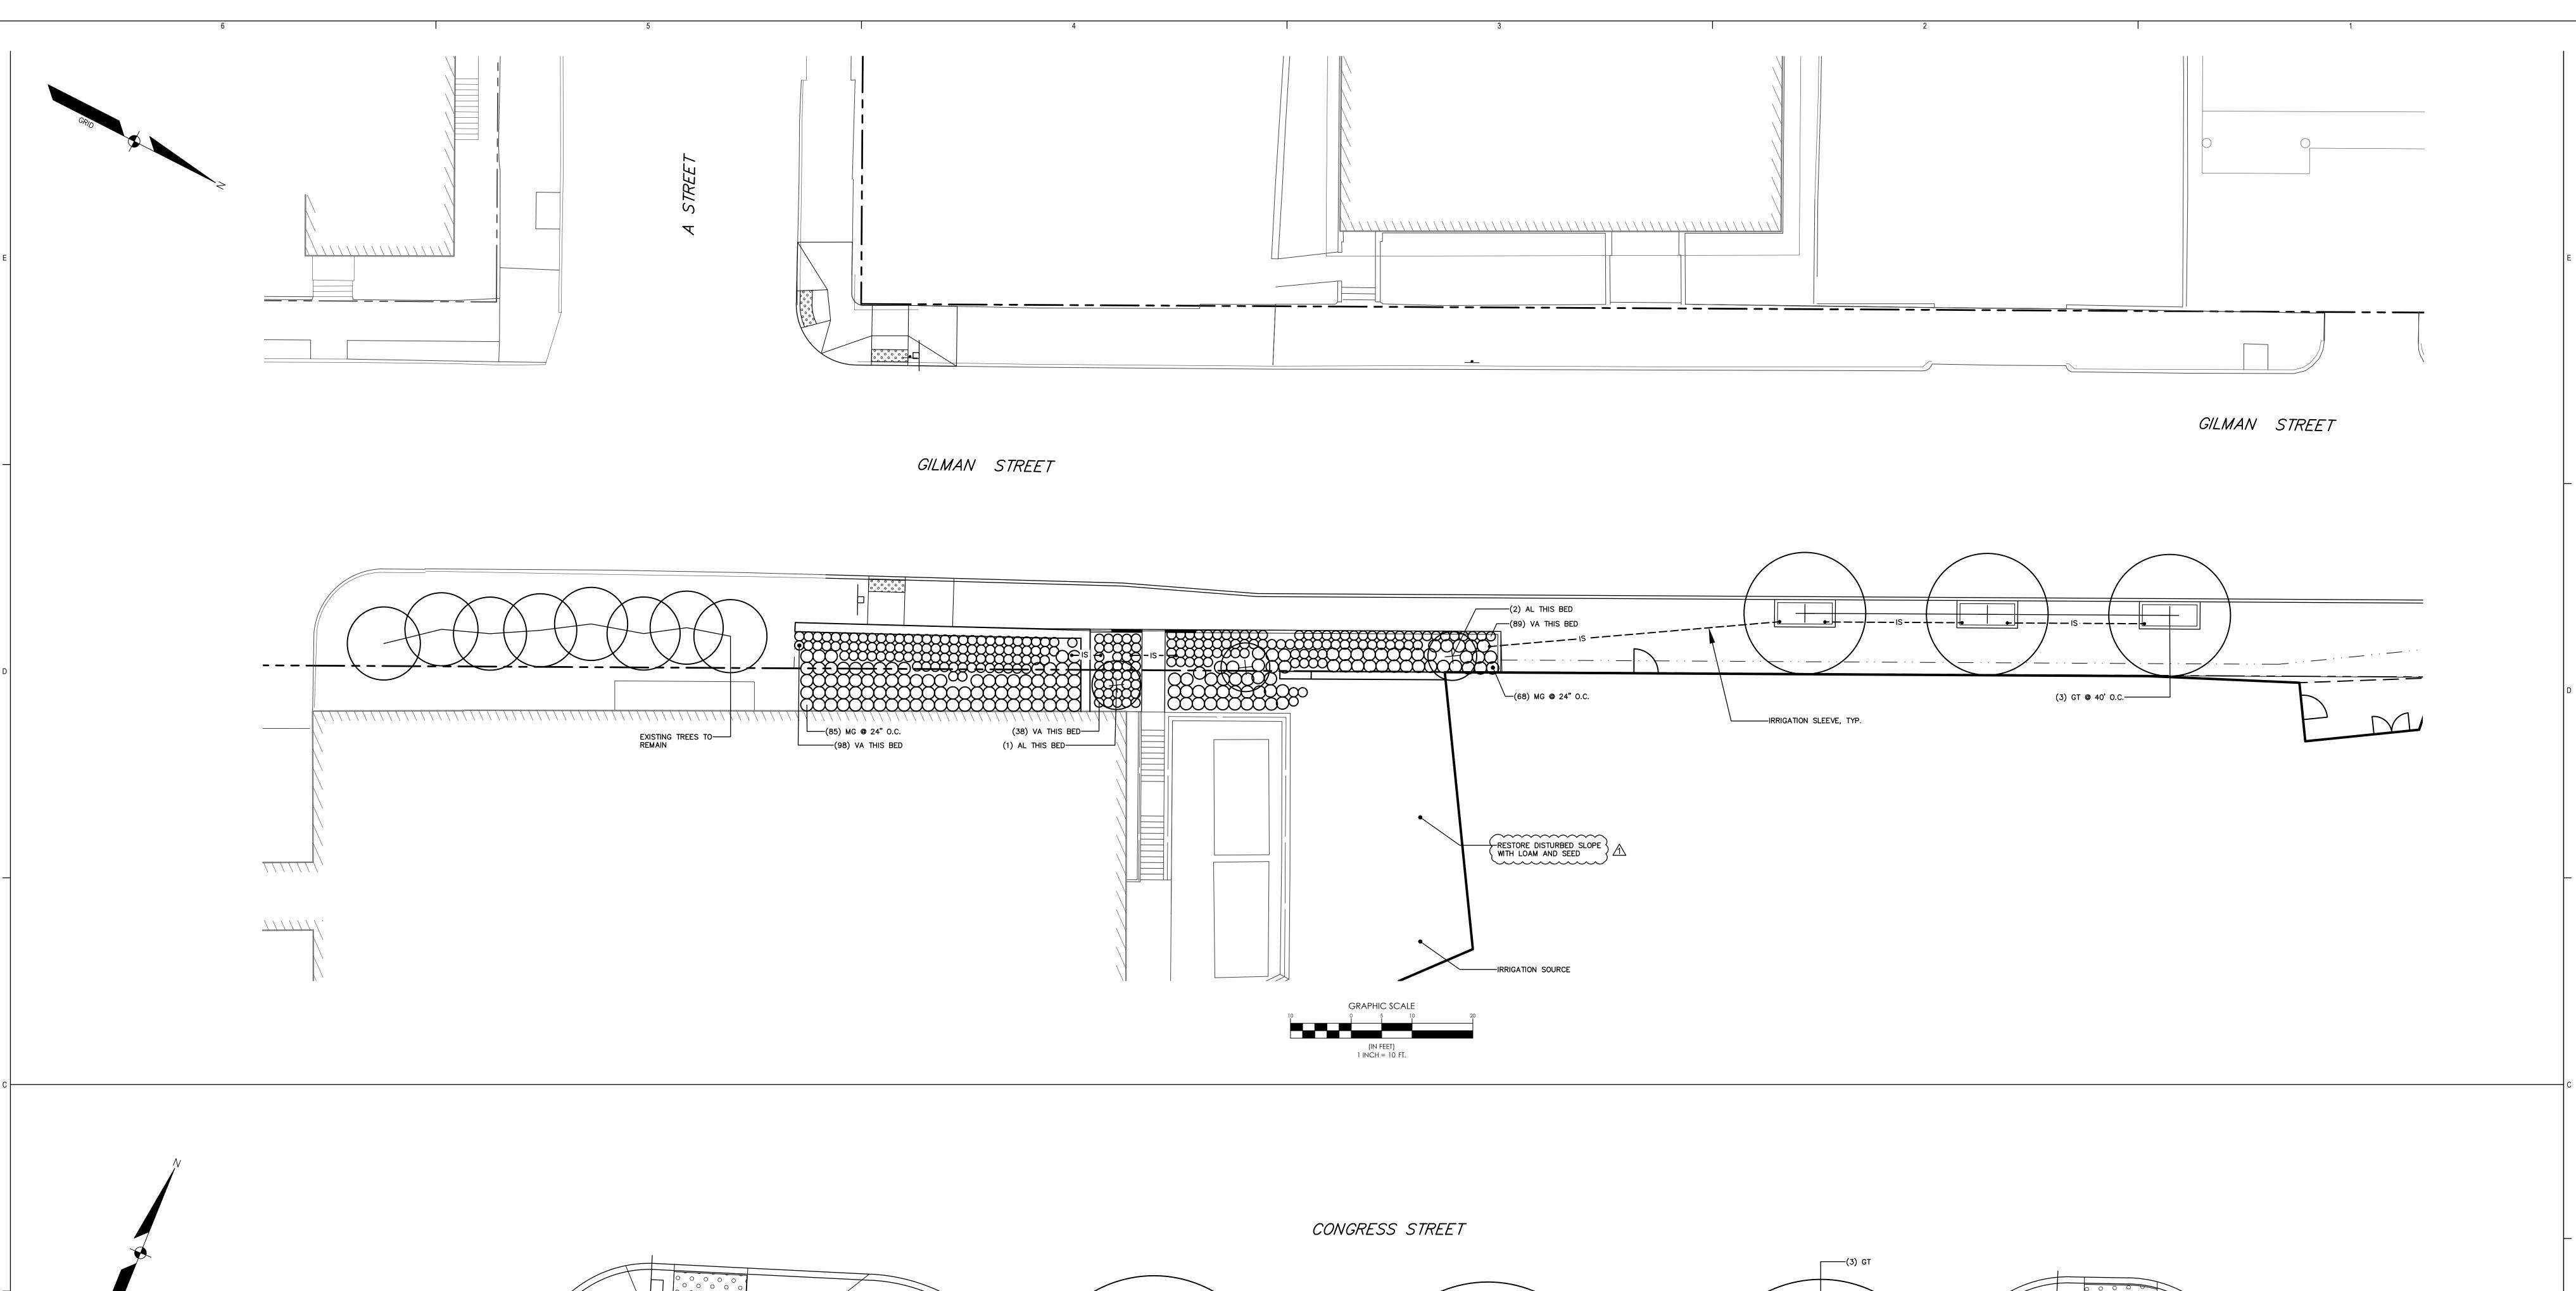

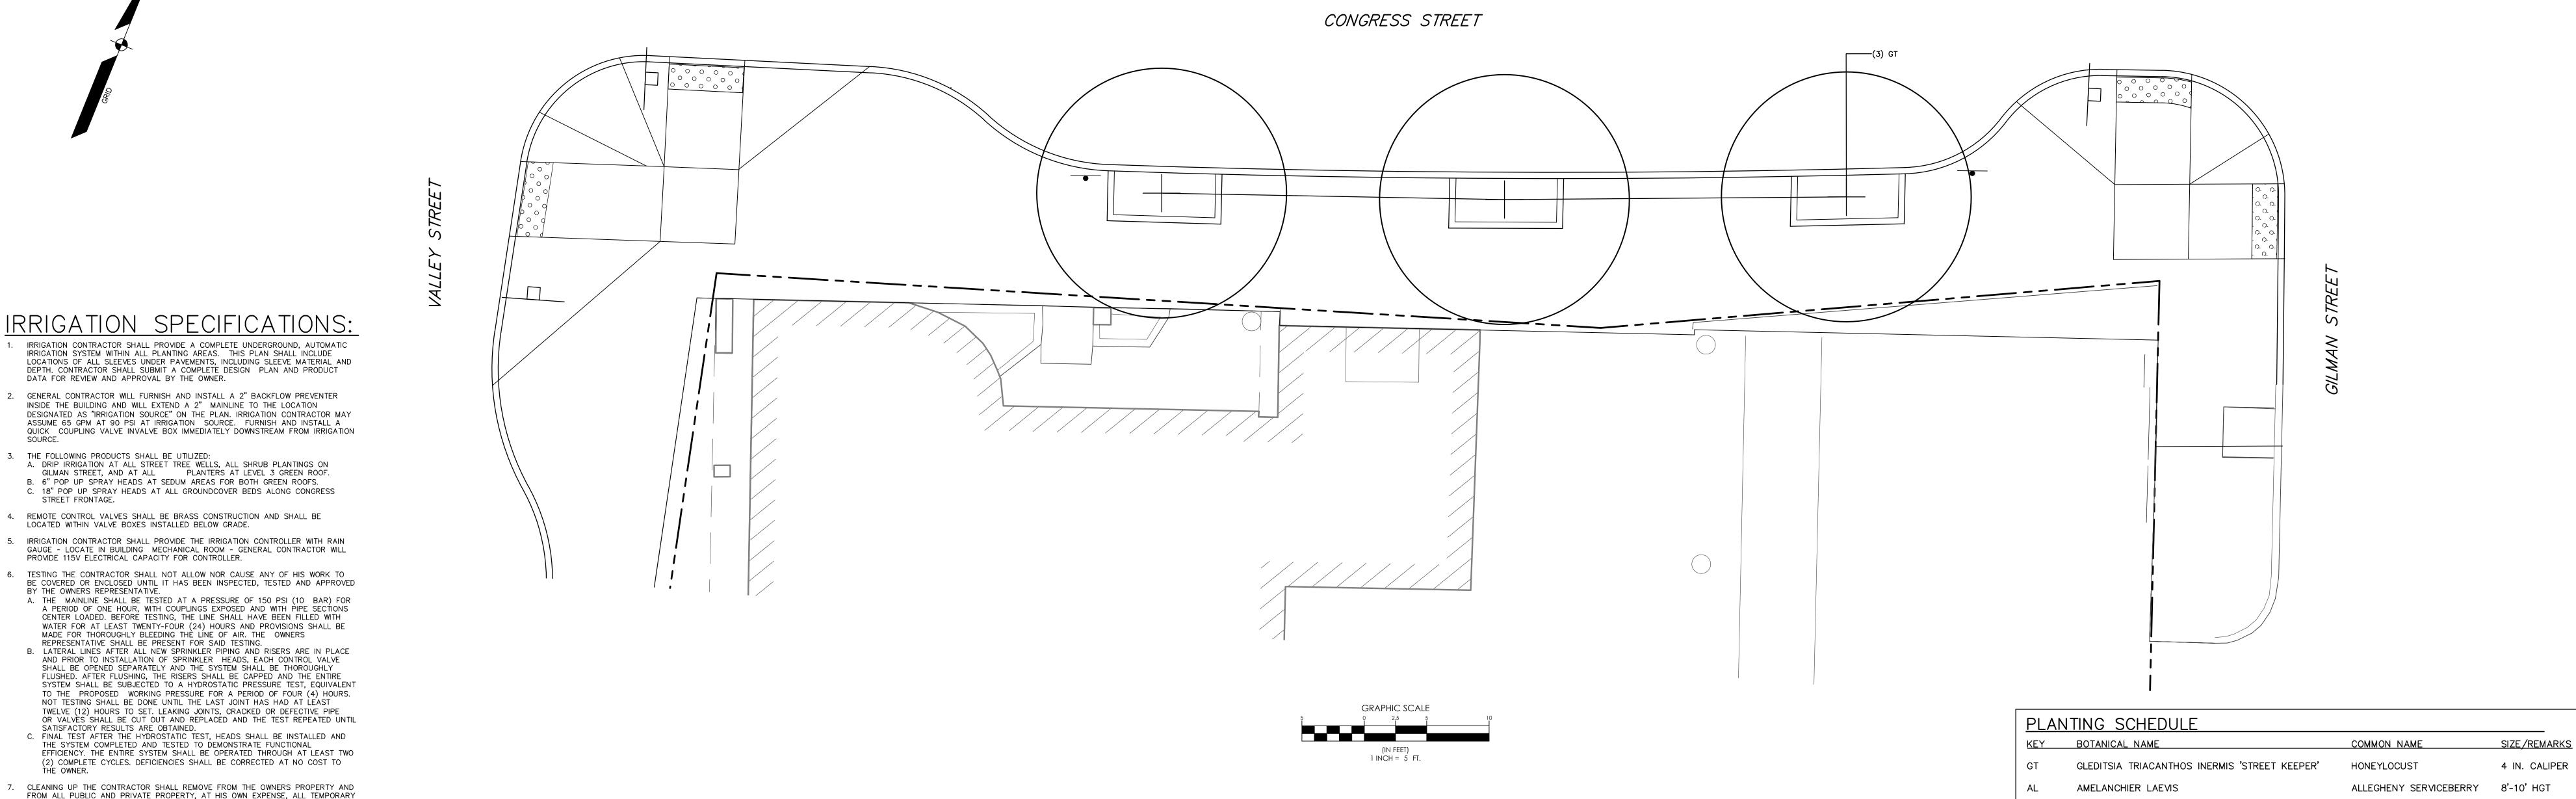

STREET FRONTAGE.

BY THE OWNERS REPRESENTATIVE.

STRUCTURES, RUBBISH, AND WASTE MATERIALS RESULTING FROM HIS OPERATION.

AGAINST ALL DEFECTS AND FAULTS OF WORKMANSHIP FOR ONE (1) YEAR FROM DATE OF RECEIPT OF NOTICE OF COMPLETION BY THE CONTRACTOR WITHOUT

8. GUARANTEE ALL WORK DONE UNDER THIS CONTRACT, SHALL BE GUARANTEED

EXPENSE TO THE OWNER. AFTER THE PROJECT HAS BEEN COMPLETED, THE

CONTRACTOR SHALL INSTRUCT THE OWNERS REPRESENTATIVE IN THE PROPER MAINTENANCE OF THE PROJECT AND SHALL FURNISH A COMPLETE SET OF MAINTENANCE INSTRUCTIONS. ANY AND ALL DAMAGE TO RAIN WATER DRAINS,

WATER SUPPLY LINES, GAS LINES, AND/OR OTHER SERVICE LINES ABOVE OR

EXPENSE. IT SHALL BE THE CONTRACTOR'S RESPONSIBILITY TO LOCATE THESE SERVICES BEFORE ANY TRENCHING, ETC., TO ELIMINATE DAMAGES OR DELAYS IN SAID SERVICES. UNDERGROUND PIPING AND UTILITIES SHOWN ON DRAWINGS ARE

SCHEMATIC. THEIR LOCATIONS SHALL BE VERIFIED BY THE CONTRACTOR.

UNDERGROUND, SHALL BE REPLACED AND MADE GOOD BY THE CONTRACTOR AT HIS



Boston, MA 02110 t 617.478.0300 f 617.478.0321

CLIENT

**Maine Medical** Center 22 Bramhall Street Portland, ME 04102

CONSULTANTS

CIVIL/ LANDSCAPE ARCHITECT Sebago Technics Inc. 75 John Roberts Road, Suite 1A, South Portland, ME 04106

STRUCTURAL ENG/ BUILDING ENVELOPE CONSULTANT Simpson Gumpertz & Heger Inc.

41 Seyon Street, Building 1, Suite 500, Waltham, MA 02453

MEPFP ENGINEER/CODE/LOW VOLTAGE AKF Group LLC 99 Bedford Street, 2nd Floor, Boston, MA 02111

> CONSTRUCTION MANAGER TURNER CONSTRUCTION

2 Seaport Lane, Suite 200, Boston, MA 02210 ELEVATOR CONSULTANT VDA (Van Deusen & Associates)

101 Summer Street, 4th Floor, Boston, MA 02110 COST ESTIMATOR D.G. Jones International


3 Baldwin Green Common, Suite 202, Woburn, MA 01801 MEDICAL EQUIPMENT PLANNING Mitchell Planning

630 Dundee Road, Suite 340, Northbrook IL 60062

PROJECT TITLE

**Congress Street** 22 Bramhall Street Portland ME 04102



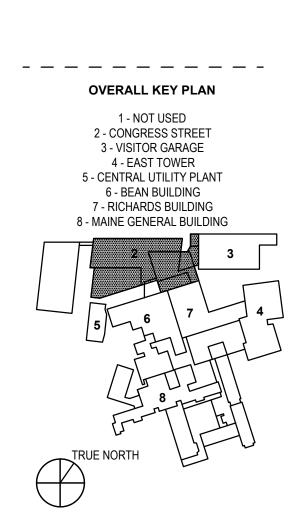

**ISSUED FOR** CONSTRUCTION

November 15, 2019

1	ADDENDUM NO. 2	01 MAY 20
NO	ISSUE	DATE
Job Number		152189.000
Drawn		MAL
Checked		DMD

LANDSCAPE PLAN, **CONGRESS AND GILMAN STREET** 

NO. 3 CONTAINER

NO. 3 CONTAINER

NO. 2 CONTAINER

NO. 2 CONTAINER

NO. 2 CONTAINER

NO. 1 CONTAINER

EUOROPEAN WILD GINGER NO. 2 CONTAINER

WINTERCREEPER

BAYBERRY

ENGLISH IVY

REED GRASS

WAKE ROBIN

LOWBUSH BLUEBERRY

EUONYMUS FORTUNEI 'COLORATUS'

CALAMAGROSTIS ACUTIFLORA 'KARL FOERSTER'

MYRICA GALE

HEDERA HELIX

ASARUM CANADENSE

TRILLIUM ERECTUM

VACCINIUM ANGUSTIFOLIUM

L50-03

SHEET NUMBER

Copyright 2019 @ Perkins + Will