

LANGFORD & LOW, INC.
248 Warren Ave., P.O. Box 662, Portland, Maine 04104

GENERAL CONTRACTORS
Telephone 207-797-5141 – Fax 207-797-0919

Request for Information Form (R.F.I.)

Job Name: Maine Heart Surgical Associates

Job Number: 0531

Contractor: Langford & Low, Inc.
Address: P.O. Box 662, Portland, ME 04104

Telephone: 207-797-5141
Fax: 207-797-0919

R.F.I. Number: 18
Date: 9/9/2005

To: Scott Pakulski
From: Darren Crawford

Jobsite Telephone: 879-8925
Jobsite Fax: 879-8927

Please Respond by Fax to the Jobsite and to the Portland Office

Problem/Conflict:

Please detail "ramp" at door 212B. The topping slab is at elev. -2'10" and the elev. of the existing deck at door 212B is -3'8".

Contractor's Recommended Solution:

Architect/Engineer's Response:

Date: 9.9.05

See Attachment:


PROVIDE LANDING + STEPS
IN VIEW OF RAMP - SEE
ATTACHED SKETCH. (PLEASE PROVIDE
PRICE PRIOR TO STARTING THE WORK).



CC: Gus Doughty


Respond By: ASAP

SKETCH

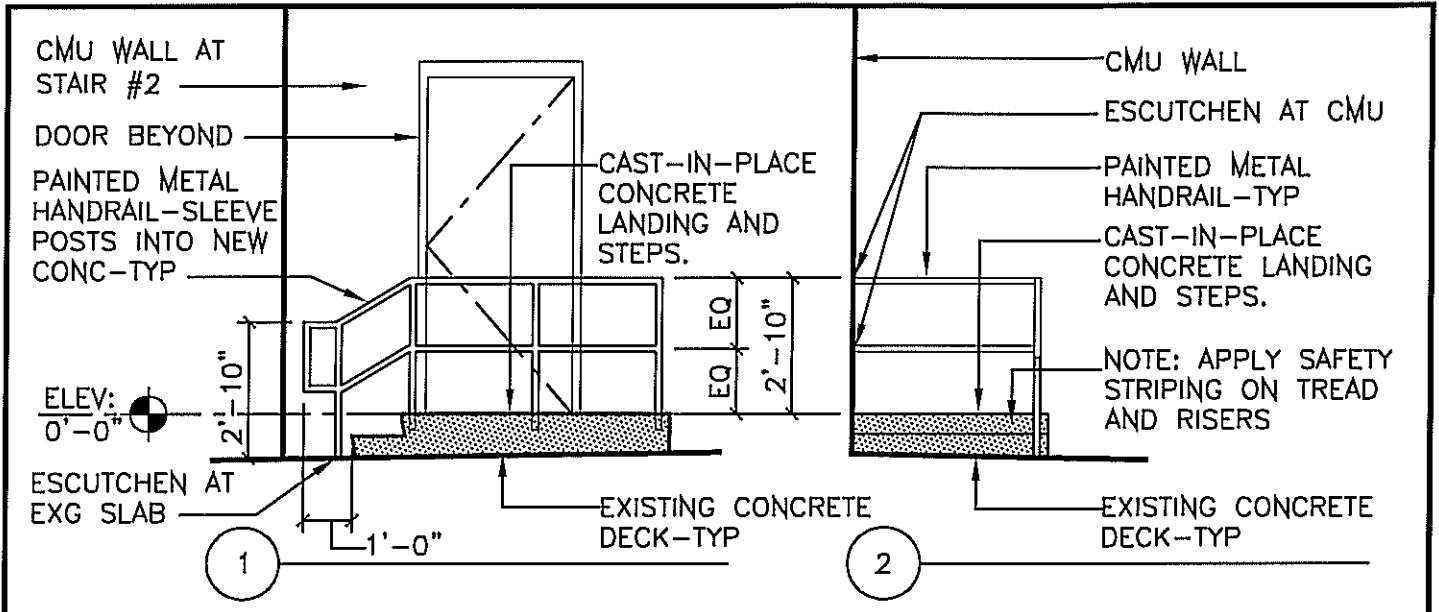

STAIR LANDING ELEVATIONS

Scale 1/4" = 1'-0"

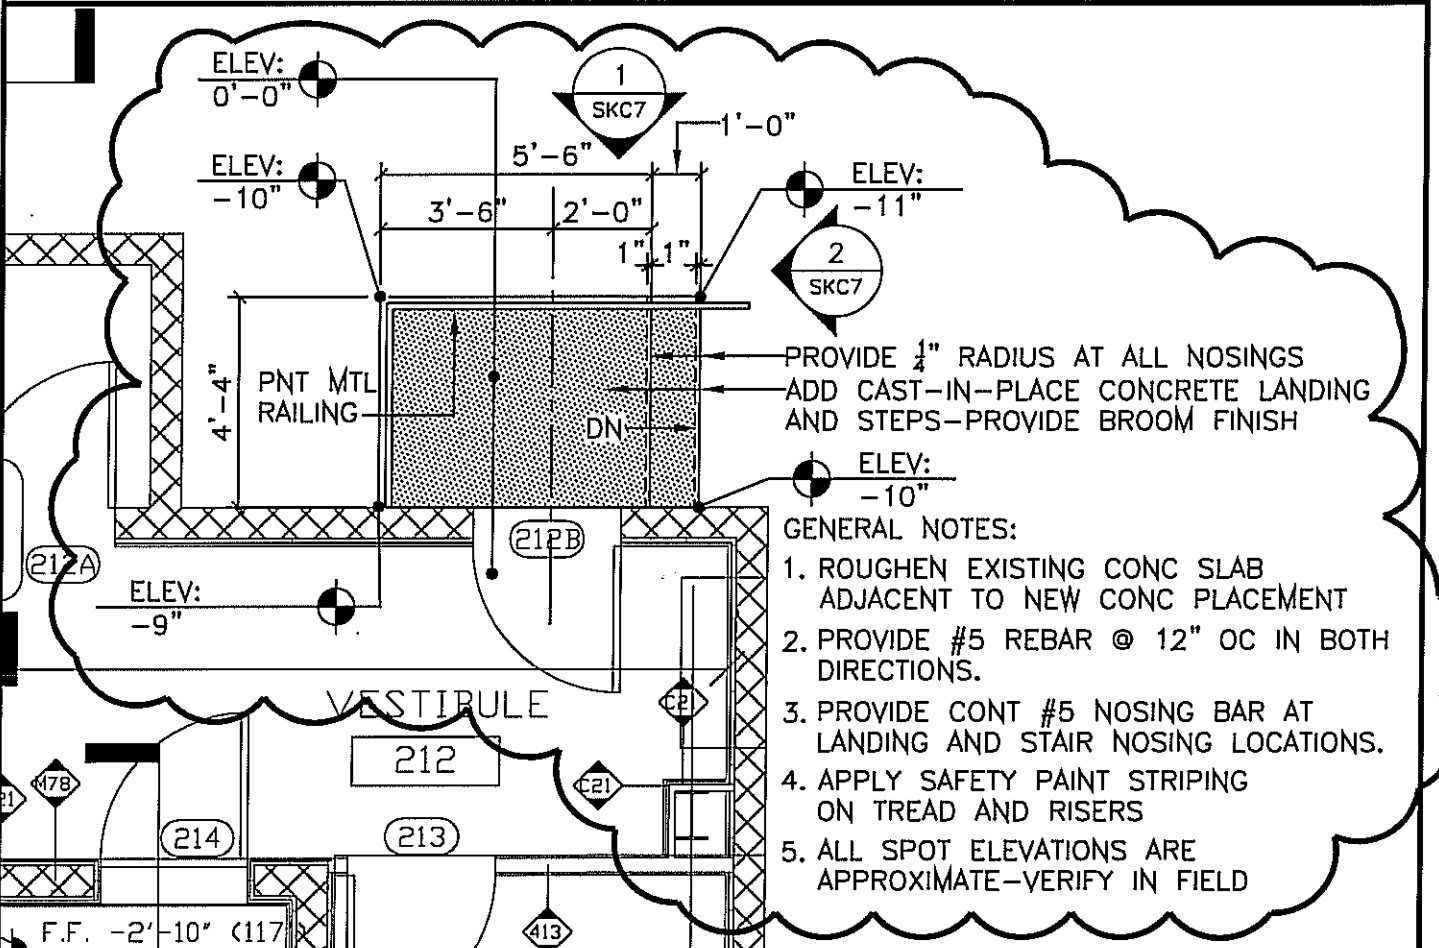

- GENERAL NOTES:
1. ROUGHEN EXISTING CONC SLAB ADJACENT TO NEW CONC PLACEMENT
 2. PROVIDE #5 REBAR @ 12" OC IN BOTH DIRECTIONS.
 3. PROVIDE CONT #5 NOSING BAR AT LANDING AND STAIR NOSING LOCATIONS.
 4. APPLY SAFETY PAINT STRIPING ON TREAD AND RISERS
 5. ALL SPOT ELEVATIONS ARE APPROXIMATE-VERIFY IN FIELD

STAIR LANDING AT DOOR 212B

Scale 1/4" = 1'-0"

<p>Architects + Engineers</p> <p>HARRIMAN ASSOCIATES</p> <p>One Auburn Business Park Auburn, Maine 04210</p> <p>207.784.5100 tel 207.782.3017 fax http://harriman.com</p>	<p>Project Title</p> <p>MAINE HEART SURGICAL ASSOC. NEW OFFICE BLDG. PORTLAND, MAINE</p>	<p>Drawing Number</p> <p>SKC7</p>
	<p>HA Project No.</p> <p>04180</p>	<p>Date</p> <p>9-09-05</p>