

As Built Drawing


TANDEM
COFFEE ROASTERS
742 Congress Street
Portland, ME 04101

02/16/2014

- Changes:
1. From metal studs to wood
 2. Take out a couple interior partitions

FULL HEIGHT WALL
TILED TO 6'-0"

OVEN TO BE INSTALLED
AS PER MANUFACTURERS
RECOMMENDATIONS
- VENTING TO BE
THROUGH EXISTING
SIDEWALL VENT
LOCATION

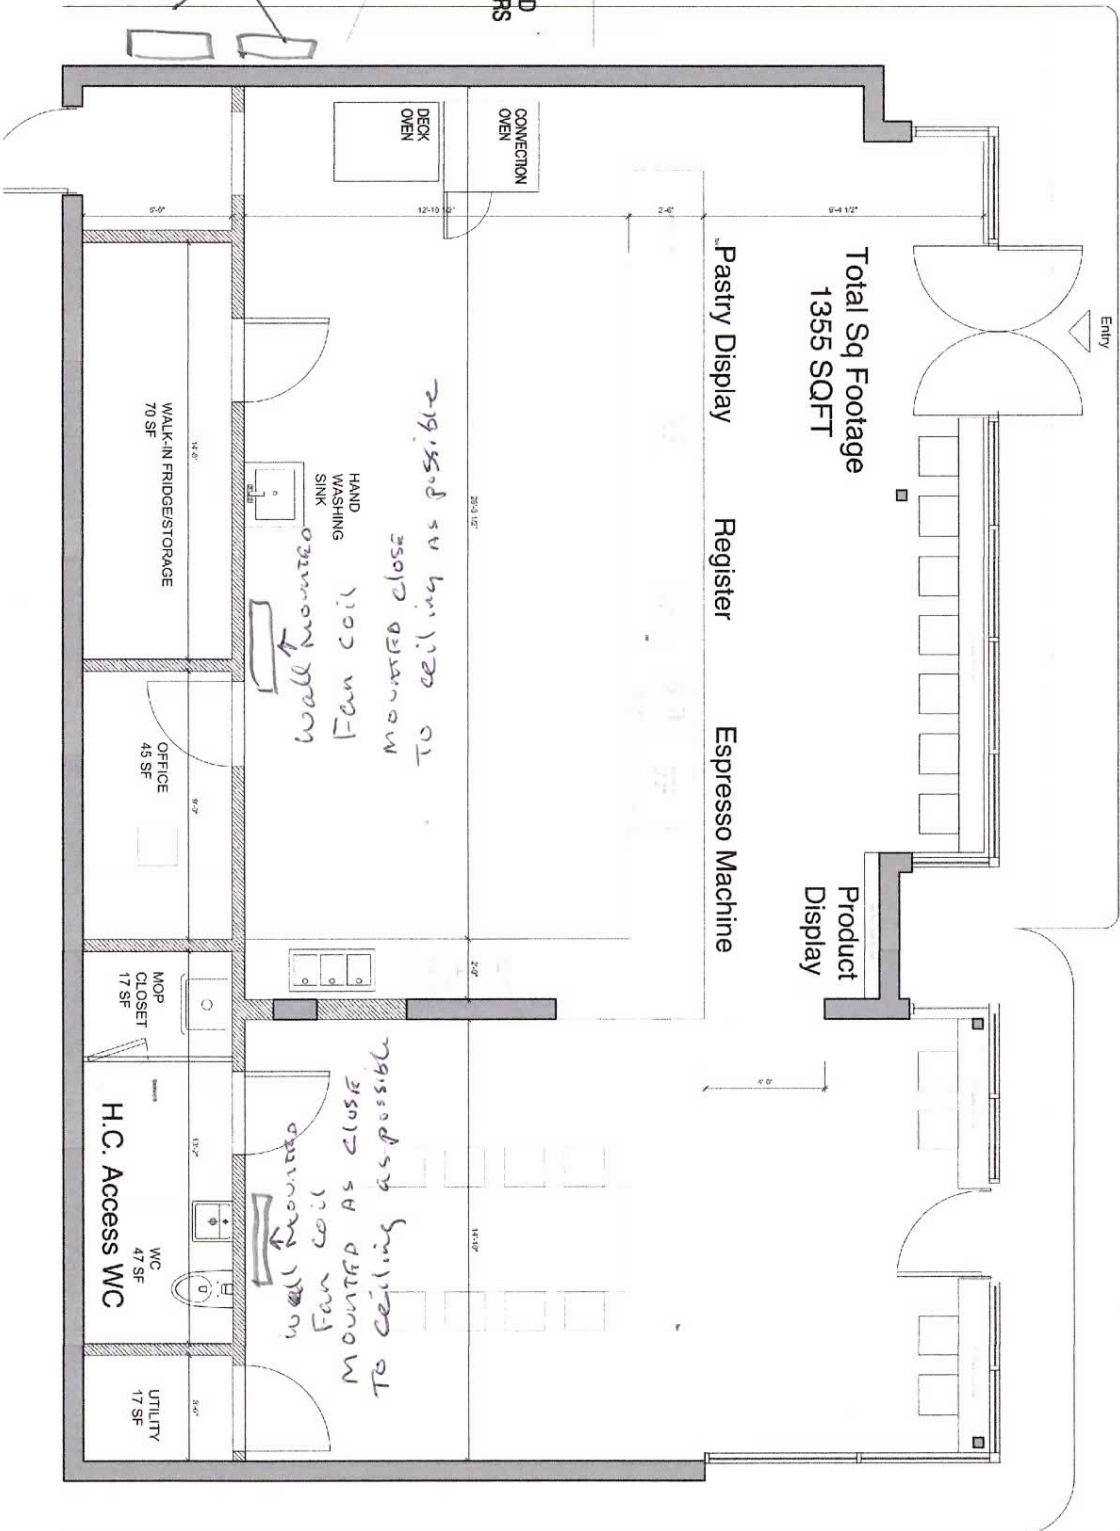

BRICK SW BRICK WALL
OVEN TO BE INSTALLED
AS PER MANUFACTURERS
RECOMMENDATIONS
- VENTING TO BE
THROUGH EXISTING
SIDEWALL VENT
LOCATION