

Permit # 041196

All Purpose Building Permit Application

If you or the property owner owes real estate or personal property taxes or user charges on any property within the City, payment arrangements must be made before permits of any kind are accepted.

Location/Address of Construction: <u>488 Congress Street</u>		
Total Square Footage of Proposed Structure <u>1,000 +/-</u>	Square Footage of Lot	
Tax Assessor's Chart, Block & Lot Chart# Block# Lot# <u>55 2 35</u>	Owner: <u>Jeff Reie</u>	Telephone: <u>772-6788</u>
Lessee/Buyer's Name (If Applicable) <u>Jim Vassile</u>	Applicant name, address & telephone: <u>450-4168</u>	Cost Of Work: <u>\$2,350.00</u> <u>75.00 COB</u> Fee: \$
Current use: <u>Vacant</u>		
if the location is currently vacant, what was prior use: <u>3 office</u> APR 16 2004		
Approximately how long has it been vacant: <u>Less than 6 months</u>		
Proposed use: <u>Tattoo Shop</u>		
Project description: <u>Build 4' knee wall & insert 2 sinks, install 2' high plexiglass</u>		
Contractor's name, address & telephone: <u>TET Development LLC</u> <u>525 Main St - So. Portland</u>		
Who should we contact when the permit is ready: <u>Jaime Galbot</u> <u>253-5025</u>		
Mailing address:		
We will contact you by phone when the permit is ready. You must come in and pick up the permit and review the requirements before starting any work, with a Plan Reviewer. A stop work order will be issued and a \$100.00 fee if any work starts before the permit is picked up, PHONE: <u>253-5025</u>		


IF THE REQUIRED INFORMATION IS NOT INCLUDED IN THE SUBMISSIONS THE PERMIT WILL BE AUTOMATICALLY DENIED AT THE DISCRETION OF THE BUILDING/PLANNING DEPARTMENT, WE MAY REQUIRE ADDITIONAL INFORMATION IN ORDER TO APPROVE THIS PERMIT.

I hereby certify that I am the Owner of record of the named property, or that the owner of record authorizes the proposed work and that I have been authorized by the owner to make this application as his/her authorized agent, I agree to conform to all applicable laws of this jurisdiction. In addition, if a permit for work described in this application is issued, I certify that the Code Official's authorized representative shall have the authority to enter all areas covered by this permit at any reasonable hour to enforce the provisions of the codes applicable to this permit.


Signature of applicant: <u>Jaime Galbot</u>	Date: <u>2/16/04</u>
---	----------------------

This is NOT a permit, you may not commence ANY work until the permit is issued. If you are in a Historic District you may be subject to additional permitting and fees with the Planning Department on the 4th floor of City Hall

Handwritten initials and date: JG 2/16/04

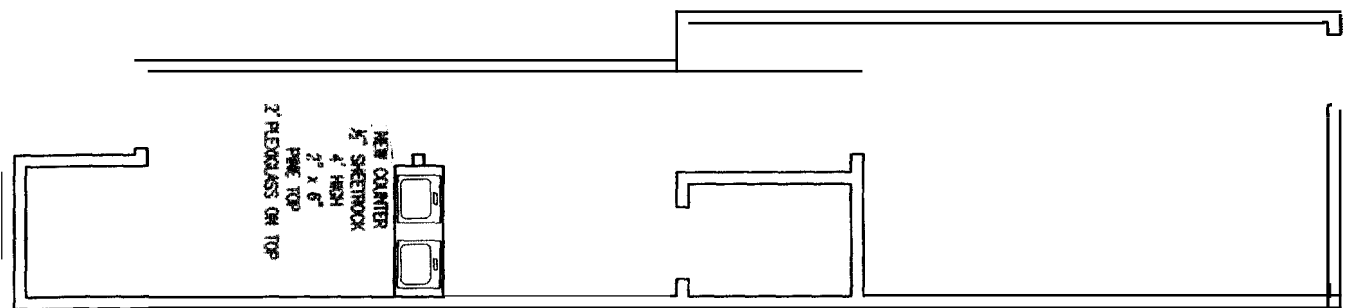


size?
plot plan?

A1	DATE: 07/16/04	<p>PROJECT 688 CONGRESS STREET FORT LAUDERDALE</p> <p>SHEET TITLE: NEW WALL</p>	 <p>T & T DEVELOPMENT, LLC CONSTRUCTION MANAGEMENT</p>
	SCALE: N.T.S.		
	DESIGN BY: TOB		
	DRAWN BY: TOB		
	FILE: 688CONGRESS.dwg		
SHEET:			

THIS DRAWING, DESIGN AND
ELECTRONIC FILE ARE THE PROPERTY
OF T & T DEVELOPMENT, LLC.
THE REPRODUCTION, COPIING OR ANY
OTHER USE OF THIS DOCUMENT WITHOUT
WRITER CONSENT IS PROHIBITED.

FLOOR PLAN
SCALE: 1/8" = 1'-0"

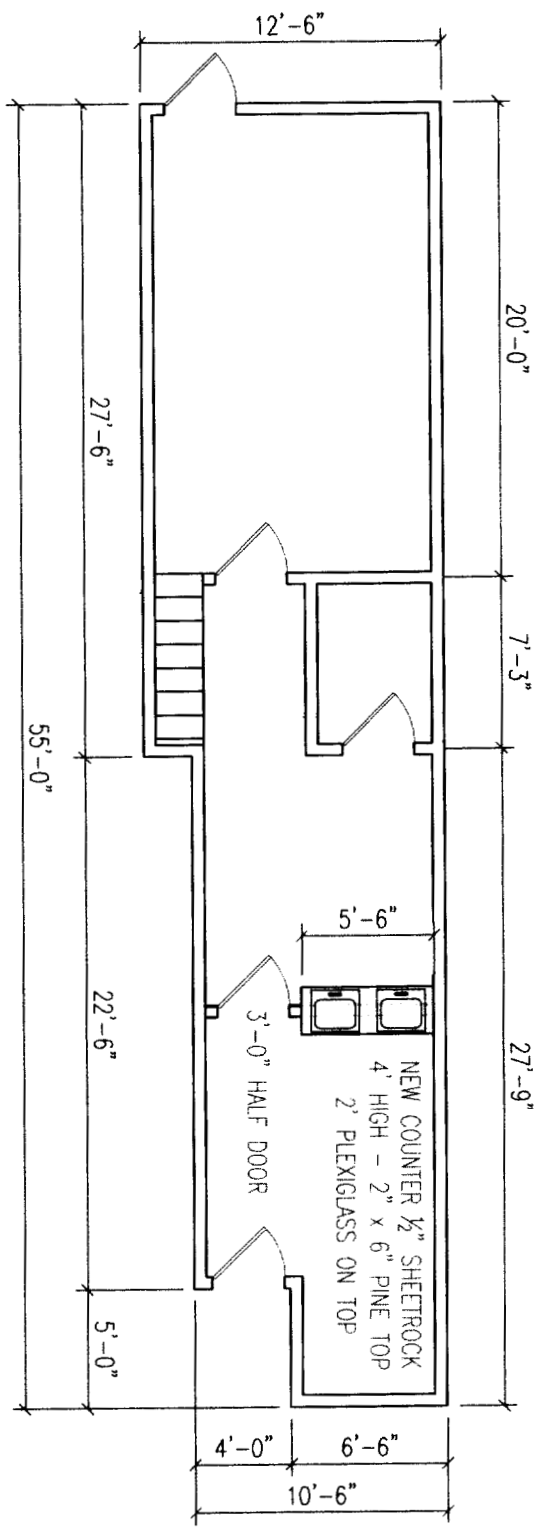

12.5 x 27.5 = 343.75
 10.5 x 22.5 = 236.25
 6.5 x 5.0 = 32.50
 612.50 #


612.50 / 334 = 1.83
 ORZ parking
 spaces

13302
 FIVE

DATE: 07/16/04
 SCALE: 1/8" = 1'-0"
 DESIGN BY: TOB
 DRAWN BY: TOB
 FILE: 688CONGRESS.dwg
 SHEET: A1

PROJECT: 688 CONGRESS STREET
 SHEET TITLE: NEW WALL

THIS DRAWING, DESIGN AND
 ELECTRONIC FILE ARE THE PROPERTY
 OF ASSOCIATED DESIGN PARTNERS, INC.
 NO REPRODUCTION, COPIES OR
 DISTRIBUTION OF ANY KIND WITHOUT
 WRITTEN CONSENT IS PERMITTED.

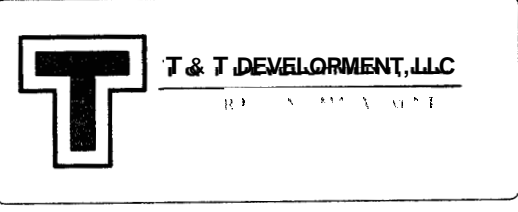

THE DUNHAM GROUP

Fax: 2077735480

Aug 30 2004 12:15

P. 02

