


**Second Floor Plan**  
 SCALE: 1/4" = 1'-0"

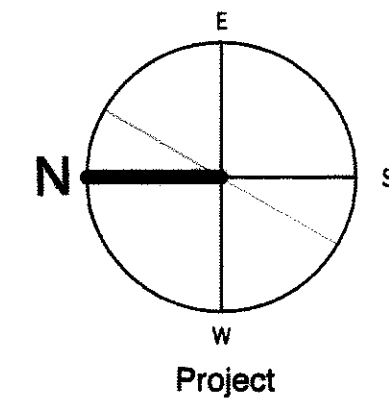

These drawings are the architect's instruments of service. A substantial amount of work to be done on the project is based on conversations between the Architect and Wright-Ryan Construction. If the drawings are used without the Architect's involvement in interpretation of the documents and review of field conditions, the Architect shall not be liable for problems with any aspect of the design during and after construction.

construction set 01/03/11

Van Dam Architecture and Design  
 66 West Street  
 Portland, ME 04102  
 207.775.9443  
 FAX 207.775-2892  
 studio@vandamd.com

Landscape Architect:  
 James Doyle Design Associates  
 125 Greenwich Avenue  
 Greenwich, CT 06839  
 Structural Engineer:  
 Becker Structural Engineers Inc.  
 75 York Street  
 Portland, ME 04101

**Jenkins Residence**  
 264 Spring Street  
 Portland, Maine

**Second Floor Plan**  
 Drawn by: JRM/DJA/KRH Scale: 1/4" = 1'-0" Date: 11/22/10  
 Revisions: 1/01/03/11 2/01/08/11 3/01/09/11 Job #: 200913  
**A1.2**