


Third Floor Plan
SCALE: 1/4" = 1'-0"

LEGEND	
Existing Wall to Remain	=====
New partition, wallboard and/or plaster and sith	=====
New 1HR. Fire Rated with minimum STC 45 interior partition UL 312	=====
New CMU block wall	=====
New Concrete and brick veneered wall	=====
Existing Brick / Rubble wall	=====

1) all dimensions are from masonry / stud to masonry / stud unless otherwise noted.
2) the thickness of all new un-dimensioned walls shall be verified in field due to unknown existing conditions

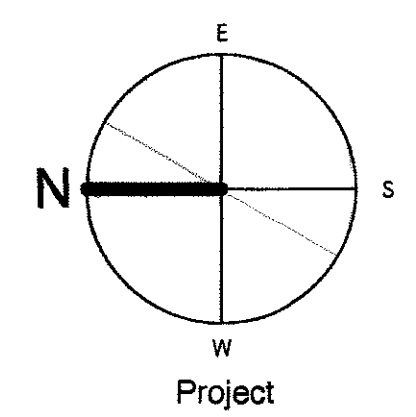

These drawings are the architect's instruments of service. A substantial amount of work to be done on the project is based on conversations between the Architect and Wright-Ryan Construction. If the drawings are used without the Architect's involvement in interpretation of the documents and review of field conditions, the Architect shall not be liable for problems with any aspect of the design during and after construction.

construction set 01/03/11

Van Dam Architecture and Design
66 West Street
Portland, ME 04102
207.775.0443
FAX 207.775.2892
studio@vandamdesign.com

Landscape Architect:
James Doyle Design Associates
125 Greenwich Avenue
Greenwich, CT 06859

Structural Engineer:
Becker Structural Engineers Inc.
75 York Street
Portland, ME 04101

Jenkins Residence
294 Spring Street
Portland, Maine

Third Floor Plan
A1.3
Drawn by: JPR/PJ/KRH Scale: 1/4" = 1'-0" Date: 11/22/10
Revisions: 11/10/10 11/01/10 11/03/11 04/06/11 Job #: 20913