



Partial Southern Elevation
SCALE: 1/4" = 1'-0"

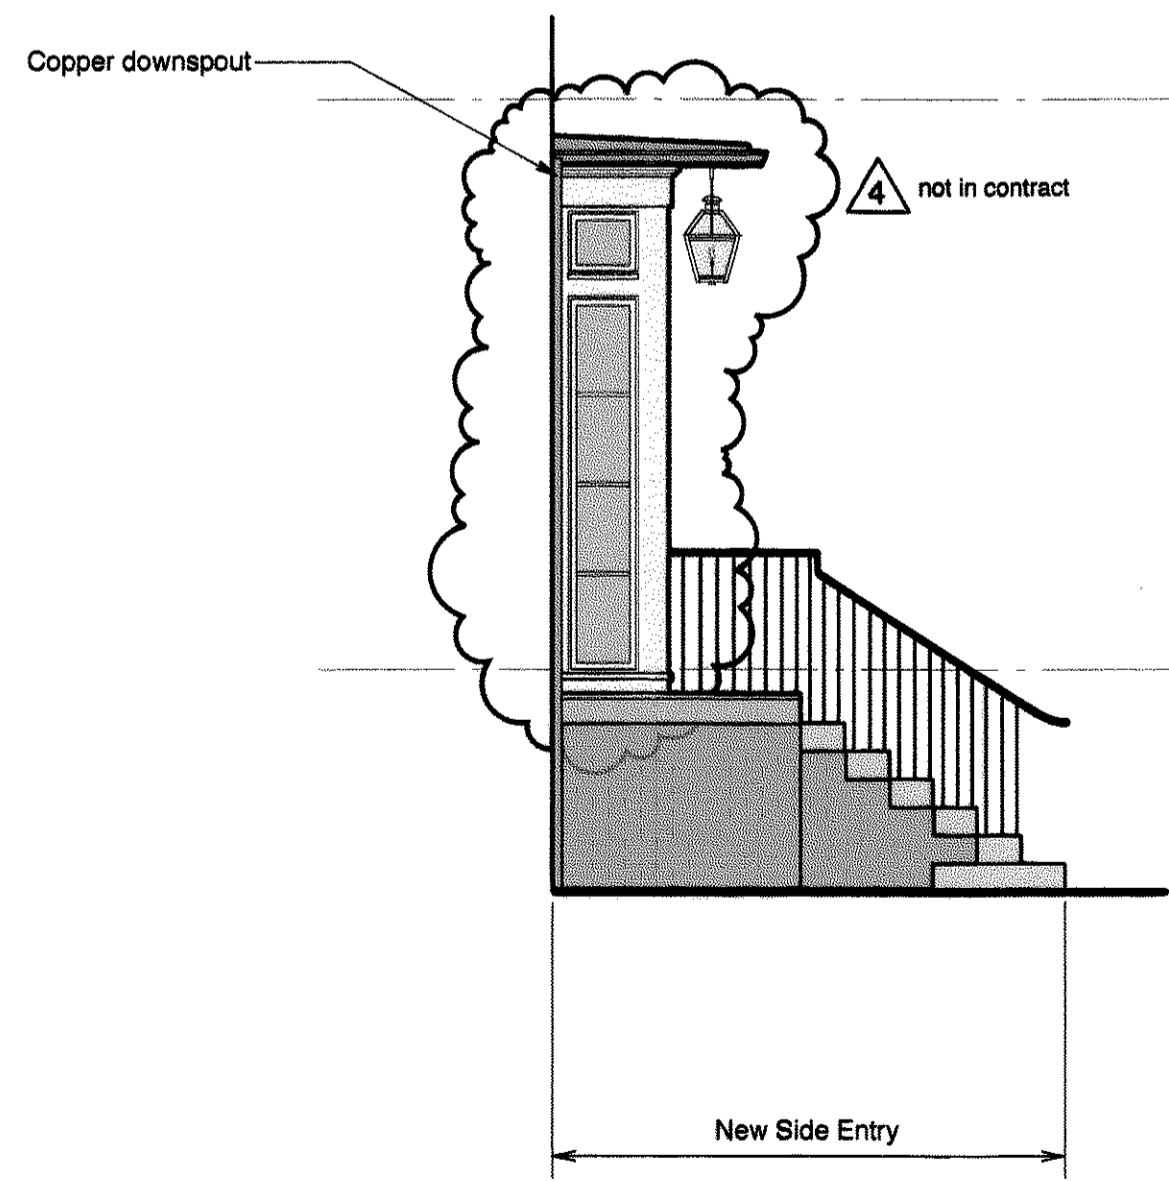

Partial North Elevation
SCALE: 1/4" = 1'-0"

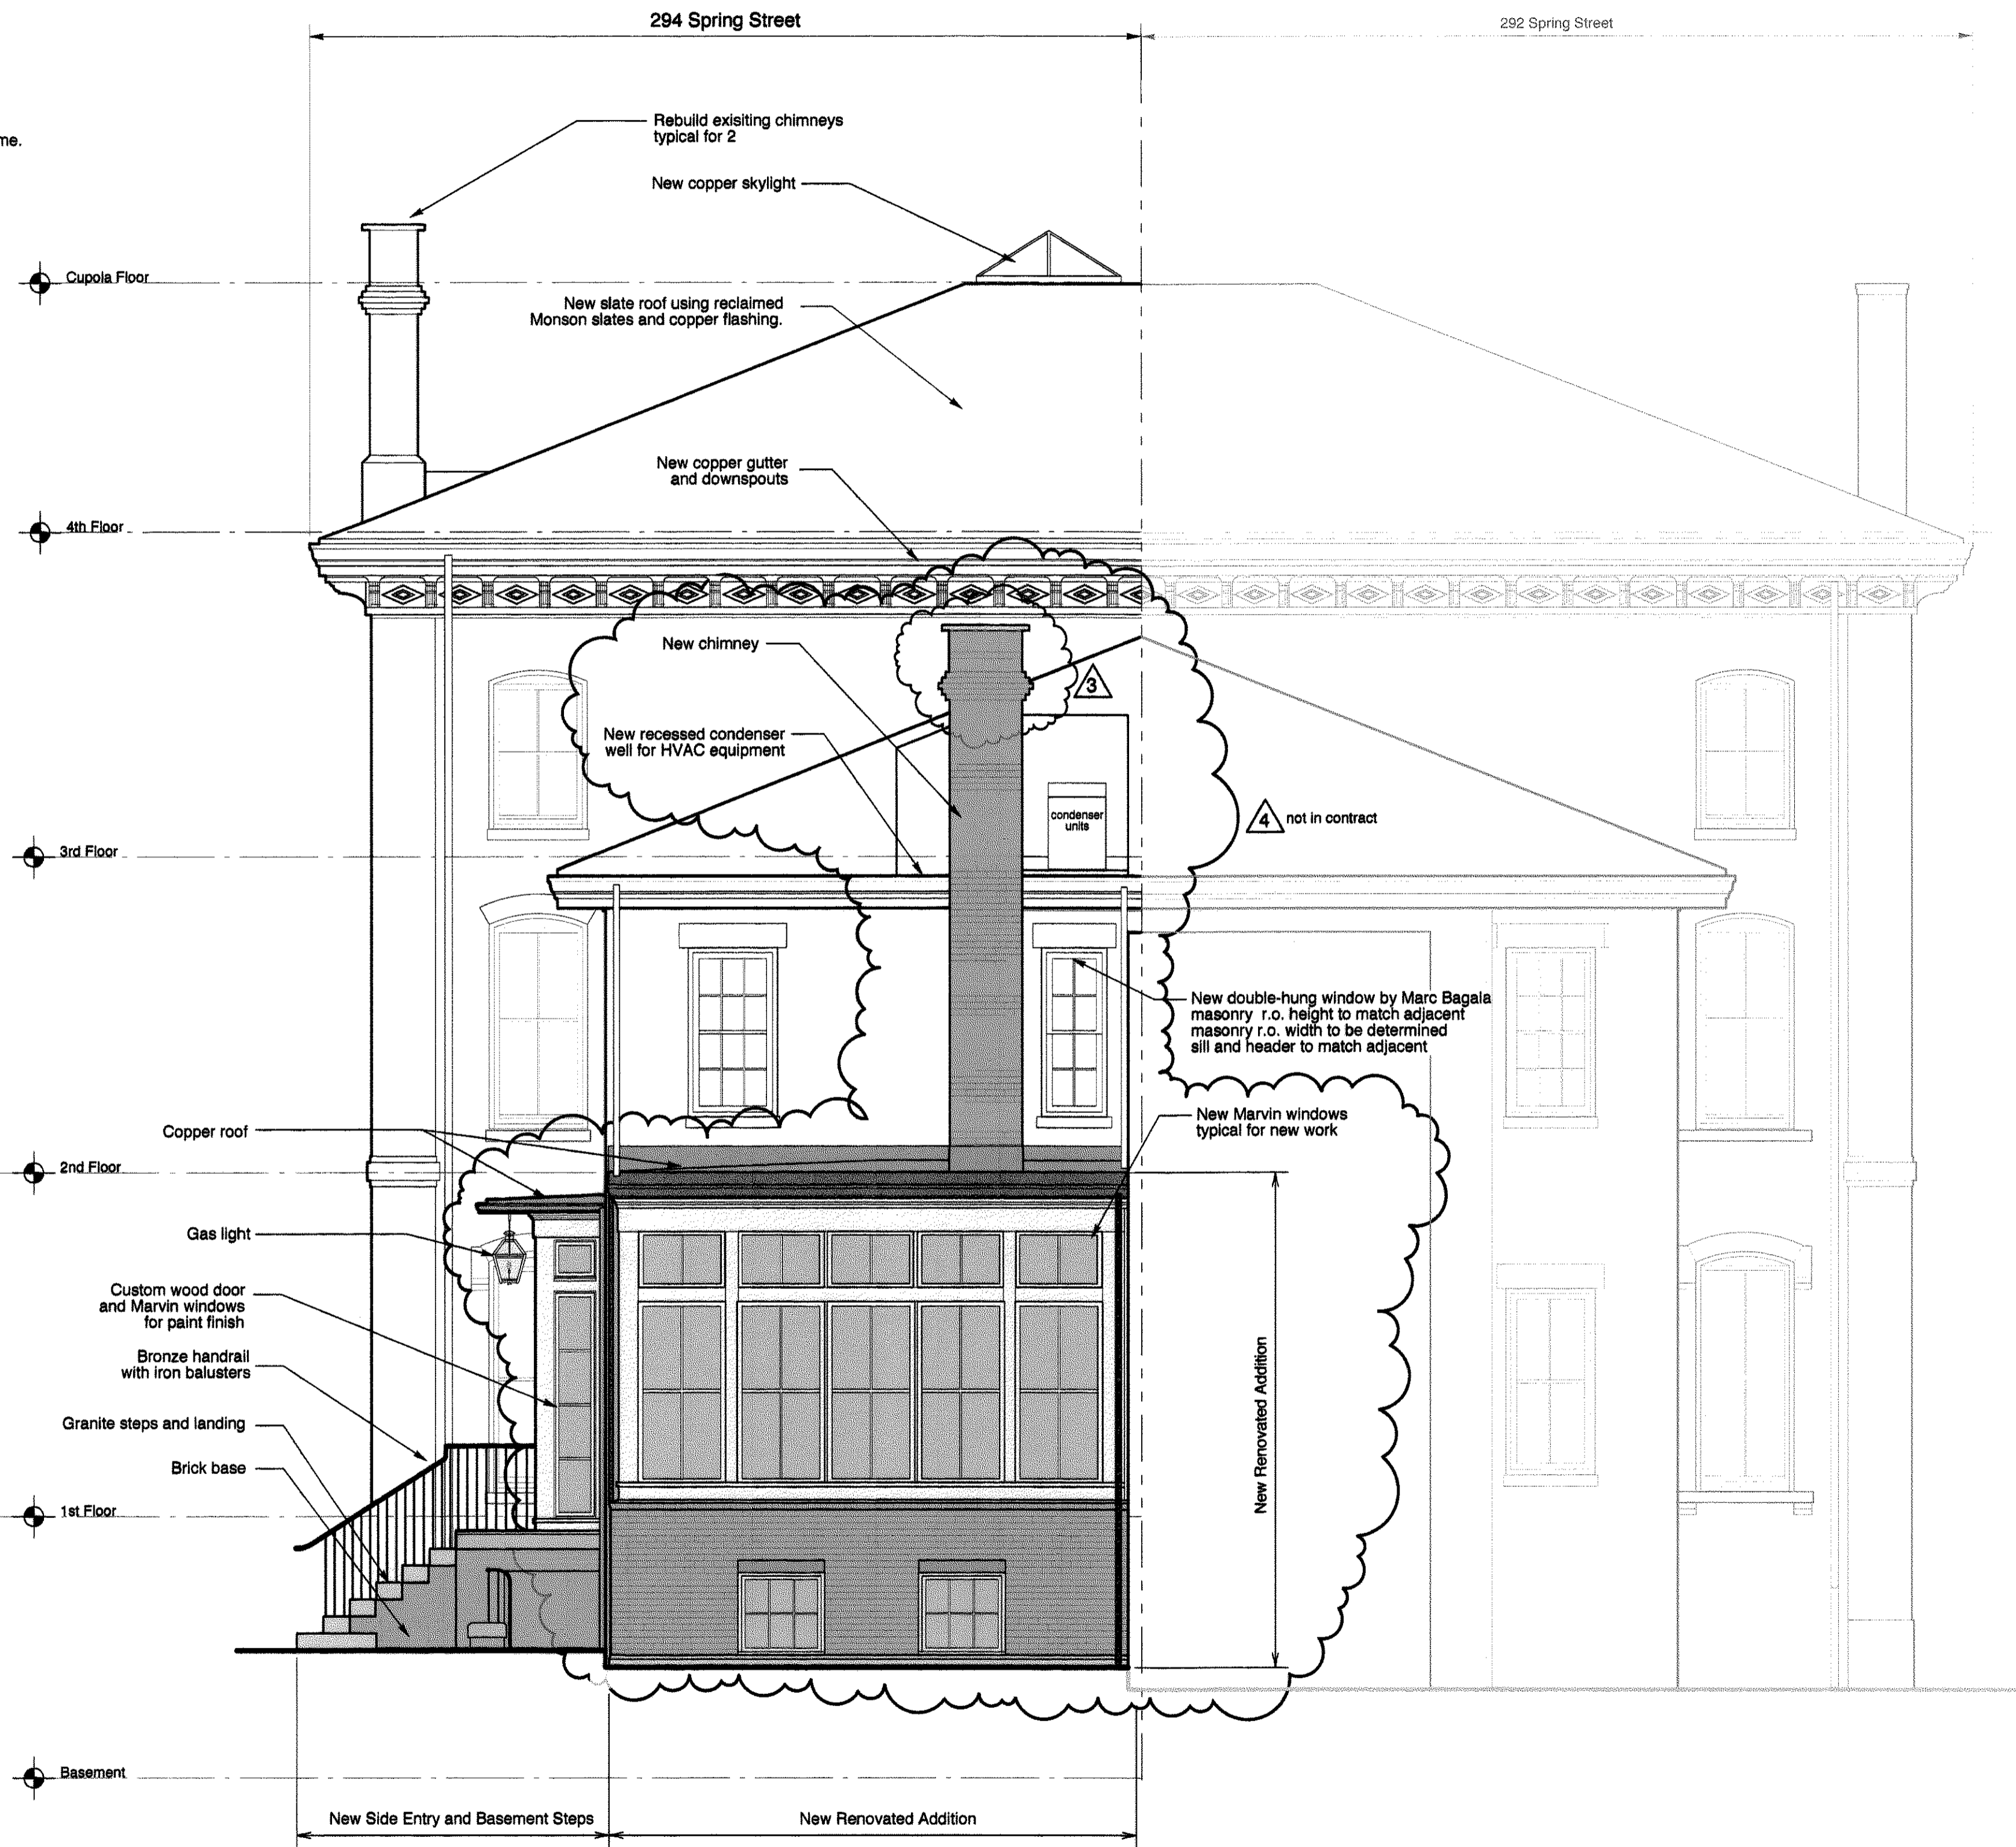

Southern Elevation
SCALE: 1/4" = 1'-0"

Van Dam Architecture and Design

66 West Street
Portland, Maine 04102
207-775-0443
FAX 775-2892
studio@vandamdesign.com

Landscape Architect:
James Doyle Design Associates
150 Water Street
Greenwich, CT 06830

Structural Engineer:
Becker Structural Engineers Inc.
100 Park Street
Portland, ME 04101

Jenkins Residence

294 Spring Street
Portland, Maine

South Elevation

Drawn by: JPP
Scale: 1/4" = 1'-0"
Date: 02/10
Revisions: 01/03/11 04/06/11
Job #: 20913

A3.2

These drawings are the architect's instruments of service. A substantial amount of work to be done on the project is based on conversations between the Architect and Wright-Ryan Construction. If the drawings are used without the Architect's involvement in interpretation of the documents and review of field conditions, the Architect shall not be liable for problems with any aspect of the design during and after construction. construction set 01/03/11