




5 Typical Base Trim @ 3rd Floor Bedrooms
not to scale

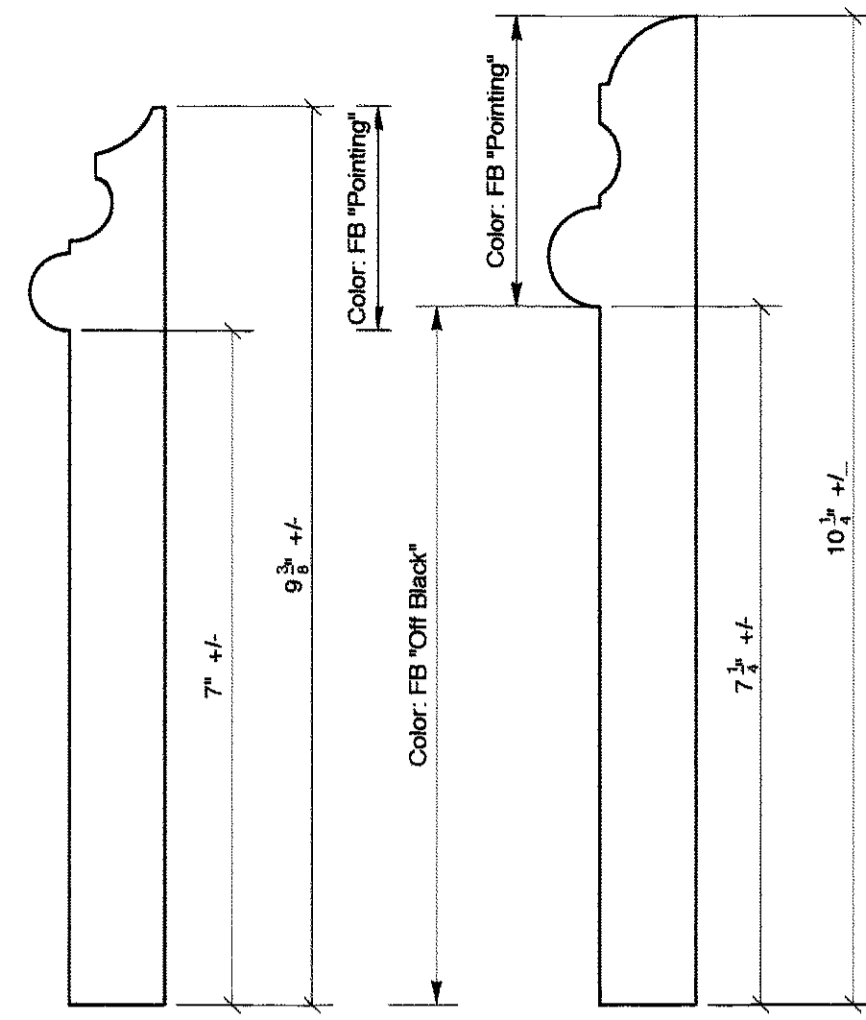


4 Typical Base Trim @ 2nd Floor Bedrooms
not to scale

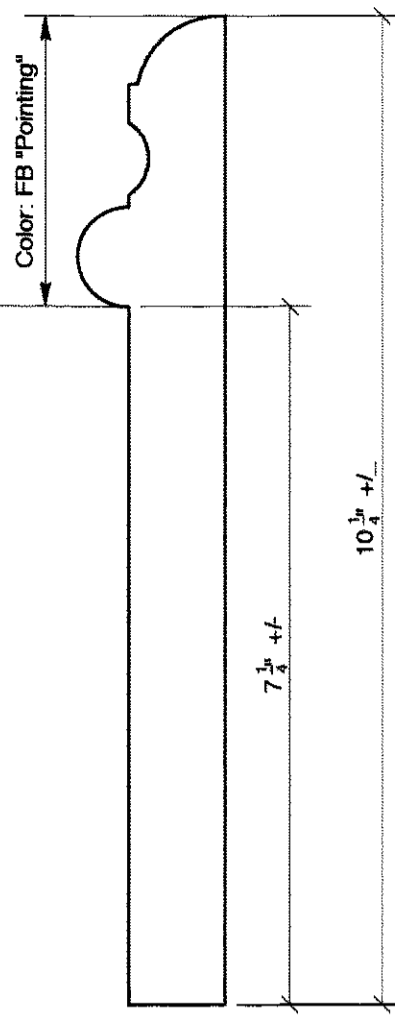


3 Typical Base Trim @ all of First Floor & 2nd / 3rd Floor Hall
not to scale

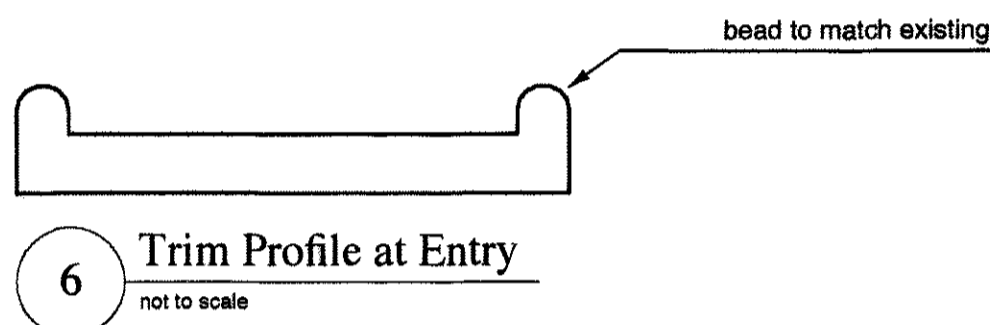

6 Trim Profile at Entry
not to scale


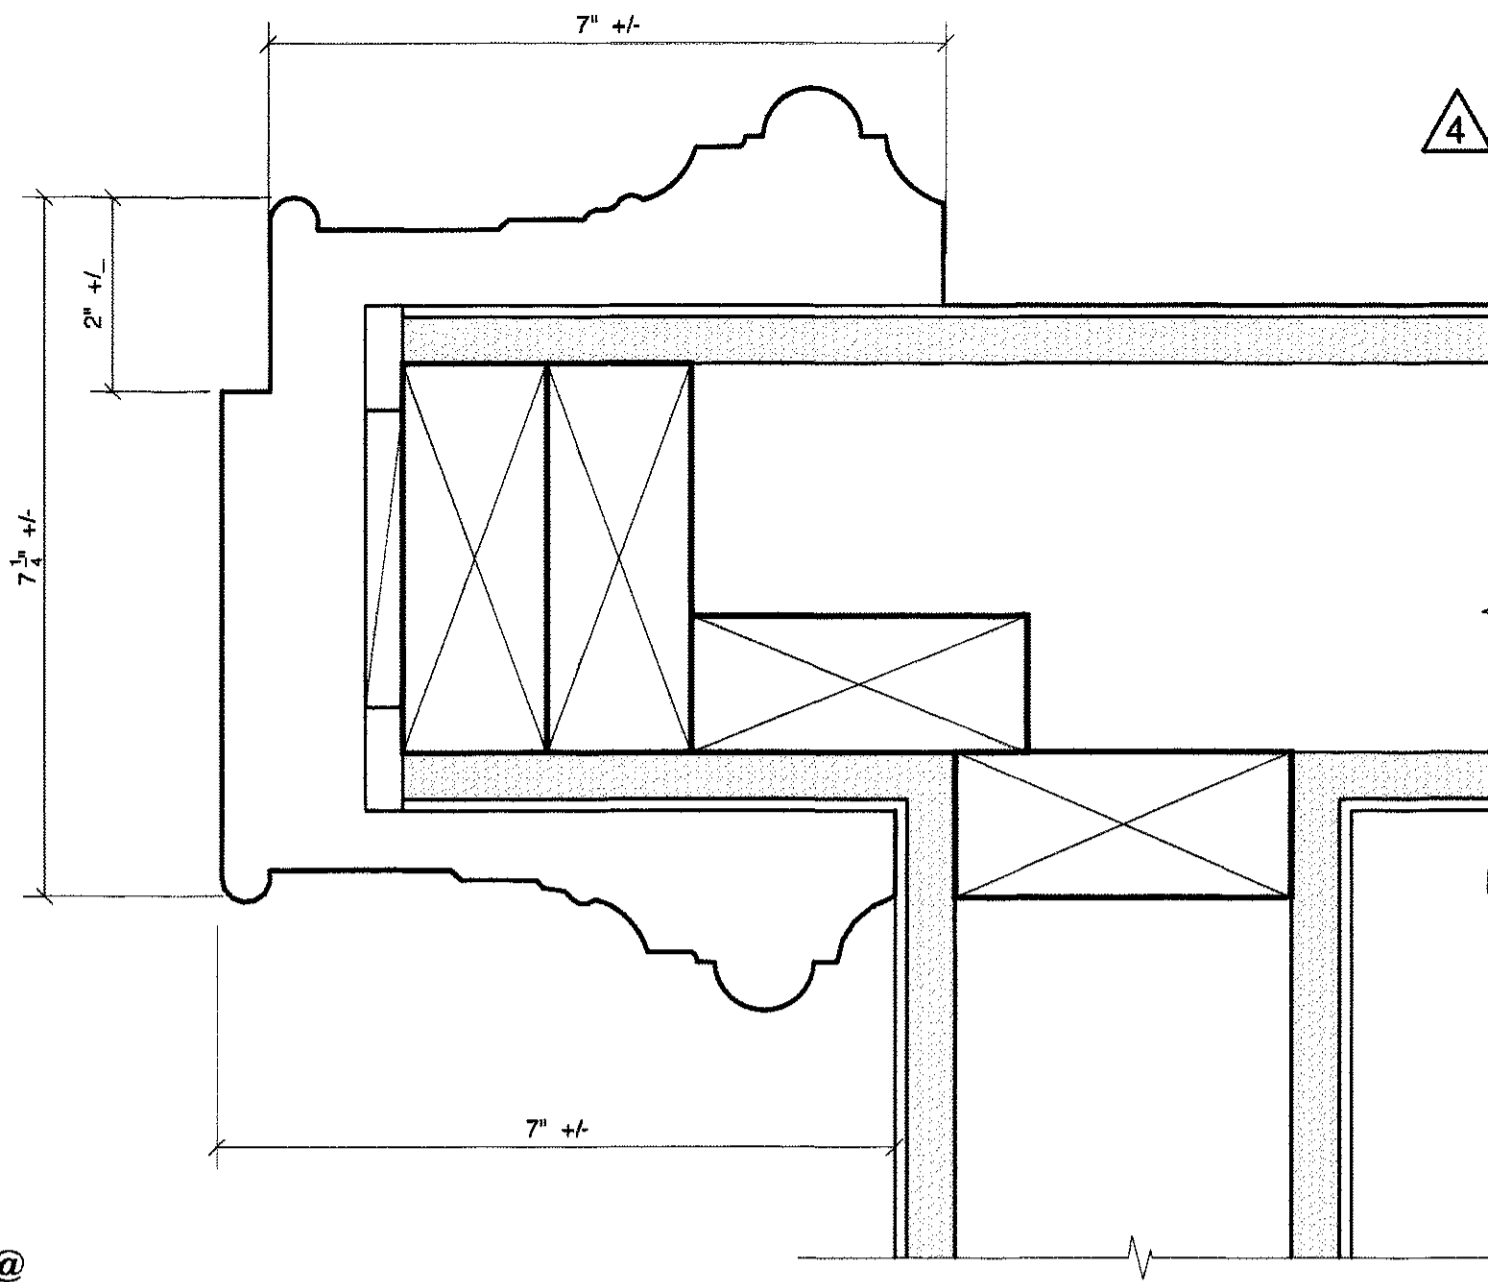


1 Typical Existing Door Jamb Detail for 1st & 2nd floor
not to scale

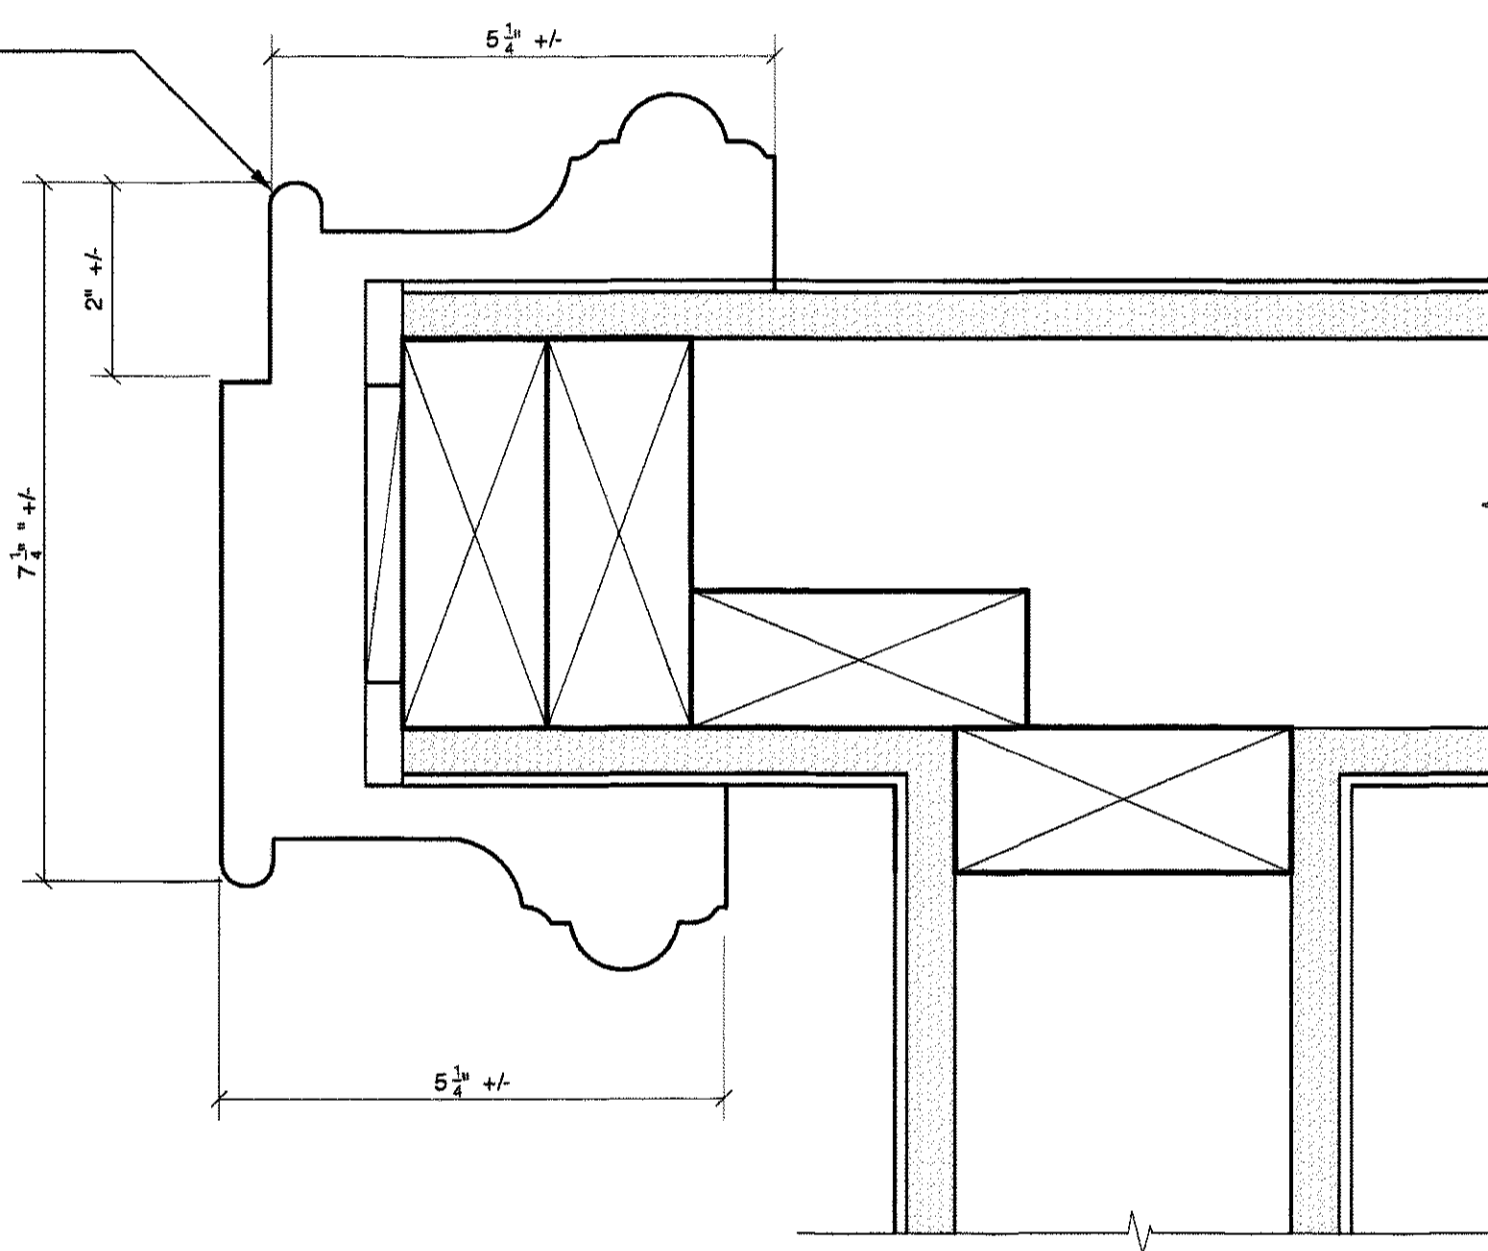

2 Typical Existing Door Jamb Detail for 3rd floor
not to scale

DOOR TYPES
Note: Verify all rough openings prior to ordering doors.

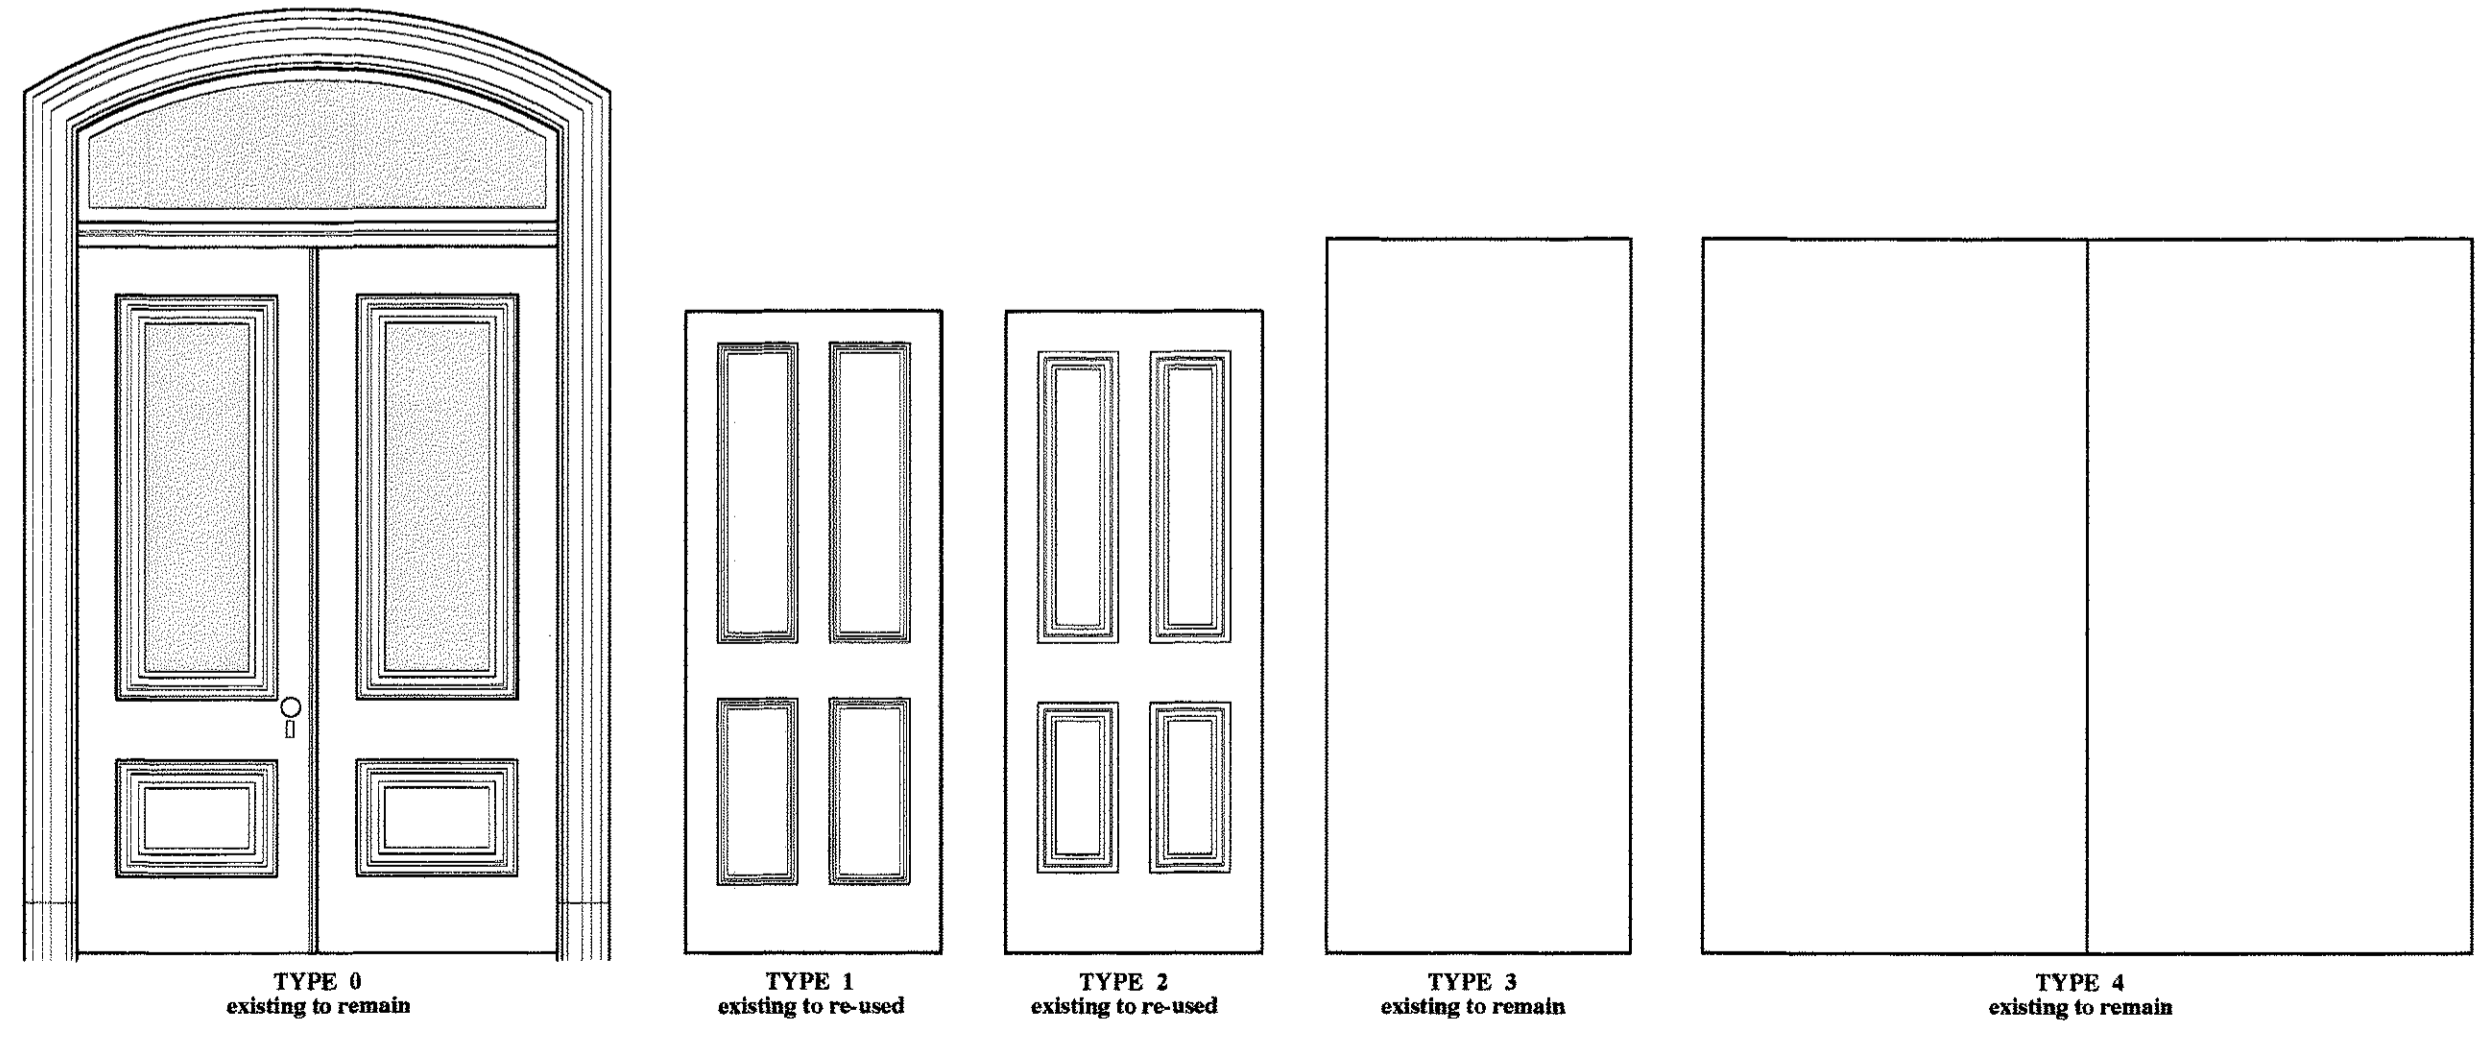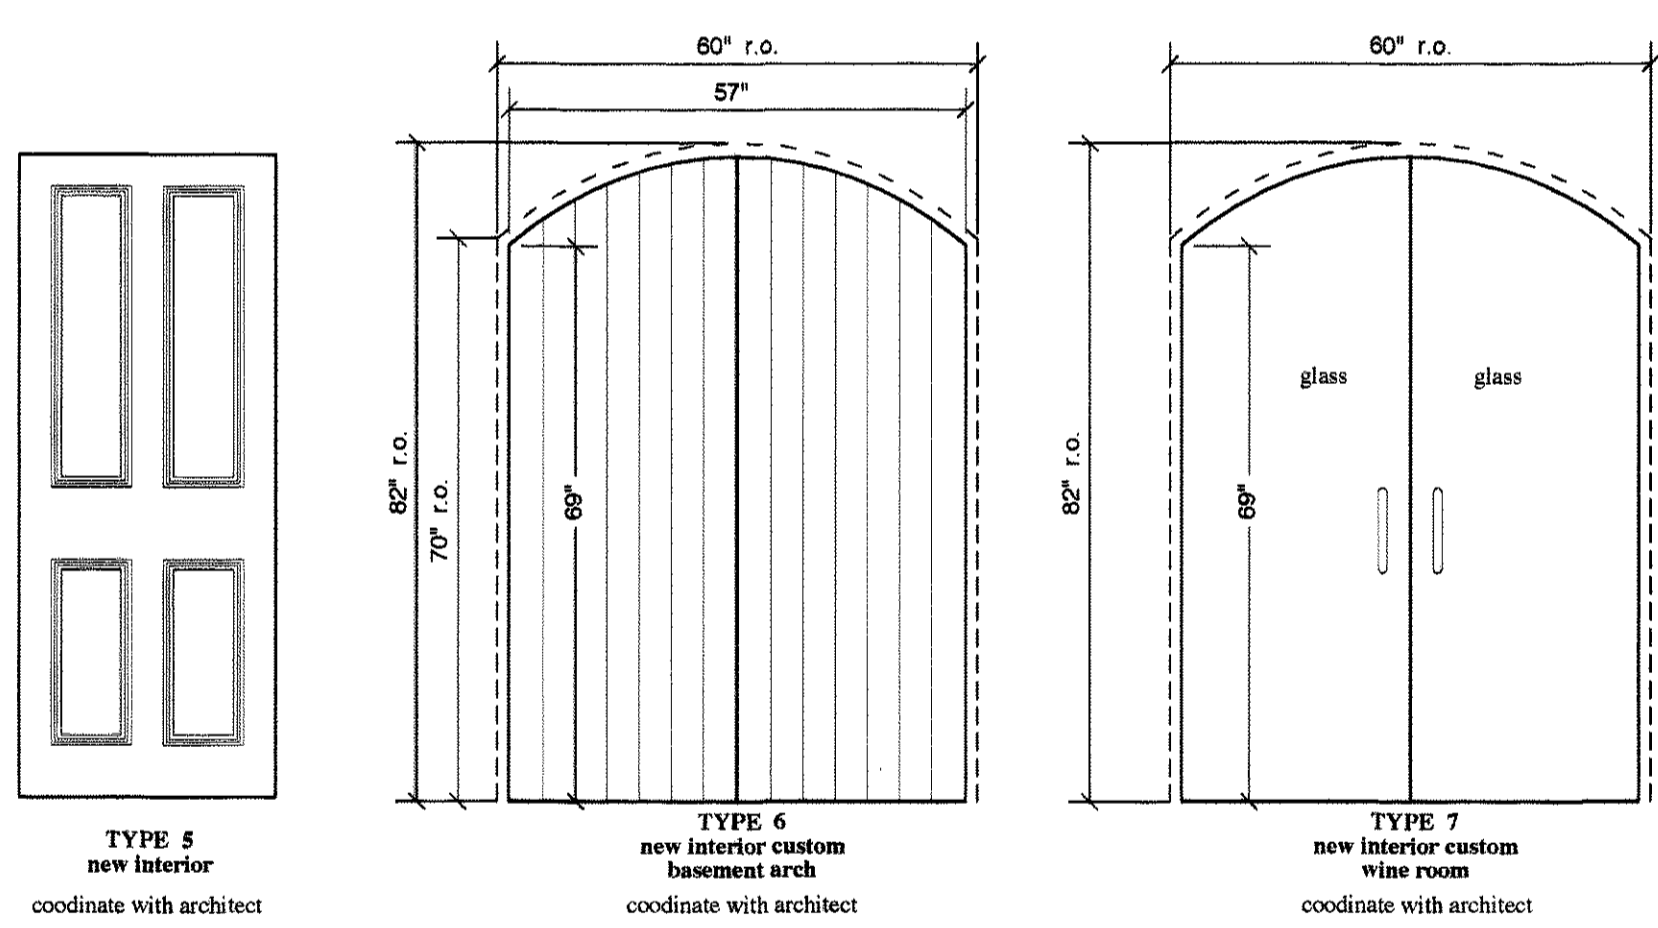

NOTES
 1) All existing doors shall be labeled using existing drawing tag #'s prior to removal and properly stored for possible re-use
 2) All existing doors for re-use shall be re-finished as necessary
 3) contractor to confirm all rough openings before framing
 4) re-use existing door frames where applicable
 5) all new frames and trim to match existing
 C. denotes custom door
 V.I.F. verify in field
 EX. existing
 T.B.D. to be determined

HARDWARE SETS
 EX1 existing to remain: 2 hinges, mortised lockset and porcelain knob
 All existing re-used hardware shall be repaired and re-finished as necessary.
 All new hardware shall be coordinated with architect and owner

DOOR SCHEDULE
 Note: Verify all rough openings prior to ordering

Door / Room #	Door Size	Jamb Size	Type	Hardware		Comments
				Set #	Type	
N 001	New door	(2) 28 1/2" x 80 x 1-3/8	7 design to follow	7	design to follow painted	Custom door, arched top, glass with chrome hinges/ pulls
N 002	New door	36 x 80 x 1-1/2	5	5	fire rated painted	1 hour rated
N 003	NOT USED					
N 004	NOT USED					
N 005	NOT USED					
N 006	NOT USED					
N 007	NOT USED					
N 008	NOT USED					
N 009	NOT USED					
N 010	NOT USED					
N 011	New door	36 x 80 x 1-1/2	5	5	fire rated painted	
N 012	New door	(2) 30 x 80 x 1-3/8	5	5	painted	
N 013	New door	32 x 80 x 1-3/8	5	5	painted	
N 014	New door	36 x 80 x 1-1/2	t.b.d.	exterior	t.b.d.	Custom mahogany door, see drawing A4.0 for more information
N 015	New door	verify in field	t.b.d.	exterior	t.b.d.	see drawing A2.2 for more information
EX 100		60-1/2 x 89-3/4 x 2-1/2	0	exterior	natural finish	owner to provide new latch sets to remain
EX 101		60-1/2 x 88-1/4 x 2-1/2	0		natural finish	owner to provide new latch sets to remain
EX 102		38-1/2 x 89 x 1-3/4	3		natural finish	EX 1 to remain
EX 103		94 x 105 x 2-1/2	4		natural finish	EX 1 to remain. Restore a refinish.
EX 104		37-1/2 x 89 x 1-3/4	3		natural finish	EX 1 to remain
EX 105		29-3/4 x 88-1/4 x 1-1/2	1		natural finish	EX 1
EX 106		28-1/4 x 82-1/4 x 1-1/2	1		painted	adjust hinges for left hand swing (see plan)
EX 107		31-1/2 x 83 x 1-5/8	1		painted	
EX 108	NOT USED	27-1/4 x 83 x 1-3/4	2		painted	
EX 109	NOT USED	29-1/4 x 83-1/4 x 1-3/4	1	exterior	painted	
EX 110		31-1/2 x 83 1/4 x 1-5/8	1		painted	
EX 111	NOT USED	31-1/2 x 83 x 1-1/4	1		painted	
EX 112		31-1/2 x 83 x 1-1/4	1		painted	
N 150		t.b.d.	t.b.d.		t.b.d.	Custom mahogany door, see drawing A4.0 for more information
N 151	NOT USED					
EX 200		33-1/2 x 83 x 1-3/4	2		painted	EX 1 adjust hinges for right hand swing (see plan)
EX 201		31-1/2 x 83-1/4 x 1-1/2	2	pocket	painted	EX 1 adjust hinges for right hand swing (see plan) provide weatherstrip / gasketing for sound deadening
EX 202		31-1/4 x 82-3/4 x 1-1/2	2		painted	EX 1 adjust hinges for right hand swing (see plan)
EX 203		33-1/2 x 83 x 1-3/4	1		painted	EX 1 adjust hinges for left hand swing (see plan)
EX 204		29-1/2 x 84 x 1-3/4	2		painted	EX 1 brass knob repair hole from deadbolt and swap out brass knob
EX 205		31-1/2 x 83-1/4 x 1-3/4	2		painted	EX 1
EX 206		34-1/4 x 84 x 1-3/4	2a		painted	EX 1 same as type 2 but with arched top and glass upper panels
EX 207		31-1/4 x 79-1/2 x 1-1/2	1		painted	EX 1 provide weatherstrip / gasketing for sound deadening
EX 208		31 x 79-1/2 x 1-1/2	1		painted	EX 1
EX 209	NOT USED	31 x 79-3/4 x 1-1/4	1		painted	EX 1
EX 210		29-1/2 x 79-1/2 x 1-1/2	1		painted	EX 1
EX 211		29-3/4 x 79-1/2 x 1-1/4	1		painted	EX 1
EX 212	NOT USED	29-1/4 x 79-1/4 x 1-1/2	1		painted	EX 1 bored lockset nickel knob
EX 300		32-1/2 x 80 x 1-1/2	1		painted	EX 1
EX 301	NOT USED	32-1/2 x 80 x 1-3/4	1		painted	EX 1a brass knob poor condition - scabbled on piece at jamb w/ deadbolt
EX 301A		32-3/8 x 80-1/2 x 1-3/8	1		painted	EX 1
EX 302	NOT USED	32-3/8 x 80 x 1-1/4	1		painted	EX 1 poor condition - scabbled on piece at jamb
EX 303		32-1/2 x 80 1/4 x 1-3/8	1		painted	EX 1
EX 304		32-1/4 x 80 1/2 x 1-3/4	1		painted	EX 1
EX 305		29-1/4 x 80 x 1-1/2	1		painted	EX 1 adjust hinges for left hand swing (see plan)
EX 306		29-1/2 x 80 1/4 x 1-3/8	1		painted	EX 1 adjust hinges for left hand swing (see plan)
EX 307	NOT USED	29-1/2 x 80-1/2 x 1-3/8	1		painted	EX 1 deadbolt
EX 308	NOT USED	31 x 80 x 1-5/8	1		painted	EX 1 extra door stored in attic space
N 350		verify in field custom size		see interior elevation	painted	t.b.d. new custom door to attic

These drawings are the architect's instruments of service. A substantial amount of work to be done on the project is based on conversations between the Architect and Wright-Ryan Construction. If the drawings are used without the Architect's involvement in interpretation of the documents and review of field conditions, the Architect shall not be liable for problems with any aspect of the design during and after construction.

construction set 01/03/11

66 West Street
Portland, Maine 04102
207-775-0443
207-775-2892
studio@vandamdesign.com

Landscape Architect:
James Doyle Design Associates
125 Greenwich Avenue
Greenwich, CT 06839

Jenkins Residence

294 Spring Street
Portland, Maine

Interior Door Schedule

Drawn by: GFB
Scale: as shown
Date: 1/12/10
Revisions: 4/10/11 Job #: 20913

A4.4