




1 Kitchen / Sunroom Plan
SCALE: 1/2" = 1'-0"

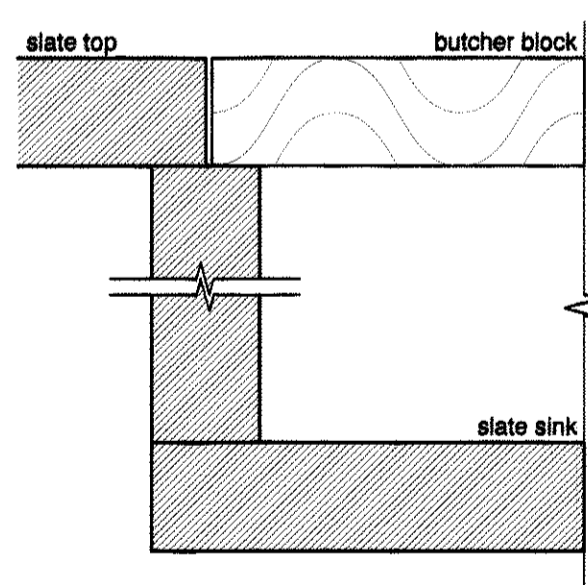


4 slate sink
SCALE: 3" = 1'-0"

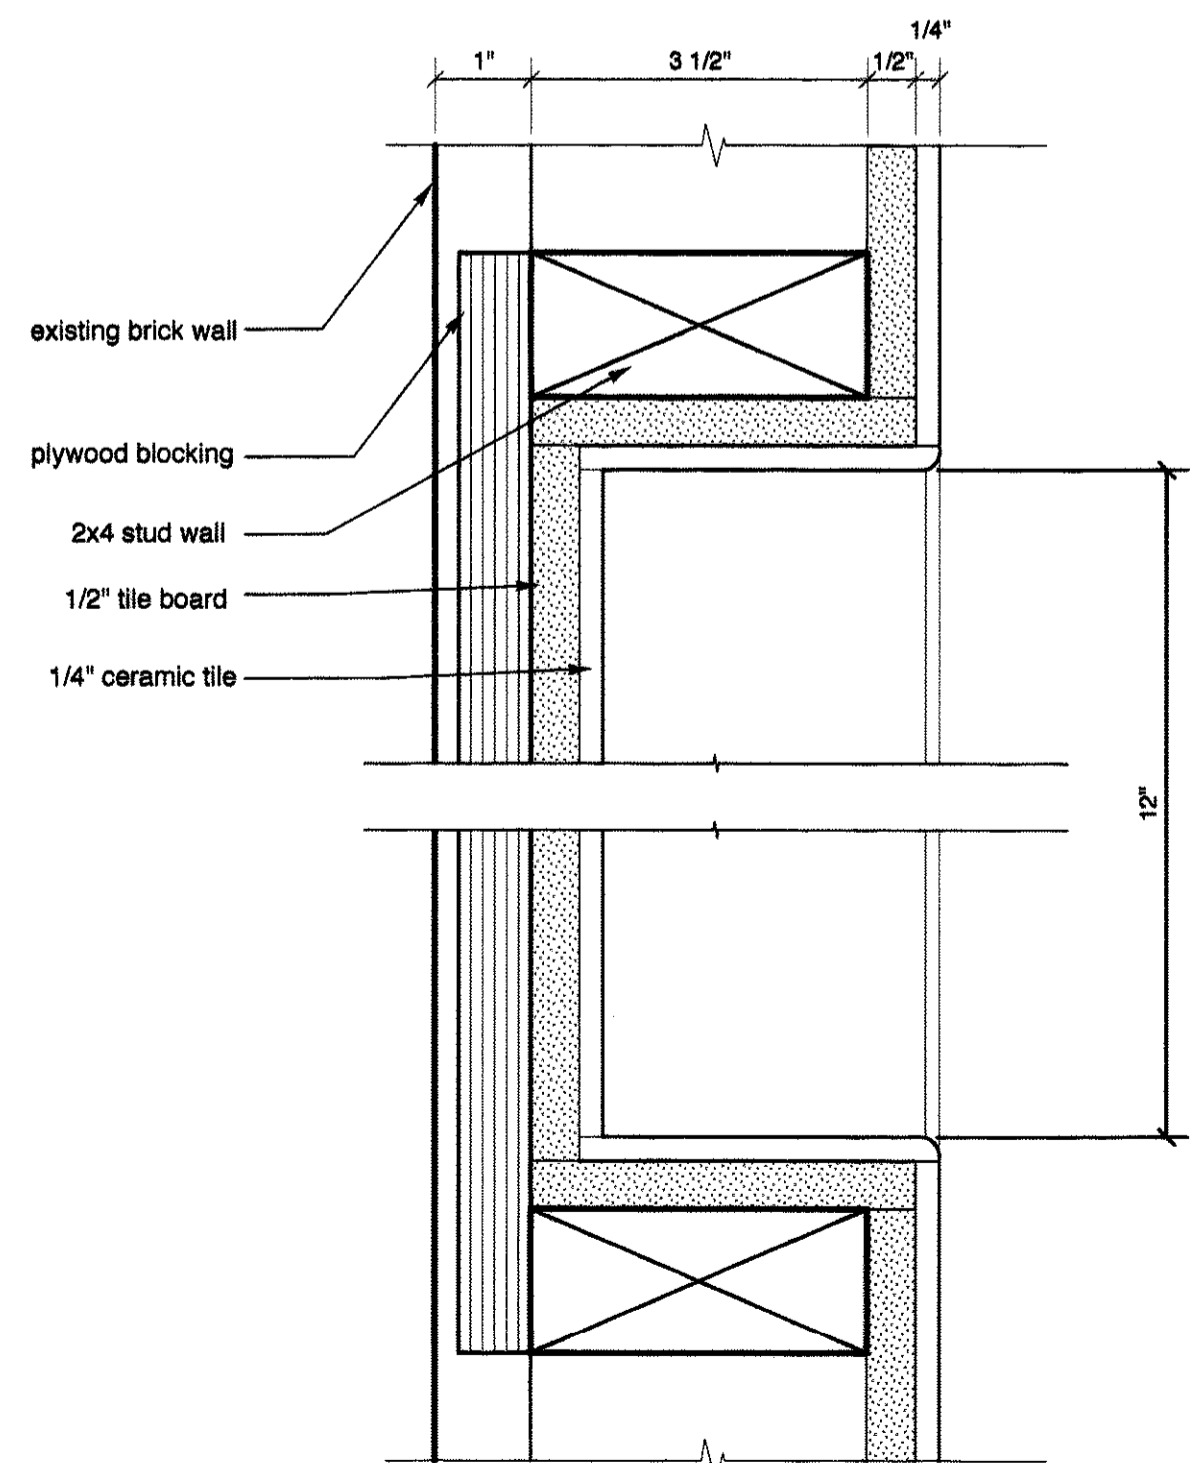

3 tiled niche
SCALE: 6" = 1'-0"

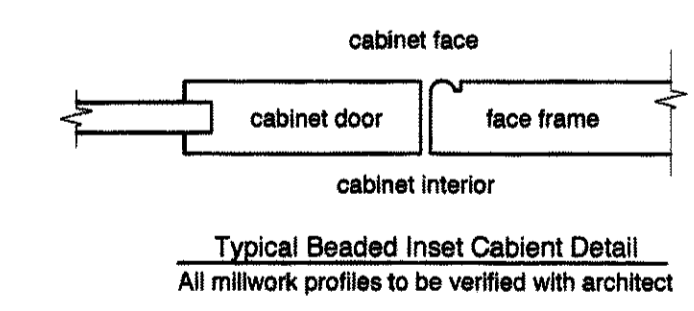

Typical Beaded Inset Cabinet Detail
All millwork profiles to be verified with architect

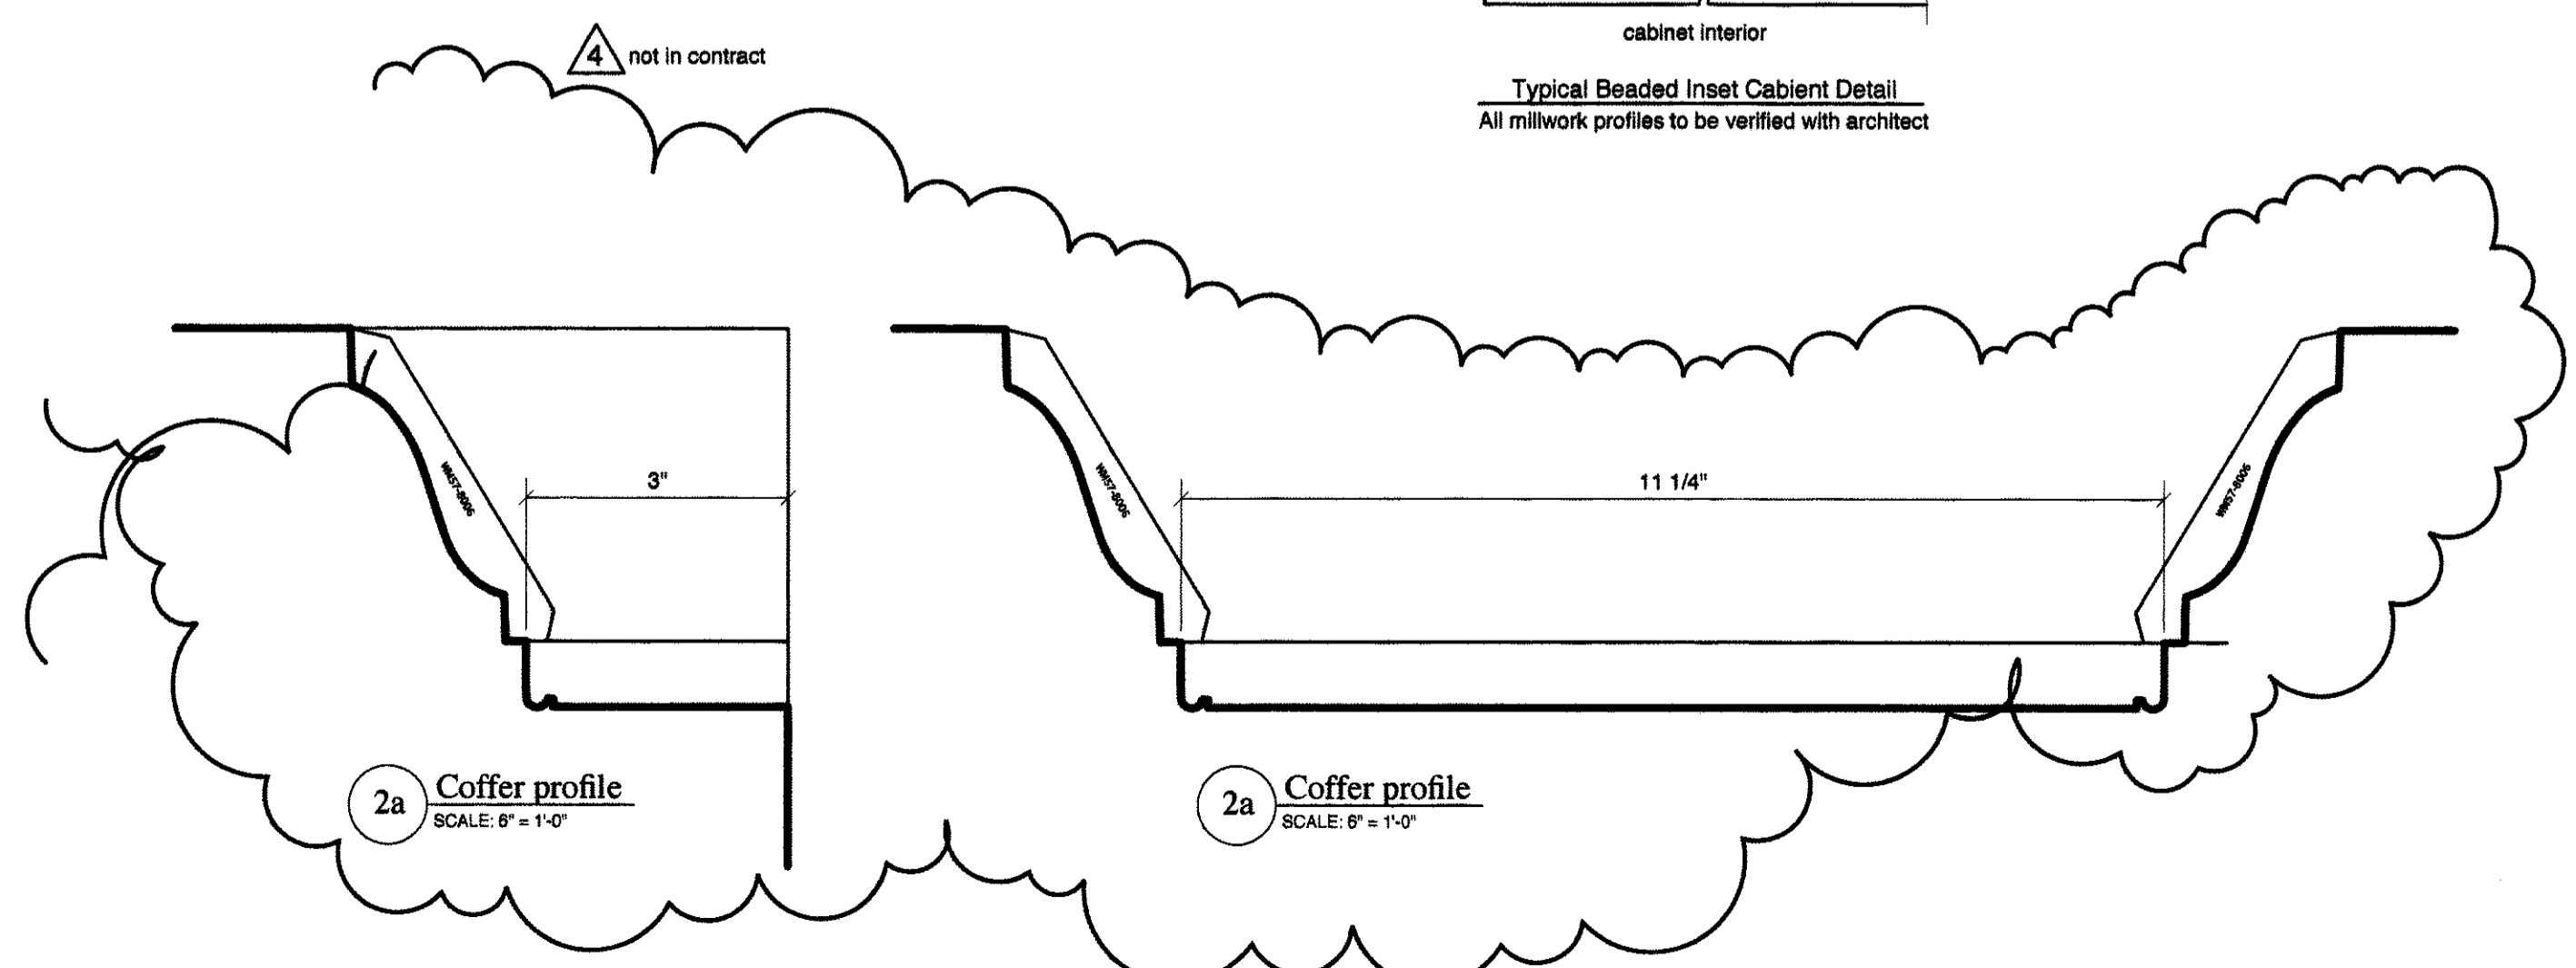

2a Coffier profile
SCALE: 6" = 1'-0"

2a Coffier profile
SCALE: 6" = 1'-0"

These drawings are the architect's instruments of service. A substantial amount of work to be done on the project is based on conversations between the Architect and Wright-Ryan Construction. If the drawings are used without the Architect's involvement in interpretation of the documents and review of field conditions, the Architect shall not be liable for problems with any aspect of the design during and after construction.

for reference and pricing
construction set 01/03/11

Van Dam Architecture and Design

Landscape Architect:
James Doyle Design Associates
125 Greenwich Avenue
Greenwich, CT 06839

Jenkins Residence

Kitchen, Sunroom &
Vestibule Plan

A5.0

66 West Street
Portland, Maine 04102
207-775-0443
FAX 775-2892
studio@vandamdesign.com

294 Spring Street
Portland, Maine

Drawn by: KGH Date: 02/27/10
Scale: 1/2" = 1'-0"
Revisions: 1/04/06/11 Job #: 20913