




1 interior elevation - Adrian's Room
SCALE: 1/2" = 1'-0"

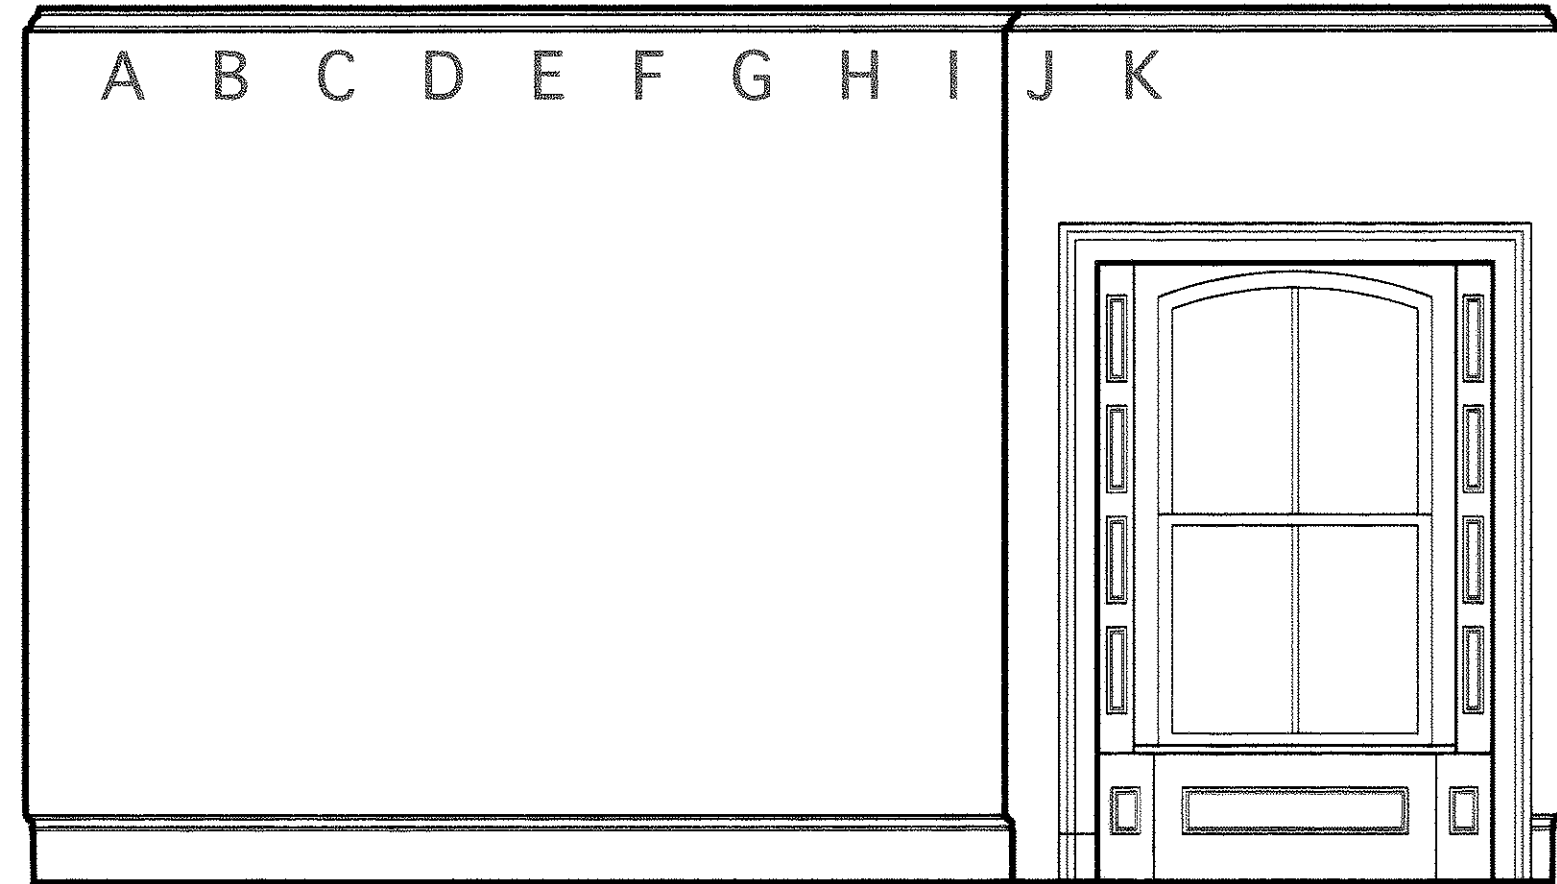


5 interior elevation - Day Nursery
SCALE: 1/2" = 1'-0"

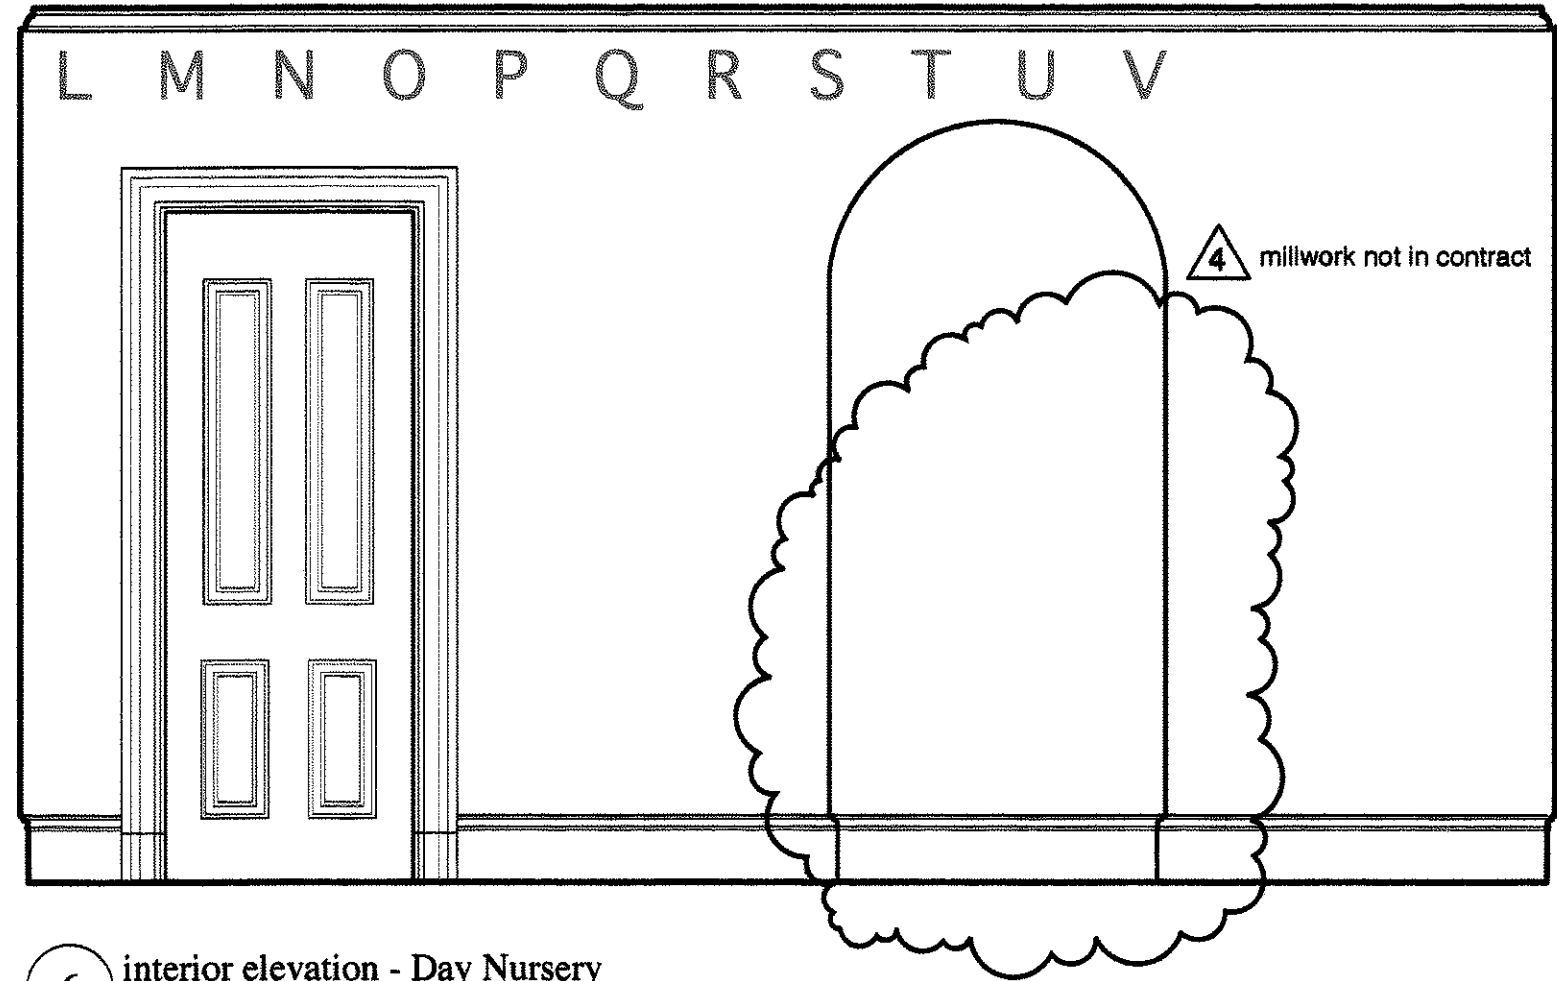

6 interior elevation - Day Nursery
SCALE: 1/2" = 1'-0"

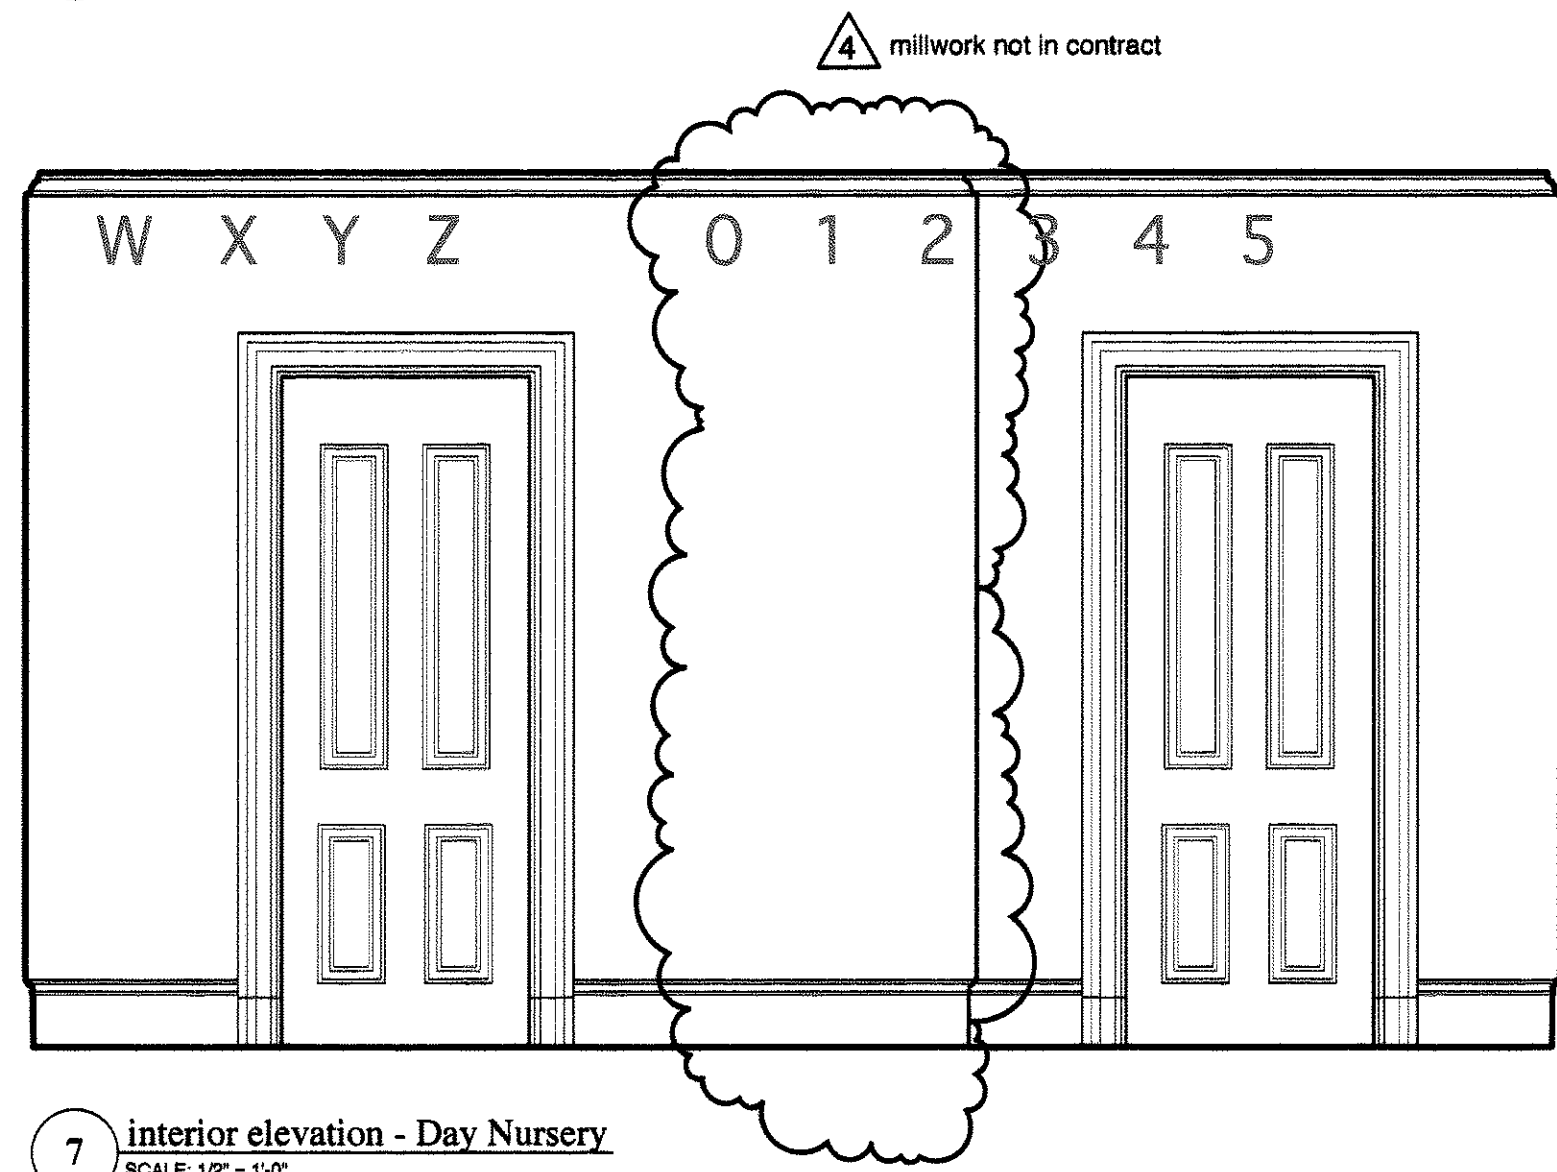

7 interior elevation - Day Nursery
SCALE: 1/2" = 1'-0"

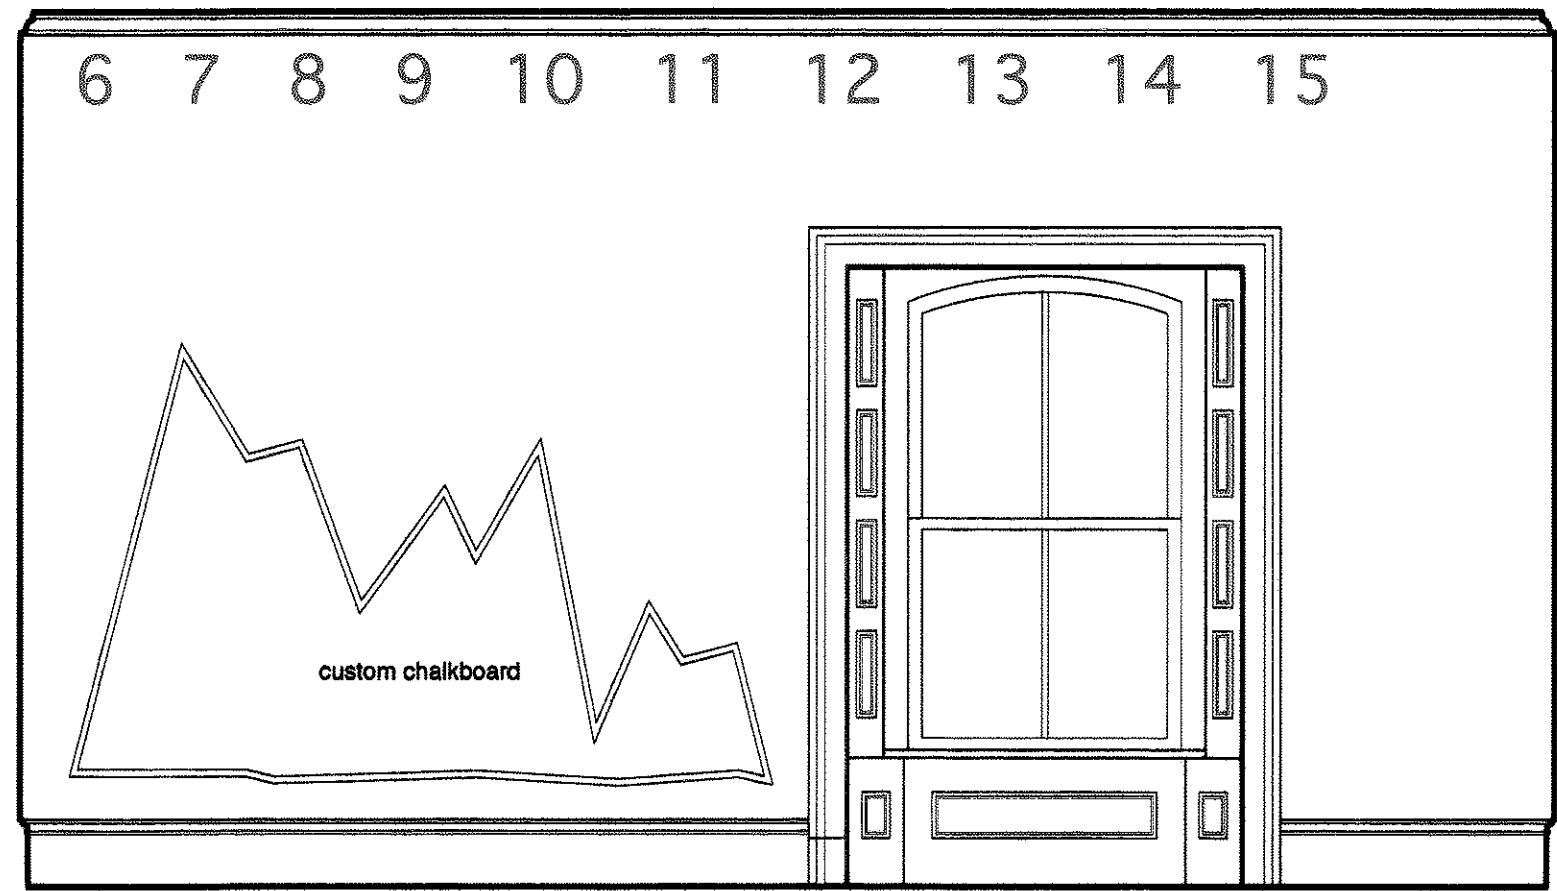

8 interior elevation - Day Nursery
SCALE: 1/2" = 1'-0"

These drawings are the architect's instruments of service. A substantial amount of work to be done on the project is based on conversations between the Architect and Wright-Ryan Construction. If the drawings are used without the Architect's involvement in interpretation of the documents and review of field conditions, the Architect shall not be liable for problems with any aspect of the design during and after construction.

for reference and pricing
construction set 01/03/11

Interior Elevations

Drawn by: KFH Scale: 1/2" = 1'-0" Date: 06/20/10
Revisions: - Job #: 20913

A5.8

Jenkins Residence

294 Spring Street
Portland, Maine

Landscape Architect:
James Doyle Design Associates
125 Greenwich Avenue
Greenwich, CT 06839

Van Dam Architecture and Design

66 West Street
Portland, Maine 04102
207.775-2893
FAX 775-2892
studio@vandamdesign.com