


ROOF FRAMING PLAN
1/4"=1'-0"

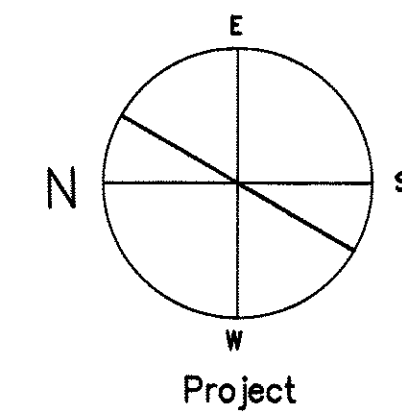

These drawings are the architect's instruments of service. A substantial amount of work to be done on the project is based on conversations between the Architect and Wright-Ryan Construction. If the drawings are used without the Architect's involvement in interpretation of the documents and review of field conditions, the Architect shall not be liable for problems with any aspect of the design during and after construction.

Van Dam Architecture and Design
66 West Street
Portland, Maine 04102
207-775-0443
FAX: 775-2892
studio@vandamdesign.com

BECKER
structural engineers, inc.
75 York Street
Portland, ME 04101-1701
Tel: 207-579-1822
Fax: 207-579-1822
www.beckerinc.com

Landscape Architect:
James Doyle Design
Architects
125 Greenwich Avenue
Greenwich, CT 06839

Jenkins Residence
294 Spring Street
Portland, Maine

Roof Framing Plan
Date: 21 September 2010
Scale: NOTED
Job #: 20913
Revisions: A 04/06/11

S1.5