




Approved for Historic Preservation
Certificate of Appropriateness


08/01/18

Date:

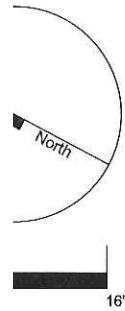


Existing Wall Photos


15 Vaughan Street
Residence

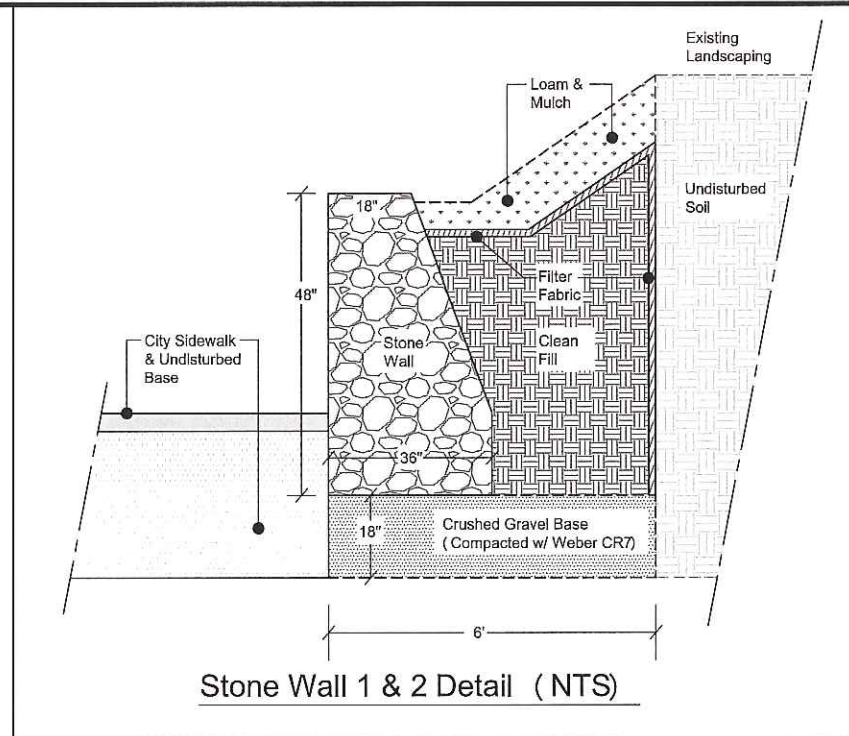

Stone Wall 1 & 2 Detail (NTS)

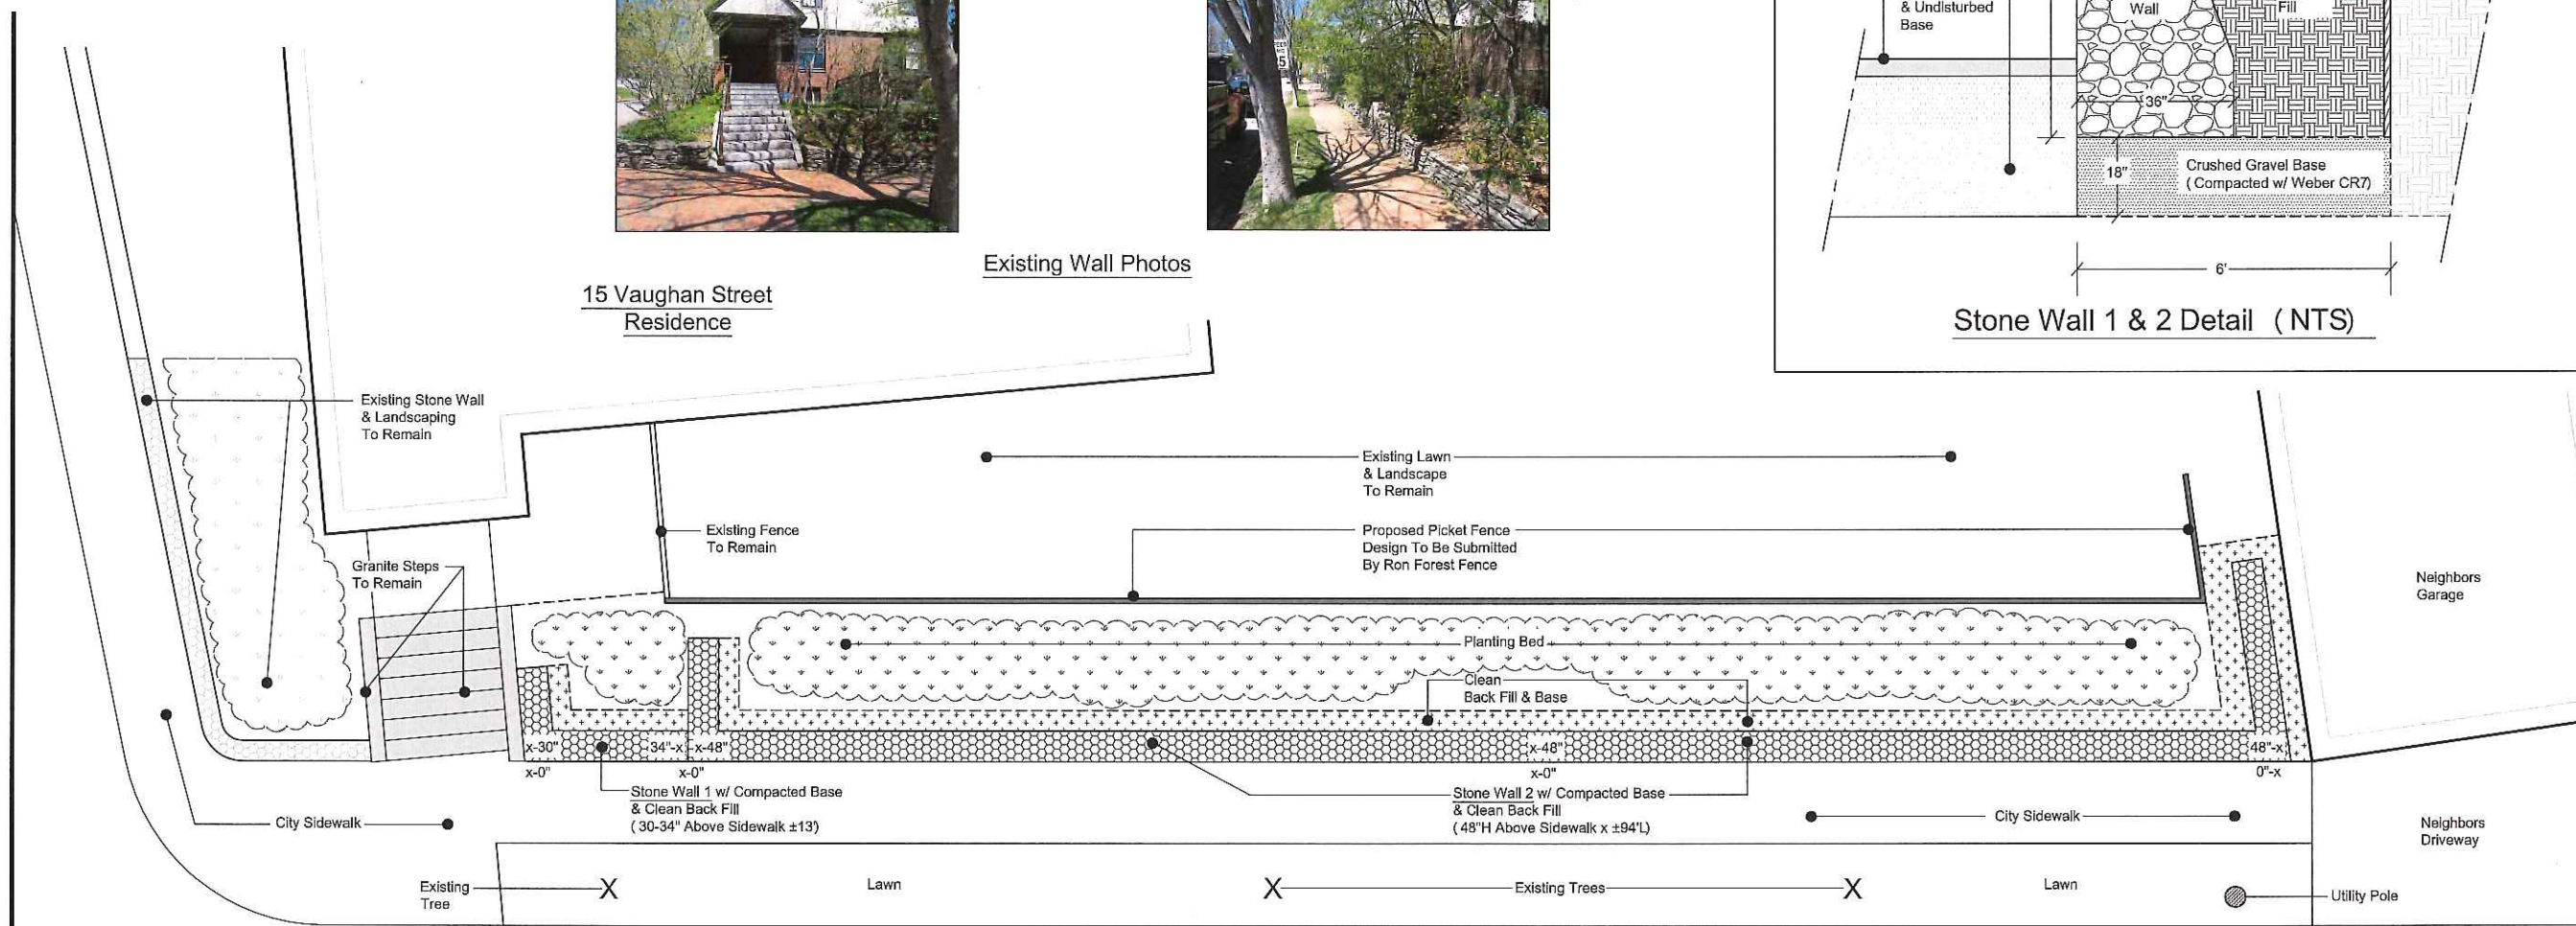

Vaughan Street

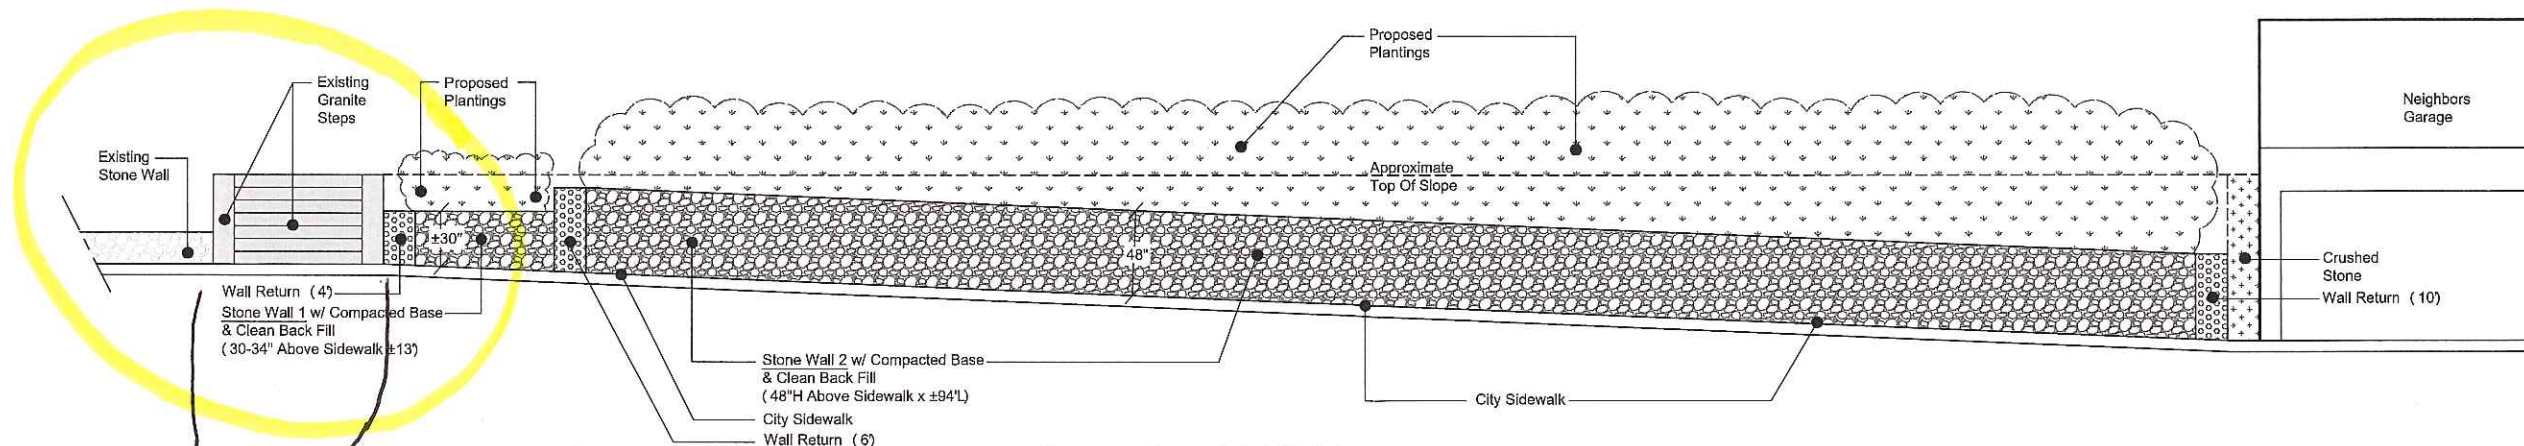

Proposed Stone Wall #1 & 2
Elevation

WALLS TO BE EVEN
WITH EACH OTHER

Prepared For:
Merclier Landscaping

Prepared By:



Land Plans, Inc.
www.landplansinc.com
(207) 347 0123

RETAINING WALL PLAN

15 VAUGHAN STREET
PORTLAND, ME

REVISIONS	DATE
HISTORIC REVIEW COMMENT	6-22-18

DATE	MAY 15, 2018
------	--------------

SCALE	1:4
-------	-----

SHEET NUMBER

1

SHEET 1 OF 1