


2ND FLOOR PLAN

SCALE: 1/8" = 1'-0"

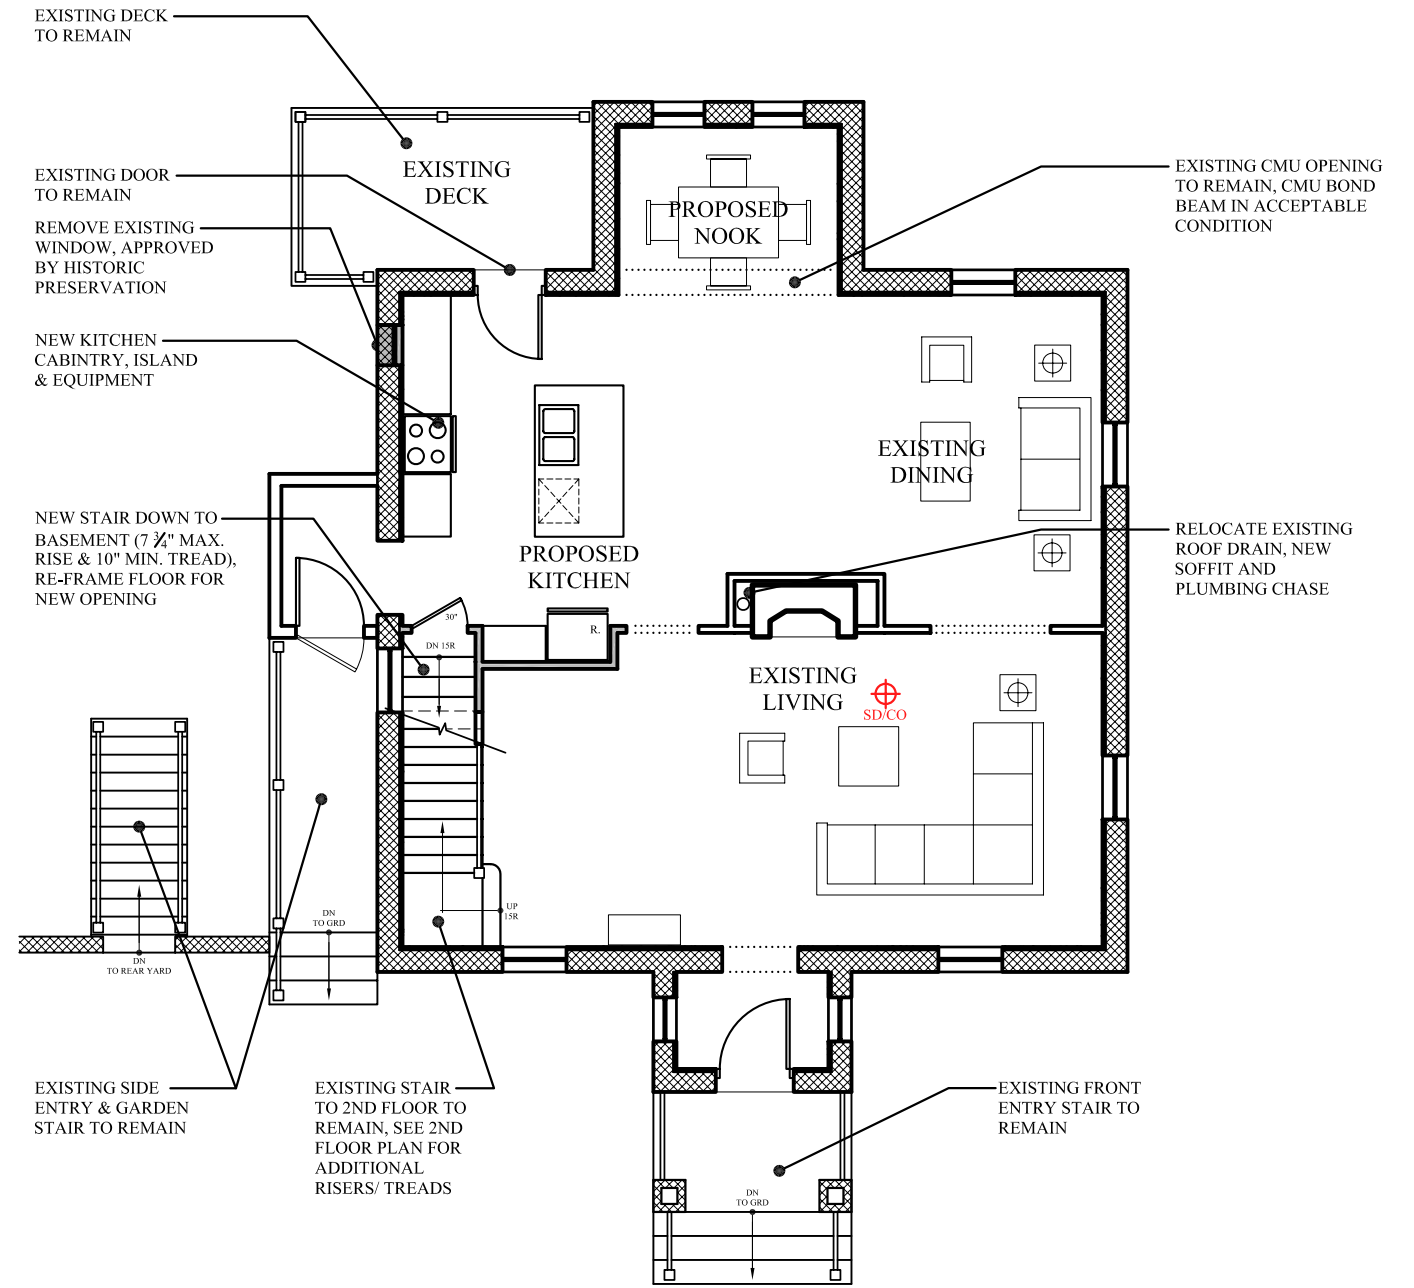

1ST FLOOR PLAN

SCALE: 1/8" = 1'-0"

'AS BUILT PLANS'
REVISED: JUNE 27, 2013
AUGUST 24, 2012

A-1.0

342 DANFORTH STREET
PORTLAND, MAINE