


**BENSON RENOVATION**  
**09-12-2013**  
**AS BUILT**

NOTE:  
 FIELD VERIFY ALL DIMENSIONS

**MUDROOM/ PANTRY WINDOWS**  
 A281 - 2' 8" W X 2' 0 1/8" H RO  
 TW210410 - 3'-0 1/8" W X 5' 0 7/8" H RO  
 TW20210 - 2' 2 1/8" W X 3' 0 7/8" H RO

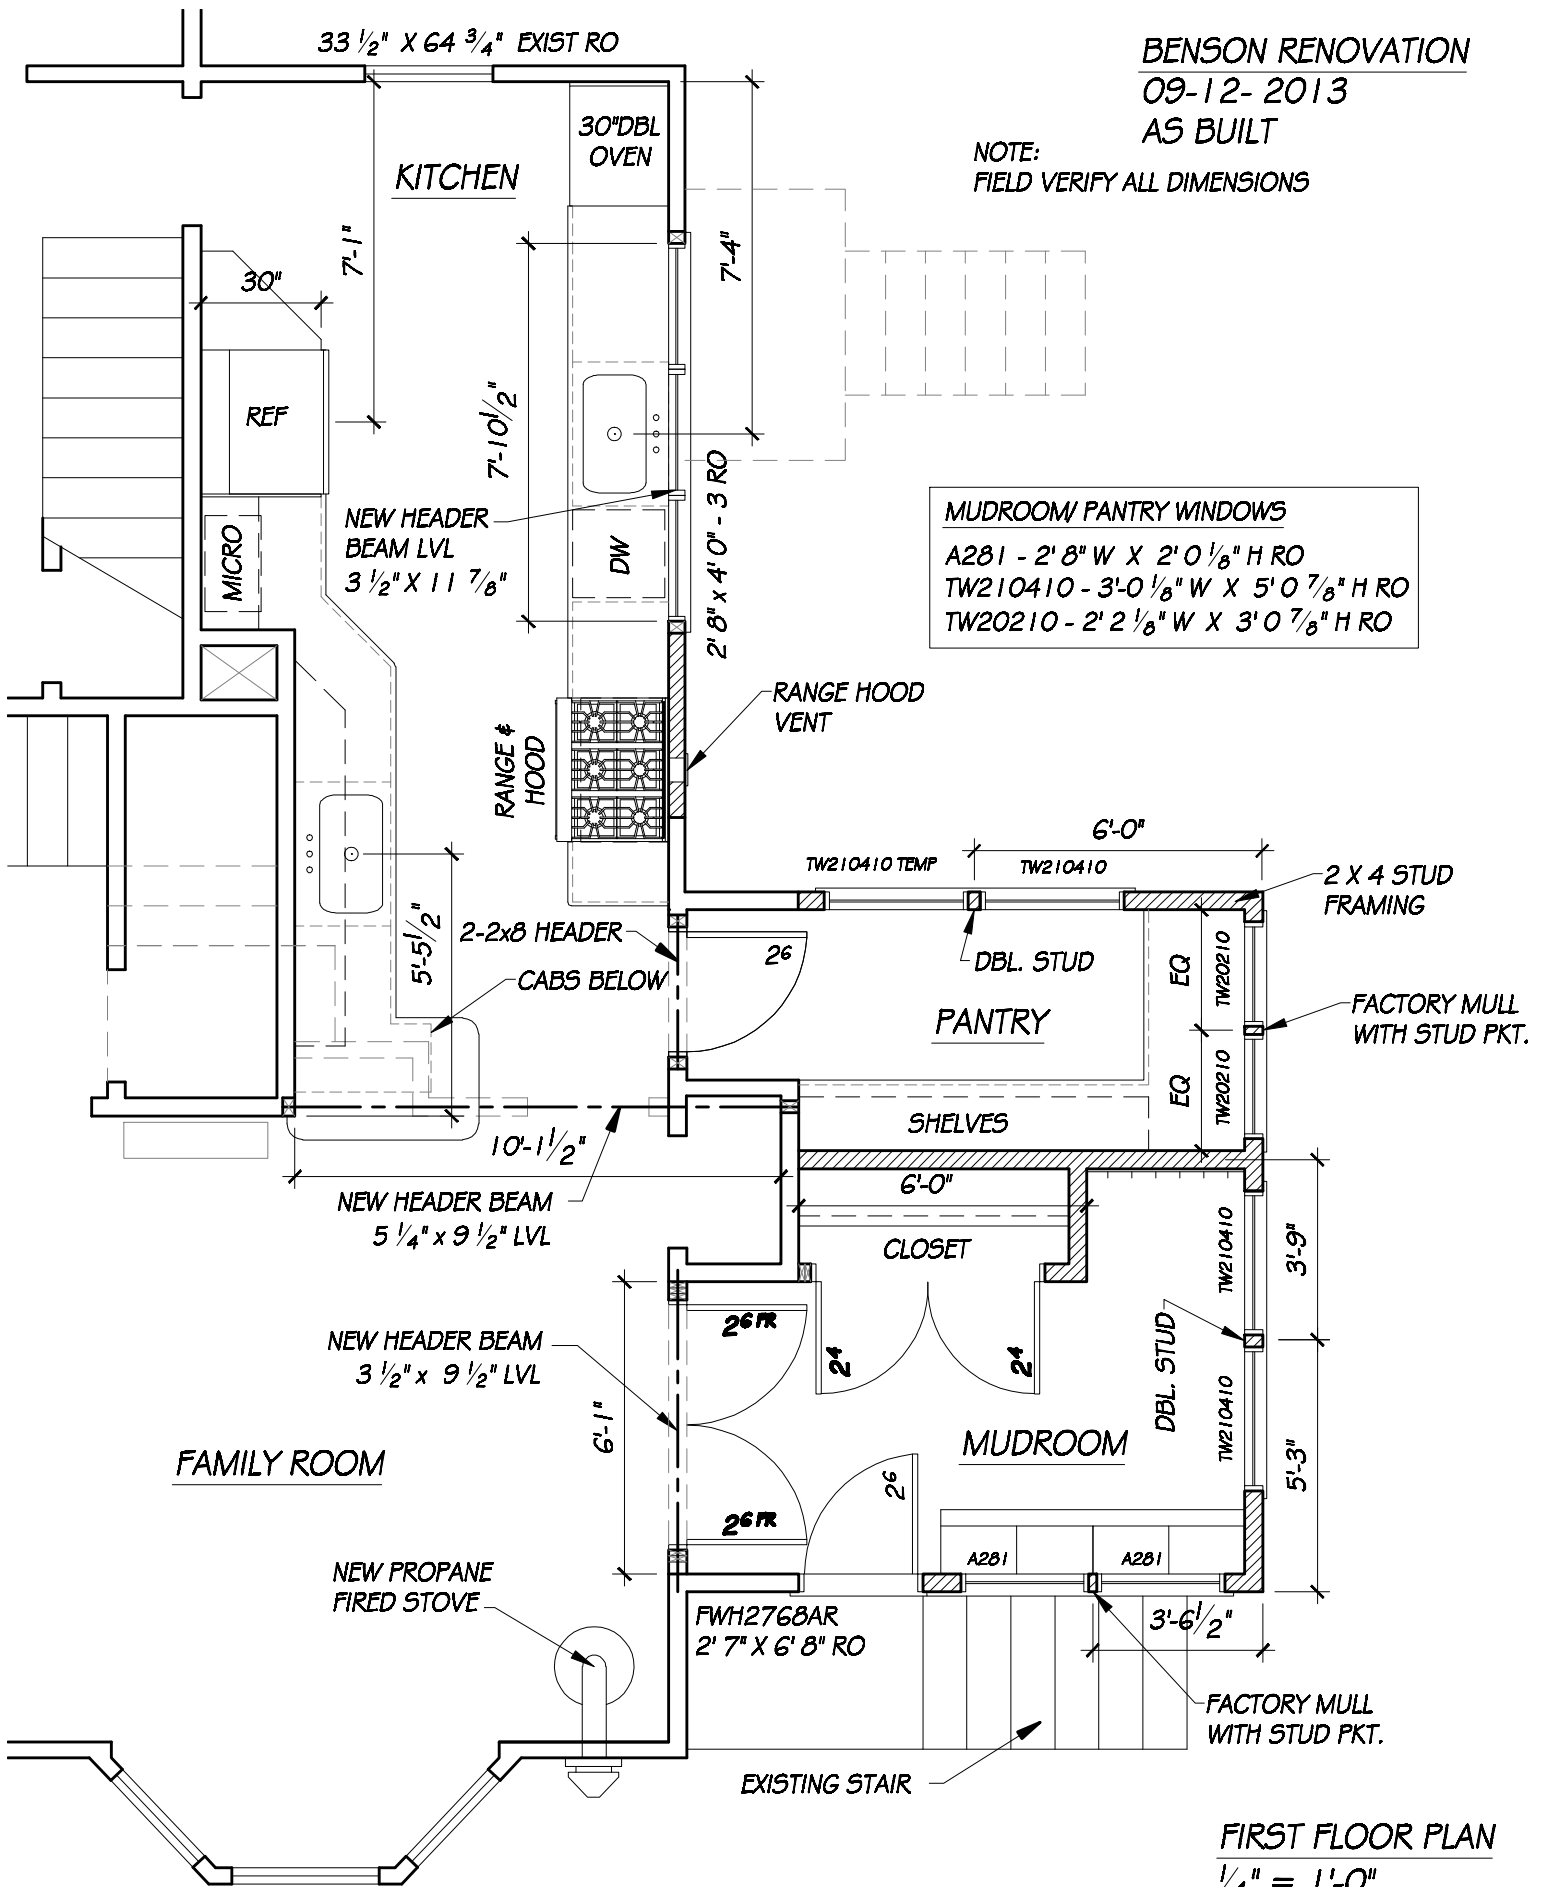

**FIRST FLOOR PLAN**  
 1/4" = 1'-0"