


BENSON RENOVATION
09-12-2013
AS BUILT

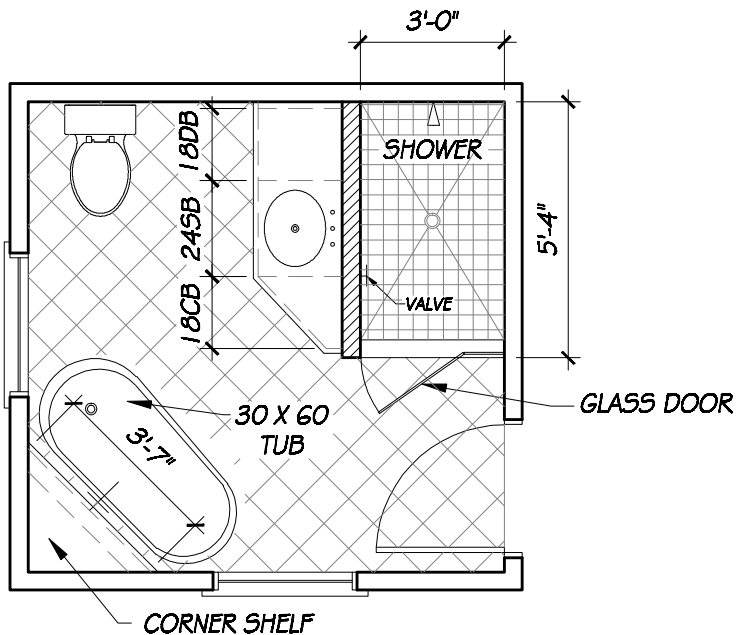

BATHROOM RENOVATION PLAN
 $\frac{1}{4}'' = 1'-0'$