

Don,

Enclosed is a plan for the
work I did in the existing
Bathroom at 56 Thomas St.

I demo'd the wall to the
existing shower and added a
wall to make the Washer/Dryer
Closet.

The original Permit I received
for the project was

2013-02586 issued 12/02/2013


any other info you need please

call me 838-2508

Thank you,


Mike Miller

Mike Miller Inc.

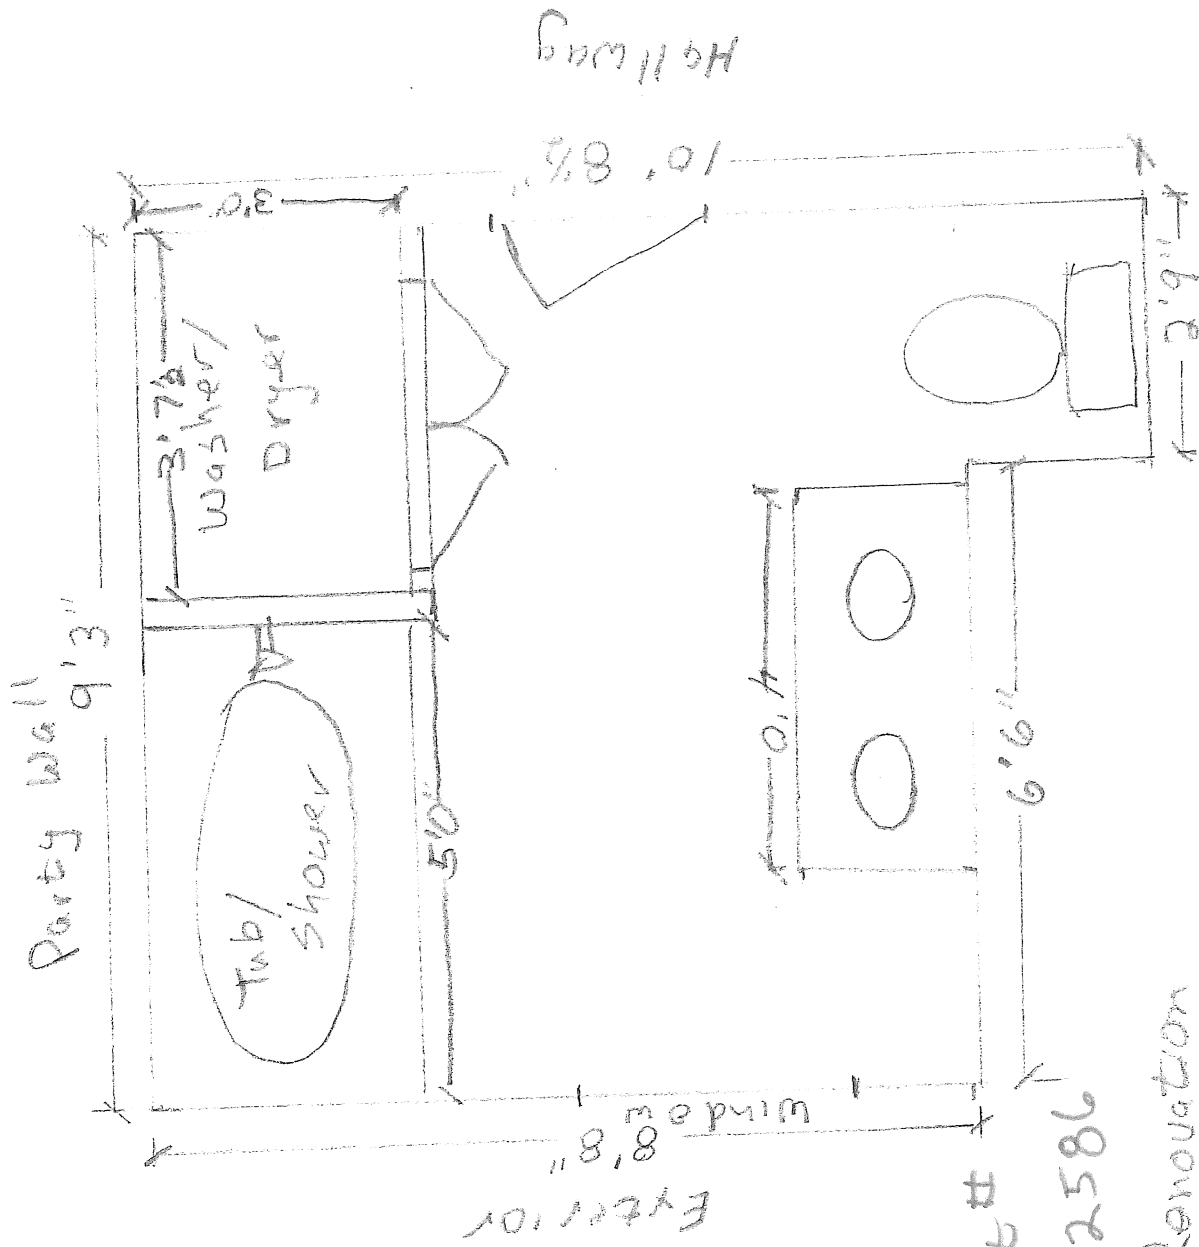

Original Permit #
 2013-02586
 Proposed Renovation
 56 Thomas St
 Guest Bathroom
 1/2" Scale

Library

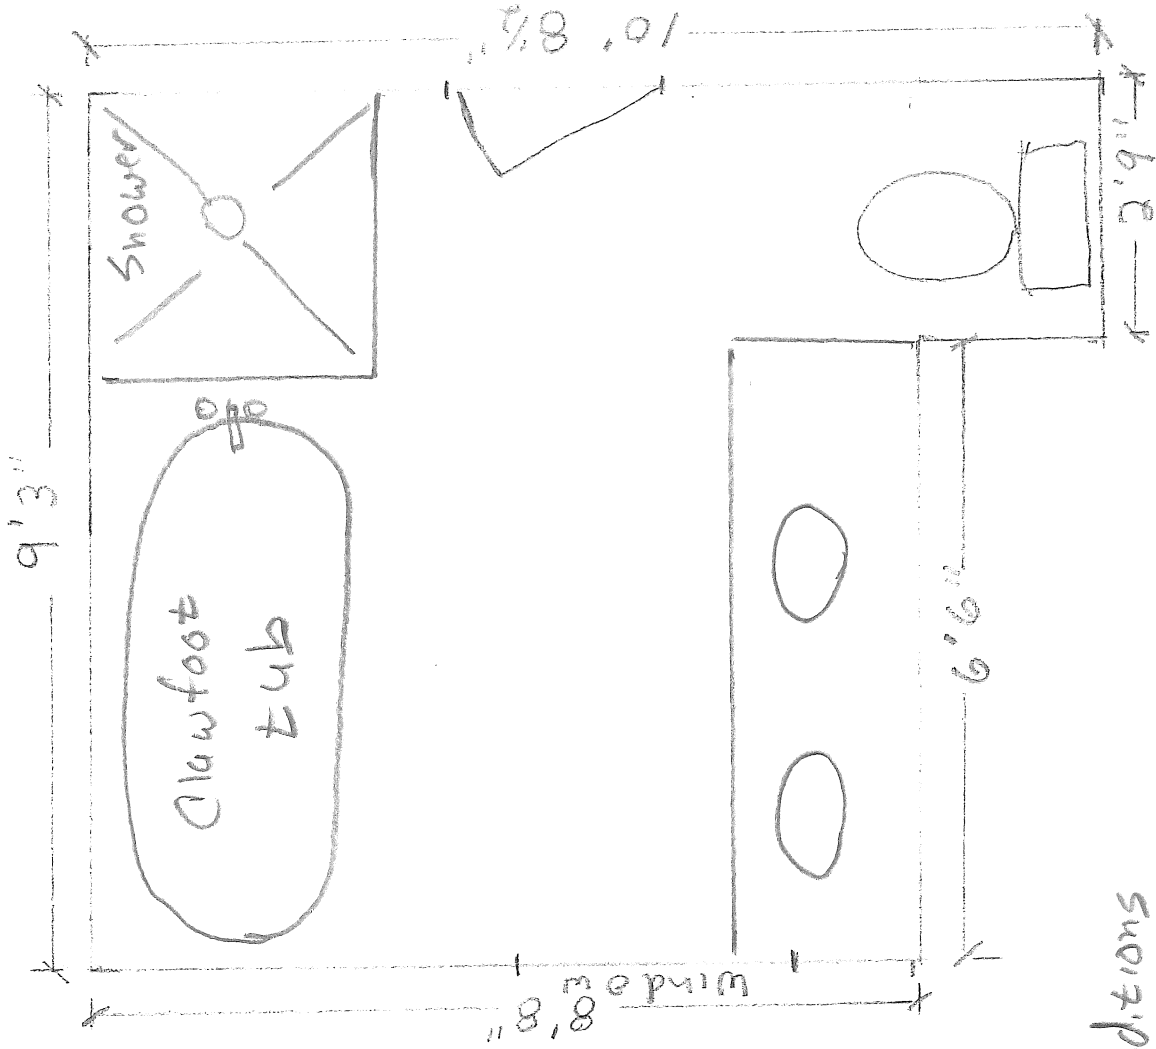

Existing Conditions
 56 Thomas St
 Guest Bathroom
 1/2" Scale