

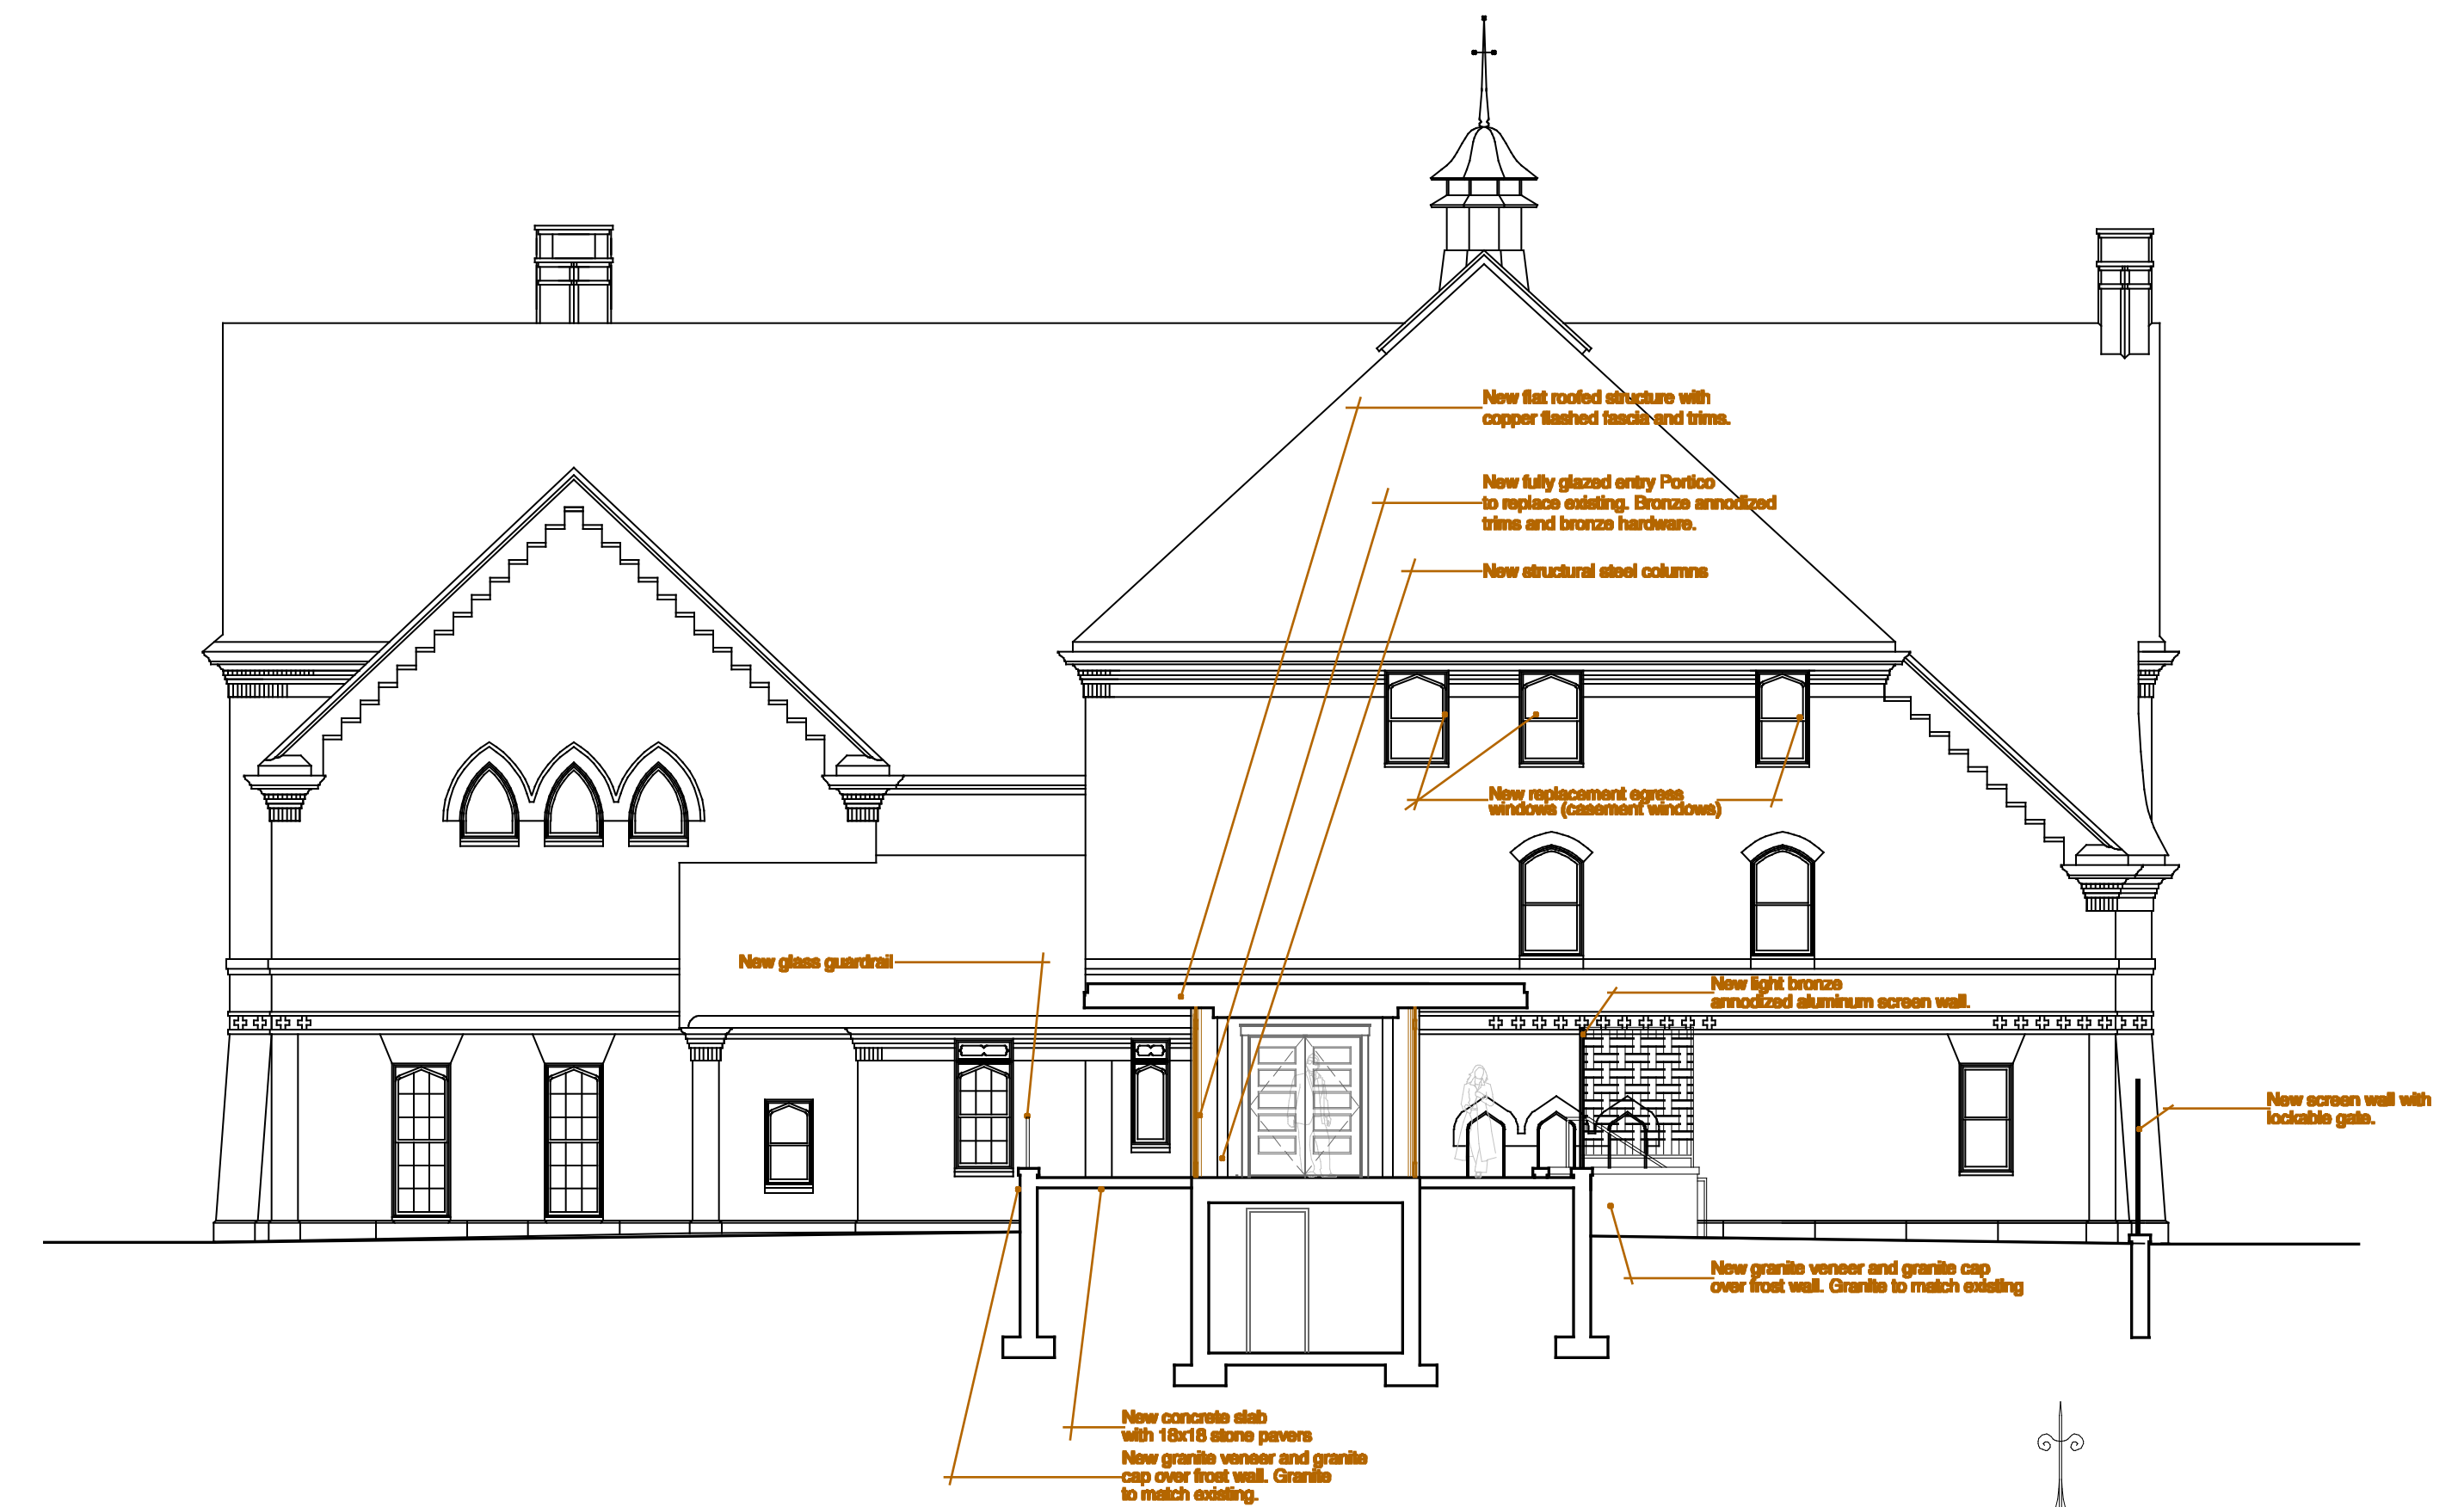
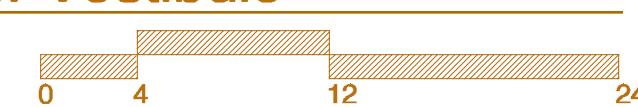



21 Section at New Vestibule

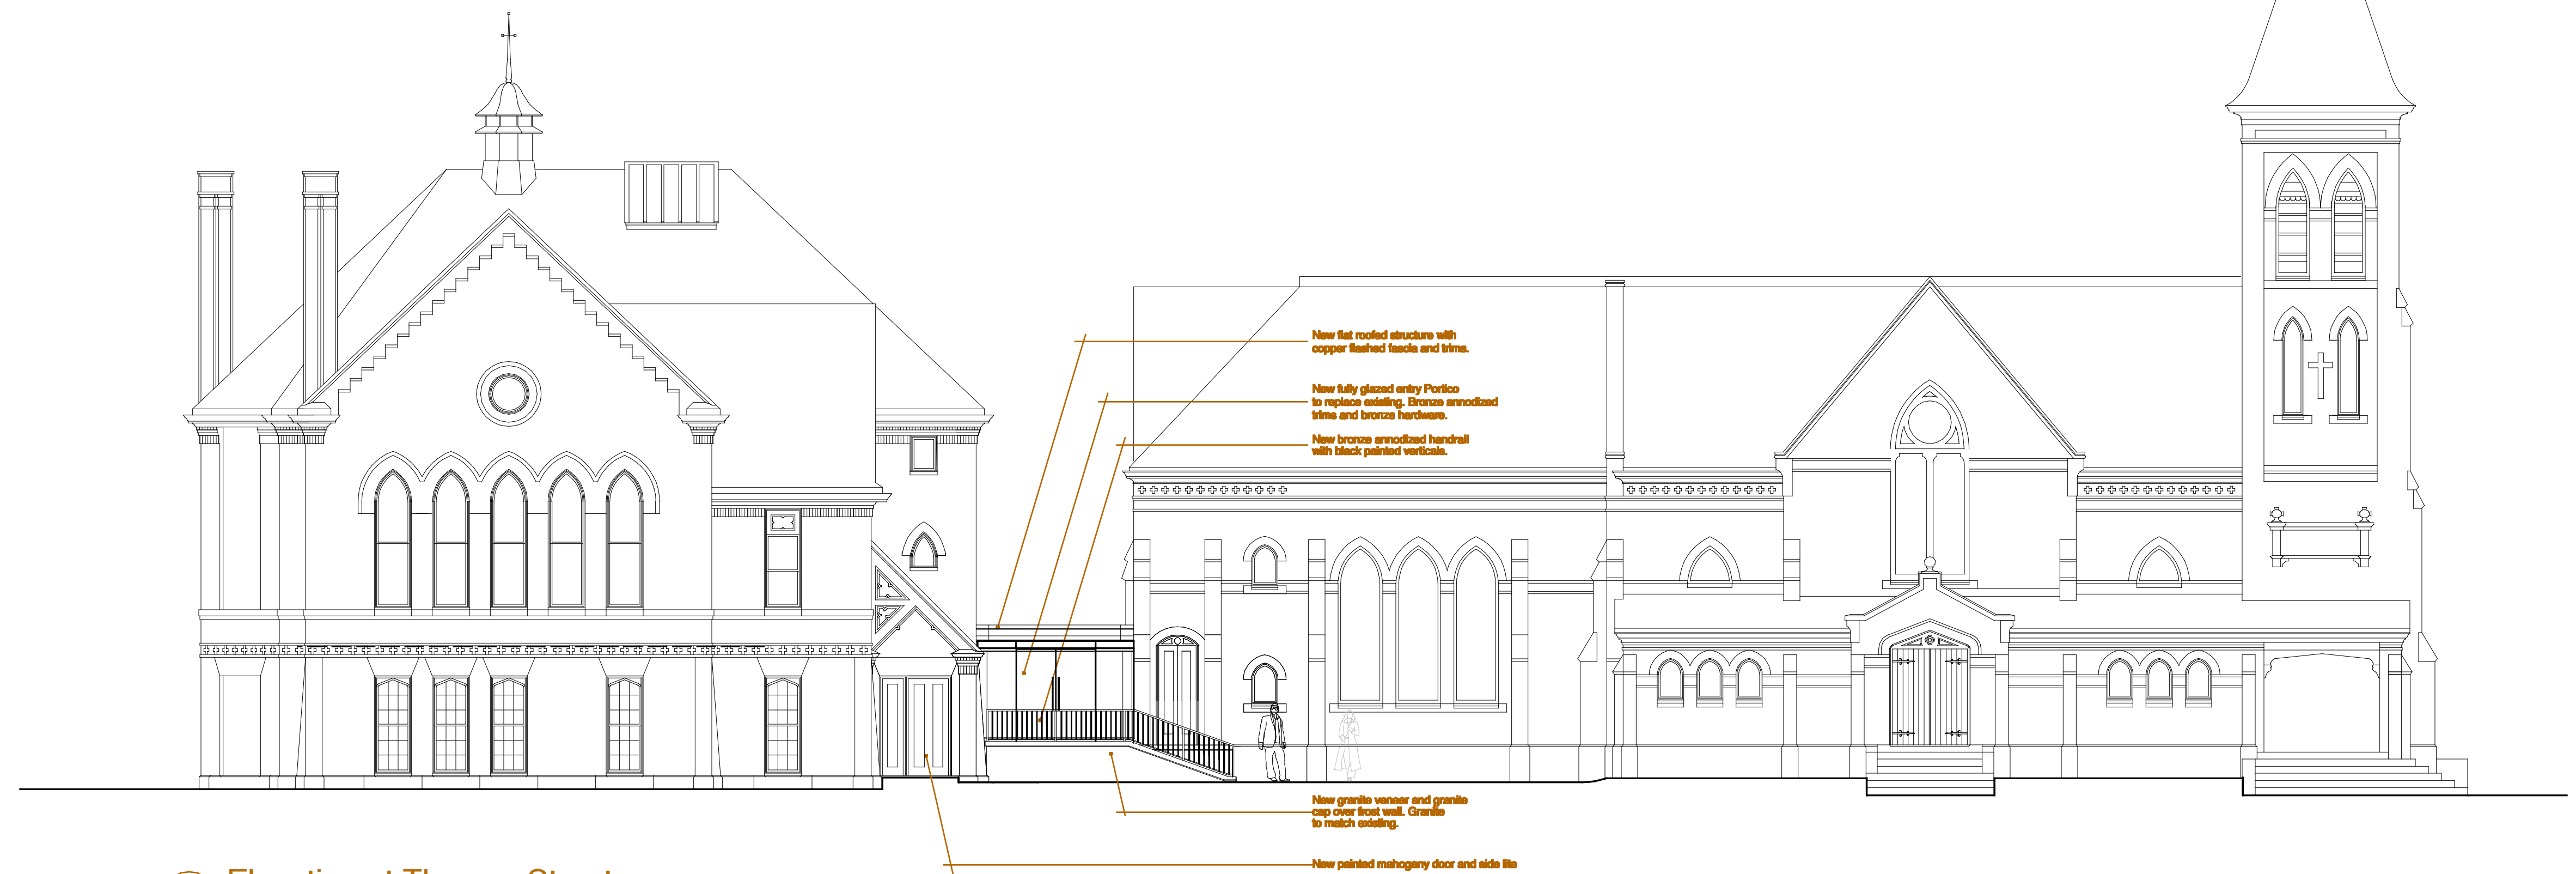

20 Section at New Vestibule

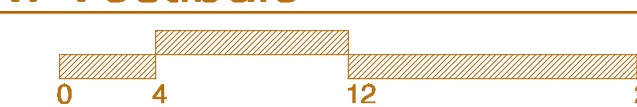

10 Elevation at Thomas Street

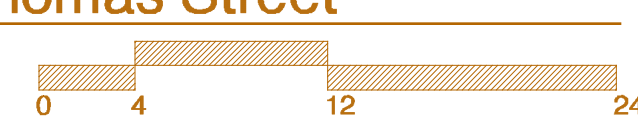

Revisions	date
Issued for Pricing	02/29/2016
Issued for Permit	02/22/2016
Revised handrail & flipped courtyard.	08/22/2016
Drawings Issued for Construction	06/15/2016