


32 Thomas St Apartments
32 Thomas St., Portland, ME
Exterior Railing
Elevation and Detail

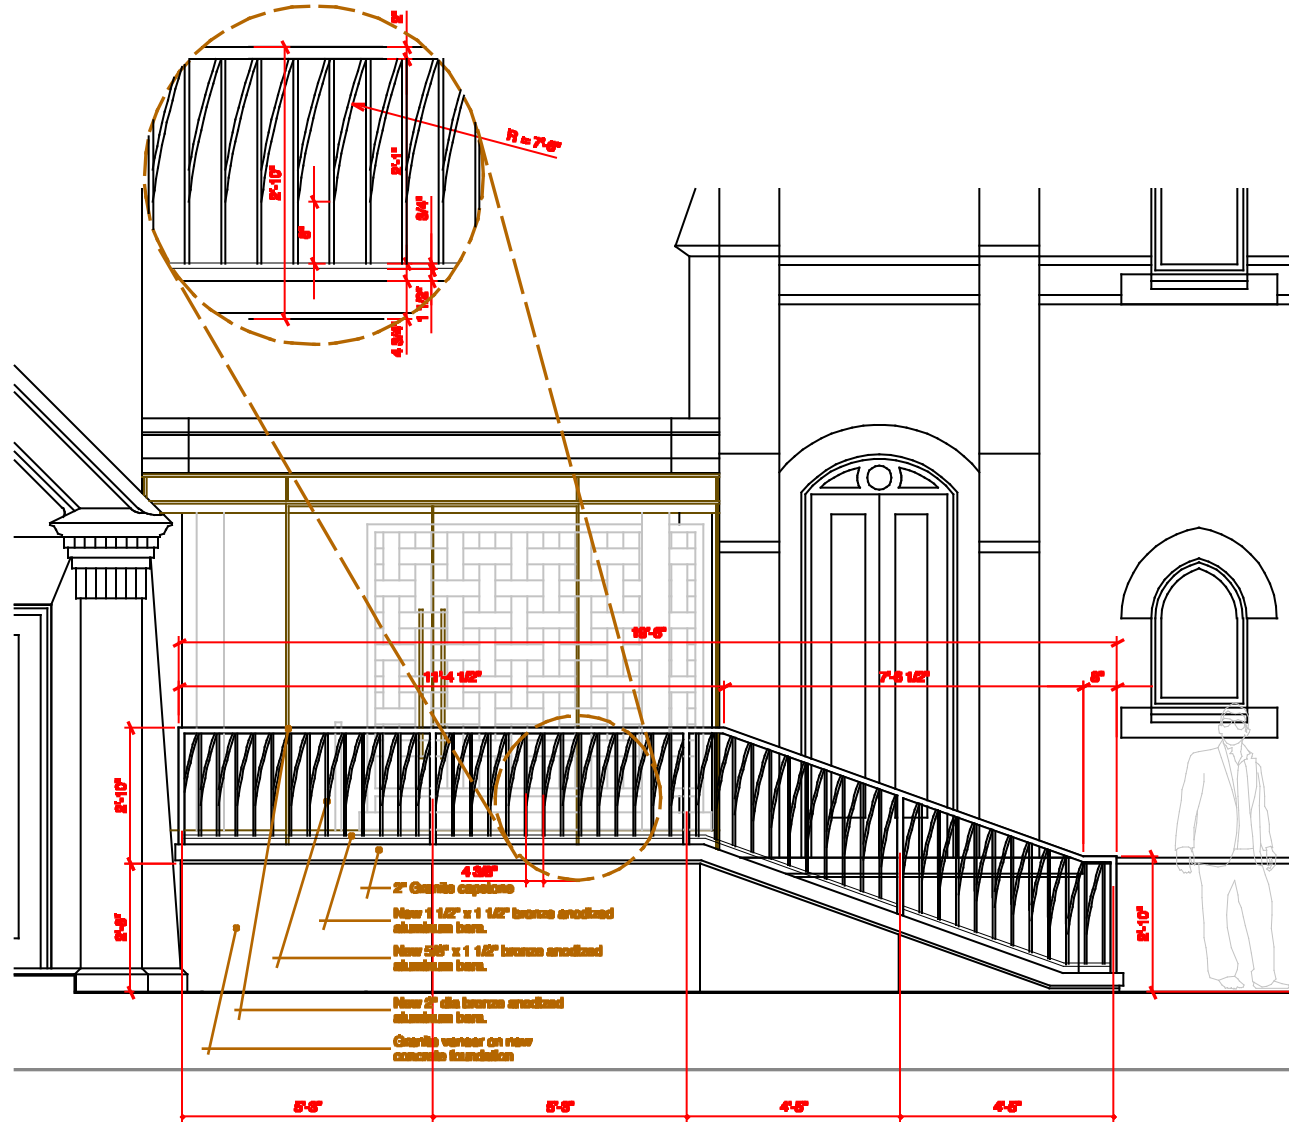

10 Enlarged Interior Elevation

Scale: 1/4" = 1'-0" Date: 03/17/16
Drawn By: MGW
Project No: 2011-018
DWG NO:

SKA-01