

Location of Construction: 140 Chadwick St		Owner: Perkins, David & Janet		Phone:	
Owner Address: ]		Leasee/Buyer's Name:		Phone:	
Contractor Name: Michael Pock		Address: 86 Grand St So. Ptld, ME		Phone: 04106 799-5462	
Past Use: 2-fam		Proposed Use: Same		<b>COST OF WORK:</b> \$ 600	
				<b>PERMIT FEE:</b> \$ 25.00	
				<b>FIRE DEPT.</b> <input type="checkbox"/> Approved <input type="checkbox"/> Denied	
				<b>INSPECTION:</b> Use Group: Type:	
				Signature:	
Proposed Project Description:  <del>XXXXXXXXXXXXXXXXXXXXXXXXXXXX</del> Add staircase as per plans		<b>PEDESTRIAN ACTIVITIES DISTRICT (P.U.D.)</b>		Signature:	
		Action: Approved <input type="checkbox"/>		Date:	
		Approved with Conditions: <input type="checkbox"/>			
		Denied <input type="checkbox"/>			
Permit Taken By: Mary Gresik		Date Applied For: 30 October 1996			

Permit No: **961106**

**PERMIT ISSUED**

Permit Issued:  
NOV - 7 1996

**CITY OF PORTLAND**

Zone: *R-3* CBL: 063-A-016

Zoning Approval: *1941 shows 2 units condition: Special Zone or Reviews: 1st floor level*

Shoreland *to only ACCESS*

Wetland

Flood Zone

Subdivision *ok*

Site Plan *major minor mm*

*11/1/96*

**Zoning Appeal**

Variance

Miscellaneous

Conditional Use

Interpretation

Approved

Denied

1. This permit application doesn't preclude the Applicant(s) from meeting applicable State and Federal rules.
2. Building permits do not include plumbing, septic or electrical work.
3. Building permits are void if work is not started within six (6) months of the date of issuance. False information may invalidate a building permit and stop all work..

**PERMIT ISSUED WITH REQUIREMENTS**

**CERTIFICATION**

I hereby certify that I am the owner of record of the named property, or that the proposed work is authorized by the owner of record and that I have been authorized by the owner to make this application as his authorized agent and I agree to conform to all applicable laws of this jurisdiction. In addition, if a permit for work described in the application issued, I certify that the code official's authorized representative shall have the authority to enter all areas covered by such permit at any reasonable hour to enforce the provisions of the code(s) applicable to such permit

*Michael R Pock* 86 Grand St So. Portland 30 October 1996  
 SIGNATURE OF APPLICANT Michael Pock ADDRESS: DATE: PHONE:

RESPONSIBLE PERSON IN CHARGE OF WORK, TITLE PHONE:

*New staircase to be painted after previous treated timber is allowed to season (6 mo)*

Action:

Approved

Approved with Conditions

Denied

Date: *10.30.96*

*J. Anderson*

CEO DISTRICT **3**

*T. m... sm*

COMMENTS

Stairs Complete - appear to be done per plans

	Type	Inspection Record	Date
Foundation:	_____	_____	_____
Framing:	_____	_____	_____
Plumbing:	_____	_____	_____
Final:	_____	_____	_____
Other:	_____	_____	_____

BUILDING PERMIT REPORT

DATE: 4 Nov 96 ADDRESS: 146 Chadwick ST.

REASON FOR PERMIT: To Construct Staircase

BUILDING OWNER: Michael Pock

CONTRACTOR: ' ' ' '


PERMIT APPLICANT: ' ' ' ' ' ' ' ' APPROVAL: \* 1, \* 7, \* 5  
 DENIED: \_\_\_\_\_

CONDITION OF APPROVAL OR DENIAL

- K 1. Before concrete for foundation is placed, approvals from ~~the Development Review coordinator and~~ Inspection Services must be obtained. (A24 hour notice is required prior to inspection)
- 2. Precaution must be taken to protect concrete from freezing.
- 3. It is strongly recommended that a registered land surveyor check all foundation forms before concrete is placed. This is done to verify that the proper setbacks are maintained.
- 4. Private garages located beneath habitable rooms in occupancies in Use Group R-1, R-2, R-3 or I-1 shall be separated from adjacent interior spaces by fire partitions and floor/ceiling assembly which are constructed with not less than 1-hour fire resisting rating. Private garages attached side-by-side to rooms in the above occupancies shall be completely separated from the interior spaces and the attic area by means of 1/2 inch gypsum board or the equivalent applied to the garage means of 1/2 inch gypsum board or the equivalent applied to the garage side. (Chapter 4 section 407.0 of the BOCA/1996)
- X 5. Guardrail & Handrails-A guardrail system is a system of building components located near the open sides of elevated walking surfaces for the purpose of minimizing the possibility of an accidental fall from the walking surface to the lower level. Minimum height all Use Groups 42", except Use Group R which is 36". In occupancies in Use Group A, B, H-4, I-1, I-2 M and R and public garages and open parking structures, open guards shall have balusters or be of solid material such that a sphere with a diameter of 4" cannot pass through any opening. Guards shall not have an ornamental pattern that would provide a ladder effect.
- 6. Headroom in habitable space is a minimum of 7'6".
- X 7. Stair construction in Use Group R-3 & R-4 is a minimum of 10" tread and 7 3/4" maximum rise. All other Use Group minimum 11" tread, 7" maximum rise.
- 8. The minimum headroom in all parts of a stairway shall not be less than 80 inches.
- 9. Every sleeping room below the fourth story in buildings of Use Groups R and I-1 shall have at least one operable window or exterior door approved for emergency egress or rescue. The units must be operable from the inside without the use of special knowledge or separate tools. Where windows are provided as means of egress or rescue, they shall


have a sill height not more than 44 inches (1118mm) above the floor. All egress or rescue windows from sleeping rooms shall have a minimum net clear opening height dimension of 24 inches (610mm). The minimum net clear opening width dimension shall be 20 inches (508mm), and a minimum net clear opening of 5.7 sq. feet.

10. Each apartment shall have access to two (2) separate, remote and approved means of egress. A single exit is acceptable when it exits directly from the apartment to the building exterior with no communications to other apartment units.
  11. All vertical openings shall be enclosed with construction having a fire rating of at least one (1) hour, including fire doors with selfclosers.
  12. The boiler shall be protected by enclosing with one (1) hour fire-rated construction including fire doors and ceiling, or by providing automatic extinguishment.
  13. All single and multiple station smoke detectors shall be of an approved type and shall be installed in accordance with the provisions of the City's building code Chapter 9, Section 19, 919.3.2 (BOCA National Building Code/1996), and NFPA 101 Chapter 18 & 19. (Smoke detectors shall be installed and maintained at the following locations):
    1. In the immediate vicinity of bedrooms
    2. In all bedrooms
    3. In each story within a dwelling unit, including basements
- In addition to the required AC primary power source, required smoke detectors in occupancies in Use Groups R-2, R-3 and I-1 shall receive power from a battery when the AC primary power source is interrupted. (Interconnection is required)
14. A portable fire extinguisher shall be located as per NFPA #10. They shall bear the label of an approved agency and be of an approved type.
  15. The Fire Alarm System shall be maintained to NFPA #72 Standard.
  16. The Sprinkler System shall be maintained to NFPA #13 Standard.
  17. All exit signs, lights, and means of egress lighting shall be done in accordance with Chapter 10 Section & Subsections 1023. & 1024. of the City's building code. (The BOCA National Building Code/1996)
  18. All construction and demolition debris must be disposed at the City's authorized reclamation site. The fee rate is attached. Proof of such disposal must be furnished to the office of Inspection Services before final Certificate of Occupancy is issued or demolition permit is granted.
  19. Section 25-135 of the Municipal Code for the City of Portland states, "No person or utility shall be granted a permit to excavate or open any street or sidewalk from the time of November 15 of each year to April 15 of the following year".
  20. The builder of a facility to which Section 4594-C of the Maine State Human Rights Act, Title 5 MRSA refers, shall obtain a certification from a design professional that the plans of the facility meet the standards of construction required by this section. Prior to commencing construction of the facility, the builder shall submit the certification to the Division of Inspection Services.
  21. This permit does not excuse the applicant from obtaining any license which may be needed from the City Clerk's Office.

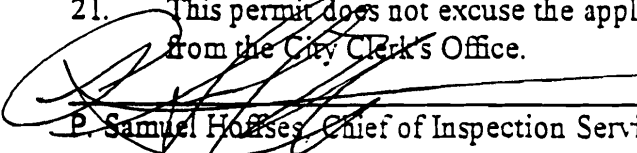  
P. Samuel Hoffes, Chief of Inspection Services c.c. Lt. McDougall P. F. D.

MAP 63  
LOT 16A  
R6

REAR

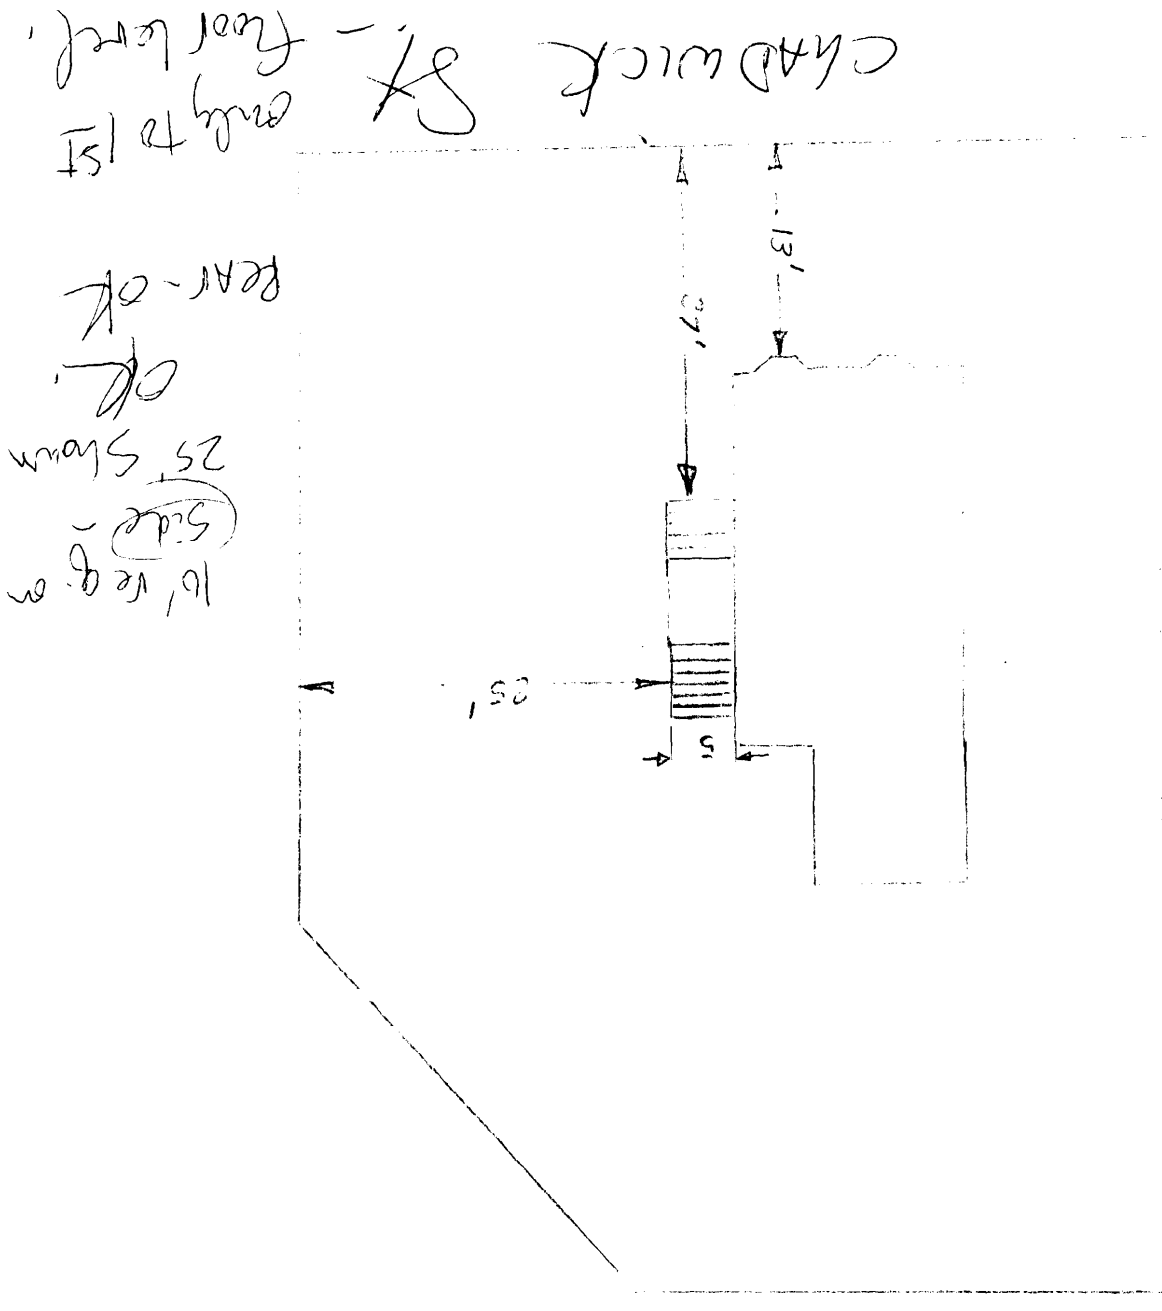


16' reg. on  
(side -  
25' shown)  
OK  
REAR - OK

CHADWICK ST - Floor level.  
only to 1st

EXISTING PORCH

3' x 5'  
LANDING

3' x 5'  
SLOPED  
NON-SKID  
RAMP  
(10 1/2" OVER 10')

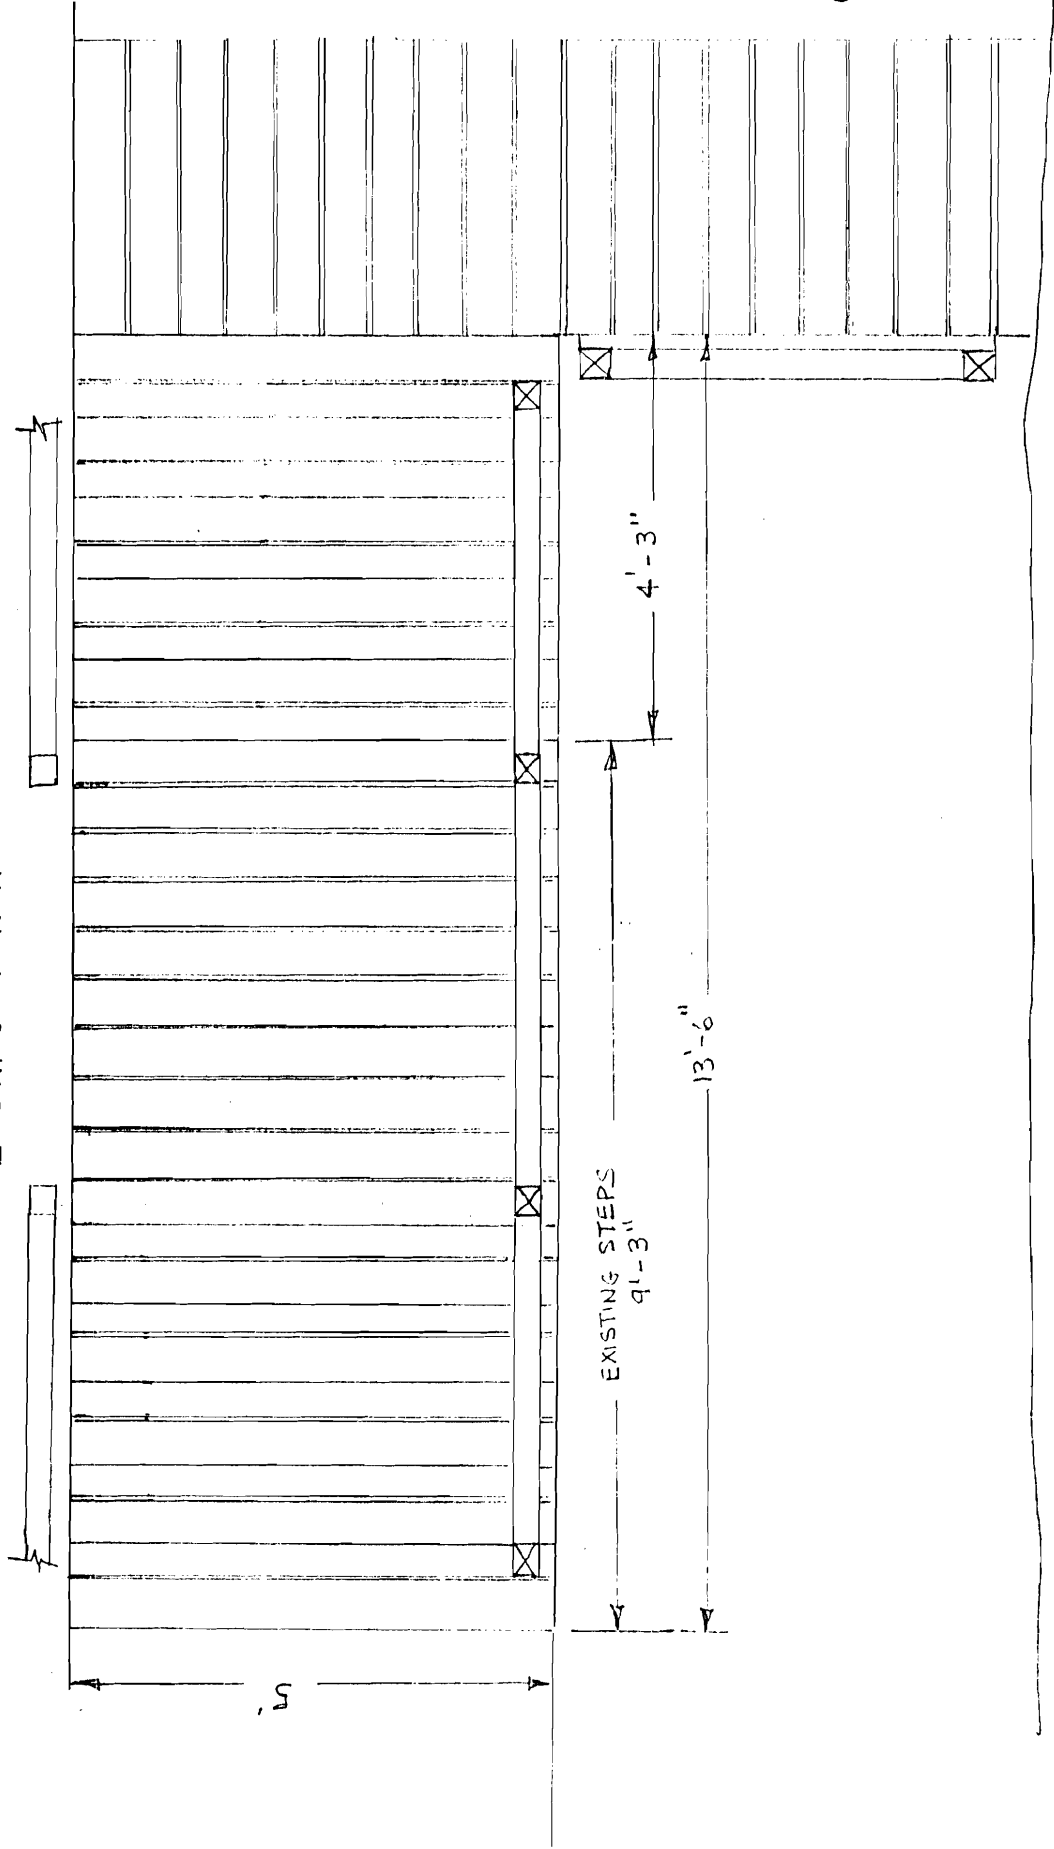

EXISTING STEPS  
9'-3"

4'-3"


13'-6"

PAVED DRIVE


STEPS  
TOP VIEW  
SCALE: 1/2" = 1'-0"

NOTES ~

1. HANDRAIL HEIGHT TO BE 36"
2. BALASTERS SPACE NOT TO EXCEED 4"
3. STEPS 6" RISE / 9 1/2" RUN
4. ENCLOSED WITH DIAGONAL P.T. LATTICE

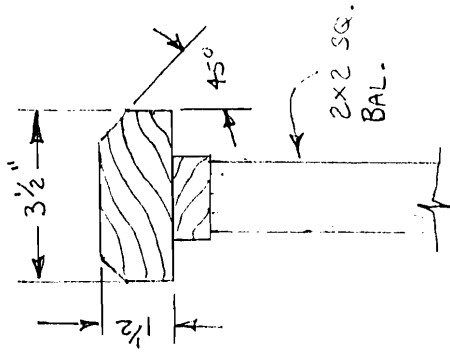

HAND RAIL DETAIL  
SCALE: 3" = 1'-0"

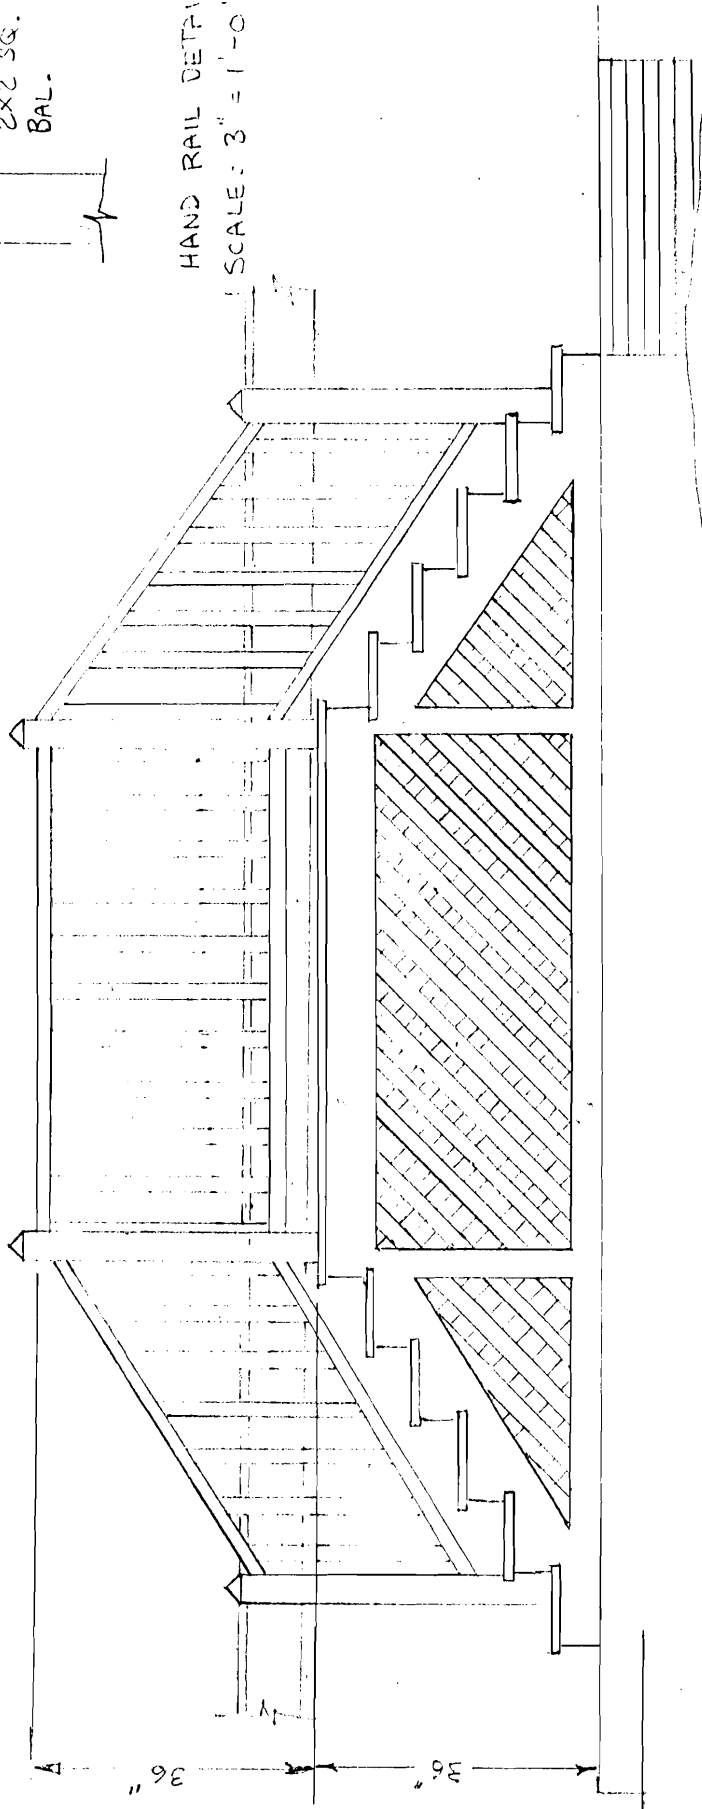

STEPS  
FRONT ELEVATION  
SCALE: 1/2" = 1'-0"

MR & MRS DAVE PERKINS  
140 CHADWICK ST  
PORTLAND, ME 04102