




Approved	X
Issued For	EXISTING CONDITIONS
Date	7/1/15
Rev. No	1

PINE ST. RESIDENCE
159 PINE STREET - PORTLAND, ME
FRAMING PLANS

Designed	NRM	Scale	NOTED
Drawn	MSK	Date	05/05/2015
Checked	DSB	Becker Job Number	3544

S1.2

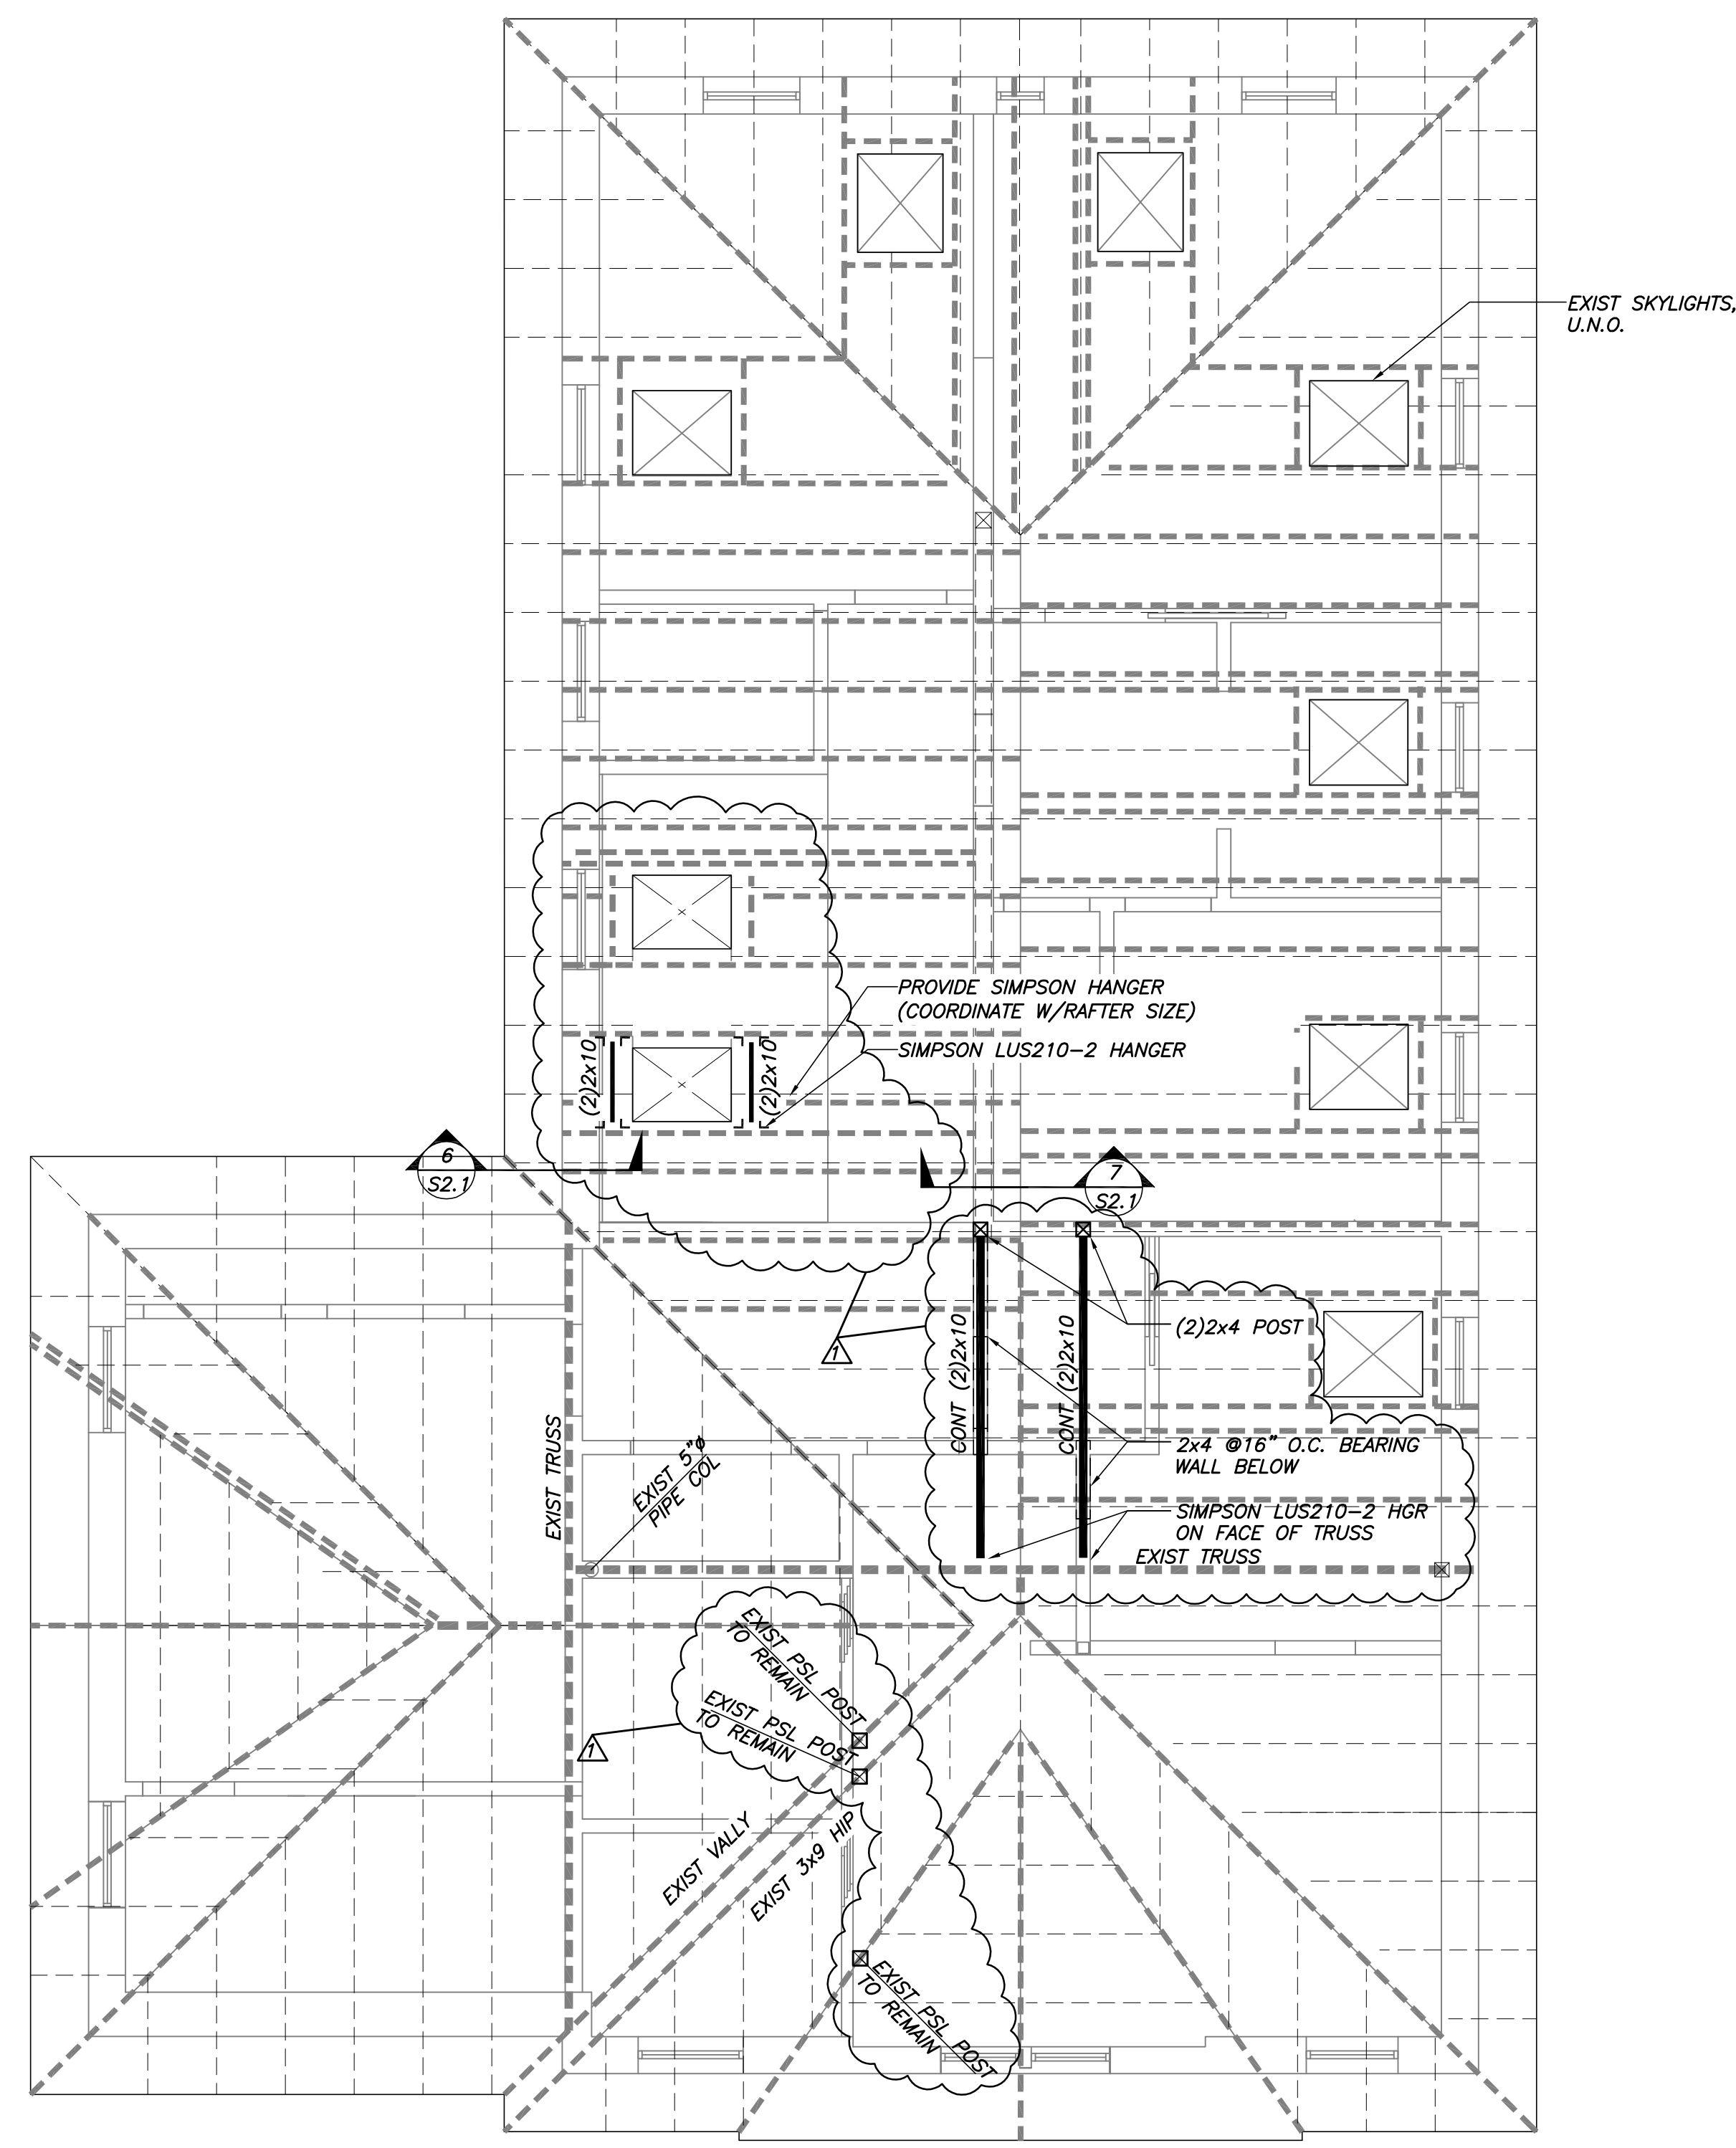

ROOF FRAMING PLAN
1/4"=1'-0"

- NOTES:**
- G/C SHALL FIELD VERIFY ALL EXIST CONDITIONS AND NOTIFY A/E OF ANY DISCREPANCIES.
 - EXIST STRUCTURE TO BE LEFT UNDISTURBED TO THE GREATEST EXTENT POSSIBLE UNLESS NOTED OTHERWISE.

THIS DRAWING IS AN INSTRUMENT OF SERVICE AND SHALL REMAIN THE PROPERTY OF BECKER STRUCTURAL ENGINEERS INC. IT SHALL NOT BE REPRODUCED, COPIED, LENT OR DISPOSED OF DIRECTLY OR INDIRECTLY NOR USED FOR ANY PURPOSE OTHER THAN FOR WHICH IT IS SPECIFICALLY FURNISHED AND MUST BE RETURNED TO BECKER STRUCTURAL ENGINEERS INC. ON COMPLETION OF WORK, IF REQUESTED.